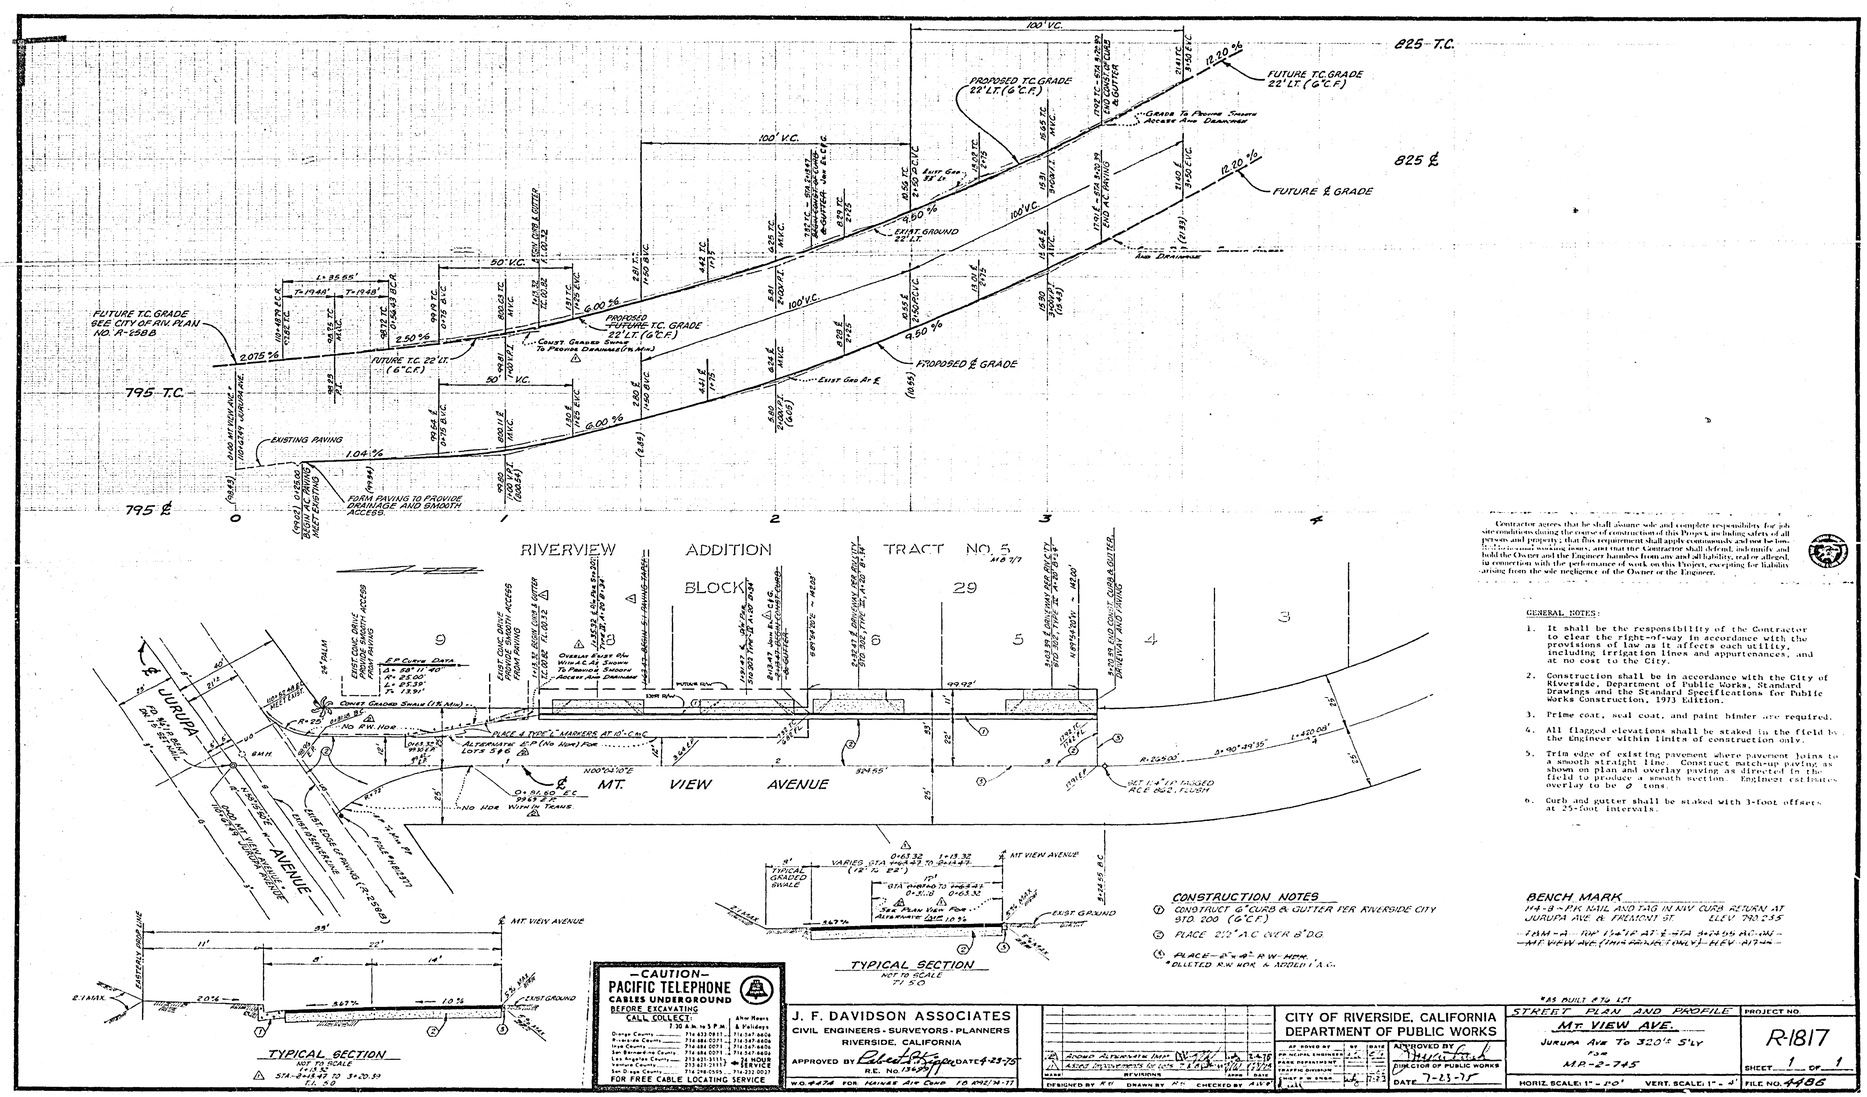

Contractor agrees that he shall assume sole and complete responsibility for job site conditions during the course of construction of this Project, including safety of all persons and property; that this requirement shall apply continuously and not be limited to normal working hours; and that the Contractor shall defend, indemnify and hold the Owner and the Engineer harmless from any and all liability, real or alleged, in connection with the performance of work on this Project, excepting for liability arising from the sole negligence of the Owner or the Engineer.

GENERAL NOTES:

1. It shall be the responsibility of the Contractor to clear the right-of-way in accordance with the provisions of law as it affects each utility, including irrigation lines and appurtenances, and at no cost to the City.
2. Construction shall be in accordance with the City of Riverside, Department of Public Works, Standard Drawings and the Standard Specifications for Public Works Construction, 1973 Edition.
3. Prime coat, seal coat, and paint binder are required.
4. All flagged elevations shall be staked in the field by the Engineer within limits of construction only.
5. Trim edge of existing pavement where pavement joins to a smooth straight line. Construct match-up paving as shown on plan and overlay paving as directed in the field to produce a smooth section. Engineer estimates overlay to be 2 tons.
6. Curb and gutter shall be staked with 3-foot offsets at 25-foot intervals.

CONSTRUCTION NOTES

(7) CONSTRUCT 6" CURB & GUTTER PER RIVERSIDE CITY STD. 200 (G.C.F.)

(5) PLACE 2½" A.C. OVER 8" D.G.

(6) PLACE 8"x4" R.W. HDR.
*DELETED R.W. HDR. & ADDED 1' A.C.

BENCH MARK

M4-8 - PK NAIL AND TAG IN NW CURB RETURN AT JURUPA AVE & FREMONT ST. ELEV. 790.255

- TAM-A - TOP 1½" I.P. AT ℄ STA. 4+74.55 AC-3W - MT VIEW AVE. (1974 RIVERSIDE ONLY) - ELEV. 817.44 -

*AS BUILT ℄ TO ℄

—CAUTION—
PACIFIC TELEPHONE
CABLES UNDERGROUND
BEFORE EXCAVATING
CALL COLLECT:

	7:30 a.m. to 5 P.M.	Also Hours & Holidays
Orange County	714 633 0811	714 547 8404
Riverside County	714 684 0271	714 547 8404
Imperial County	714 684 0271	714 547 8404
San Bernardino County	714 684 0271	714 547 8404
Los Angeles County	213 621 3111	24 HOUR SERVICE
Ventura County	213 621 3111	
San Diego County	714 298 5555	714 232 0023

FOR FREE CABLE LOCATING SERVICE

J. F. DAVIDSON ASSOCIATES
CIVIL ENGINEERS - SURVEYORS - PLANNERS
RIVERSIDE, CALIFORNIA
APPROVED BY [signature] DATE 4-23-75
R.E. No. 13429

MARK	REVISIONS	APPD	DATE

DESIGNED BY R.E. DRAWN BY R.E. CHECKED BY A.V.P.

CITY OF RIVERSIDE, CALIFORNIA
DEPARTMENT OF PUBLIC WORKS

APPROVED BY	BY	DATE
PR. MUNICIPAL ENGINEER		
PARK DEPARTMENT		
TRAFFIC DIVISION		
DIR. OF PUBLIC WORKS		

APPROVED BY [signature]
DIRECTOR OF PUBLIC WORKS
DATE 7-23-75

STREET PLAN AND PROFILE
MT. VIEW AVE.
JURUPA AVE TO 320'± S'LY
FOR
MP-2-745

PROJECT NO. R-1817
SHEET 1 OF 1
HORIZ. SCALE: 1" = 20' VERT. SCALE: 1" = 4'
FILE NO. 4486