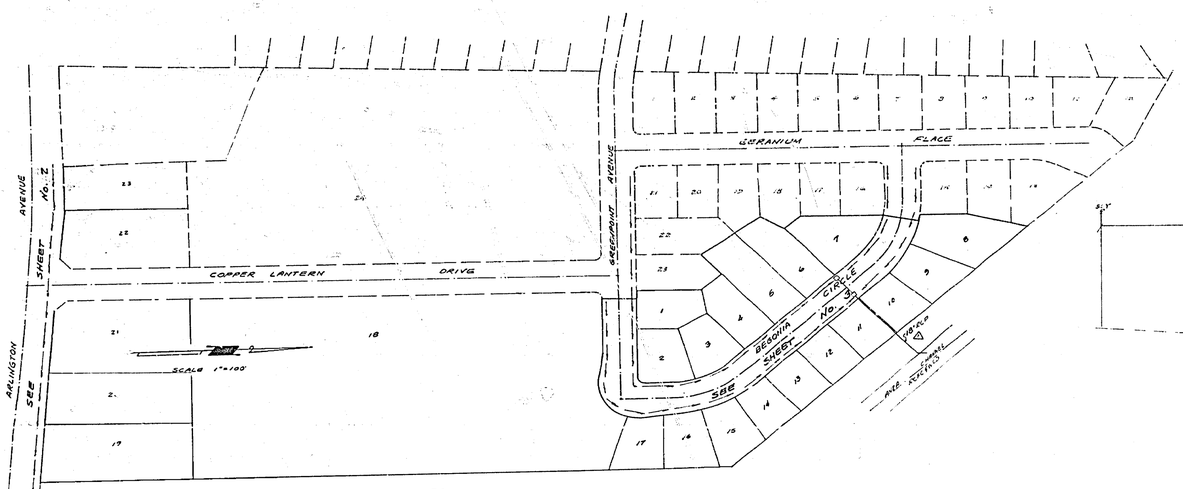

INDEX MAP AND FLOW DIAGRAM

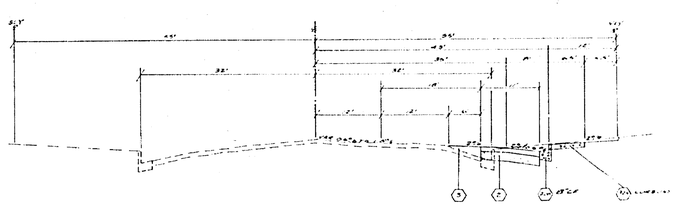

TYPICAL SECTION
FOR
ARLINGTON AVENUE
T1=8

STREET NAME SIGN SCHEDULE	
(A) BEGONIA CIRCLE	6500
GREENPOINT AVENUE	6000

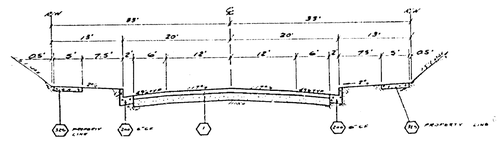

TYPICAL SECTION
FOR
BEGONIA CIRCLE
AND
GREENPOINT AVENUE
T1=5

NOT TO SCALE

GENERAL NOTES

1. CONSTRUCTION SHALL BE IN ACCORDANCE WITH THE STANDARD SPECIFICATIONS FOR PUBLIC WORKS CONSTRUCTION, 1973 EDITION AND CITY OF RIVERSIDE STANDARD DRAWINGS.
2. IT SHALL BE THE RESPONSIBILITY OF THE CONTRACTOR TO CLEAR THE RIGHT OF WAY IN ACCORDANCE WITH THE PROVISIONS OF LAW AS IT AFFECTS EACH UTILITY INCLUDING IRRIGATION LINES AND APPURTENANCES AND AT NO COST TO THE CITY.
3. ALL TRAFFIC CONTROL SIGNS SHALL BE INSTALLED PRIOR TO OPENING THE STREETS TO TRAFFIC.
4. SEE STREET LIGHTING PLAN FOR NUMBER AND LOCATION OF STREET LIGHTS.
5. CURB AND GUTTER SHALL BE STAKED WITH 3' OFFSETS AT 25' INTERVALS. CURB FACES, GRADES OF LESS THAN 0.4% WILL BE STAKED AT 12.5' INTERVALS AND 3/4" SOLID STEEL DOWELS WILL BE REQUIRED AT ALL EXPANSION JOINTS.
6. SEE STORM DRAIN PLANS FOR STANDARD NO. 452, CASE 2
7. UNIVERSAL APPEARANCE FOR EACH LOT TO BE LOCATED IN THE FIELD AS EXHIBITED BY THE TRAFFIC ENGINEER AND CONSTRUCTED PER STD NO. 208.
8. TRIM BASE OR EXISTING PAVEMENT WHERE NEW PAVEMENT JOINS TO A SMOOTH STRAIGHT LINE. CONSTRUCT MATCH LINE PAVING AS SHOWN AND OVERLAY PAVING AS DIRECTED IN THE FIELD TO PRODUCE A SMOOTH SECTION. ENCLOSURE ASPHALTIC CONCRETE OVERLAY TO BE 35 TONS.
9. THE CONTRACTOR SHALL CONTACT THE PUBLIC SERVICE DEPT. (787-7511) TO PICK UP ANY EXISTING STD. 180 BARRICADES THAT ARE BEING REMOVED.

CONSTRUCTION NOTES

- (CG) CONSTRUCT CITY OF RIVERSIDE STANDARD NO. 200, CURB AND GUTTER, TYPE I
- (WC) CONSTRUCT CITY OF RIVERSIDE STANDARD NO. 304, WHEELCHAIR RAMP
- (CB) CONSTRUCT CITY OF RIVERSIDE STANDARD NO. 403, CATCH BASIN
- (SD) CONSTRUCT CITY OF RIVERSIDE STANDARD NO. 325, SIDEWALK
- (1) PLACE 3/4" AC OVER 4"-0A BASE OR 3"-AC OVER 6"-0A BASE OVER COMPACTED NATIVE MATERIAL AND TYPICAL SECTION ON THIS SHEET.
- (2) PLACE 4.5" AC OVER 8"-CR BASE OR 7"AC OVER COMPACTED NATIVE MATERIAL AND TYPICAL SECTION ON THIS SHEET.
- (3) OVERLAY EXIST PAVEMENT PER GENERAL NOTE 8. LIMITS SHOWN AT [ ]

BENCH MARK

ELEVATION 733.51, CITY OF RIVERSIDE D.S.D., TOP OF BRASS DISC IN WELL AT AB IN ARLINGTON AVENUE, 500± WEST OF LAKE STREET.

ALBERT A. WEBB ASSOCIATES
CIVIL ENGINEERS
RIVERSIDE, CALIFORNIA

APPROVED BY [illegible] DATE 1-7-76
R.E. No. 11984
W.O. 75-175 FOR ROAD AND DRAINAGE P.D. 1089

MARK	REVISIONS	APP'D	DATE
1	ADD "AS BUILT" ELEVATIONS	[illegible]	4/5/76

DESIGNED BY [illegible] DRAWN BY [illegible] CHECKED BY [illegible]

CITY OF RIVERSIDE, CALIFORNIA
PUBLIC WORKS DEPARTMENT

APPROVED BY	BY	DATE
PRINCIPAL ENGINEER	[illegible]	4/5/76
PARK DEPARTMENT	[illegible]	4/5/76
TRAFFIC DIVISION	[illegible]	4/5/76
CHIEF PUB WKS ENGR	[illegible]	4/5/76

APPROVED BY [illegible]
DIRECTOR OF PUBLIC WORKS
DATE 1-7-76

"AS BUILT 8-76 +PT"

STREET PLAN
TRACT 5002
PLAN INDEX

SCALE: AS NOTED

ACCOUNT No.
DRAWING NUMBER
R-1849
SHEET 1 OF 3
73-173-4

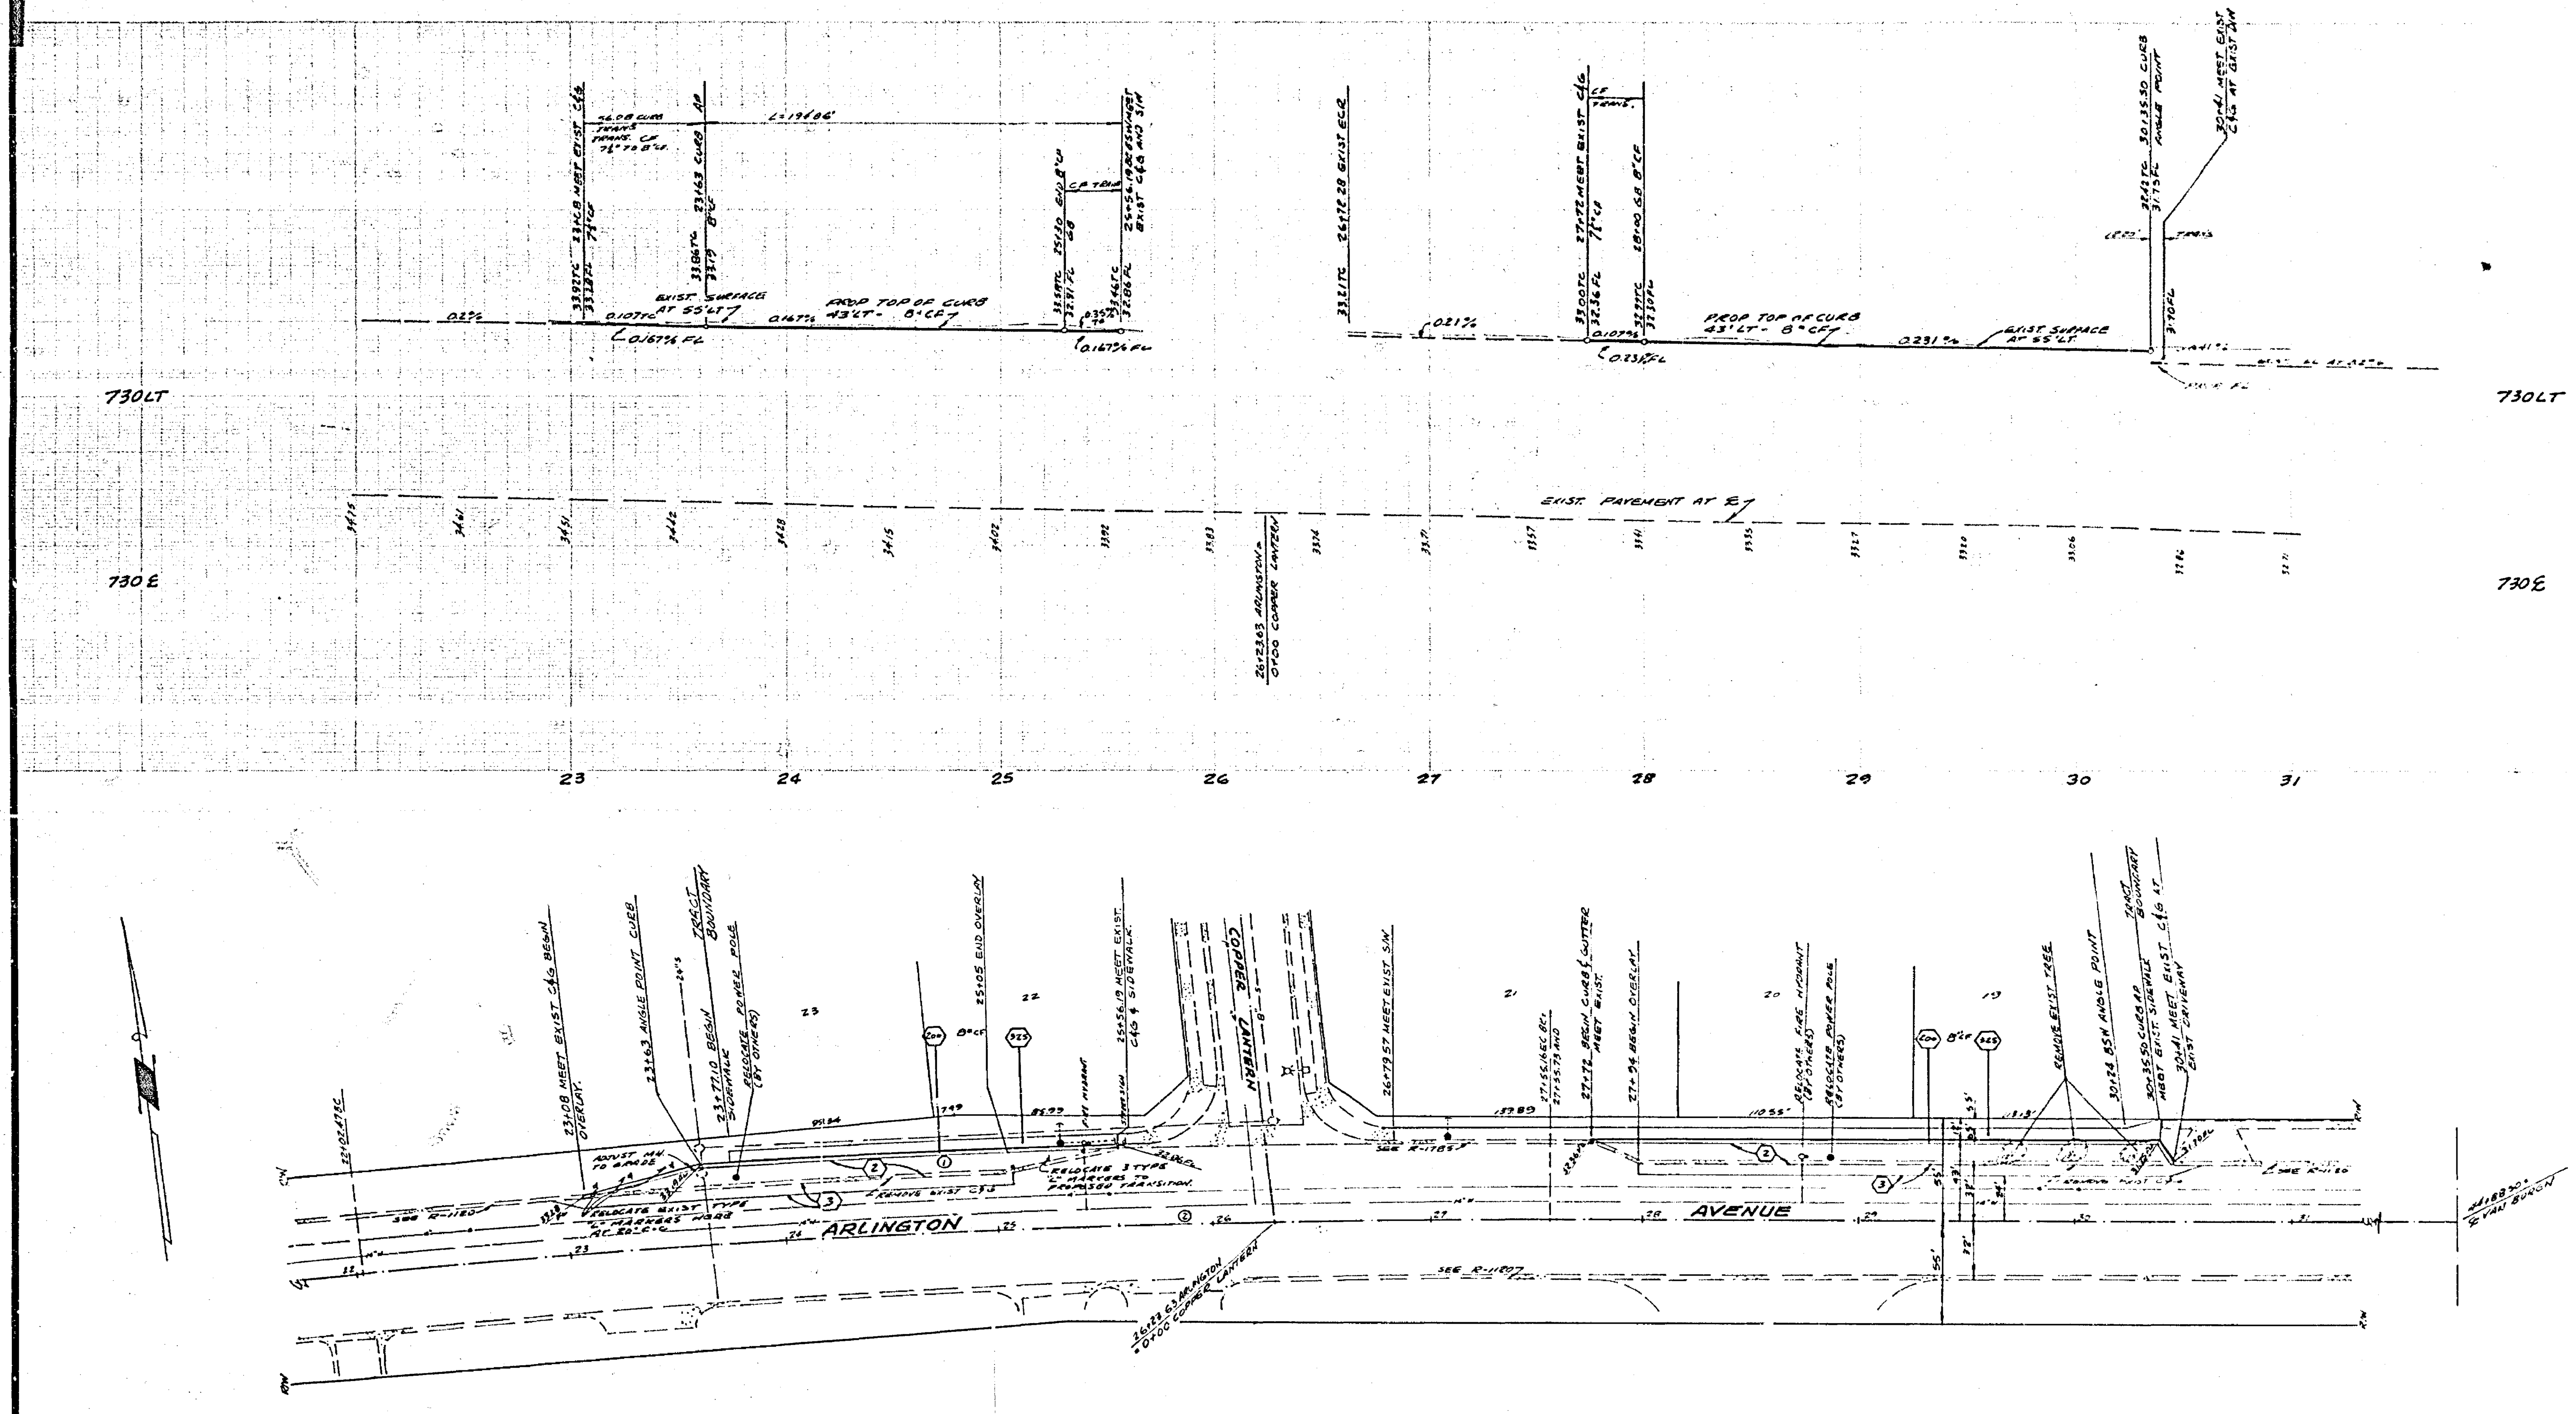

BENCH MARK:
ELEV. 733.31
CITY OF RIVERSIDE 6-3-0 TOP OF BRASS DISC IN WELL AT A.P. IN ARLINGTON AVENUE, 500'± EAST OF LAKE STREET.

NOTE
SEE SHEET 1 FOR GENERAL AND CONSTRUCTION NOTES.

CURVE DATA				
No	Δ	R	T	L
1	2°12'50"	5043'	97.46'	194.86'
2	6°20'00"	5000'	276.63'	552.69'

ALBERT A. WEBB ASSOCIATES
CIVIL ENGINEERS
RIVERSIDE, CALIFORNIA
APPROVED BY ______ DATE ______
R.E. No. 21584
W.O. 75-175 FOR: HOME AND COUNTRY F.B. 1029

MARK	REVISIONS	APPR	DATE

DESIGNED BY ___ DRAWN BY ___ CHECKED BY ___

CITY OF RIVERSIDE, CALIFORNIA
PUBLIC WORKS DEPARTMENT

APPROVED BY	BY	DATE
PRINCIPAL ENGINEER		
PARK DEPARTMENT		
TRAFFIC DIVISION		
CHIEF PUB WKS ENGR		

APPROVED BY: ______
DIRECTOR OF PUBLIC WORKS
DATE 1-7-76

*AS BUILT 8-76

STREET PLAN AND PROFILE
TRACT NO. 5002
ARLINGTON AVENUE
AT
COPPER LANTERN DRIVE

SCALE: HORZ. 1"=40' VERT 1"=4'

ACCOUNT No.
DRAWING NUMBER
R-1849
SHEET 2 OF 3
75-175-A

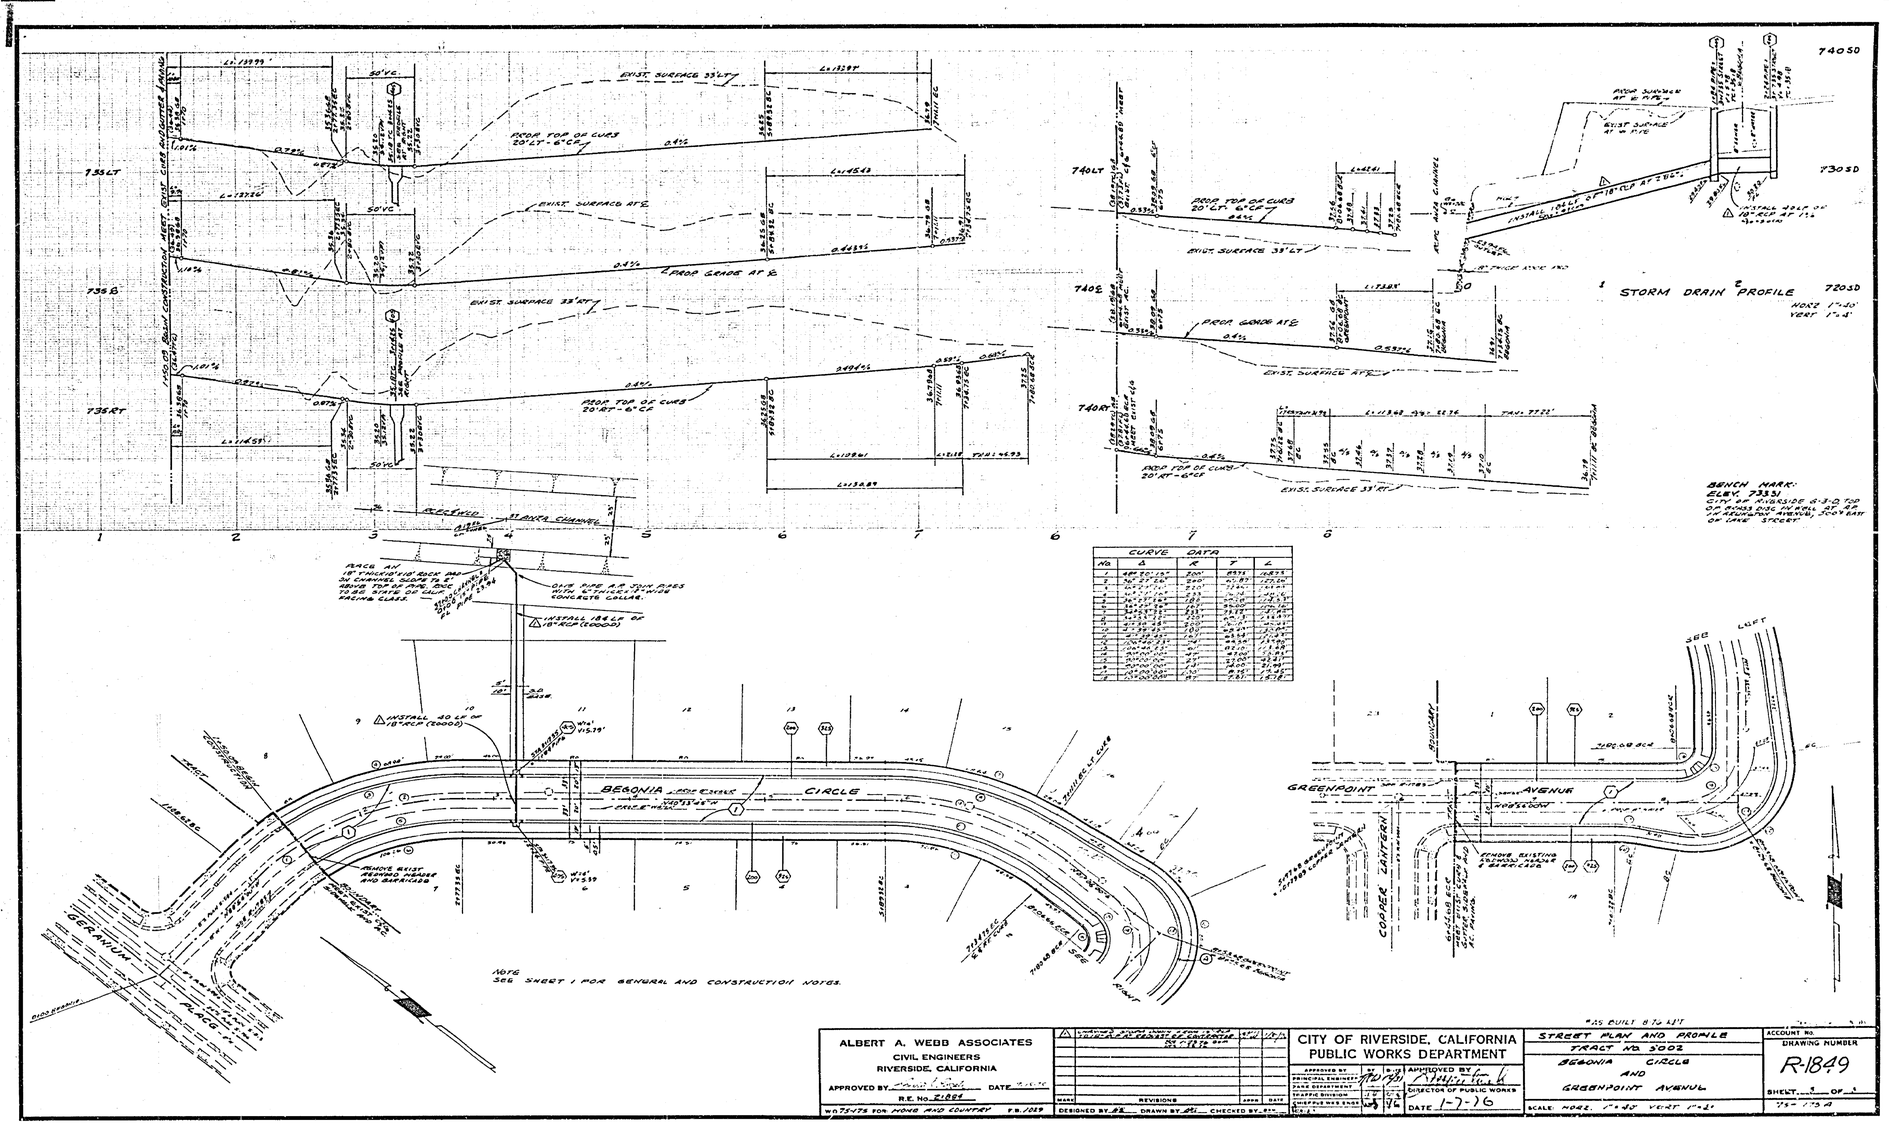
735LT
735 ℄
735RT
740LT
740℄
740RT
740SD
730SD
720SD
STORM DRAIN ℄ PROFILE
EXIST. SURFACE 35'LT
EXIST. SURFACE AT ℄
EXIST. SURFACE 35'RT
PROP TOP OF CURB 20'LT - 6"CF
PROP GRADE AT ℄
PROP TOP OF CURB 20'RT - 6"CF
EXIST. SURFACE 35'RT
EXIST. SURFACE AT ℄
EXIST. SURFACE 35'LT
PROP TOP OF CURB 20'RT - 6"CF
EXIST. SURFACE AT ℄
PROP SURFACE AT ℄ PIPE
EXIST SURFACE AT ℄ PIPE
