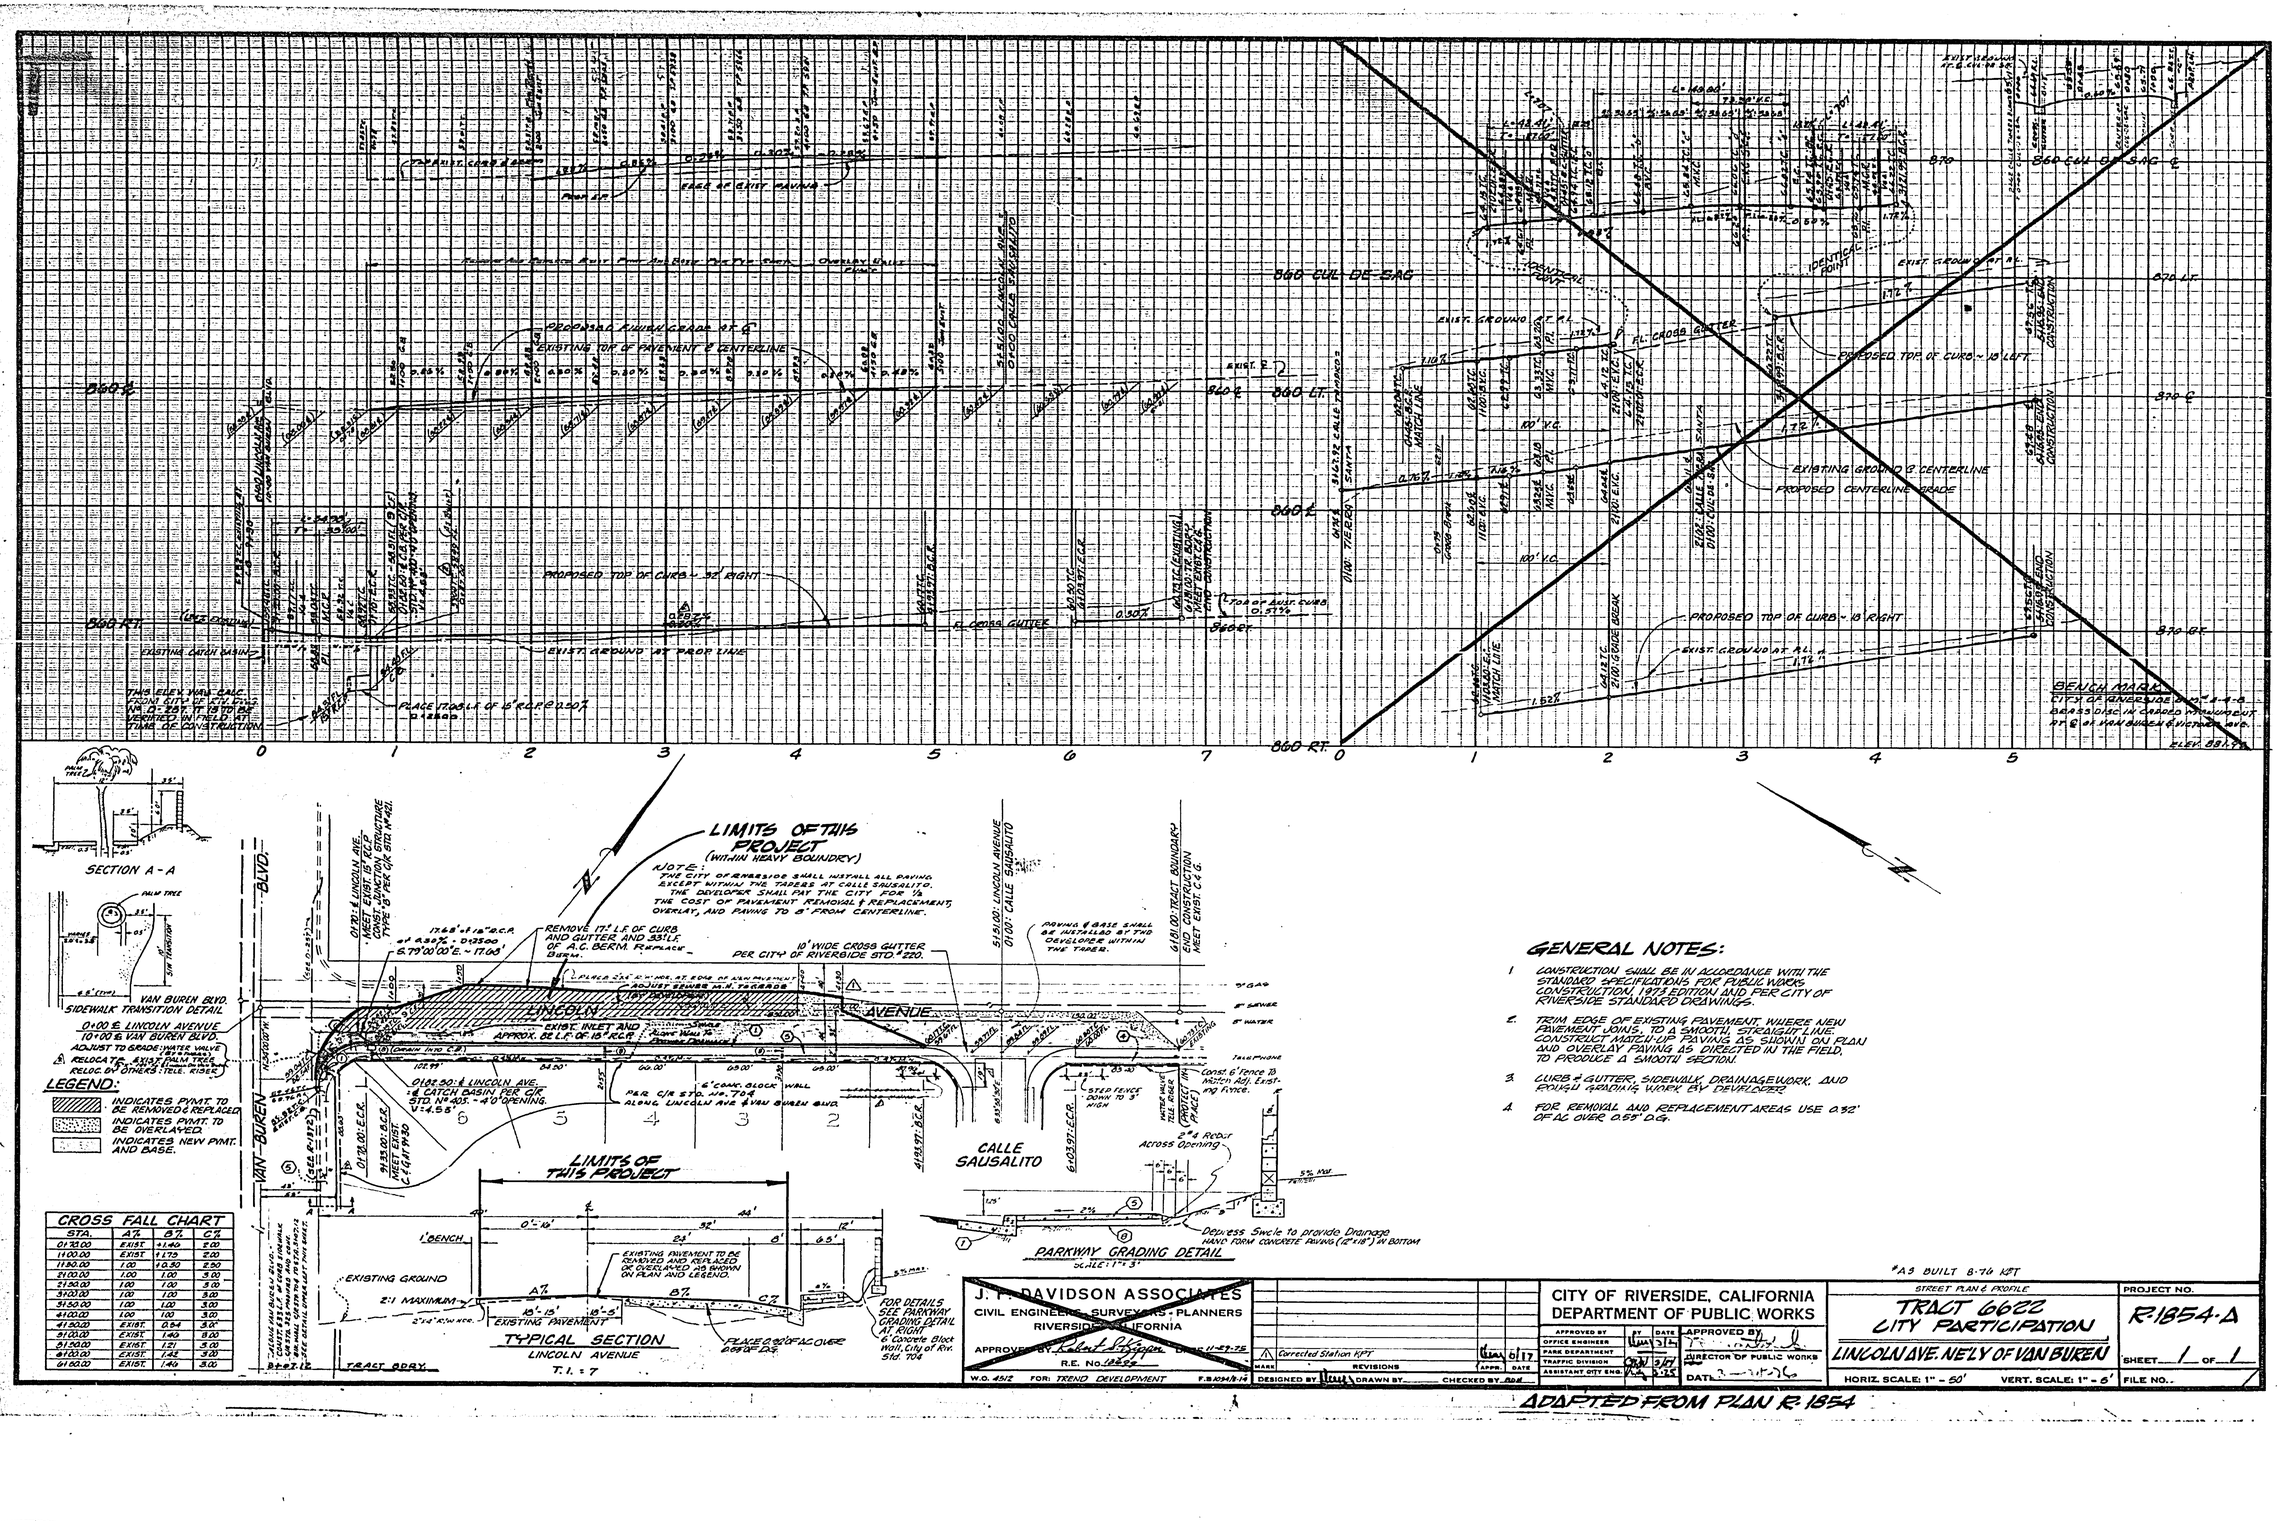

J. T. DAVIDSON ASSOCIATES
CIVIL ENGINEERS · SURVEYORS · PLANNERS
RIVERSIDE, CALIFORNIA
APPROVED BY: Robert L. Skipper DATE: 11-27-76
R.E. NO. 12254
W.O. 4512 FOR: TREND DEVELOPMENT F.B. 304/9-14
DESIGNED BY: [illegible] DRAWN BY: [illegible] CHECKED BY: ADA

MARK	REVISIONS	APPR.	DATE
1	Corrected Station KPT	[illegible]	01/17

CITY OF RIVERSIDE, CALIFORNIA
DEPARTMENT OF PUBLIC WORKS

	BY	DATE
APPROVED BY		
OFFICE ENGINEER	[illegible]	3/16
PARK DEPARTMENT		
TRAFFIC DIVISION	[illegible]	3/17
ASSISTANT CITY ENG.	[illegible]	3-15
DIRECTOR OF PUBLIC WORKS		
DATE	3-[illegible]-76	

STREET PLAN & PROFILE
TRACT 6622
CITY PARTICIPATION
LINCOLN AVE. NE'LY OF VAN BUREN
HORIZ. SCALE: 1" = 50' VERT. SCALE: 1" = 5'

PROJECT NO. R.1854-A
SHEET 1 OF 1
FILE NO.