RIVERSIDE CITY OF RIVERSIDE CALIFORNIA

PUBLIC WORKS DEPARTMENT

CONSTRUCTION LEGEND

CENTER LINE ——℄——·——
RIGHT-OF-WAY LINE ——R/W——
SUBDIVISION LOT LINE ——ℓ——

TOP OF SLOPE
TOE OF SLOPE
DIRECTION OF FLOW

CONSTRUCT PER CITY OF RIVERSIDE STANDARD DRAWINGS:

200 CURB AND GUTTER PER STANDARD DRAWING 200.
250 ASPHALT BERM PER STANDARD DRAWING 250.
302 DRIVEWAY APPROACH PER STANDARD DRAWING 302.
304 WHEELCHAIR RAMP PER STANDARD DRAWING 304.
325 SIDEWALK PER STANDARD DRAWING 325.
R RETAINING WALL PER DETAIL DRAWING ON SHEET 3.
1 PLACE VARIABLE THICKNESS AC. OVERLAY.
2 PLACE 0.35' AC OVER 0.65' DG BASE.
3 REMOVE EXISTING AC. AND REPLACE WITH 0.35' AC OVER 0.65' DG BASE.
4 REMOVE 6 LF OF CURB AND REPLACE WITH DEPRESSED CURB FOR CONTINUOUS DRIVEWAY DEPRESSION. (STA. 12+30)
5 REMOVE WALL WITHIN STREET R/W AND REBUILD AT R/W IN WORKMAN-LIKE MANNER.
6 REMOVE SHRUB.
7 REMOVE TREE.
8 SAVE TREE, TRIM BRANCHES AS DIRECTED, CONSTRUCT EDGE OF S/W 12" CLEAR FROM TRUNK. (STATION 13+32)
9 REMOVE FENCE AND PLACE ON PRIVATE PROPERTY FOR OWNER TO REBUILD.
10 CONNECT PRIVATE WALK TO SIDEWALK WITH 4" PCC. CONSTRUCT STEP IF NECESSARY.
11 UTILITIES TO BE RELOCATED BY OTHERS.
12 EXIST. LAWN. DO NOT GRADE PARKWAY.
13 TRIM CACTUS. (STA. 10+17)
14 REMOVE 16 L.F.± OF SUNKEN C&G (STA. 20+00).
15 REMOVE WALL.
16 CONTRACTOR TO RELOCATE SPRINKLER SYSTEM (1289 ORANGE ST.)
17 PROPERTY OWNER WILL RELOCATE SPRINKLER SYSTEM.
18 ADJUST DRIVEWAY ON PRIVATE PROPERTY. DIRT / AC / PCC
19 GRADE @ 3:1, REPLACE GRASS.

GENERAL CONSTRUCTION NOTES

1. CONSTRUCTION TO BE IN ACCORDANCE WITH STANDARD SPECIFICATIONS FOR PUBLIC WORKS CONSTRUCTION, 1973 EDITION AND WITH CITY OF RIVERSIDE STD. DWGS.
2. CLEAR AND GRUB WHERE NEW CONSTRUCTION IS INDICATED.
3. WHERE APPLICABLE, RELOCATE STREET NAME SIGNS AND TRAFFIC SIGNS IN ACCORDANCE WITH STD. DWGS. NOS. GG2 & GGG RESPECTIVELY.

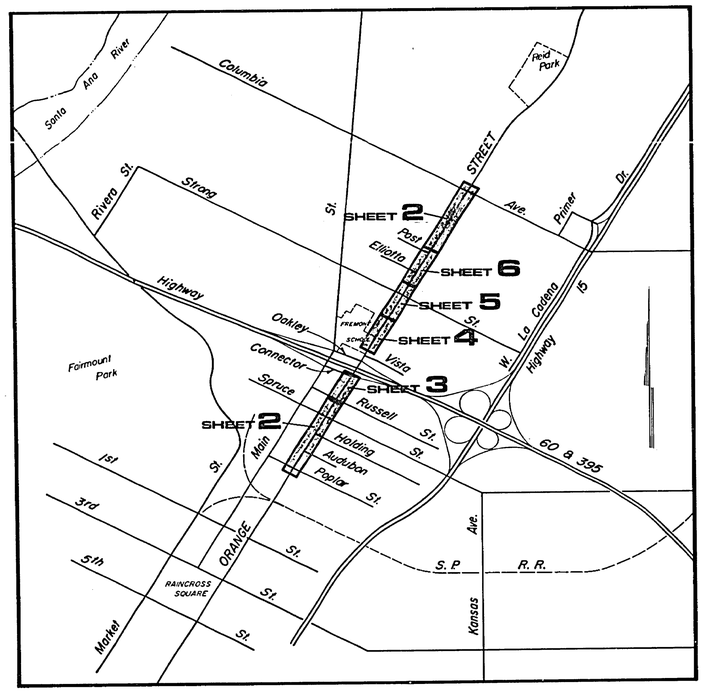

PROJECT LOCATION PLAN

0' 500' 1000' 2000' 3000' 4000' 5000' 6000'

SCALE 1"= 1000'

EXISTING UNDERGROUND & TOPOGRAPHY LEGEND

EXISTING UNDERGROUND UTILITIES:

SANITARY SEWER	8"S	TELEPHONE CONDUIT	T T
WATER LINE	6"W	ELECTRICAL CONDUIT	E E
STORM DRAIN	24"SD	STREET LIGHTING	SL SL
GAS LINE	3"G	TRAFFIC SIGNAL	SIG SIG
IRRIGATION LINE	20"IRR	FIRE ALARM	F F

EXISTING TOPOGRAPHY:

BLOCK WALL
BOARD FENCE
WIRE FENCE
CHAIN LINK FENCE
TOP OF SLOPE
TOE OF SLOPE
DIRECTION OF FLOW

(S) SANITARY SEWER MH
SANITARY SEWER CLEANOUT
(S) STORM DRAIN MH
IRRIGATION WEIR
WATER M.H.
GAS M.H.
ELECTRIC MH
T TELEPHONE MH OR VAULT
WATER METER
FIRE HYDRANT
SPRINKLER HEAD
VALVE
POLE & GUY ANCHOR
ELECTRIC POLE
TELEPHONE POLE
JOINT USE POLE
PULL BOX
TRAFFIC SIGN
PARKING METER
FIRE ALARM BOX
STREET NAME SIGN
GAS METER
MAIL BOX
FAUCET
PEDESTRIAN PUSH BUTTON
RAILROAD TRACKS
RAILROAD SIGN
RAILROAD SIGNAL
STREET LIGHT & TRAFFIC SIGNAL ON MAST ARM
STREET LIGHT (UPRIGHT)
STREET LIGHT
TRAFFIC SIGNAL
TRAFFIC SIGNAL ON MAST ARM
TRAFFIC SIGNAL CONTROLLER
TRAFFIC SIGNAL PRESSURE DETECTOR
TRAFFIC SIGNAL LOOP DETECTOR

CONCRETE
ASPHALT
(ASPHALT) & CONC EDGE OF PAVEMENT
BUILDING
UNDERGROUND STRUCTURE
OVERHANGING STRUCTURE

CITRUS TREE
OR DECIDUOUS TREE
OR PALM TREE
SHRUBBERY
TREE STUMP

"AS BUILT 3-77 KRT

CITY OF RIVERSIDE PUBLIC WORKS DEPARTMENT	ORANGE ST. IMPROVEMENTS WESTERLY SIDE HCD PROJECT	ACCOUNT No. 179-550-45x
APPROVED BY / DATE / BY	POPLAR ST. to COLUMBIA AVE.	DRAWING NUMBER R-1856
PRINCIPAL ENGINEER 3-5-76	APPROVED BY PUBLIC WORKS DIRECTOR	SHEET 1 OF 6
PARK DEPARTMENT 3-4-76	DATE 3-5-76	
TRAFFIC DIVISION 3-12-76	DESIGNED BY ____ DRAWN BY ____ CHECKED BY ____	
CHIEF P.W. ENGINEER 3-5-76		

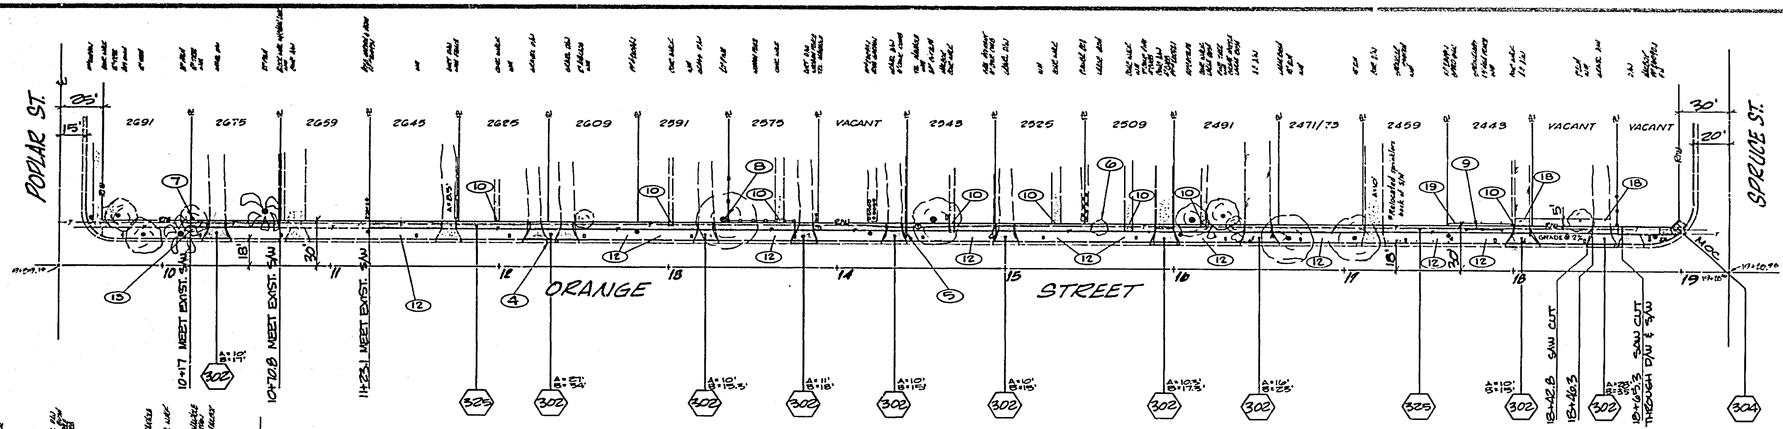

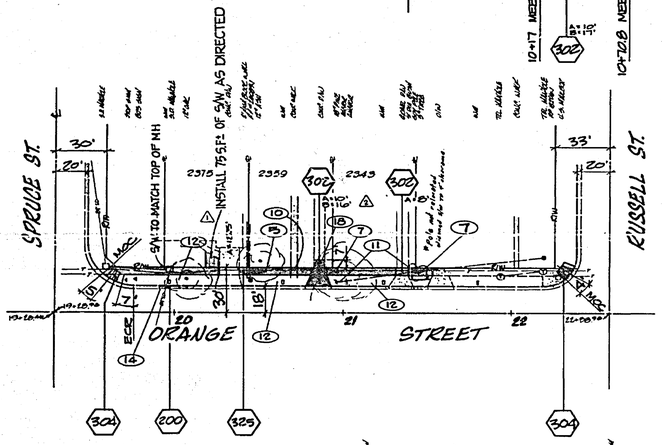

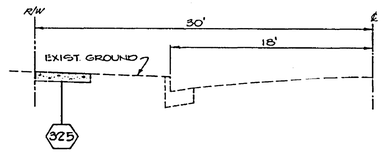

TYPICAL SECTION
NOT TO SCALE
POPLAR ST. TO RUSSELL ST.
SIDEWALK TO MEET EXIST. GROUND
DEPRESS DRIVEWAYS AS NECESSARY
TO PROVIDE DRAINAGE.

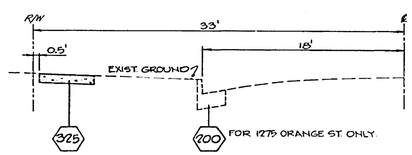

TYPICAL SECTION
NOT TO SCALE
ELLIOTTA DR. TO COLUMBIA AVE.
SIDEWALK TO MEET EXIST. GROUND
UNLESS OTHERWISE DIRECTED.

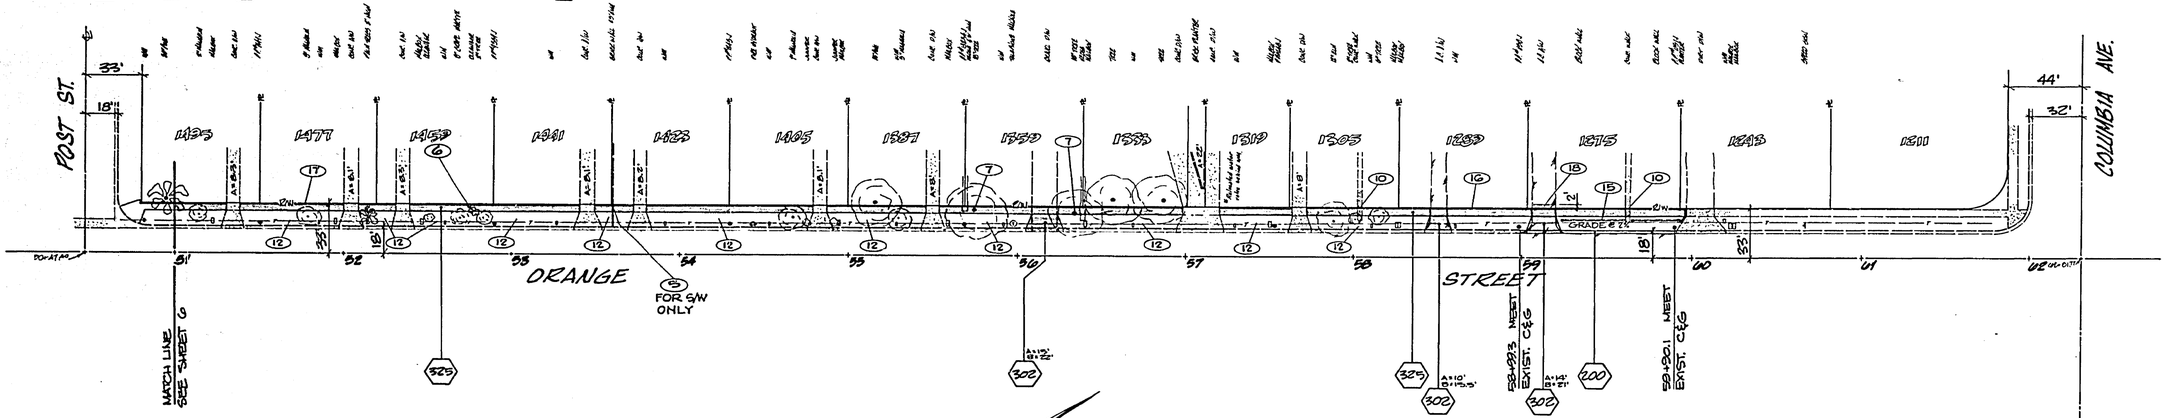

NORTH

"AS BUILT 3-77 KPT

CITY OF RIVERSIDE
PUBLIC WORKS DEPARTMENT

ORANGE ST. IMPROVEMENTS
WESTERLY SIDE
HCD PROJECT
POPLAR ST. to RUSSELL ST.
AND POST ST. to COLUMBIA AVE.

R-1856

SHEET 2 OF 6

HORIZ. SCALE 1" = 40' VERT. SCALE 1" =

FILE NO.

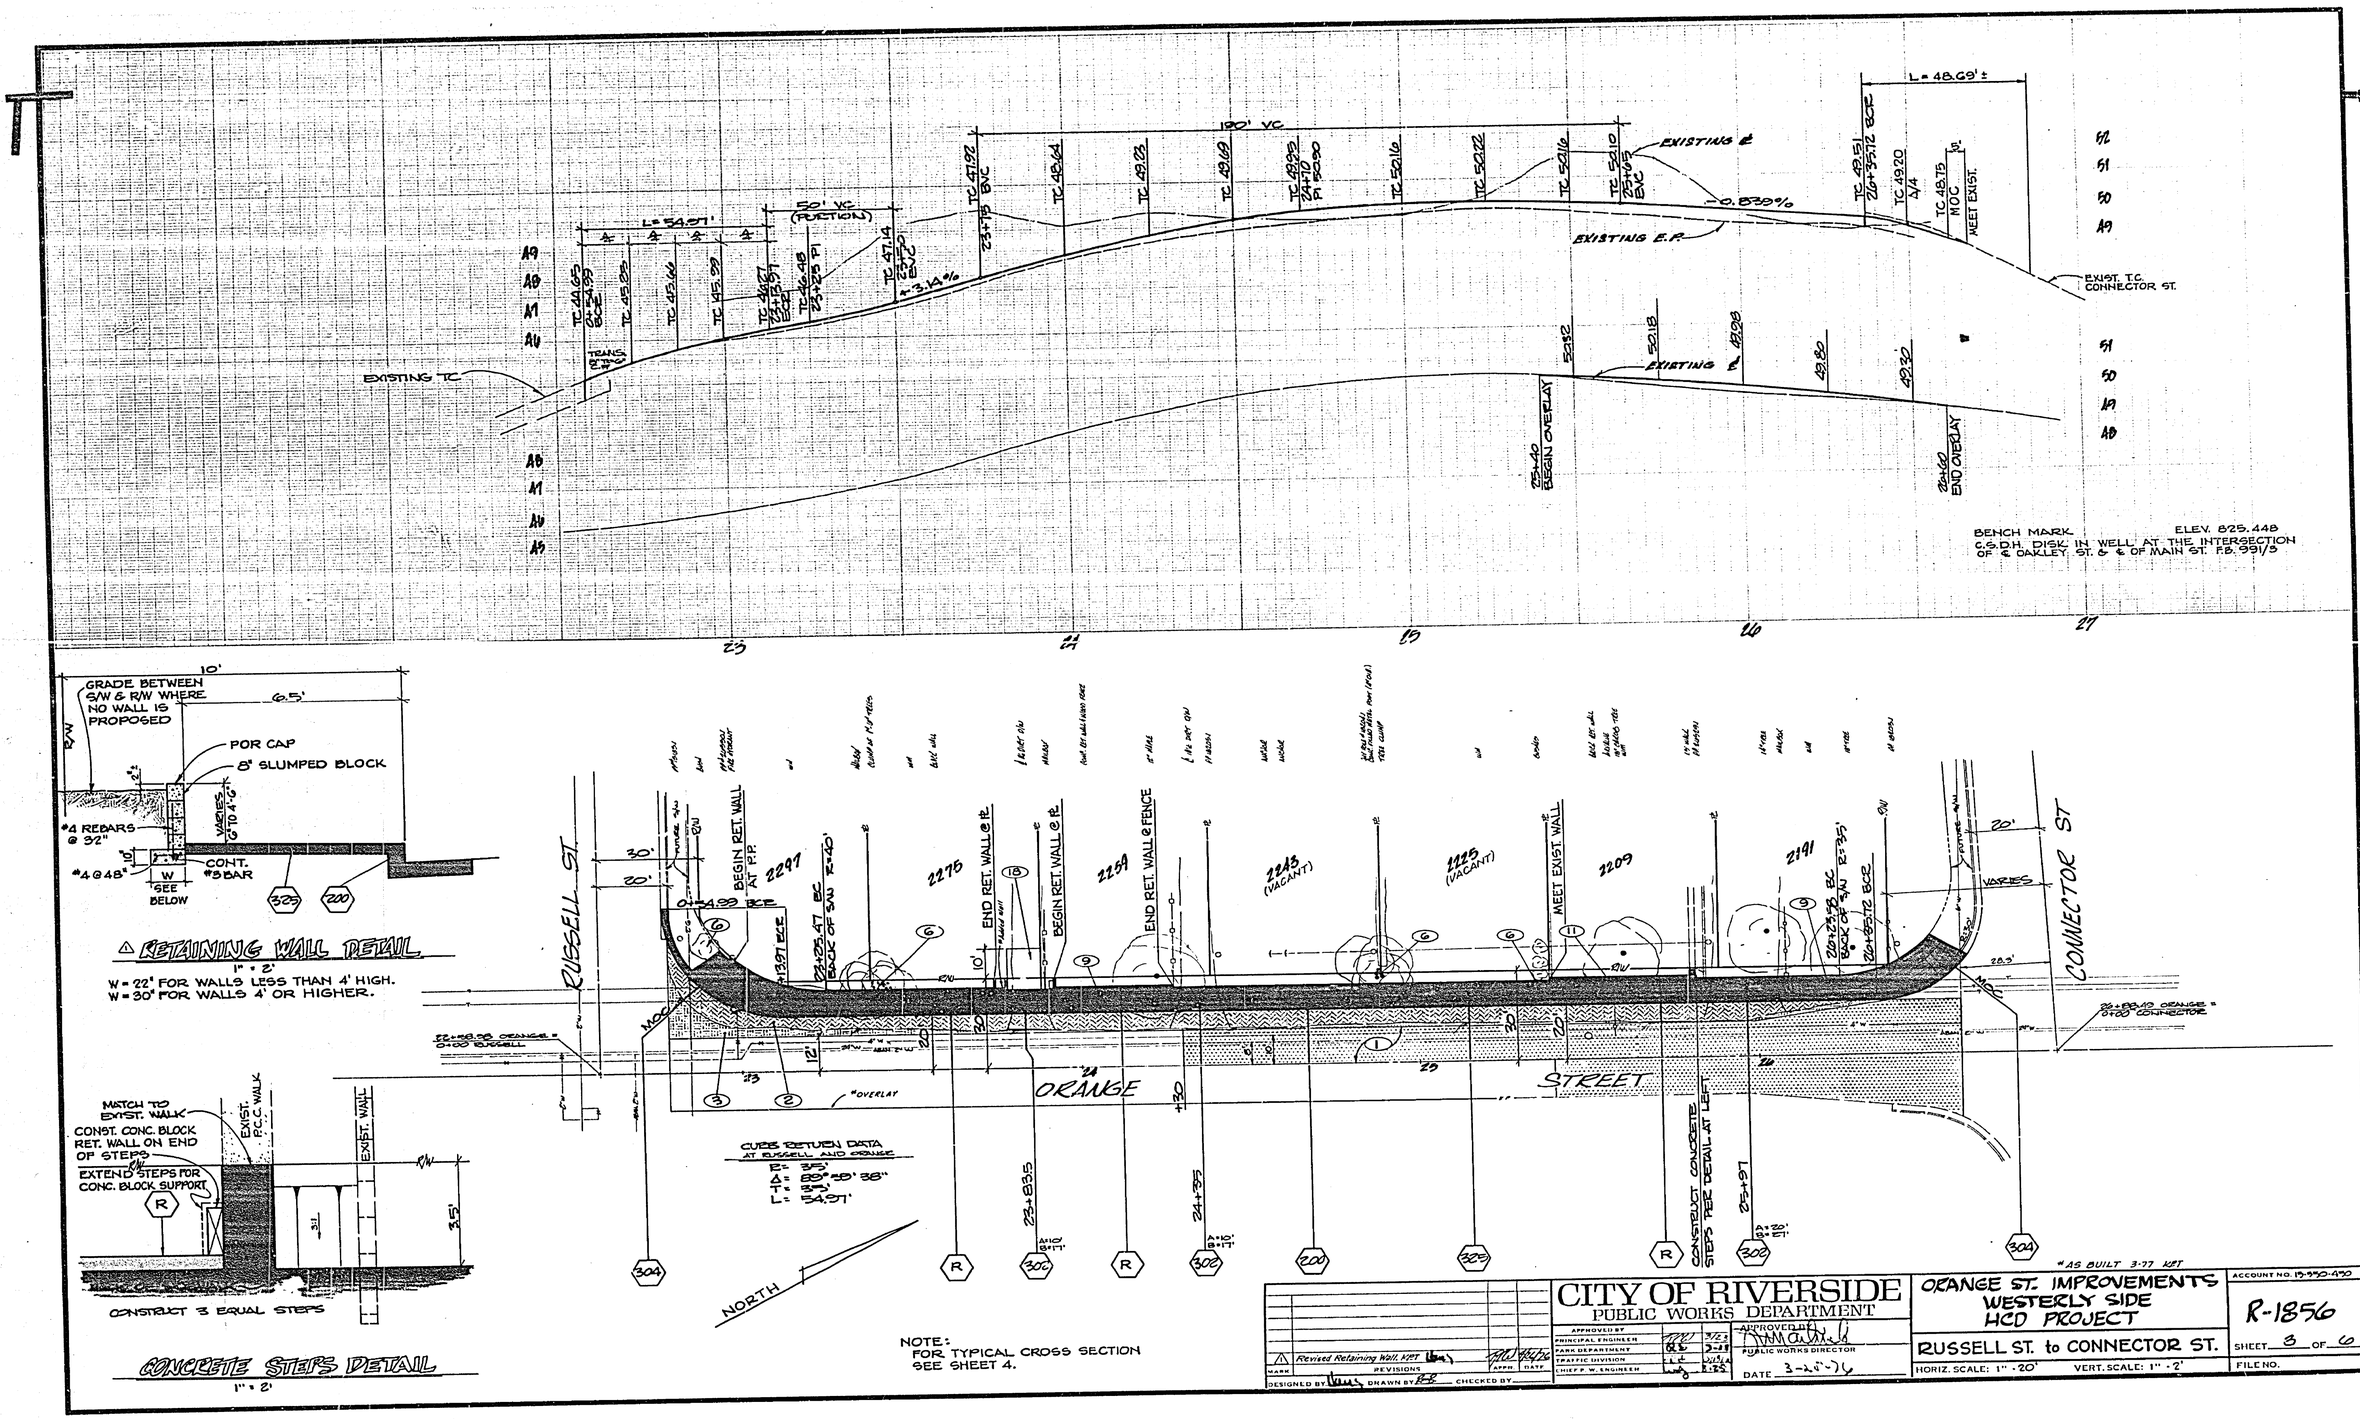

⚠ RETAINING WALL DETAIL

1" = 2'

W = 22' FOR WALLS LESS THAN 4' HIGH.
W = 30" FOR WALLS 4' OR HIGHER.

CONCRETE STEPS DETAIL

1" = 2'

⚠	Revised Retaining Wall, KPT	KPT	4/4/74	CITY OF RIVERSIDE PUBLIC WORKS DEPARTMENT	ORANGE ST. IMPROVEMENTS WESTERLY SIDE HCD PROJECT	ACCOUNT NO. 19-950-490
MARK	REVISIONS	APPR.	DATE	APPROVED BY: PRINCIPAL ENGINEER; PARK DEPARTMENT; TRAFFIC DIVISION; CHIEF P. W. ENGINEER	APPROVED BY: PUBLIC WORKS DIRECTOR DATE 3-24-76	R-1856
DESIGNED BY	DRAWN BY	CHECKED BY			RUSSELL ST. to CONNECTOR ST.	SHEET 3 OF 6
					HORIZ. SCALE: 1" = 20' VERT. SCALE: 1" = 2'	FILE NO.

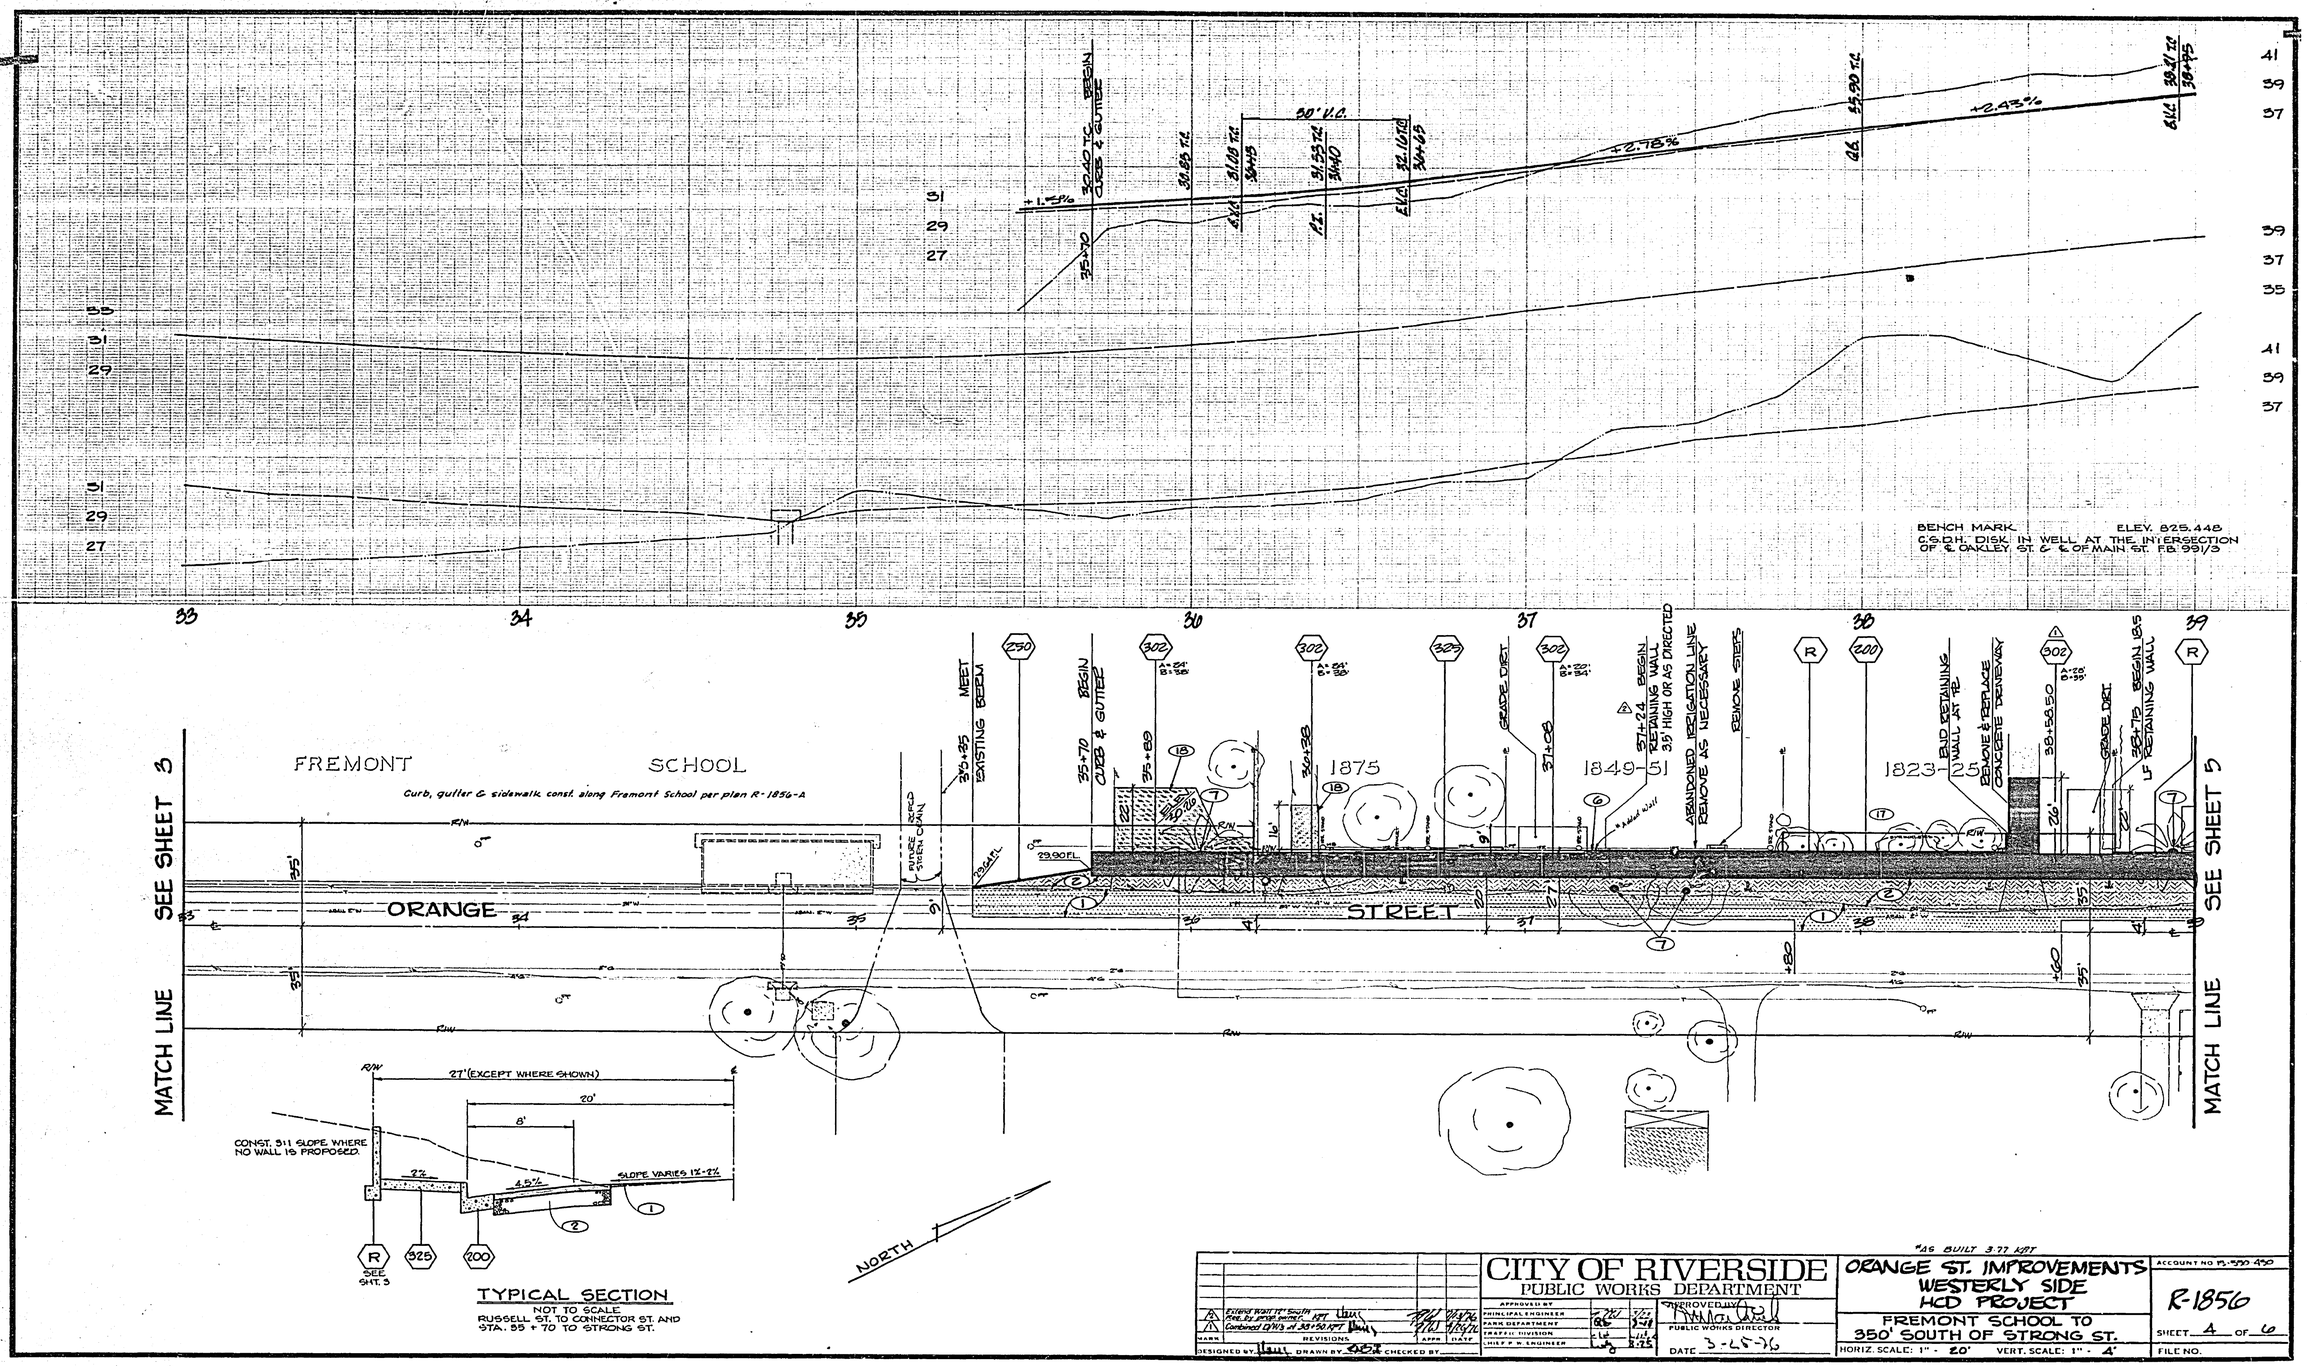

"AS BUILT 3-77 KPT

			CITY OF RIVERSIDE PUBLIC WORKS DEPARTMENT	ORANGE ST. IMPROVEMENTS WESTERLY SIDE HCD PROJECT FREMONT SCHOOL TO 350' SOUTH OF STRONG ST.	ACCOUNT NO 11-530 450 R-1856
2	Extend Wall 75' South	KPT	3/77	APPROVED BY: PRINCIPAL ENGINEER	DATE	APPROVED BY: PUBLIC WORKS DIRECTOR	SHEET 4 OF 6
1	Combined QTYs at 33+50 RT	KPT	8/76	PARK DEPARTMENT		DATE 3-15-76	
MARK	REVISIONS	APPR.	DATE	TRAFFIC DIVISION		HORIZ. SCALE: 1" = 20' VERT. SCALE: 1" = 4'	FILE NO.
DESIGNED BY KPT	DRAWN BY SBT	CHECKED BY		CHIEF P. W. ENGINEER			

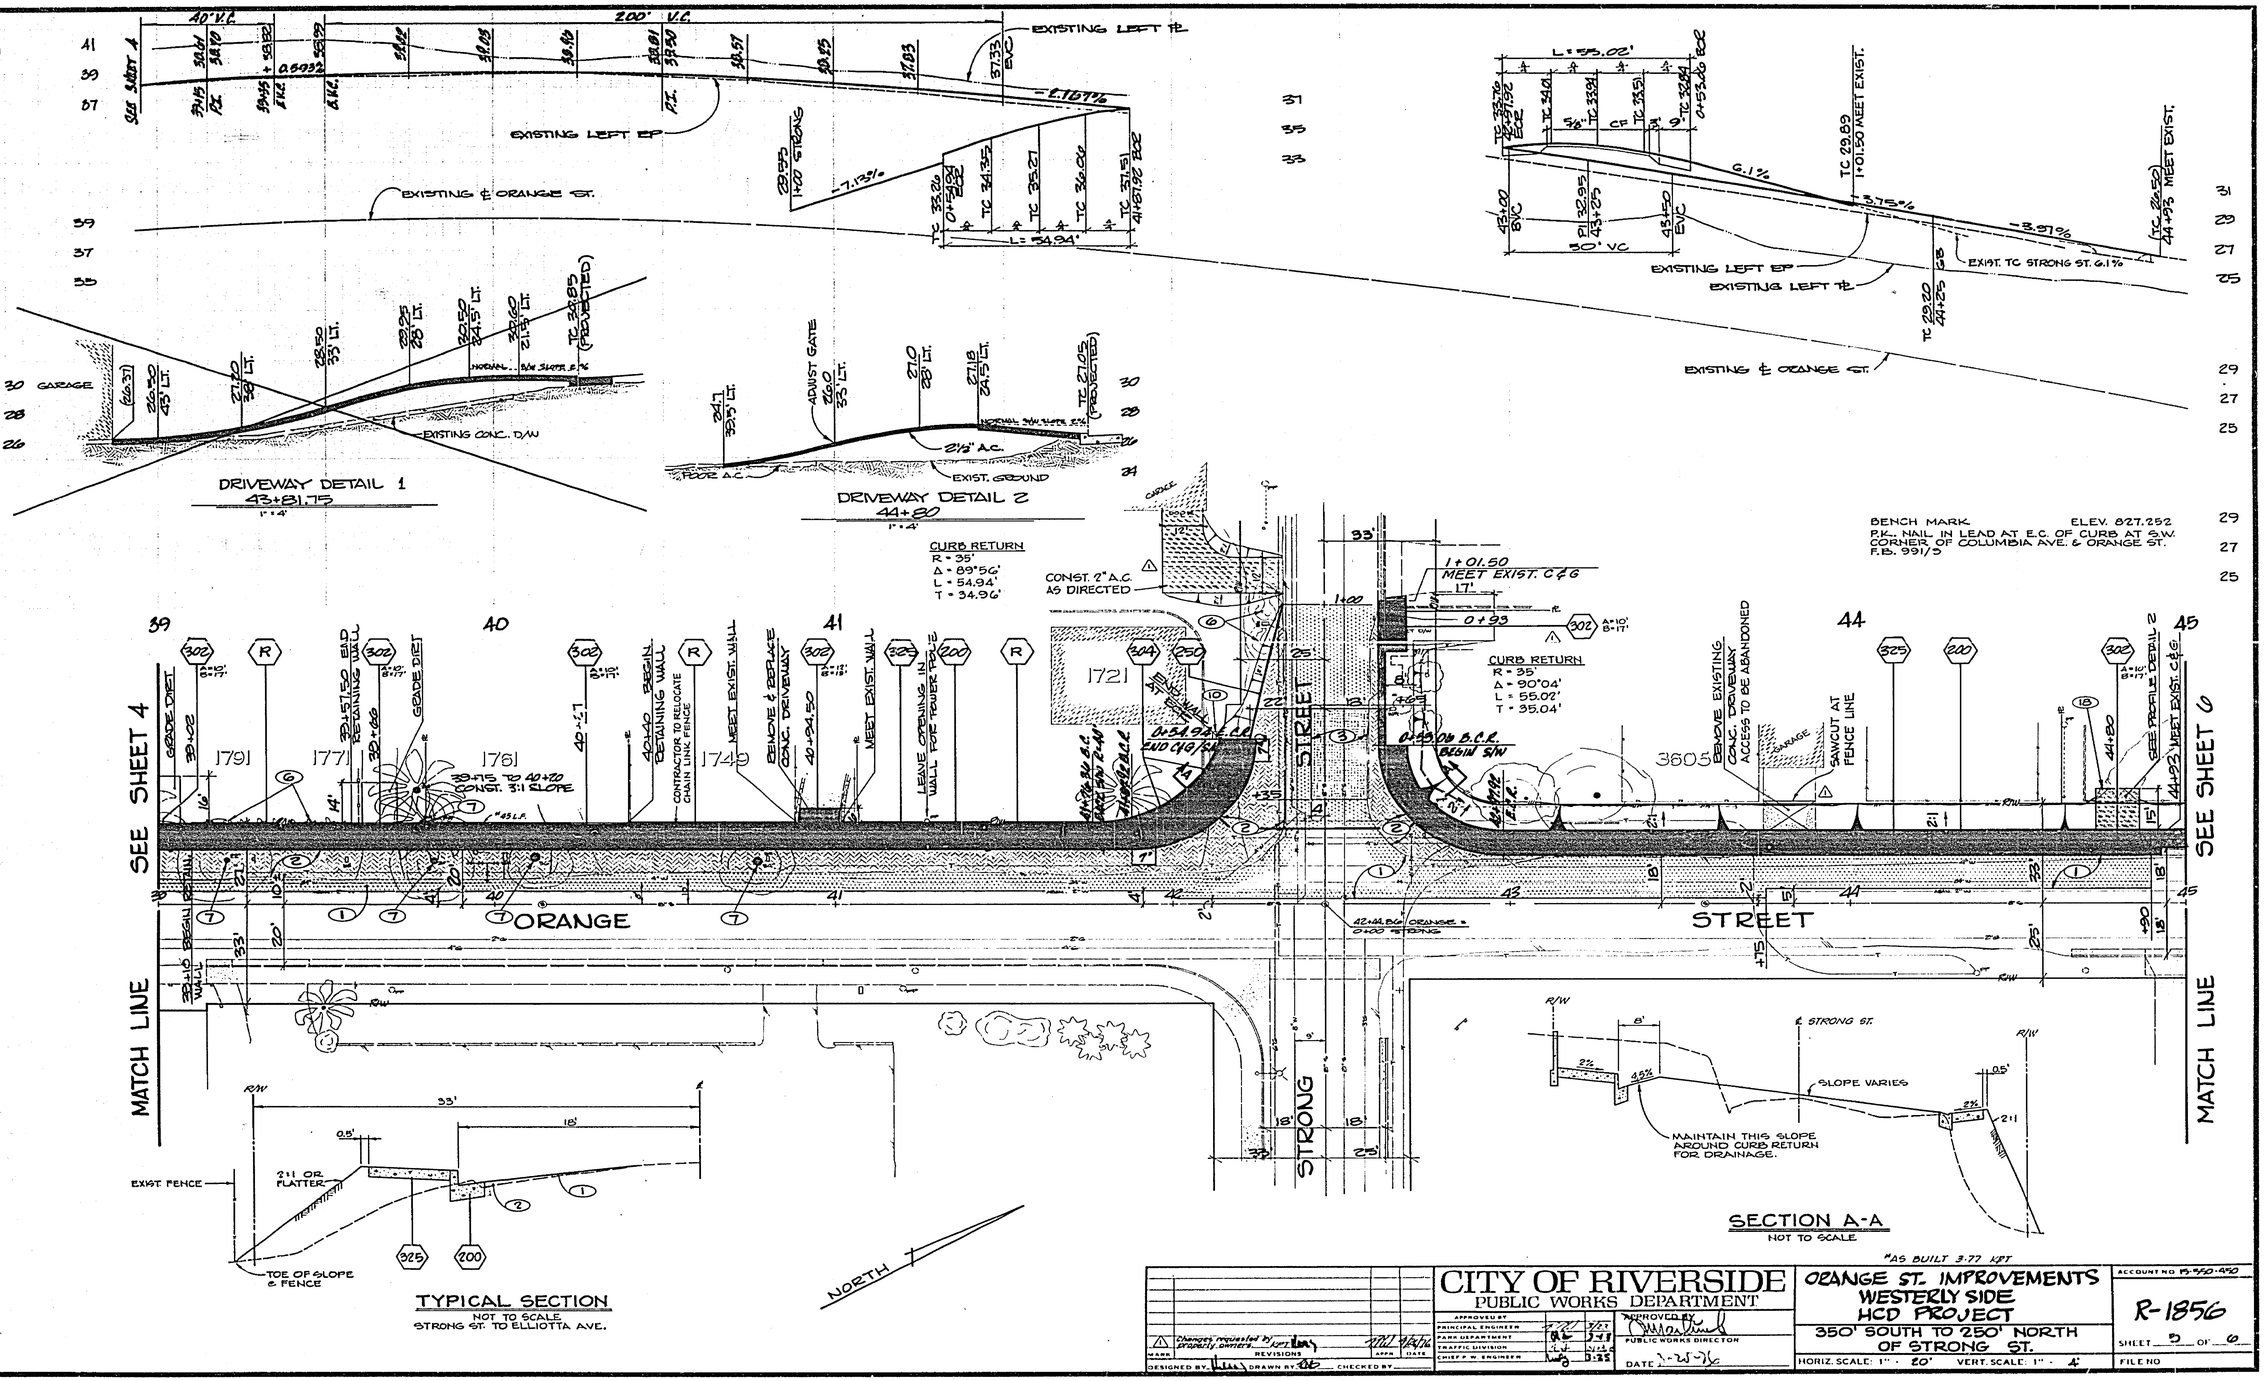

BENCH MARK ELEV. 827.252
P.K. NAIL IN LEAD AT E.C. OF CURB AT S.W. CORNER OF COLUMBIA AVE. & ORANGE ST.
P.B. 991/5

TYPICAL SECTION
NOT TO SCALE
STRONG ST. TO ELLIOTTA AVE.

SECTION A-A
NOT TO SCALE

"AS BUILT 3-77 KPT

CITY OF RIVERSIDE
PUBLIC WORKS DEPARTMENT

ORANGE ST. IMPROVEMENTS
WESTERLY SIDE
HCD PROJECT
350' SOUTH TO 250' NORTH OF STRONG ST.

HORIZ. SCALE: 1" = 20' VERT. SCALE: 1" = 4'

ACCOUNT NO 15-550-450

R-1856

SHEET 5 OF 6

FILE NO

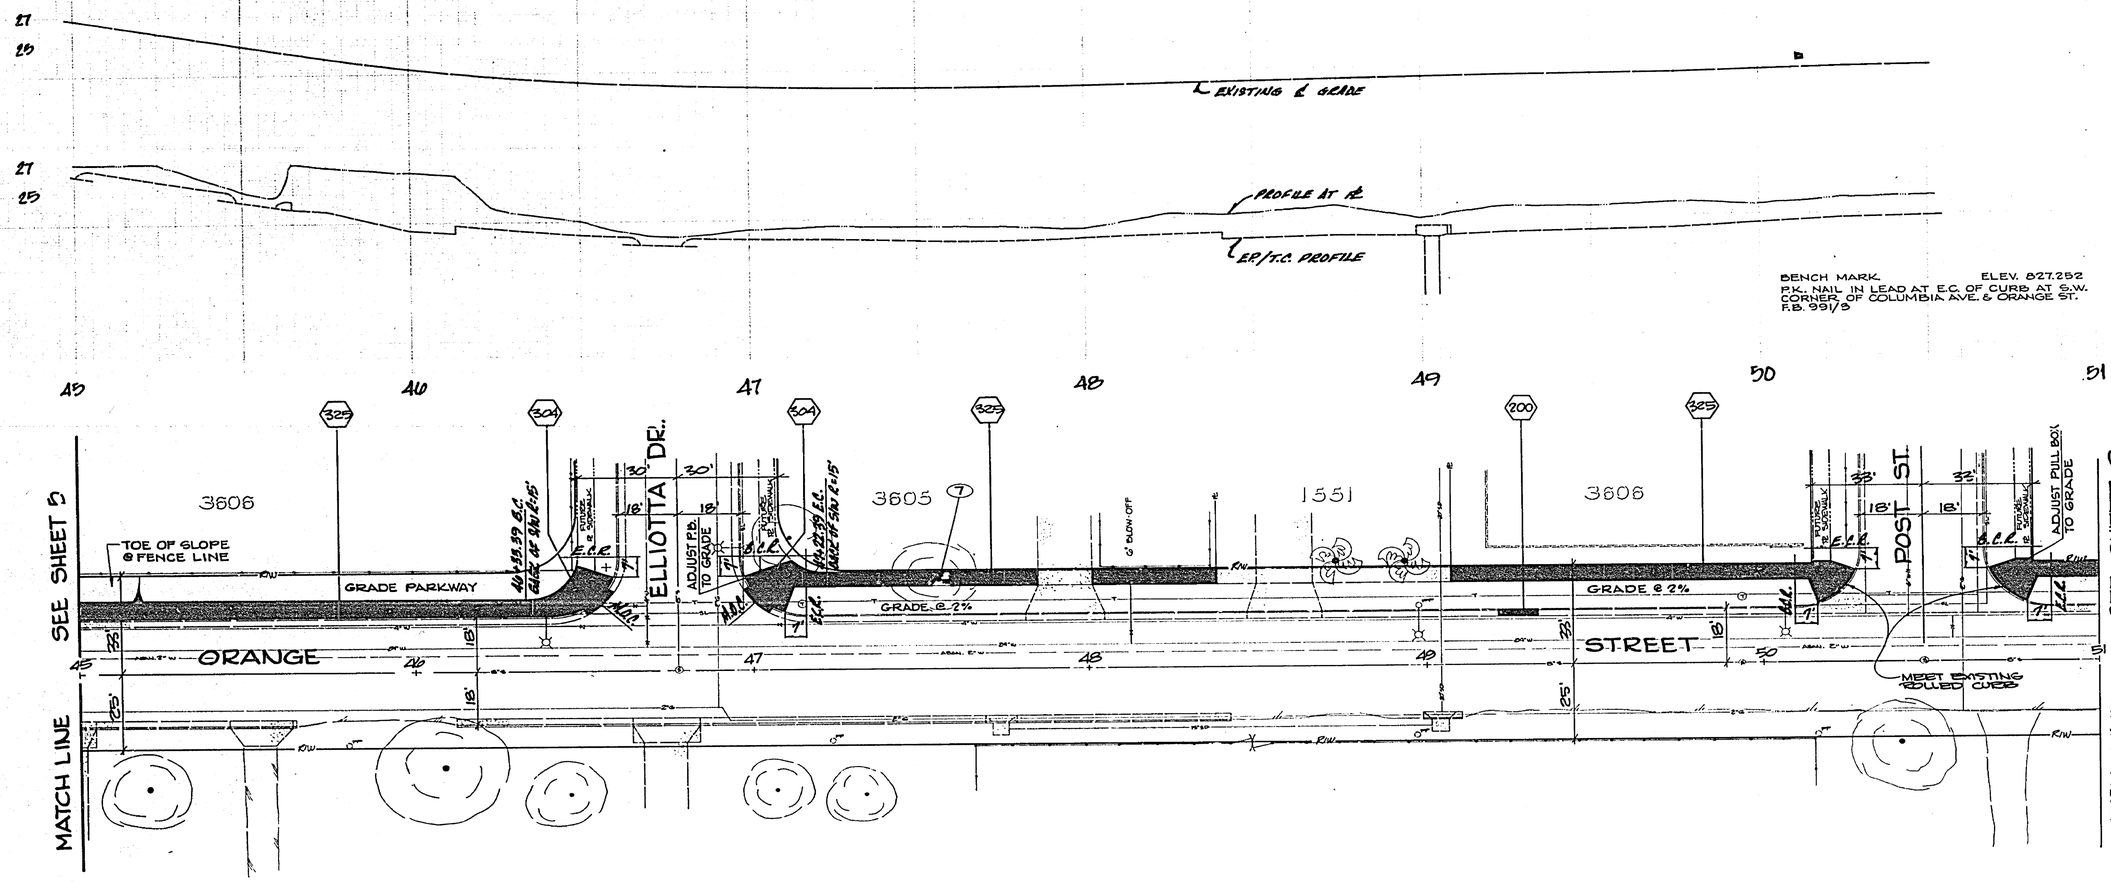

"AS BUILT 3-77 KDT

MARK	REVISIONS	APPR	DATE		
DESIGNED BY [illegible]	DRAWN BY DE	CHECKED BY			

CITY OF RIVERSIDE
PUBLIC WORKS DEPARTMENT

APPROVED BY			
PRINCIPAL ENGINEER			
PARK DEPARTMENT			
TRAFFIC DIVISION			
CHIEF P. W. ENGINEER			

APPROVED BY
PUBLIC WORKS DIRECTOR
DATE 3-17-76

ORANGE ST. IMPROVEMENTS WESTERLY SIDE HCD PROJECT

250' NORTH OF STRONG ST. TO POST ST.

HORIZ. SCALE: 1" - 20' VERT. SCALE: 1" - 4'

ACCOUNT NO. 15-5550-450

R-1856

SHEET 6 OF 6

FILE NO.