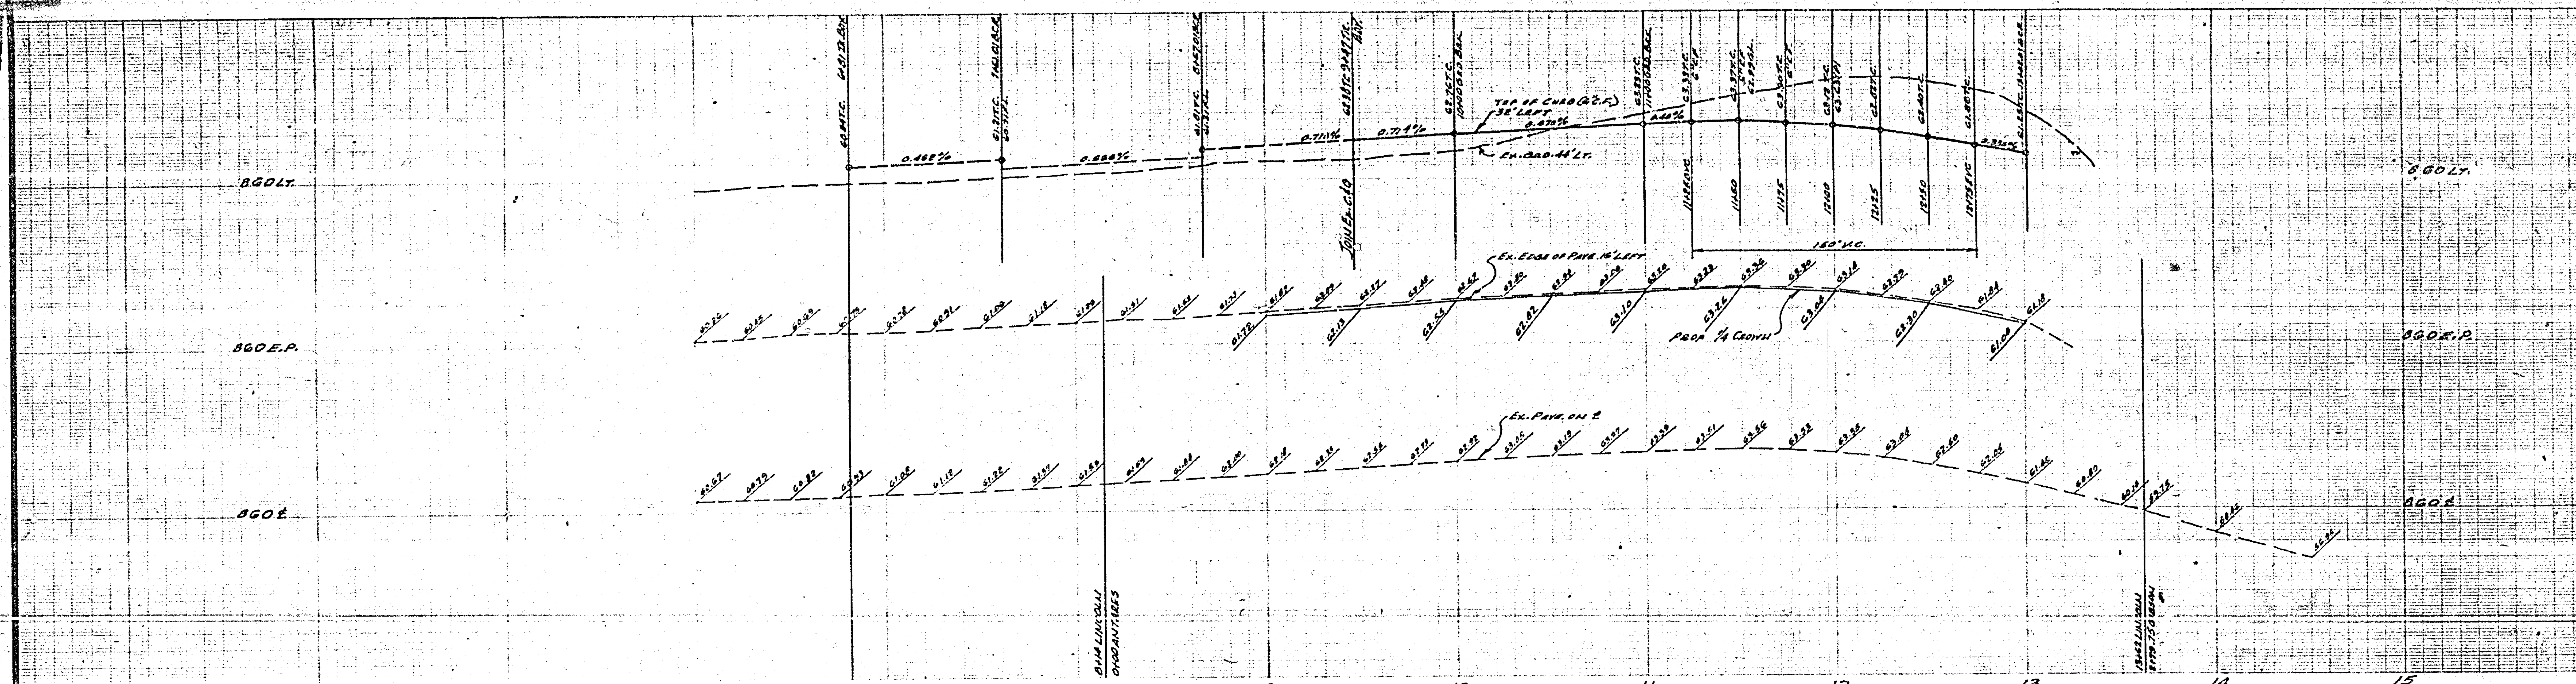

BENCH MARK ELEV. 881.950
Top of Brass Disk E4-B (capped) at the intersection of Van Buren Blvd. and Victoria Ave. C/R F.B. 735/43.

CONSTRUCTION NOTES

1. CONSTRUCTION SHALL BE IN ACCORDANCE WITH STANDARD SPECIFICATIONS FOR PUBLIC WORKS CONSTRUCTION, 1976 EDITION.
2. TRIM EDGE OF EXIST. PAVEMENT WHERE NEW PAVEMENT JOINS TO A SMOOTH STRAIGHT LINE. CONSTRUCT MATCH-UP PAVING AS SHOWN ON THE PLAN.

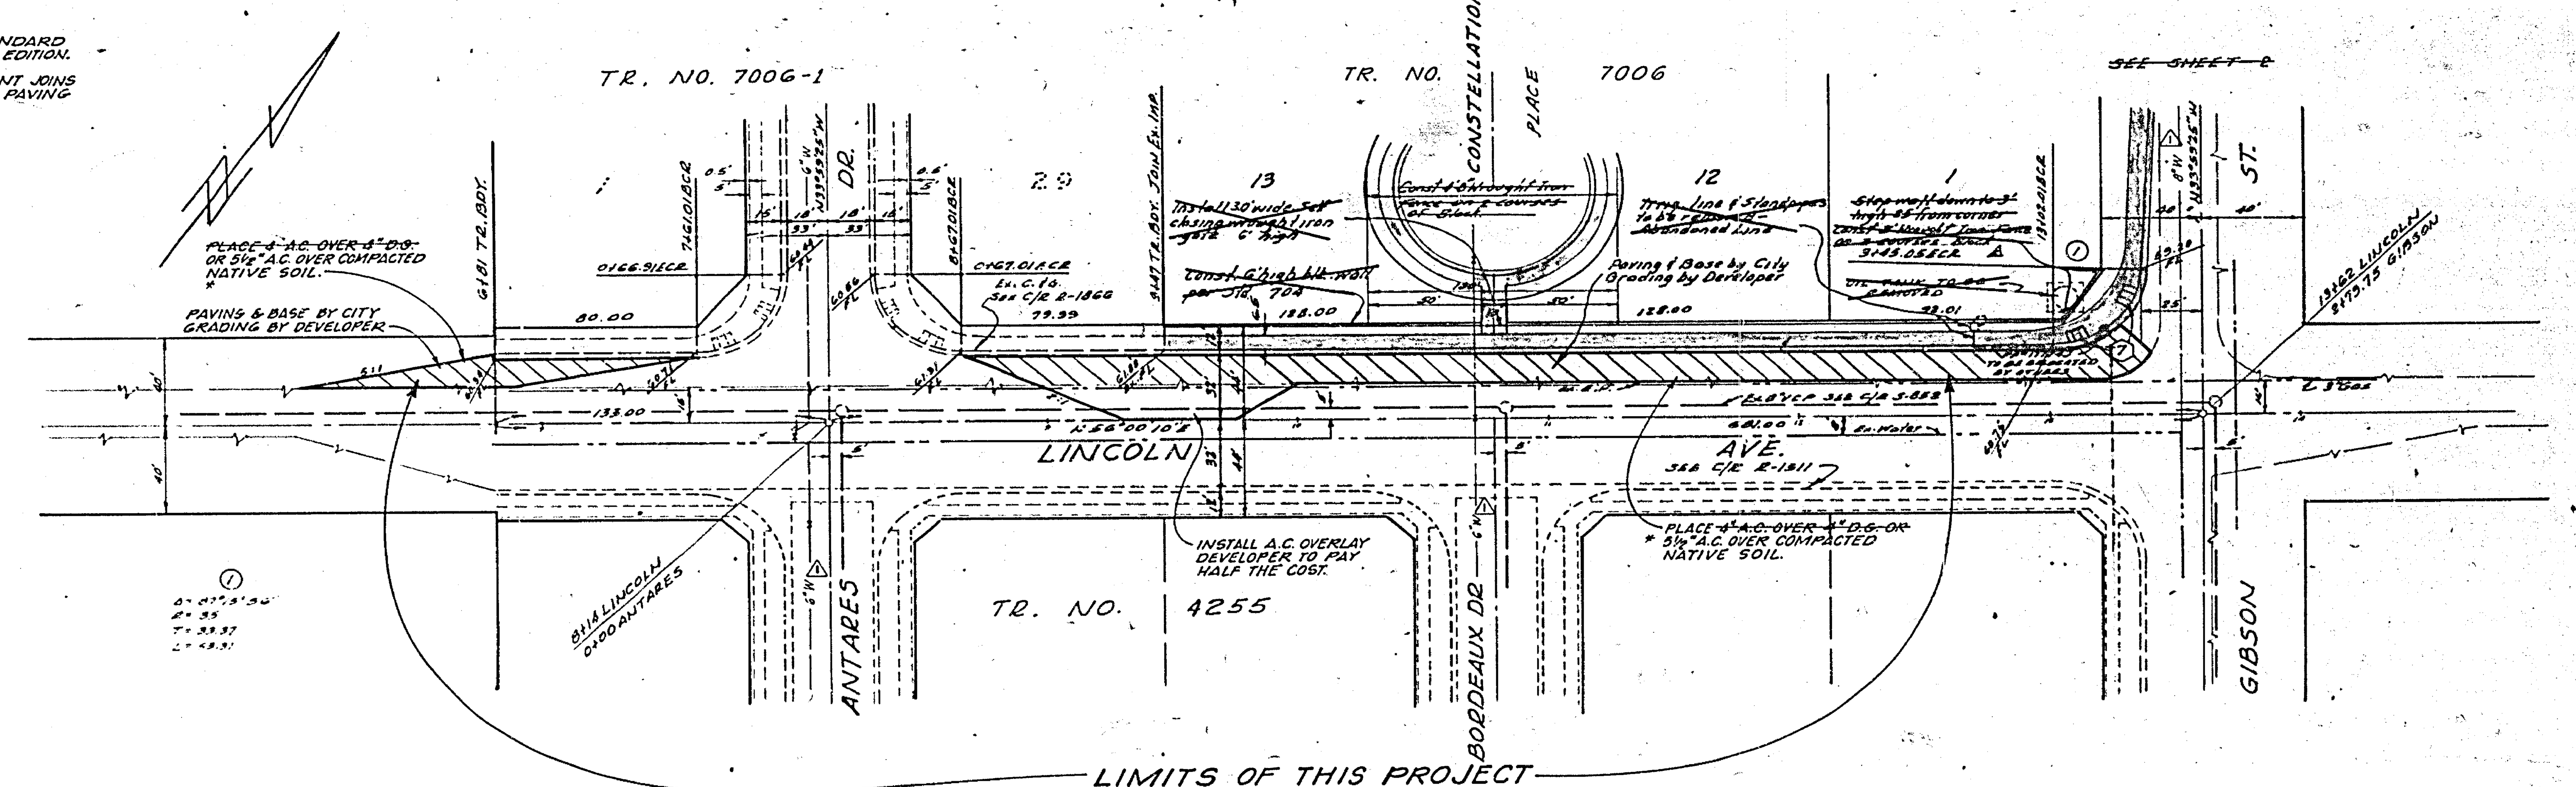

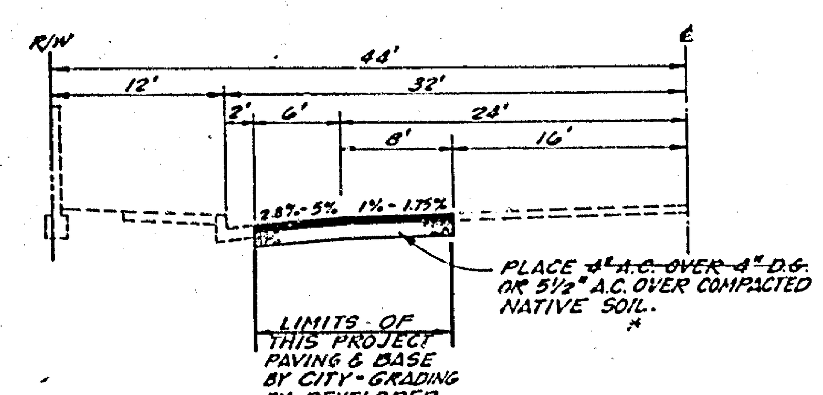

TYPICAL SECTION
NOT TO SCALE
T.I. = 7

*AS BUILT 3-77 KPT

ALBERT A. WEBB ASSOCIATES
CIVIL ENGINEERS
RIVERSIDE, CALIFORNIA
APPROVED BY ________ DATE 2/3/76
R.E. No. 9874
W.O. 75-217 FOR: HUNTLEY HOUSING F.B. 1037

MARK	REVISIONS	APPR.	DATE
1	Added Water Lines KPT		

DESIGNED BY EEC DRAWN BY EEC CHECKED BY EDH

CITY OF RIVERSIDE, CALIFORNIA
PUBLIC WORKS DEPARTMENT

APPROVED BY	BY	DATE
PRINCIPAL ENGINEER		
PARK DEPARTMENT		
TRAFFIC DIVISION		
CHIEF PUB. WKS. ENGR.		

APPROVED BY ________
DIRECTOR OF PUBLIC WORKS
DATE 12-16-76

STREET PLAN AND PROFILE
LINCOLN AVENUE PAVEMENT PARTICIPATION WITH TRACTS 7006 & 7006-1
130' WESTERLY OF ANTARES DR. TO GIBSON ST.
SCALE: HORIZ. 1"=40' VERT. 1"=4'

ACCOUNT No. 30-575-384-07
DRAWING NUMBER
R-1871-A
SHEET 1 OF 1
75-217-A

ADAPTED FROM PLANS R-1866 & R-1871