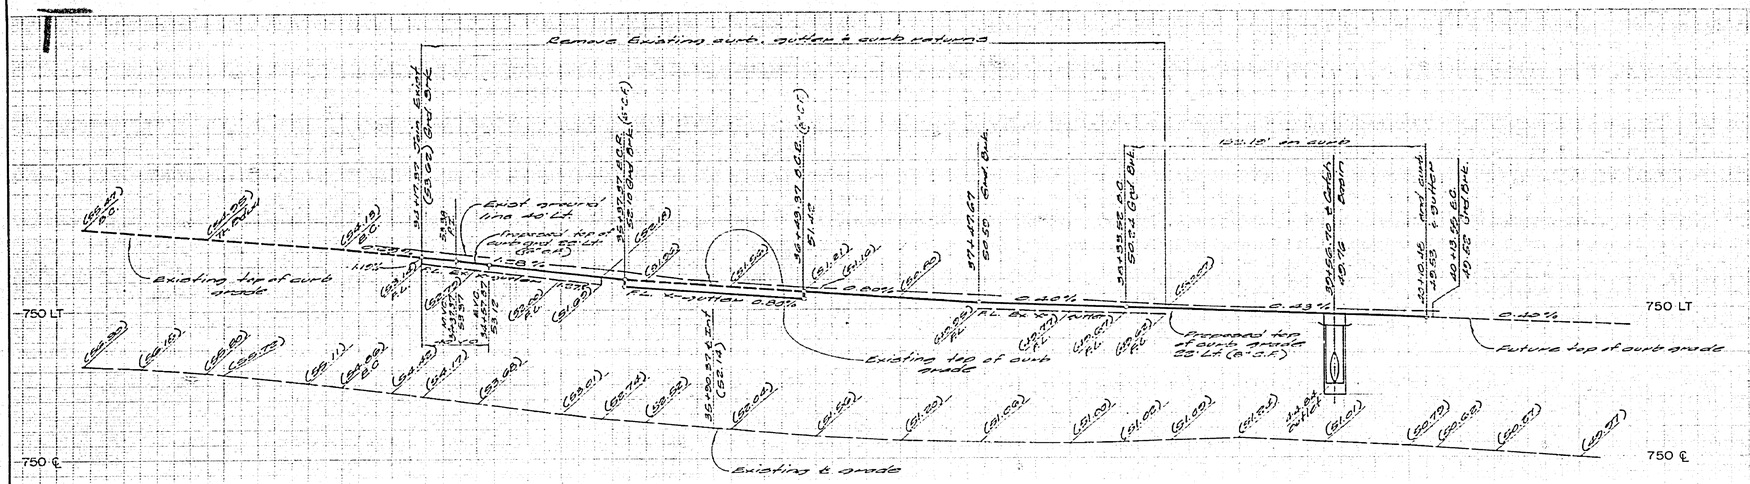

STREET NAME & TRAFFIC SIGN SCHEDULE		
Ⓐ	CURRAN DR.	4400
	CHALLEN AVE.	4400
Ⓑ	CURRAN DR.	4400
	CARLSON PL.	4400
Ⓒ	BARTEL DR.	4400
	CARLSON PL.	4400
Ⓓ	DELLA ST.	7600
	BARTEL DR.	4400
Ⓔ	REMINGTON DR.	4400
	BARTEL DR.	7600
Ⓕ	R-1 (STOP SIGN) 30" OCTAGON	
Ⓖ	W 53 (NOT A THROUGH STREET)	24" x 24"

BENCH MARK

(Ⓐ-D) R.E. nail in N'ly curb return at Van Buren Blvd. & California Ave. C.O.R.D. 65/10. Elevation = 788.917

CONSTRUCTION NOTES

1. Construct R.C.C. curb & gutter per std. No. 200 (6" curb face)
2. Construct R.C.C. sidewalk per std. No. 400
3. Construct R.C.C. v-gutter per std. No. 220 (6" wide)
4. Construct wheelchair ramp per std. No. 304
5. Construct 3" A.C. paving over 12½" C.S.
6. Construct R.C.C. curb & gutter per std. No. 200 (8" curb face)

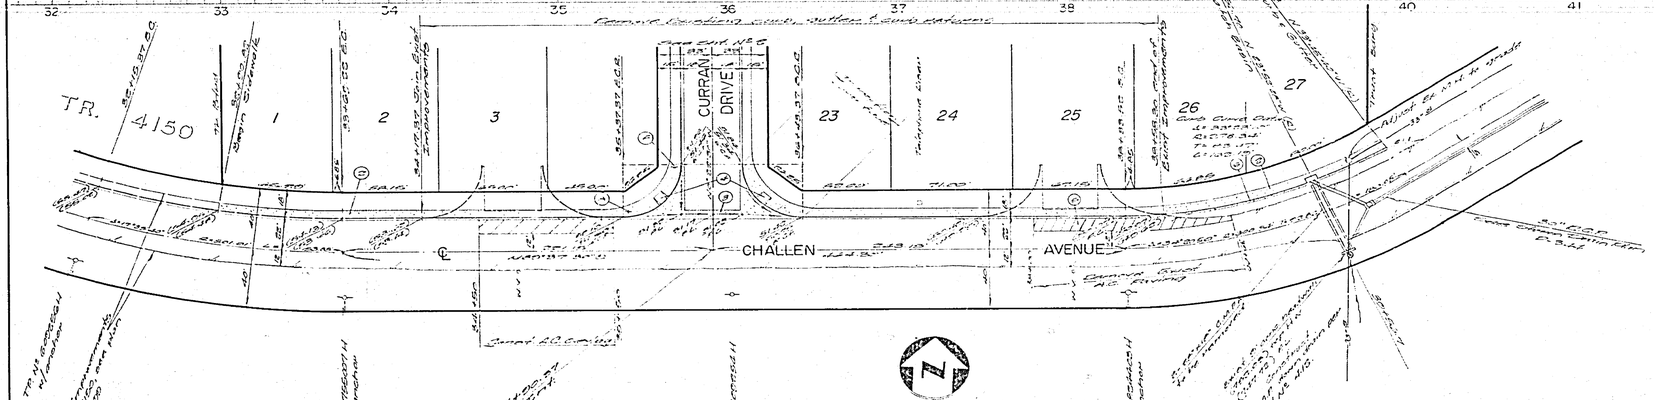
TR. 4150
CURRAN DRIVE
CHALLEN AVENUE
Remove Existing curb, gutter & curb returns

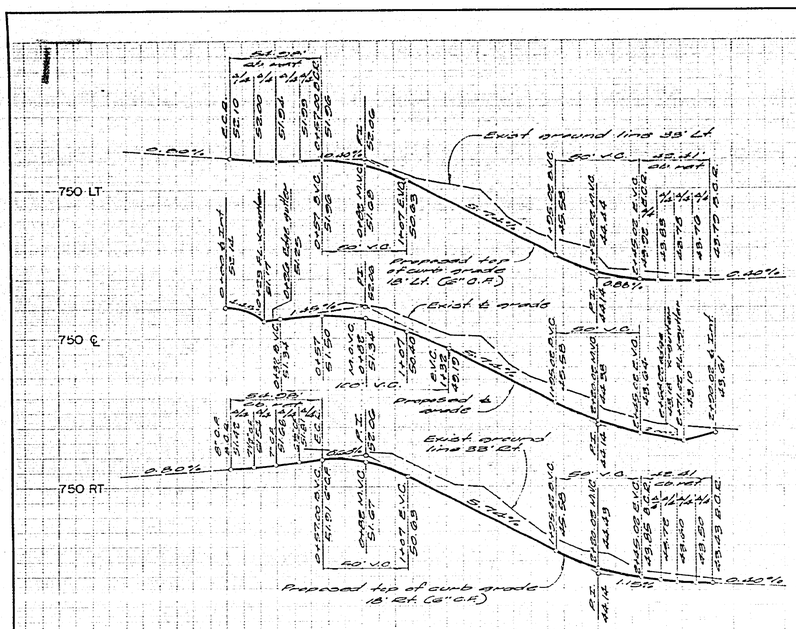

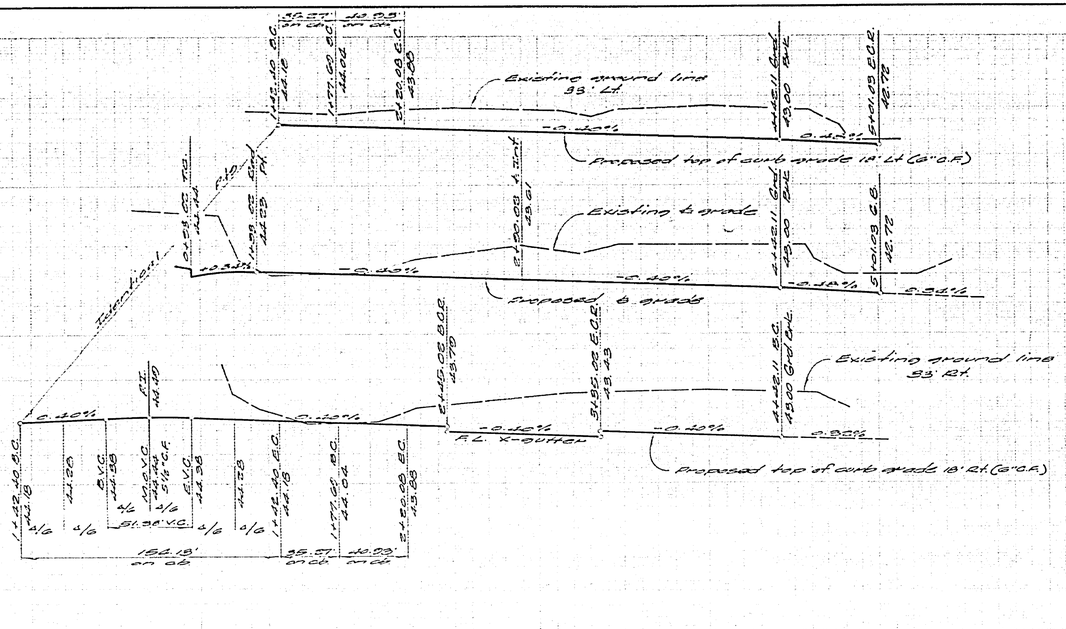

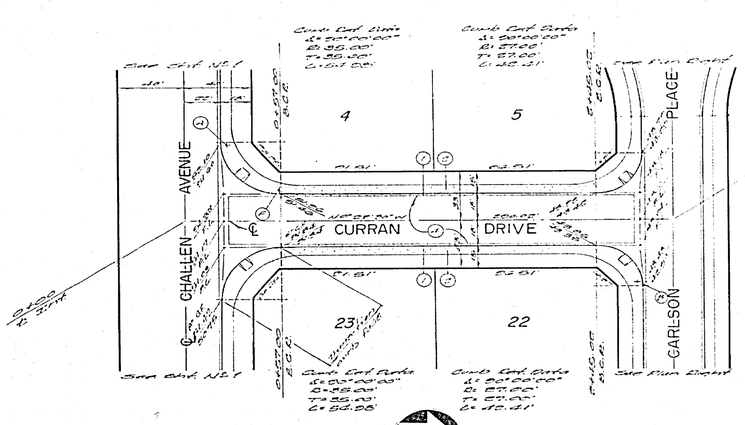

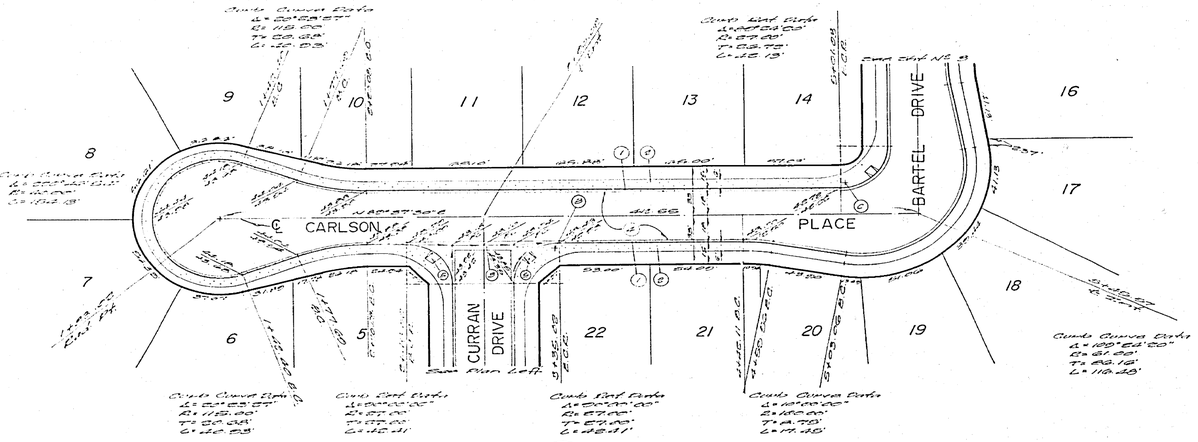

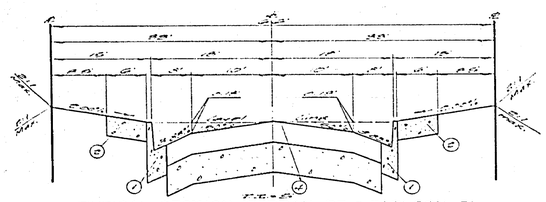

CONSTRUCTION NOTES:

1. Construct P.C.C. curb & gutter per std. No. 200 (6"O.R.)
2. Construct P.C.C. sidewalk per std. No. 400
3. Construct P.C.C. cross gutter per std. No. 200 (6" wide)
4. Construct 0.25' A.C. paving over 10" C.S.
5. Construct Wheelchair Ramp per std. No. 304.

BENCH MARK

(283-D) AC nail in N'ly curb return at Van Buren Blvd. & California Ave., 0.01' S. 80'/10 Elevation = 708.317

ENGINEERING COMPANY			
WES	Public Works • Land Development • Planning		
	3272 North E Street, Suite D		
	San Bernardino, California 92405		
	714/883-8663		
William E. Street	7-7-77		
William E. Street R.C.E. 19452	Date		
REVISIONS			
Mark	Description	Date	Initial
1	Added paving section per SR 985 (2010)	7-10-78	

* AS BUILT 2-24-78 BLP INDEXED BG

CITY OF RIVERSIDE, CALIFORNIA PUBLIC WORKS DEPARTMENT		
APPROVED BY	BY	DATE
PRINCIPAL ENGINEER	BMS	3-1-78
PARK DEPARTMENT		
TRAFFIC DIVISION	TCE	3-6-78
CHIEF PUB WKS ENGR	WJS	3-24-78

APPROVED BY: Robert L. Wilder, DIRECTOR OF PUBLIC WORKS
DATE 3/24/78

STREET PLAN & PROFILE
CURRAN DRIVE
CARLSON PLACE
TRACT NO. 9235-1
SCALE: Horiz. 1"=50', Vert. 1"=5'

ACCOUNT No.
DRAWING NUMBER
R-2066
SHEET 2 OF 4

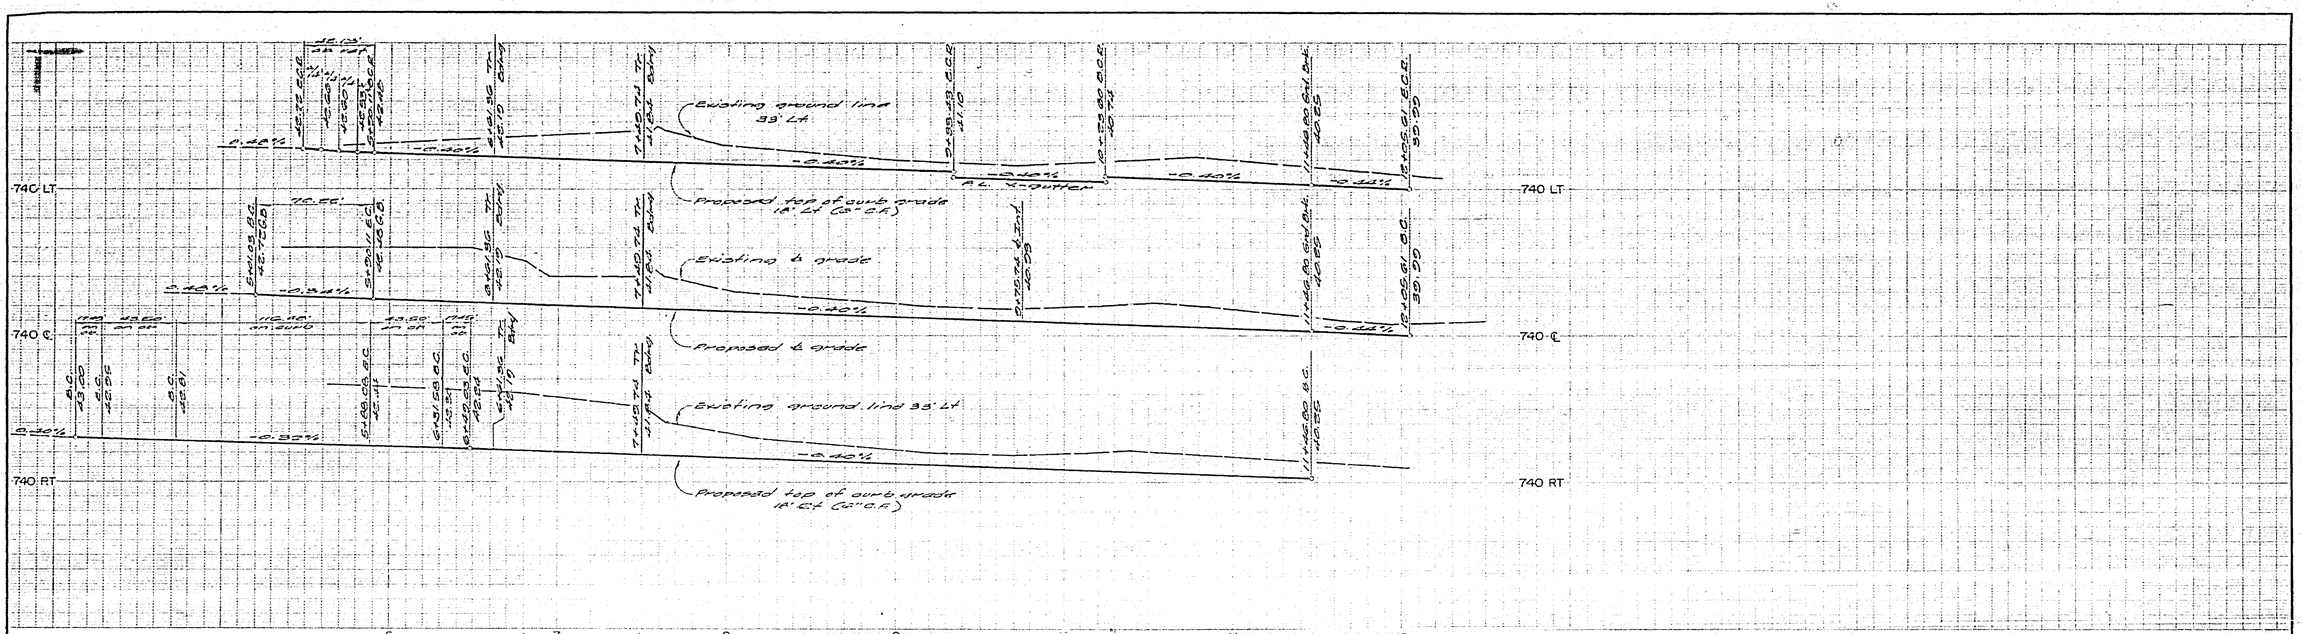
740 LT
740 ℄
740 RT
Existing ground line 33' LT
Existing ℄ grade
Proposed ℄ grade
Existing ground line 33' LT
-0.40%
-0.32%
-0.30%
-0.44%
-0.48%
-0.34%
-0.40%
-0.40%
-0.40

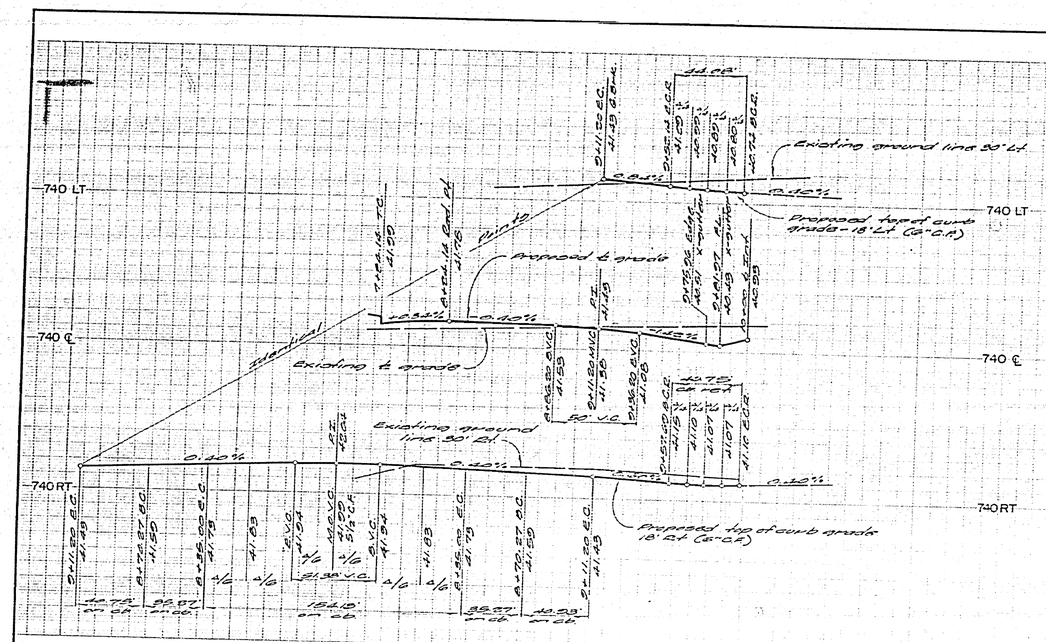

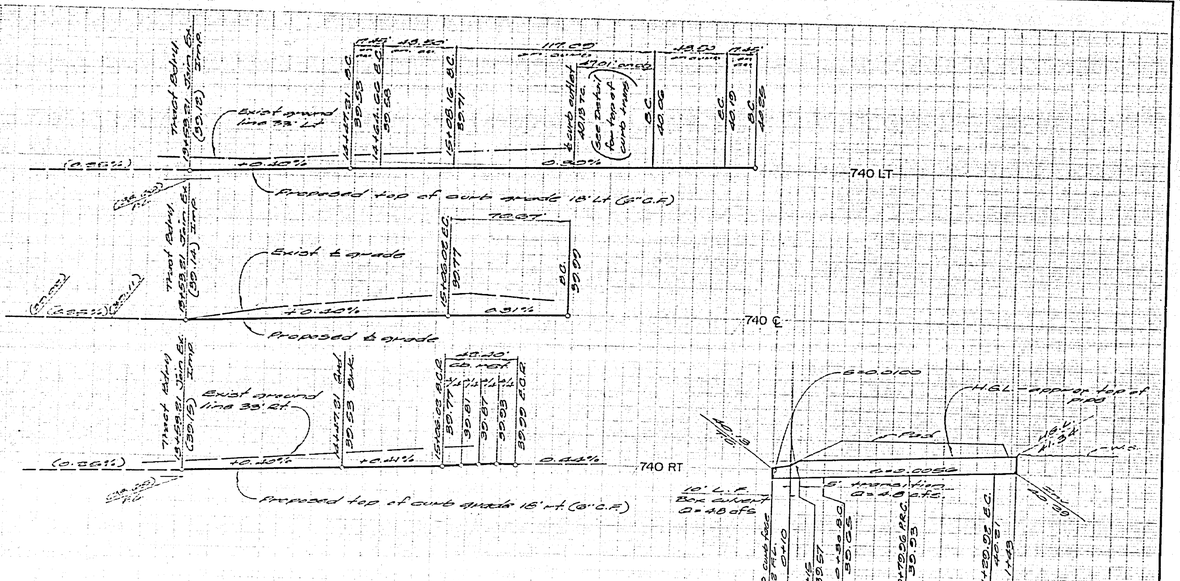

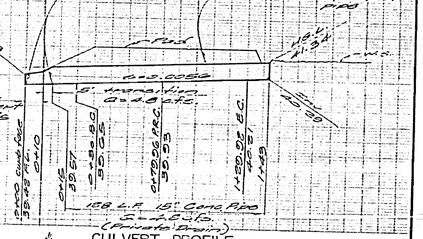

CULVERT PROFILE

TR. NO. 4147

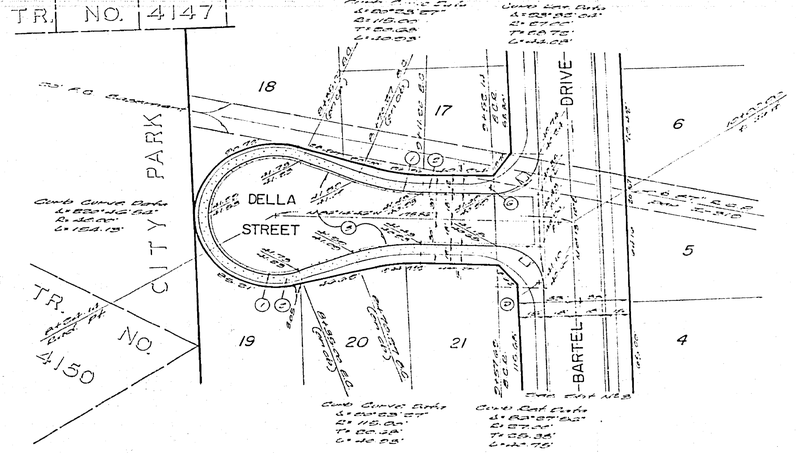

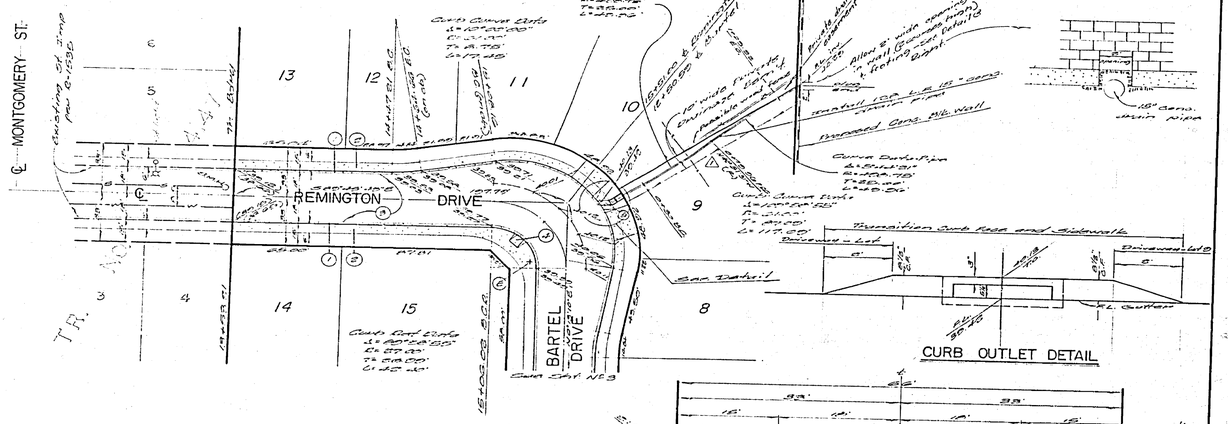

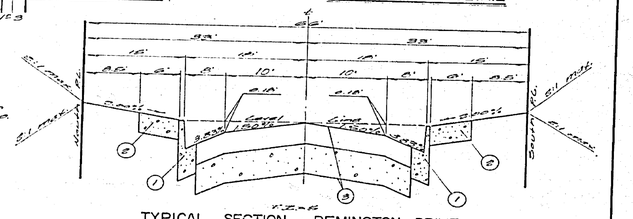

CURB OUTLET DETAIL

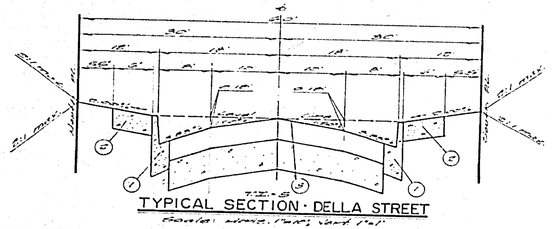

TYPICAL SECTION · DELLA STREET

Scale: Horiz. 1"=5', Vert. 1"=1'

TYPICAL SECTION · REMINGTON DRIVE

Scale: Horiz. 1"=5', Vert. 1"=1'

CONSTRUCTION NOTES

1. Construct P.C.C. curb & gutter per std. No. 200 (2C.A.R.)
2. Construct P.C.C. sidewalk per std. No. 224
3. Construct 2½" A.C. paving over 10" C.A.B.
4. Construct Wheelchair Ramp per std. No. 304.
5. Construct "Cross Gutter per std. No. 210

BENCH MARK

(TBM-2) Pk nail in N'ly curb return at Van Buren Blvd & California Ave., C.G.S.B.S. 1929 Elevation, = 768.84 M.M.

WES ENGINEERING COMPANY
Public Works • Land Development • Planning
3672 North E Street, Suite D
San Bernardino, California 92405
714-885-6063

William E. Smith
William E. Smith R.C.E. 11442

7-7-77
Date

Mark	Description	Date	Initial
1	Added paving section per 62.205 (2C.A.R.)	5-1-78	
2	Revised curb return & lot lines - Main Drive	12-7-78	

REVISIONS

AS BUILT 2-20-80 RJD

CITY OF RIVERSIDE, CALIFORNIA
PUBLIC WORKS DEPARTMENT

APPROVED BY	BY	DATE
PRINCIPAL ENGINEER		
PARK DEPARTMENT		
TRAFFIC DIVISION		
CHIEF PUB WKS ENGR.		

APPROVED BY
DIRECTOR OF PUBLIC WORKS
DATE 3/29/78

STREET PLAN & PROFILE

REMINGTON DRIVE
DELLA STREET
TRACT NO. 9235

SCALE: Horiz. 1"=40', Vert. 1"=4'

INDEXED & A
ACCOUNT No.
DRAWING NUMBER
R-2066
SHEET 4 OF 4