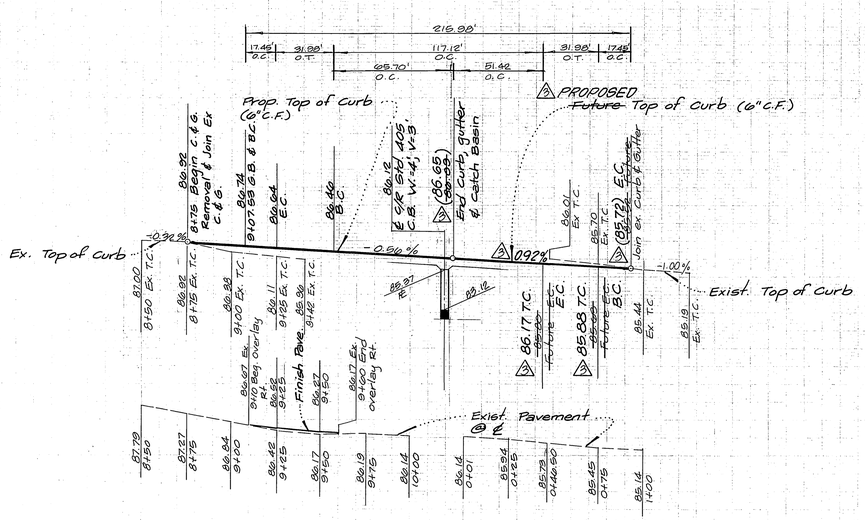

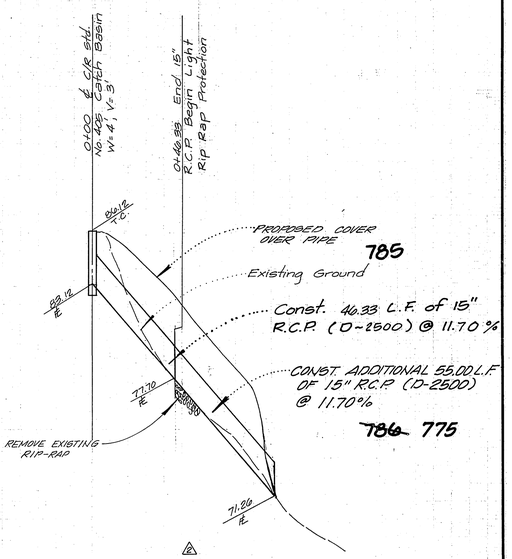

PROFILE "A"

8 9 10

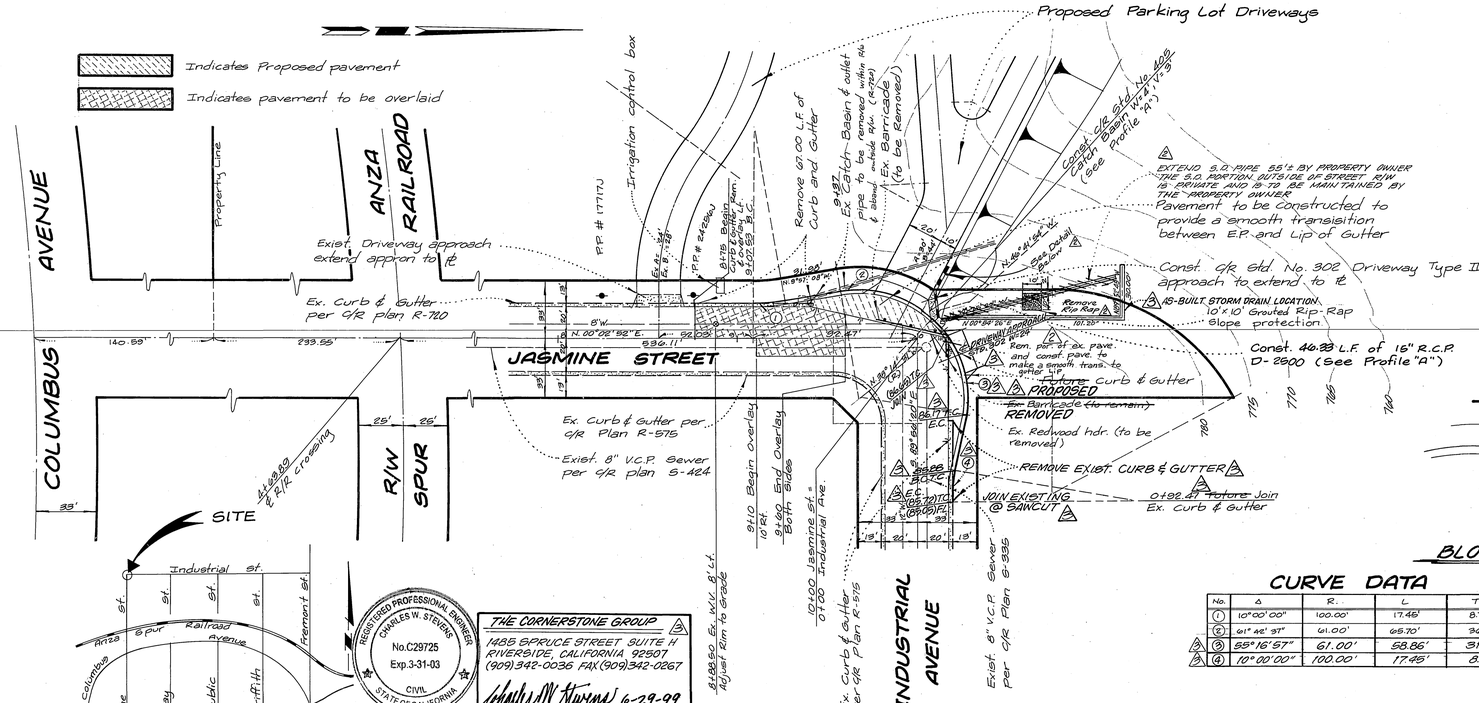

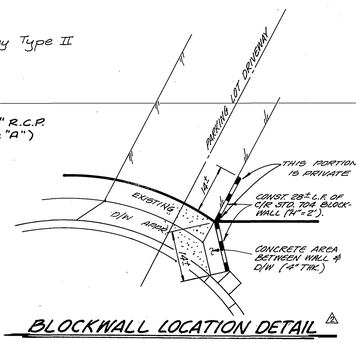

BLOCKWALL LOCATION DETAIL

GENERAL NOTES

1. The private engineer signing these plans is responsible for the accuracy and acceptability of the work hereon. In the event of discrepancies arising during construction, the private engineer signing these plans shall be responsible for determining an acceptable solution and revising the plans for approval by the City.
2. Constructed shall be in accordance with Standard Specifications for Public Works Construction ~~1979~~ 1992 Edition and per City of Riverside Std. Drawings.
3. All flagged elevations shall be staked in the field by the engineer.
4. The Subdivider shall arrange for a soil test to be made by a Soils Engineer after the streets have been prepared to rough grade. Depth of base materials and A.C. pavement shall be determined by the City of Riverside Standards and Test Procedures.
5. Location and size of driveway approaches (Std. 302) to be determined at the time of construction as approved by the Traffic Engineer.
6. Curb and Gutter to be staked on 3' offset at 25' intervals.
7. Trim edge of existing pavement where new pavement joins, to a smooth straight line. Construct match up paving as shown on the plans and overlay paving as directed in the field to produce a smooth surface.
8. It shall be the responsibility of the Contractor to clear the right of way in accordance with the provisions of law as it affects each utility including irrigation lines and appurtenances, and at no cost to the City.
9. The Contractor shall contact the Public Service Department (787-7251) to pick up any exist. std. 180 Barricades that are being removed.
10. Quantities shown are for information only and the City of Riverside is not responsible for their accuracy.
11. Developer to give City Water Division five (5) working days written notice prior to start of construction and to allow city ten (10) working days for completion of work. (787-7011)

QUANTITIES

3" A.C. Pavement	900	S.F.
A.B. 3 10"	900	S.F.
Catch Basin Std. No. 405	1	Ea.
15" R.C.P.	50	L.F.
Rip Rap	100	S.F.
Curb & Gutter Removal	67	L.F.
Barricade Removal	40	L.F.
6" C.F.	14.3	L.F.
Overlay	18	Tons
Pavement Removal	14	S.F.

CURVE DATA

	No.	Δ	R.	L	T
	①	10°00'00"	100.00'	17.45'	8.76'
	②	61°42'37"	61.00'	65.70'	36.44'
Δ2	③	55°16'57"	61.00'	58.86'	31.95'
Δ2	④	10°00'00"	100.00'	17.45'	8.75'

REGISTERED PROFESSIONAL ENGINEER CHARLES W. STEVENS No.C29725 Exp.3-31-03 CIVIL STATE OF CALIFORNIA

THE CORNERSTONE GROUP
1485 SPRUCE STREET, SUITE H
RIVERSIDE, CALIFORNIA 92507
(909)342-0036 FAX(909)342-0267

CHARLES W. STEVENS 6-29-99
CHARLES W. STEVENS DATE
R.C.E. 29725 Exp 3-31-03

CITY OF RIVERSIDE
DOMESTIC SYSTEM

Approved By:
Fred Land 1/22/80
Chief Utilities Engineer - Water Date

L A WAINSCOTT & ASSOCIATES
CIVIL ENGINEERS
GRAND TERRACE, CALIFORNIA
(714) 824-1775

APPROVED BY L.A. Wainscott DATE 10-26-79
R.C.E. 16056

W.O. 017.05 FOR Warren Bruce F.B. 3

MARK	REVISIONS	APPR.	DATE
Δ3	ADDED REMAINING PORTION OF EXISTING RIGHT AND ORIGINAL C.L.S. LOCATION		8/11/99
Δ2	Added mail address & cell ph. no. P.H. & J.R.	WLK	5-18-84
Δ1	Extended 5.0' from Station 2+25 Rear	WLK	4-4-80
	Add note 11 (Water Dept note)		2-1-80

DESIGNED BY P.H. JR. DRAWN BY P.H. JR. CHECKED BY

BENCH MARK:
Set P.K. nail and tag in NW. curb return @ Jurupa Ave. and Fremont St.
F.B. 730/47
Elevation = 780.235

CITY OF RIVERSIDE, CALIFORNIA
DEPARTMENT OF PUBLIC WORKS

APPROVED BY	BY	DATE
OFFICE ENGINEER		
PARK DEPARTMENT		
TRAFFIC DIVISION	CHW	2-1-80
ASSISTANT CITY ENG.		2-1-80

APPROVED BY: DIRECTOR OF PUBLIC WORKS
DATE 2/4/80

STREET PLAN AND PROFILE

JASMINE STREET
MP-4-767

SCALE: HORIZ.: 1"= 40' VERT.: 1"= 4'

R-2232
SHT. 1 OF 1
W.O. 017.05-A

INDEXED F.M.P.