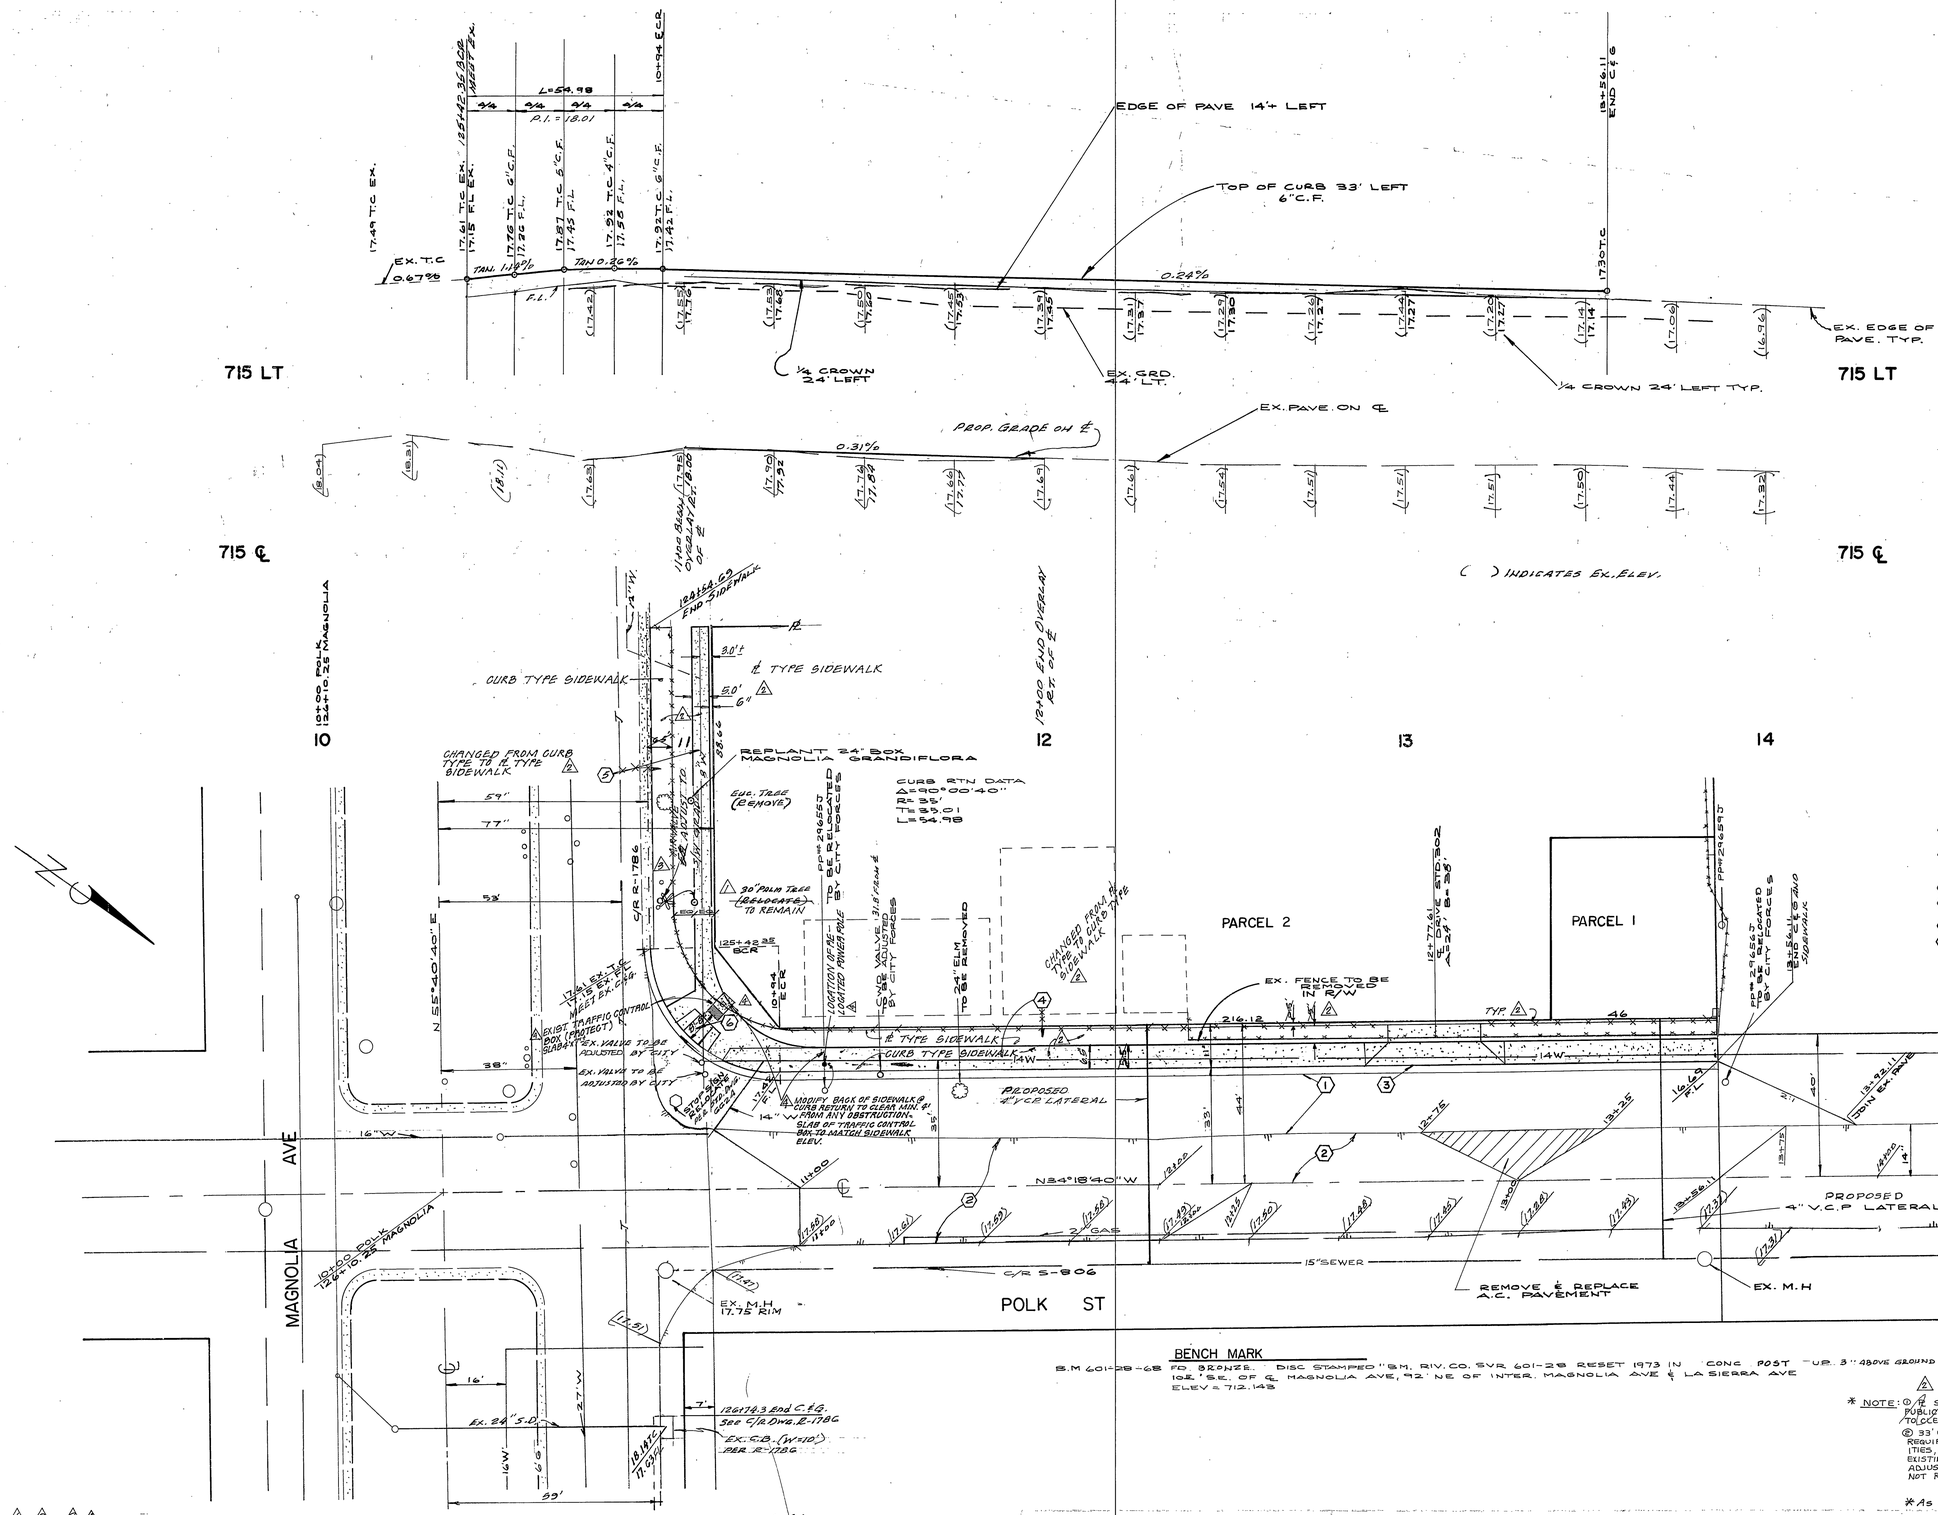


## GENERAL NOTES

1. IT SHALL BE THE RESPONSIBILITY OF THE CONTRACTOR TO CLEAR THE RIGHT OF WAY IN ACCORDANCE WITH THE PROVISIONS OF LAW AS IT AFFECTS EACH UTILITY INCLUDING IRRIGATION LINES AND APPURTENANCES AND AT NO COST TO THE CITY.
2. CONSTRUCTION SHALL BE IN ACCORDANCE WITH THE CITY OF RIVERSIDE, DEPT. OF PUBLIC WORKS STANDARD DRAWINGS, AND THE STANDARD SPECIFICATIONS FOR PUBLIC WORKS CONSTRUCTION, 1979 EDITION.
3. TRIM EDGE OF EXIST. PAVEMENT WHERE NEW PAVEMENT JOINS TO A SMOOTH, STRAIGHT LINE. CONSTRUCT MATCH-UP PAVING AS SHOWN ON PLANS AND OVERLAY PAVING AS DIRECTED IN THE FIELD TO PRODUCE A SMOOTH SECTION. ENGINEER ESTIMATES OVERLAY TO BE 25 TONS.
4. CURB AND GUTTER SHALL BE STAKED WITH 3' OFFSETS AT 12.5 INTERVALS.
5. ALL FLAGGED ELEVATIONS SHALL BE STAKED IN THE FIELD BY THE PRIVATE ENGINEER.
6. THE PRIVATE ENGINEER SIGNING THESE PLANS IS RESPONSIBLE FOR THE ACCURACY AND ACCEPTABILITY OF THE WORK HEREON. IN THE EVENT OF DISCREPANCIES ARISING DURING CONSTRUCTION, THE PRIVATE ENGINEER SHALL BE RESPONSIBLE FOR DETERMINING AN ACCEPTABLE SOLUTION AND REVISING THE PLANS FOR APPROVAL BY THE CITY.
7. CONSTRUCT DRIVEWAY APPROACHES PER STD DWG. 302.
8. LOCATION OF LATERALS TO BE DETERMINED IN THE FIELD AT THE DIRECTION OF THE OWNER. AVOID CONFLICT WITH PROPOSED AND/OR EXISTING FACILITIES.
9. ALL TREE RELOCATION AND PLANTING SHALL BE IN ACCORDANCE WITH C/R PARKS DEPARTMENT STANDARDS. INSPECTION IS REQUIRED. CONTACT THE PARK PROJECT INSPECTOR AT 787-7225 A MINIMUM OF 48 HOURS (TWO WORKING DAYS) IN ADVANCE TO ARRANGE FOR INSPECTION APPOINTMENT.
10. THE SUBDIVIDER SHALL ARRANGE FOR A SOIL TEST TO BE MADE BY A SOILS ENGINEER AFTER THE STREETS HAVE BEEN PREPARED TO ROUGH GRADE. DEPTH OF BASE MATERIAL AND A.C. PAVING SHALL BE DETERMINED BY THE CITY OF RIVERSIDE DESIGN STANDARDS AND TEST PROCEDURES.
11. DEVELOPER TO GIVE CITY WATER DIVISION FIVE (5) WORKING DAYS WRITTEN NOTICE PRIOR TO START OF CONSTRUCTION AND TO ALLOW CITY (10) WORKING DAYS FOR COMPLETION OF WORK. (787-7611).

## CONSTRUCTION NOTES

1. CONST 4" A.C. PAVEMENT OVER 11" D.G. BASE. PER SR 1075, 'R' = 27
2. OVERLAY EXISTING PAVEMENT WITH A.C. TO PRODUCE A SMOOTH SECTION AS DIRECTED IN THE FIELD.
3. CONST. CURB & GUTTER PER STD. DWG. NO. 200 (6" C.F.)
4. CONST. ~~PROPERTY LINE~~ CURB TYPE SIDEWALK PER STD. DWG. NO. 325. ~~PROPERTY LINE~~
5. CONST. ~~CURB LINE~~ SIDEWALK PER STD. DWG. 325.
6. CONST. WHEEL CHAIR RAMP PER STD. 304.

FOR: △1, △2, △3, △4

| W. J. McKEEVER, INC. | APPROVED REVISIONS | BY | DATE |
|---|---|---|---|
| CIVIL ENGINEERING | WATER DEPT. | | 6/4/83 |
| 647 N. MAIN ST. RIVERSIDE, CA 92501 | PARK DEPT. | | 6-20-83 |
| (714) 684-5807 | PLANNING | | 6-20-83 |
| 4-21-83 | | | |
| WILLIAM J. McKEEVER R.C.E. 22502 | | | |

CITY OF RIVERSIDE
OVERHEAD & UNDERGROUND
For CHIEF UTILITIES ENGINEER-ELECTRIC — 5-16-80 DATE

CITY OF RIVERSIDE
DOMESTIC & IRRIGATION SYSTEM
WATER SYSTEM MANAGER — 6/18/80 DATE

ALFERT E. WATER ASSOCIATES
CIVIL ENGINEERS
RIVERSIDE, CALIFORNIA
APPROVED BY Ernest W. Wall DATE 1/3/80
R.C.E. NO. 9876

△4 ADDED EXIST. TRAFFIC CONTROL BOX, SHOW RE-LOCATED POWER POLE, ADDED NOTE TO MODIFY BACK OF SIDEWALK & CURB RETURN — 9-6-83
△3 CHANGED LABEL "F.H." to "AIR VALVE" — 6-20-83
△2 Revised time of S.W. both streets — 6/24/80
△1 Changed disposition existing trees

79-265 ERNEST PINTOR — REC — EJL

CITY OF RIVERSIDE, CALIFORNIA
DEPARTMENT OF PUBLIC WORKS
DATE 6/25/80

# STREET PLAN & PROFILE
# POLK STREET
# PARCEL MAP NO. 15247

ACCT. No.
DRAWING NUMBER R-2268
SHEET 1 OF 1
79-265-A

SCALE: HORIZ. 1" = 20' VERT. 1" = 2'

Indexed RRE