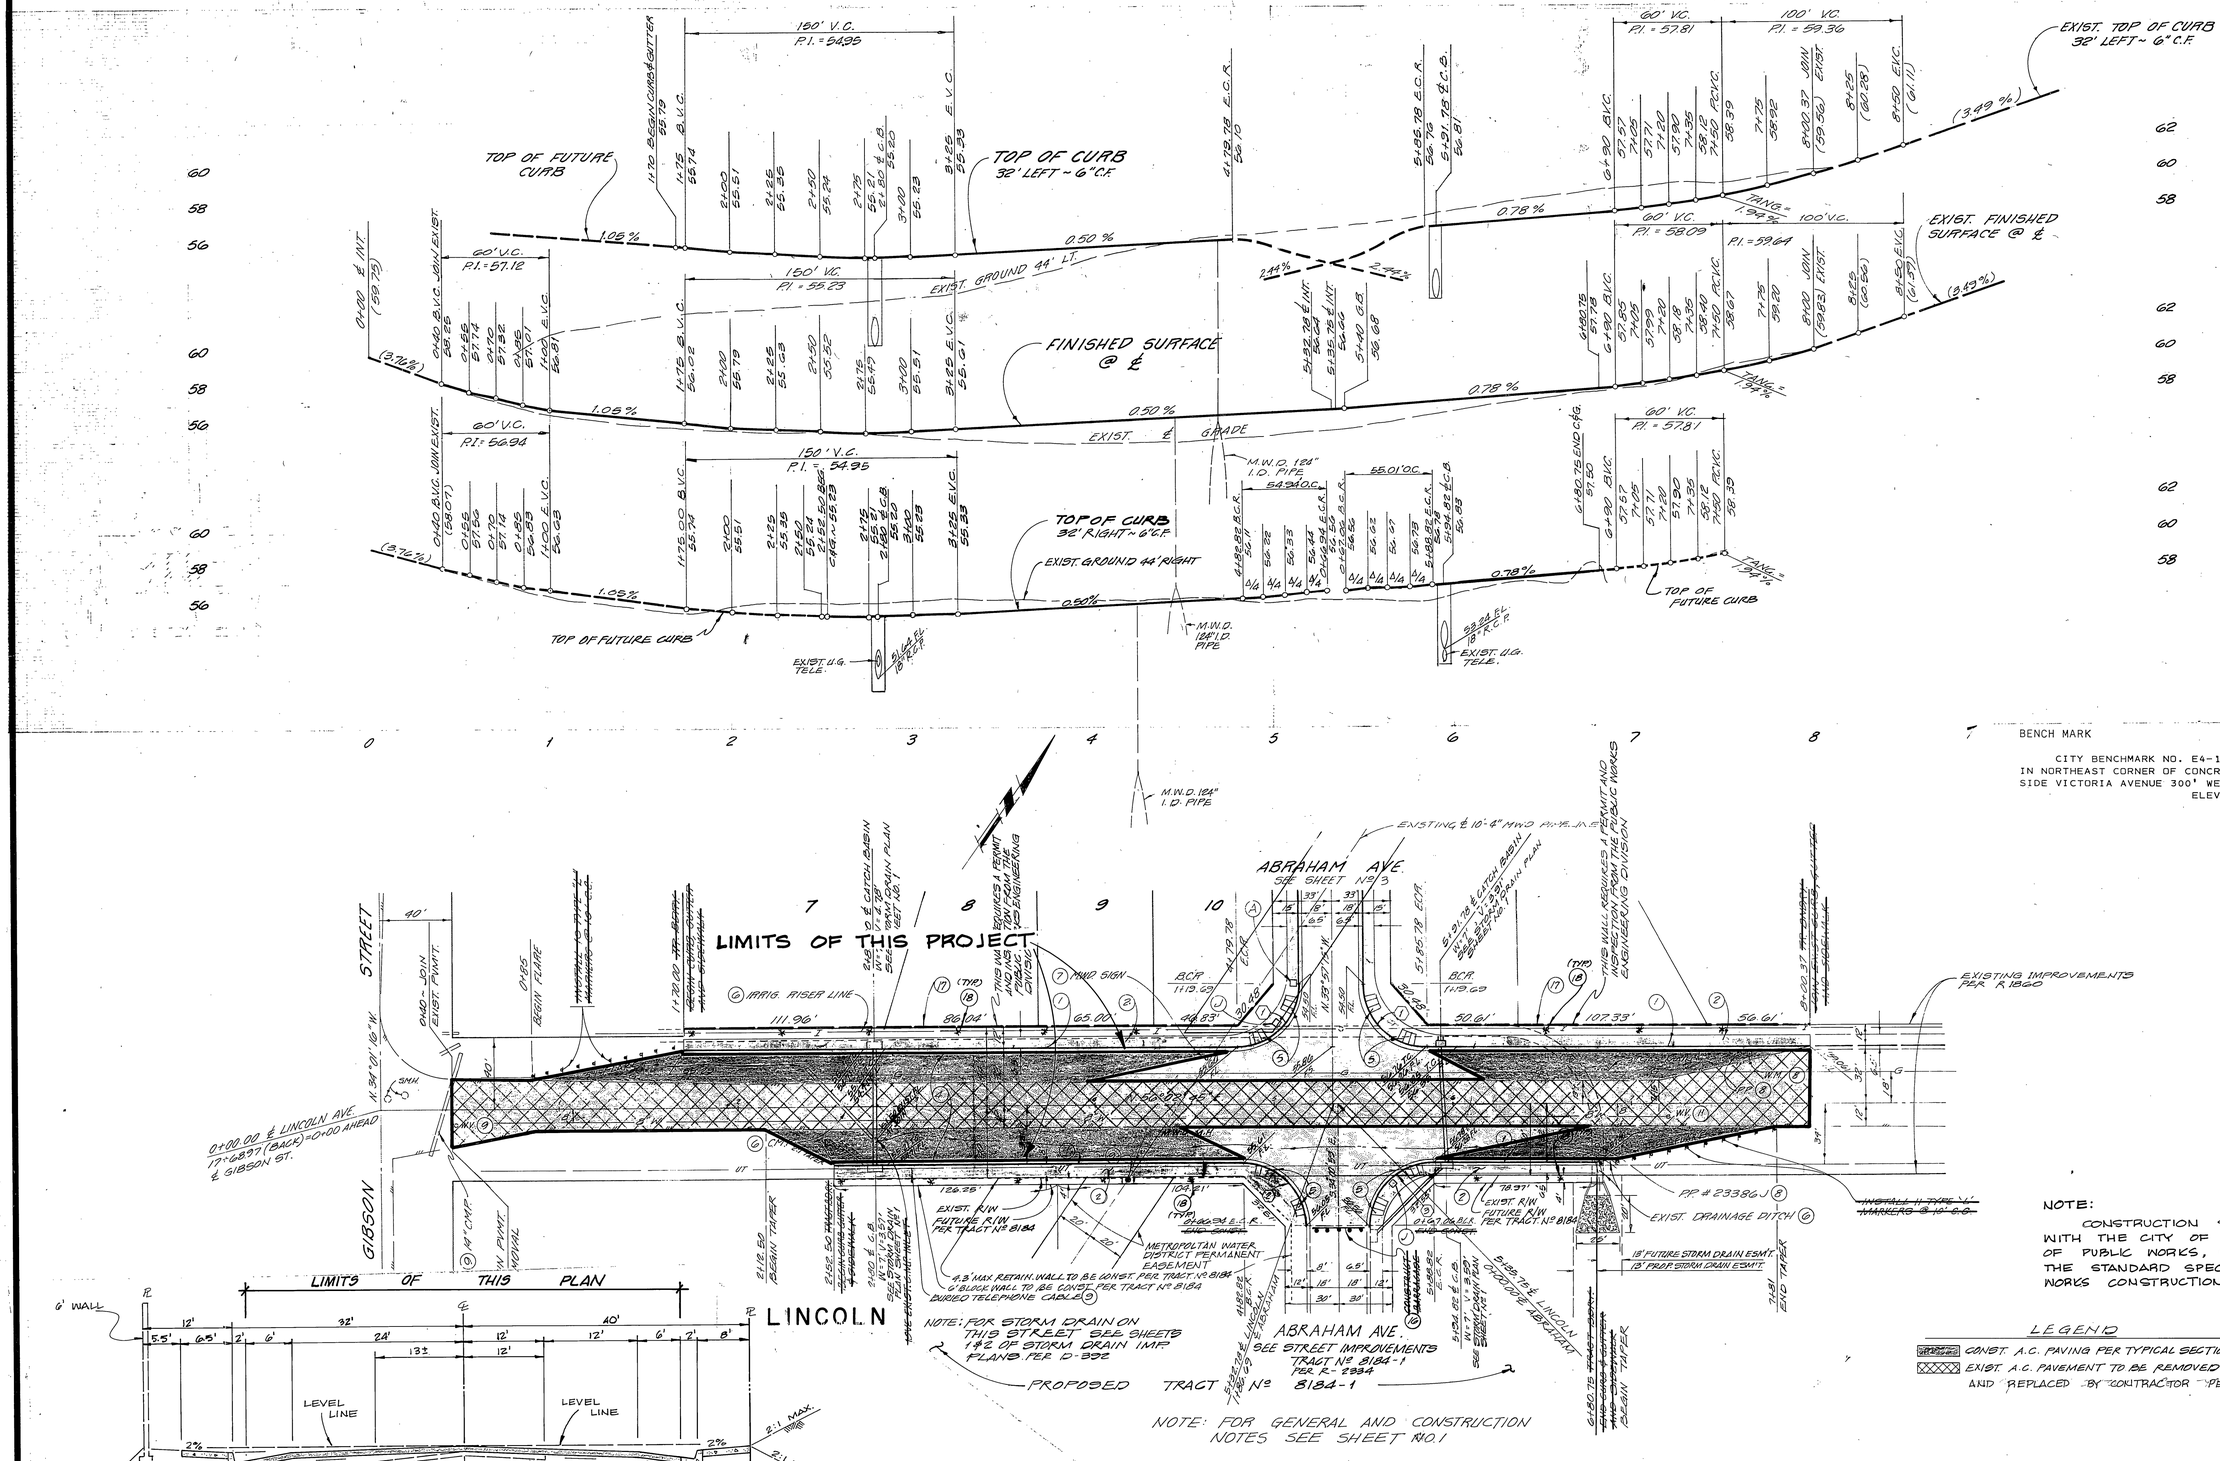

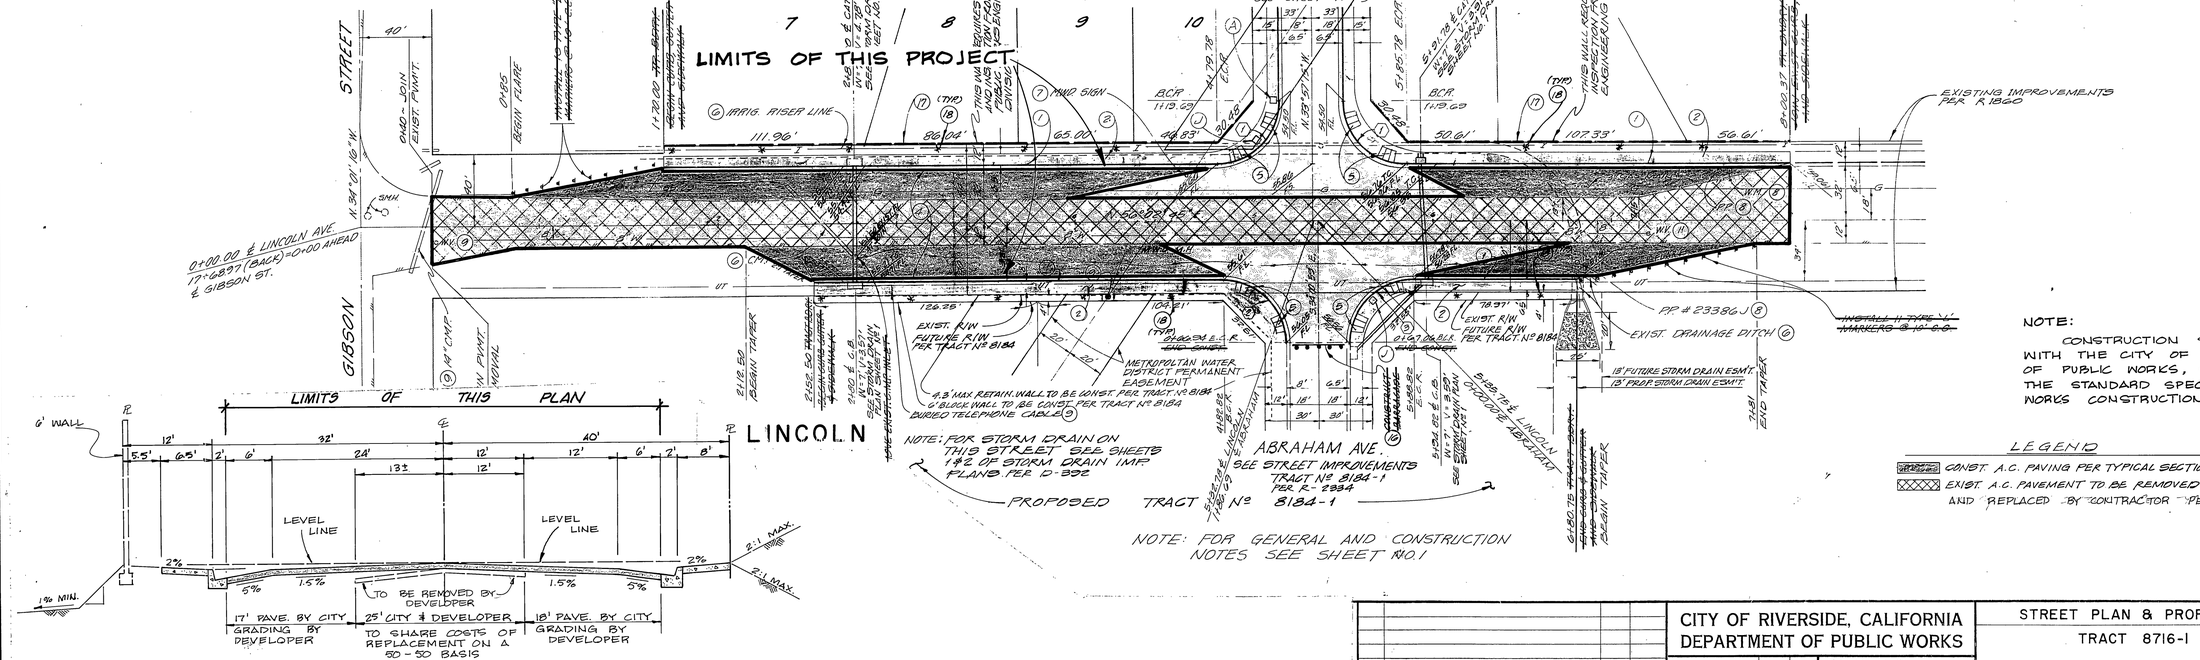

TYPICAL SECTION
NOT TO SCALE
LINCOLN AVE.

BENCH MARK

CITY BENCHMARK NO. E4-1 P.K. NAIL AND TAG IN NORTHEAST CORNER OF CONCRETE GUTTER ON NORTHERLY SIDE VICTORIA AVENUE 300' WESTERLY OF JACKSON STREET. ELEVATION 871.412

NOTE:

CONSTRUCTION SHALL BE IN ACCORDANCE WITH THE CITY OF RIVERSIDE, DEPARTMENT OF PUBLIC WORKS, STANDARD DRAWINGS, AND THE STANDARD SPECIFICATIONS FOR PUBLIC WORKS CONSTRUCTION, 1979 EDITION.

LEGEND

CONST. A.C. PAVING PER TYPICAL SECTION

EXIST. A.C. PAVEMENT TO BE REMOVED BY DEVELOPER AND REPLACED BY CONTRACTOR PER TYPICAL SECTION

MARK | REVISIONS | APPR. | DATE

DESIGNED BY ____ DRAWN BY ____ CHECKED BY ____

CITY OF RIVERSIDE, CALIFORNIA
DEPARTMENT OF PUBLIC WORKS

APPROVED BY	BY	DATE
PRINCIPAL ENGINEER		
PARK DEPARTMENT		
TRAFFIC DIVISION		
CHIEF P. W. ENGR.		
PLANNING DEPT.		

APPROVED BY
DIRECTOR OF PUBLIC WORKS
DATE 11/4/81

STREET PLAN & PROFILE
TRACT 8716-1
LINCOLN AVENUE

HORIZ. SCALE: 1" = 40' VERT. SCALE: 1" = 4'

PROJECT NO. R-2333A
SHEET 1 OF 1
FILE NO.

ADAPTED FROM R-2333