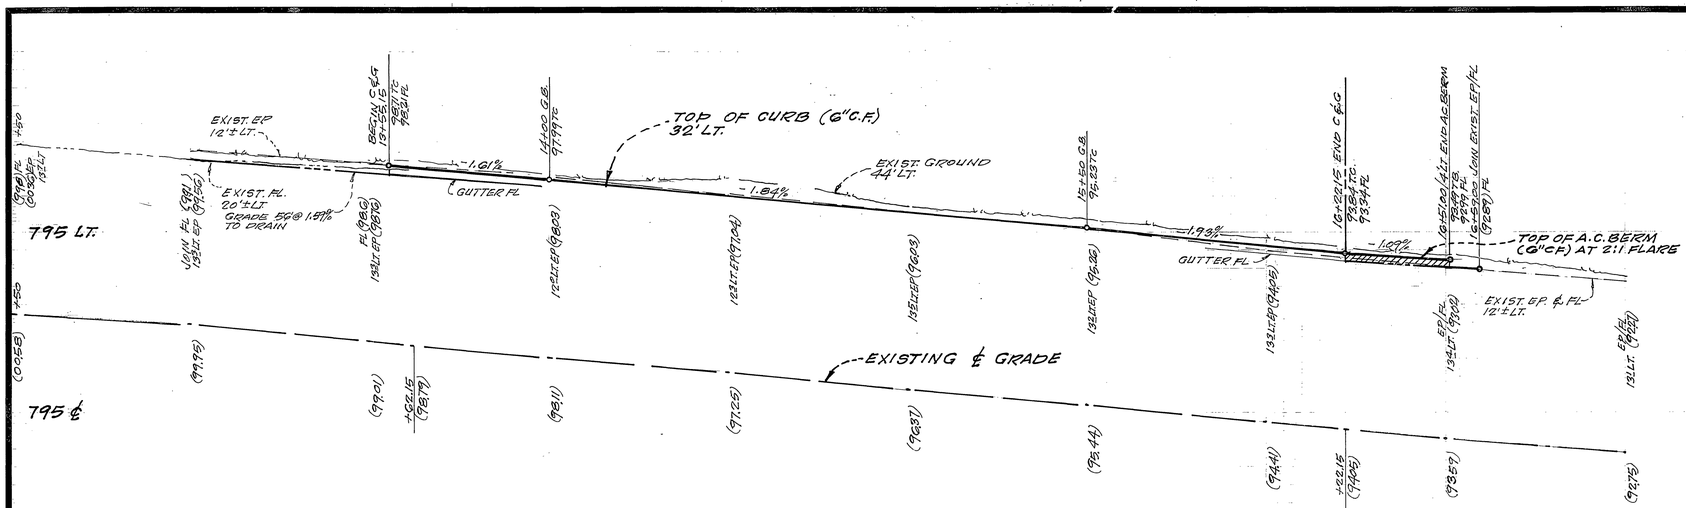

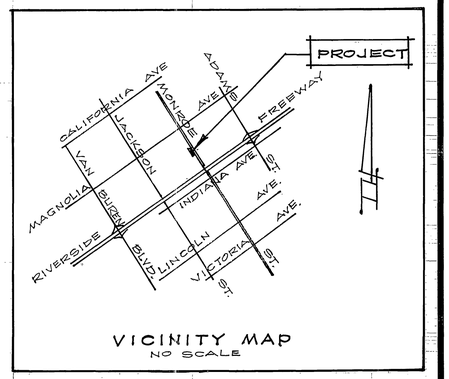

VICINITY MAP
NO SCALE

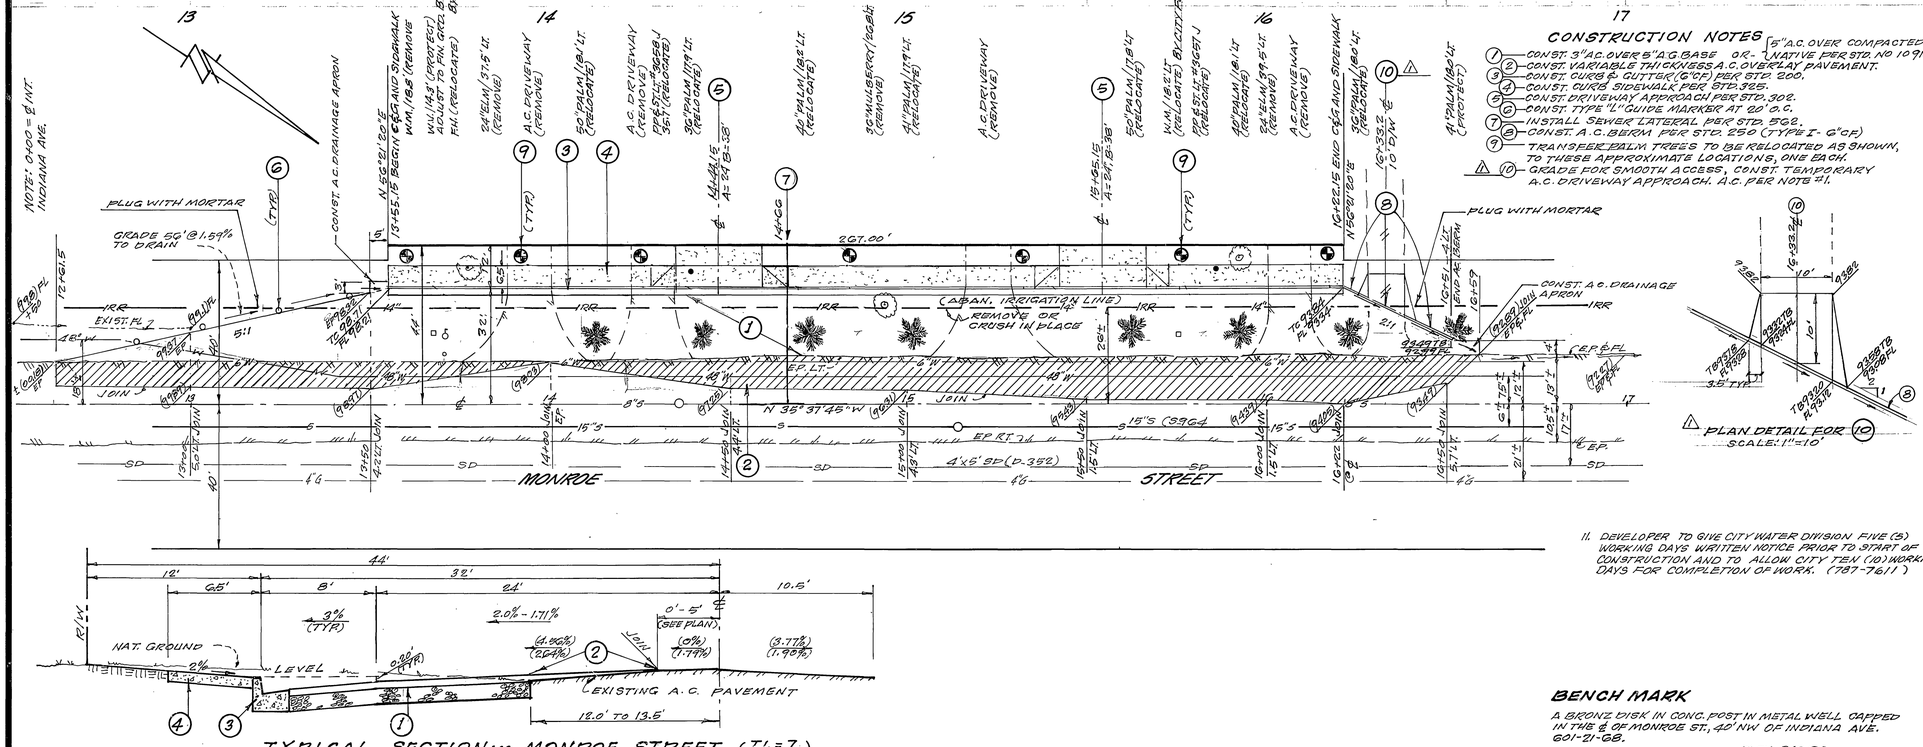

TYPICAL SECTION··· MONROE STREET (T1.=7 R=59)
SCALE: HORIZ. 1"=5', VERT. 1"=2'

PLAN DETAIL FOR (10)
SCALE: 1"=10'

CONSTRUCTION NOTES

(5" A.C. OVER COMPACTED NATIVE PER STD. NO 1091.)

1. CONST. 3" AC. OVER 5" A.G. BASE OR -
2. CONST. VARIABLE THICKNESS A.C. OVERLAY PAVEMENT.
3. CONST. CURB & GUTTER (6"CF) PER STD. 200.
5. CONST. DRIVEWAY APPROACH PER STD. 302.
6. CONST. TYPE "I" GUIDE MARKER AT 20' O.C.
7. INSTALL SEWER LATERAL PER STD. 502.
8. CONST. A.C. BERM PER STD. 250 (TYPE I - C"CF)
9. TRANSPLANT PALM TREES TO BE RELOCATED AS SHOWN, TO THESE APPROXIMATE LOCATIONS, ONE EACH.
10. GRADE FOR SMOOTH ACCESS, CONST. TEMPORARY A.C. DRIVEWAY APPROACH. A.C. PER NOTE #1.
11. DEVELOPER TO GIVE CITY WATER DIVISION FIVE (5) WORKING DAYS WRITTEN NOTICE PRIOR TO START OF CONSTRUCTION AND TO ALLOW CITY TEN (10) WORKING DAYS FOR COMPLETION OF WORK. (787-7611)

GENERAL NOTES

1. CONSTRUCTION SHALL BE IN ACCORDANCE WITH THE CITY OF RIVERSIDE, DEPARTMENT OF PUBLIC WORKS, STANDARD DRAWINGS AND THE STANDARD SPECIFICATIONS FOR PUBLIC WORKS CONSTRUCTION, 1979 EDITION.
2. IT SHALL BE THE RESPONSIBILITY OF THE CONTRACTOR TO CLEAR THE RIGHT OF WAY IN ACCORDANCE WITH THE PROVISIONS OF LAW AS IT AFFECTS EACH UTILITY INCLUDING IRRIGATION LINES AND APPURTENANCES AND AT NO COST TO THE CITY.
3. TRIM EDGE OF EXISTING PAVEMENT WHERE NEW PAVEMENT JOINS TO A SMOOTH, STRAIGHT LINE. CONSTRUCT MATCH-UP PAVING AS SHOWN ON PLAN AND OVERLAY PAVING AS DIRECTED IN THE FIELD TO PRODUCE A SMOOTH SECTION. ENGINEER ESTIMATES OVERLAY TO BE 5 TONS.
4. CONSTRUCTION STAKES TO BE 3' BEHIND CURB AT 25' INTERVALS.
5. ALL FLAGGED ELEVATIONS SHALL BE STAKED IN FIELD BY THE PRIVATE ENGINEER.
6. NOTICE TO CONTRACTOR: THE EXISTENCE AND LOCATION OF ANY UNDERGROUND UTILITY PIPES OR STRUCTURES SHOWN ON THESE PLANS WERE OBTAINED BY A SEARCH OF THE AVAILABLE RECORDS. TO THE BEST OF OUR KNOWLEDGE THERE ARE NO EXISTING UTILITIES EXCEPT AS SHOWN ON THESE PLANS. THE CONTRACTOR IS REQUIRED TO TAKE DUE PRECAUTIONARY MEASURES TO PROTECT THE UTILITY LINES SHOWN OR NOT SHOWN ON THESE PLANS.
7. CONTRACTOR SHALL NOTIFY SO. CALIF. GAS CO. AT LEAST 48 HOURS PRIOR TO START OF CONSTRUCTION AT (714) 781-6111.
8. 4"x4" BLOCK OUT FOR MAIL BOX IN CURB SIDEWALK IS REQUIRED.
9. THE PRIVATE ENGINEER SIGNING THESE PLANS IS RESPONSIBLE FOR THE ACCURACY AND ACCEPTABILITY OF THE WORK NOTED IN THE EVENT OF DISCREPANCIES ARISING DURING CONSTRUCTION, THE PRIVATE ENGINEER SIGNING THESE PLANS SHALL BE RESPONSIBLE FOR DETERMINING AN ACCEPTABLE SOLUTION AND REVISING THE PLANS FOR APPROVAL BY THE CITY.
10. CONTACT THE PARK PROJECTS INSPECTOR A MINIMUM OF 48 HOURS IN ADVANCE AT 787-7923 TO SCHEDULE INSPECTIONS. INSPECTIONS SHALL BE REQUIRED: A. WHEN PLANT LOCATIONS HAVE BEEN SPOTTED IN THE FIELD PRIOR TO DIGGING PLANT PITS. B. WHILE DIGGING PLANT PITS AND PLANTING/RELOCATING TREES. C. AFTER PLANTING AND ALL OTHER INDICATED OR SPECIFIED WORK HAS BEEN COMPLETED FOR START OF MAINTENANCE. D. AT END OF MAINTENANCE/FINAL ACCEPTANCE (CONTRACTOR/DEVELOPER WILL BE RELEASED FROM MAINTENANCE ONLY UPON RECEIPT OF WRITTEN NOTIFICATION FROM THE CITY THAT THE PARK AND RECREATION DEPARTMENT IS ASSUMING MAINTENANCE RESPONSIBILITIES).

ALL RELATED WORK SHALL CONFORM TO THE CITY OF RIVERSIDE PARK AND RECREATION DEPT. STANDARDS.

THE CONTRACTOR/DEVELOPER SHALL MAINTAIN ALL PLANTINGS FOR A MINIMUM PERIOD OF ONE(1) YEAR.

BENCH MARK

A BRONZ DISK IN CONC. POST IN METAL WELL CAPPED IN THE ℄ OF MONROE ST., 40' NW OF INDIANA AVE.
601-21-GB.

ELEV. 810.93

* AS BUILT 9/21/81 BZIFT

INDEXED BLG

SOUTHERN CALIF. GAS CO.
APPROVED BY: 11-20-80 DATE

CITY OF RIVERSIDE
PUBLIC UTILITIES DEPT.
ELECTRICAL DIVISION
APPROVED BY: 11/25/80 DATE
FOR CHIEF UTILITIES ENGINEER, ELECTRICAL

CITY OF RIVERSIDE
DOMESTIC SYSTEM
APPROVED BY: 12/2/80 DATE
WATER SYSTEMS MANAGER

HAWKINS, ROBERTSON & ASSOC.
ENGINEERS & SURVEYORS
RIVERSIDE CALIFORNIA
R.C.E. 15016 8/12/80 DATE
FOR: SOUTHERN BAPTIST ASSOC.

MARK	REVISIONS	APPR.	DATE
1	ADD TEMPORARY A.C. D/W STA. 16+49.2		4/9/81
2	E PLAN DETAIL		10-26-81

DESIGNED BY G.H. DRAWN BY R.V.R. CHECKED BY

CITY OF RIVERSIDE, CALIFORNIA
DEPARTMENT OF PUBLIC WORKS

APPROVED BY	BY	DATE
PRINCIPAL ENGINEER		12/1/80
PARK DEPARTMENT		11/26/80
TRAFFIC DIVISION		11/26/80
CHIEF P. W. ENGR.		12-1-80
PLANNING DEPT.		12/1/80

APPROVED BY: DIRECTOR OF PUBLIC WORKS
DATE 12/9/80

STREET PLAN & PROFILE
MONROE STREET
(SOUTH SIDE @ 2GT'± HALFWAY BETWEEN INDIANA AVE & MAGNOLIA AVE.)
C-5-790

HORIZ. SCALE: 1" = 20' VERT. SCALE: 1" = 4'

PROJECT NO. R-2341
SHEET 1 OF 1
FILE NO. 80-2995-A

12-17-80