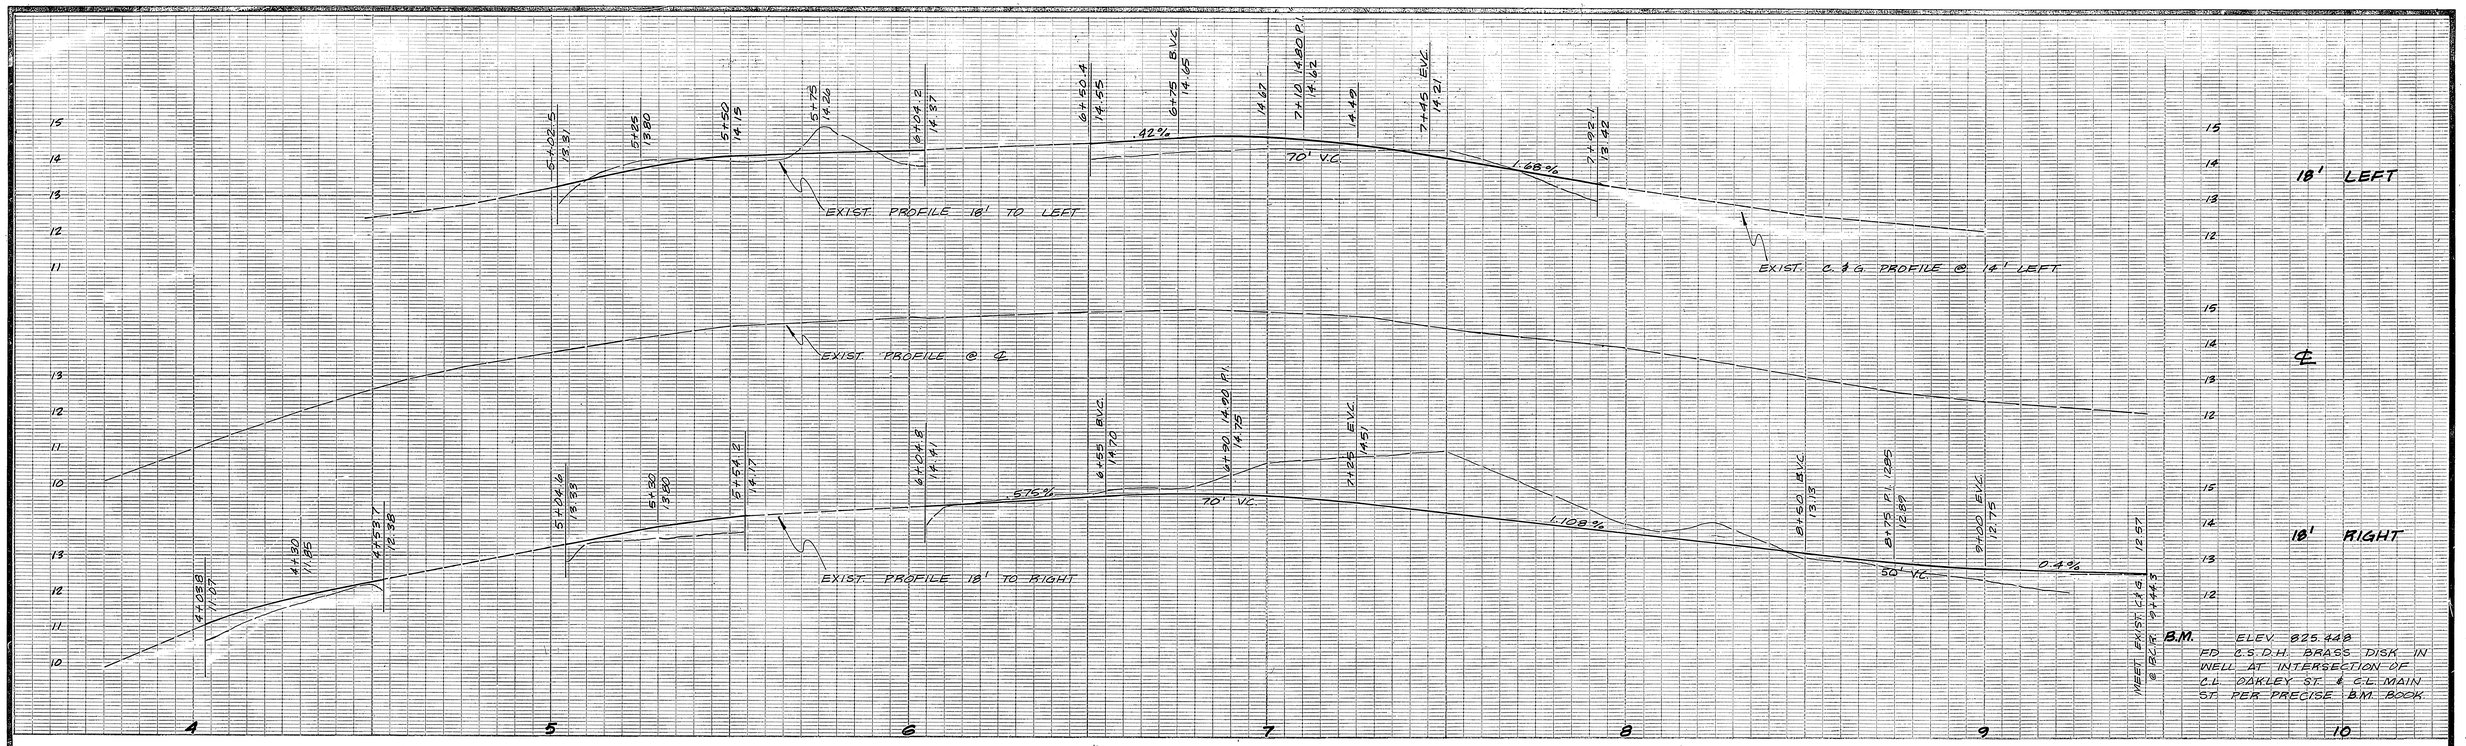

GENERAL NOTES:

1. CONSTRUCTION SHALL BE IN ACCORDANCE WITH THE CITY OF RIVERSIDE, DEPT. OF PUBLIC WORKS, STD. DWGS. & THE STD. SPECIFICATIONS FOR PUBLIC WORKS CONSTRUCTION, 1979 EDITION.

CONSTRUCTION NOTES:

200 — CONSTRUCT CURB & GUTTER PER STD. DWG. 200.

302 — CONSTRUCT DWY. APPROACH PER STD. DWG. 302. (SIZE AS NOTED ON PLAN).

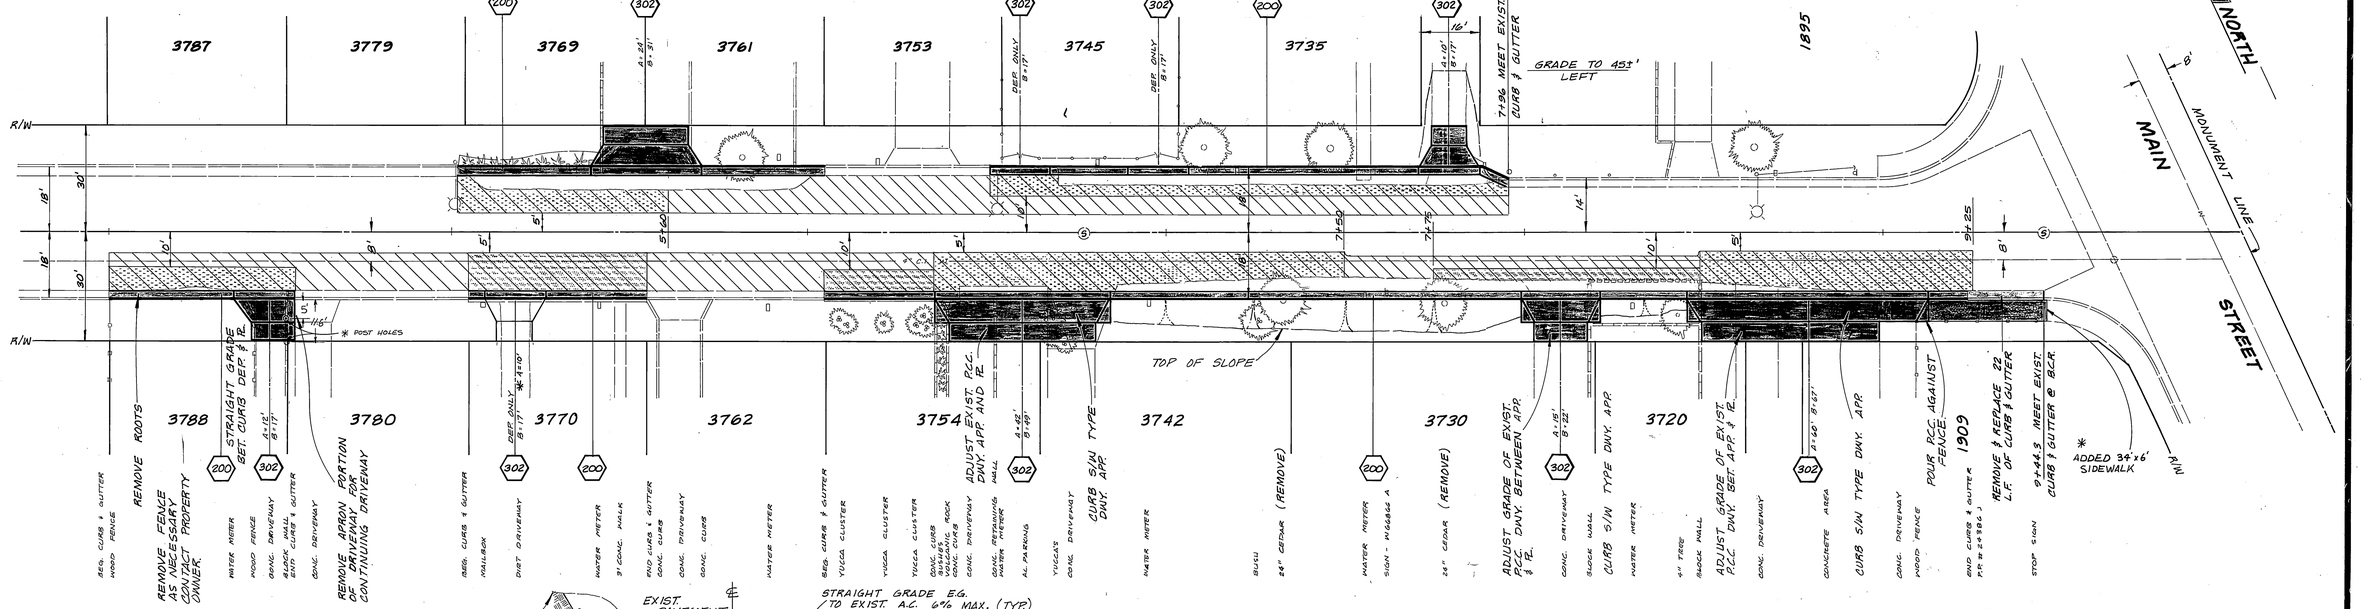

PLACE A.C. OVERLAY

REMOVE & REPLACE A.C. PAVING.

AS BUILT OVERLAY *

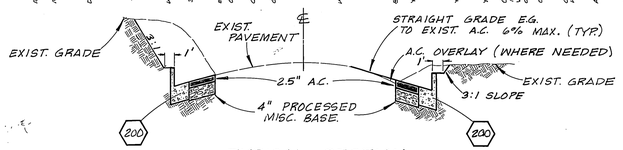

TYPICAL SECTION
NO SCALE

MARK	REVISIONS	APPR.	DATE

DESIGNED BY ____ DRAWN BY ____ CHECKED BY ____

CITY OF RIVERSIDE
PUBLIC WORKS DEPARTMENT

APPROVED BY	DATE	BY
PRINCIPAL ENGINEER		
PARK DEPARTMENT	10-6-81	
TRAFFIC DIVISION	9-21-81	
CHIEF P.W. ENGINEER	10-13	

APPROVED BY ____ PUBLIC WORKS DIRECTOR

DATE 10/8/81

SHAMROCK AVENUE STREET IMPROVEMENTS
— AN H.C.D. PROJECT —
MAIN STREET TO 600' W'LY

HORIZ. SCALE: 1" = 20' VERT. SCALE: 1" = 2'

INDEXED BLD
ACCOUNT NO. 15-550-591

R-2396

SHEET 1 OF 1