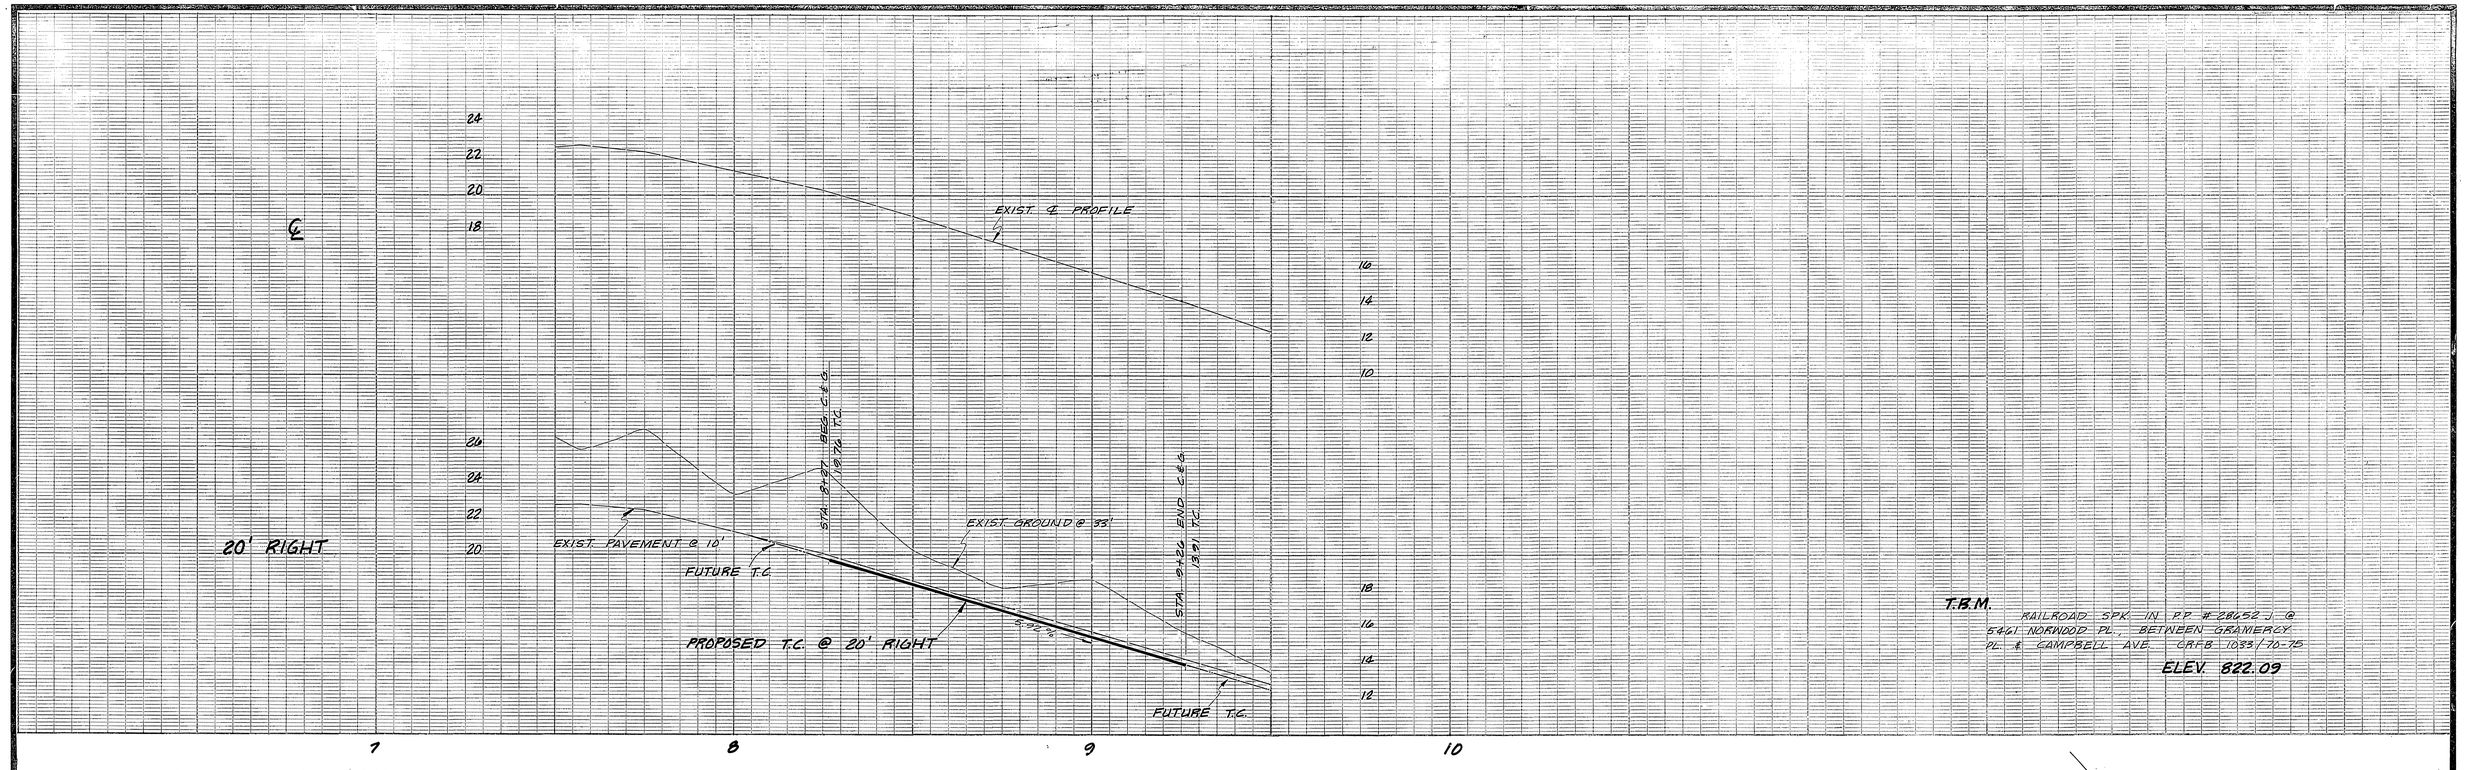

T.B.M.
RAILROAD SPK. IN P.P. # 28652 J @ 5461 NORWOOD PL., BETWEEN GRAMERCY PL. & CAMPBELL AVE. CRFB 1033/70-75
ELEV. 822.09

CONSTRUCTION NOTES:

1. MAILBOX TO BE RELOCATED BY CONTRACTOR
2. WATER METER TO BE ADJUSTED BY CITY.
3. INSTALL 3 TYPE "L" MARKERS, 20' O.C. (TYP.) PER STD. DWG. 665.
4. REMOVE EXIST. PAVING AND CONST. .21' A.C. OVER 1.04' C.A.B.
5. CONST. .21' A.C. OVER 1.04' C.A.B.
6. CONST. C.& G. PER STD. DWG. NO. 200, 6" C.F.
7. CONST. CURB S/W PER STD. DWG. NO. 325.
8. CONST. D/W APPROACH PER STD. DWG. NO. 302. A=10', B=17'
9. REMOVE EXIST. ASPHALT D/W TO 48' RIGHT, REGRADE AND REPLACE TO MAKE A SMOOTH ACCESSIBLE DRIVE.

GENERAL NOTES:

1. CONST. SHALL BE IN ACCORDANCE WITH THE CITY OF RIVERSIDE, DEPT. OF PUBLIC WORKS, STD. DWGS. AND THE STD. SPECIFICATIONS FOR PUBLIC WORKS CONSTRUCTION, 1979 EDITION.

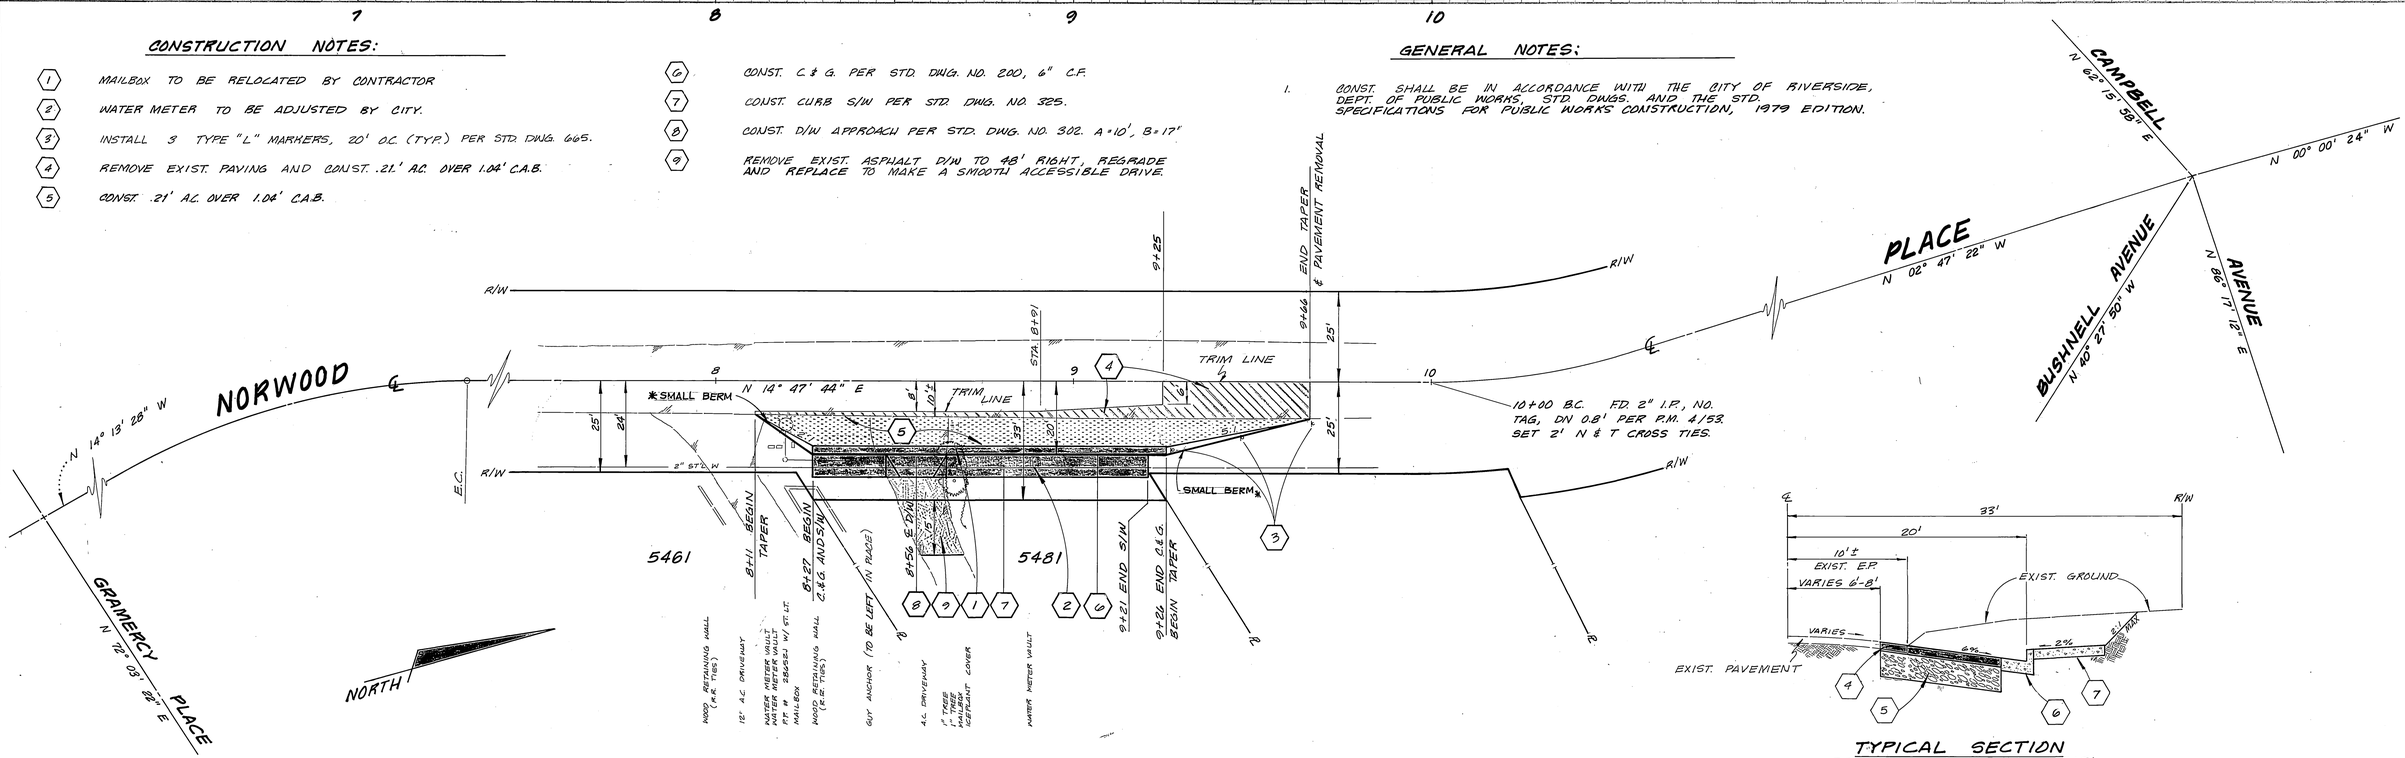

TYPICAL SECTION
BETWEEN STA. 8+27 & STA. 9+21
NO SCALE
T.I. 6

*As Built 9-20-85 TL

MARK	REVISIONS	APPR.	DATE

DESIGNED BY [illegible] DRAWN BY [illegible] CHECKED BY [illegible]

CITY OF RIVERSIDE
PUBLIC WORKS DEPARTMENT

APPROVED BY	DATE	BY
PRINCIPAL ENGINEER	[illegible]	2/10/82
PARK DEPARTMENT		
TRAFFIC DIVISION	[illegible]	11-11-81
CHIEF P. W. ENGINEER	[illegible]	2-19

APPROVED BY [signature]
PUBLIC WORKS DIRECTOR
DATE 2/19/82

BONDED STREET IMPROVEMENTS
5481 NORWOOD PL.
BETWEEN 870' TO 970' S'LY OF CAMPBELL
HORIZ. SCALE: 1" = 20' VERT. SCALE: 1" = 4'

INDEXED BLD
ACCOUNT NO. 30-575-380-30
R-2418
SHEET 1 OF 1
CRFB 1033/70-75