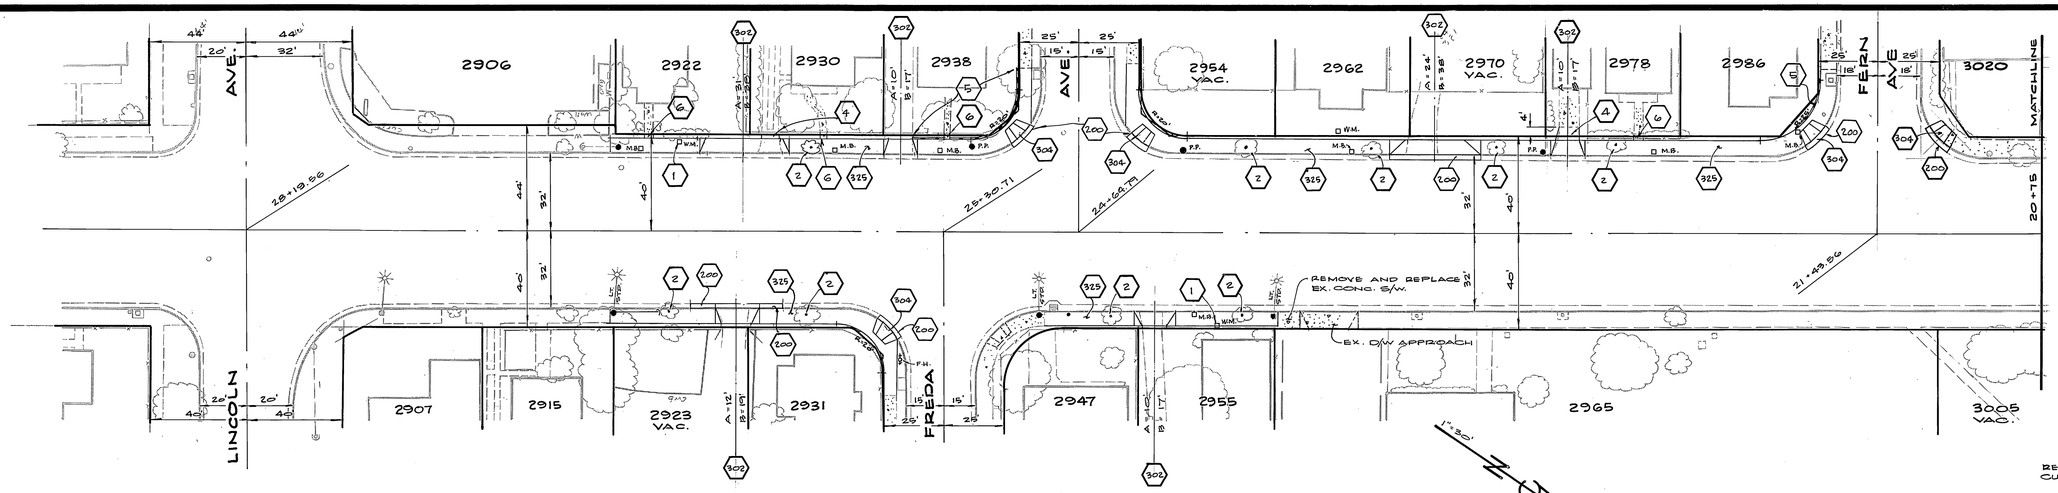

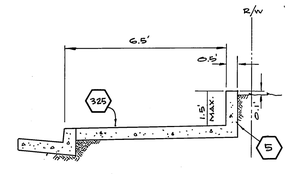

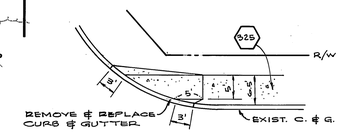

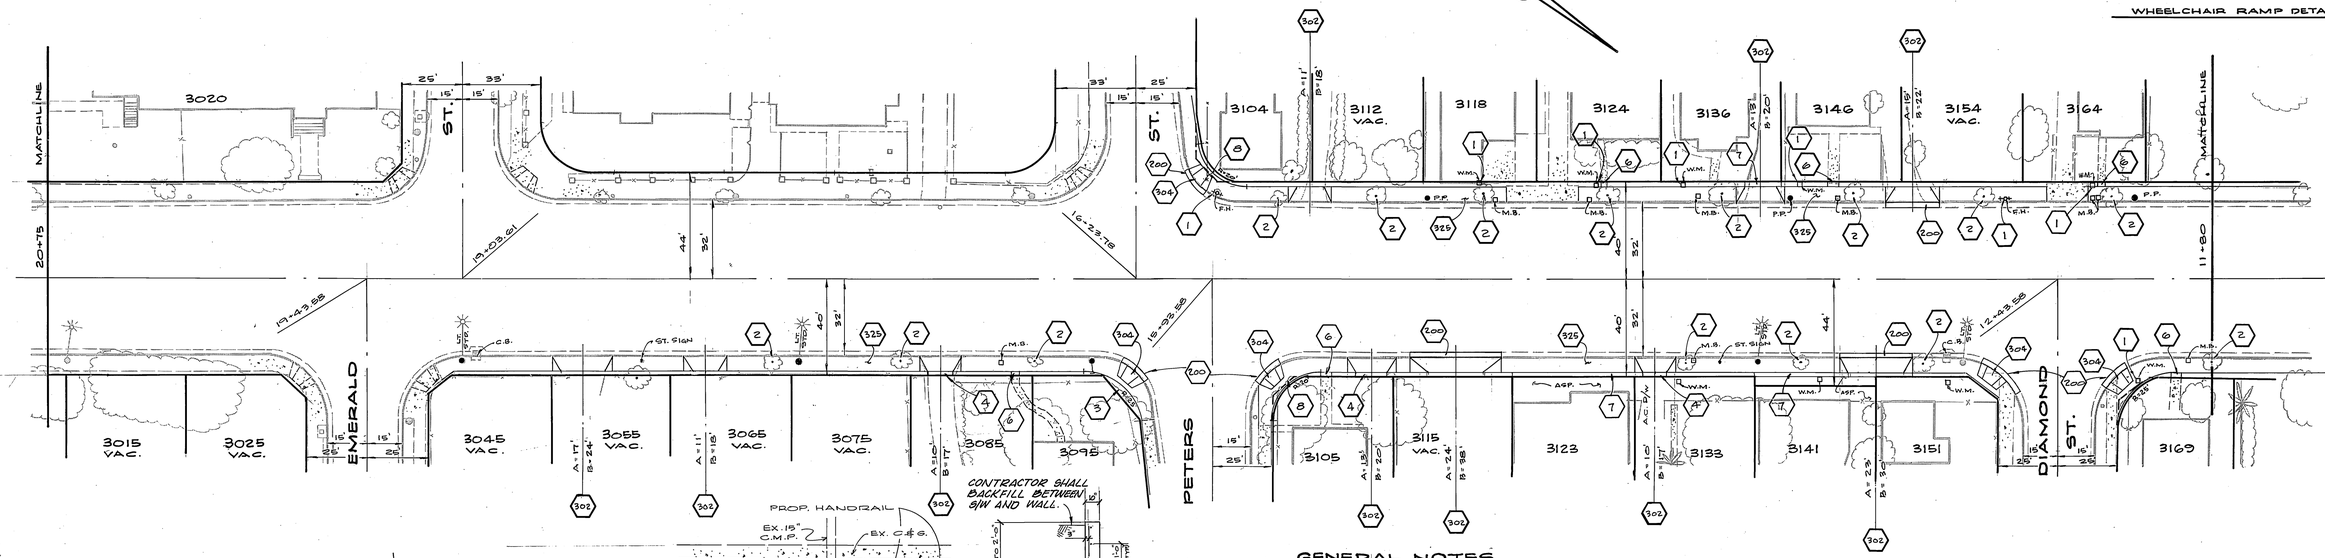

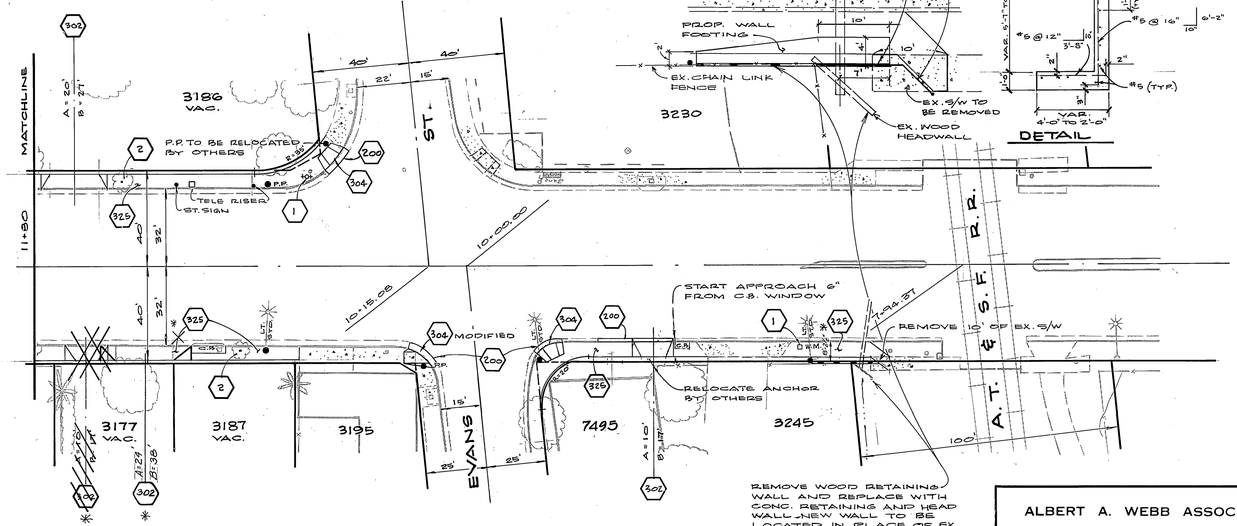

GENERAL NOTES

1. CONSTRUCTION SHALL BE IN ACCORDANCE WITH STANDARD SPECIFICATIONS FOR PUBLIC WORKS CONSTRUCTION, 1979 EDITION, AND CITY OF RIVERSIDE STANDARD DRAWINGS.
2. CONTRACTOR TO RESET ANY STREET NAME AND TRAFFIC SIGNS.
3. CONTRACTOR TO ADJUST STREET LIGHT PULL BOXES TO NEW SIDEWALK GRADE AS REQUIRED.
4. GRADING AT REAR OF SIDEWALK, IF NECESSARY, TO MEET EX. GROUND AT R/W
5. CONTRACTOR TO GIVE THE CITY WATER DIVISION FIVE (5) WORKING DAYS WRITTEN NOTICE PRIOR TO START OF CONST. AND TO ALLOW CITY TEN (10) WORKING DAYS FOR COMPLETION OF WORK. PH. 787-7611.
6. CONTRACTOR IS TO SALVAGE MAIL BOXES AND POSTS AND TEMPORARILY SET IN AN UPRIGHT POSITION OUTSIDE OF CONST. LIMITS REINSTALLATION IN FINAL POSITION WILL BE THE RESPONSIBILITY OF THE CONTRACTOR.
7. CONTRACTOR IS TO TRIM TREES AS NECESSARY TO ALLOW PEDESTRIAN TRAFFIC ON SIDEWALK.
8. METAL HANDRAIL SHALL BE CONSTRUCTED ON TOP OF REINFORCED CONCRETE RETAINING WALL WHERE THERE IS NO FENCE.

CONSTRUCTION NOTES

(302) — CONST. D/W APPROACH PER C/R STD. 302, "A" AND "B" AS INDICATED.

(304) — CONST. WHEELCHAIR RAMP PER C/R STD. 304.

(325) — CONST. CURBLINE S/W PER C/R STD. 325.

(1) — ADJUST W.M./F.H. TO PROP. GRADE, BY OTHERS, IF NECESSARY.

(2) — INSTALL TREE WELL PER C/R STD. 326. MAINTAIN MINIMUM 4' OF S/W IN BACK OF WELL IF POSSIBLE. IF S/W IS LESS THAN 4' INSTALL WELL COVER PER STD. 326. CENTERED ON EXIST TREE.

(3) — RELOCATE FENCE (BY OWNER) TO FACILITATE CONST.

(4) — CONSTRUCT MATCHUP CONC. PAVING TO EX. D/W.

(5) — CONSTRUCT CONC. WALL PER DETAIL ABOVE.

(200) — CONSTRUCT CURB AND GUTTER PER C/R STD. 200; CURB FACE TO MATCH EXIST. REMOVE EXISTING CURB & GUTTER AS REQUIRED.

(6) — CONSTRUCT MATCHUP CONC. PAVING TO EX. S/W. FIELD INSPECTION AT TIME OF CONSTRUCTION MAY REQUIRE STEPS TO BE CONSTRUCTED.

(7) — CONSTRUCT MATCHUP ASPHALT PAVING.

(8) — CONTRACTOR TO RELOCATE FENCE TO BACK OF SIDEWALK.

* AS BUILT 5-24-85 TL

INDEXED

ALBERT A. WEBB ASSOCIATES
CIVIL ENGINEERS
RIVERSIDE, CALIFORNIA
APPROVED BY Albert A. Webb DATE 10/20/81
R.E. No. 7876
W.O. 81-162 FOR: CITY OF RIVERSIDE F.B.

MARK	REVISIONS	APPR.	DATE

DESIGNED BY JMB DRAWN BY JMB CHECKED BY Karl F.

CITY OF RIVERSIDE, CALIFORNIA
DEPARTMENT OF PUBLIC WORKS

APPROVED BY	BY	DATE
PRINCIPAL ENGINEER		
PARK DEPARTMENT		
TRAFFIC DIVISION		
CHIEF PUB. WKS. ENGR.		

APPROVED BY
DIRECTOR OF PUBLIC WORKS
DATE 6/24/82

H.C.D. CASA BLANCA
MADISON ST.
BETWEEN LINCOLN AVE. AND R.R. TRACKS E'LY OF INDIANA AVE.
SCALE: 1" = 30'

ACCOUNT No. 15-550-532
DRAWING NUMBER R-2427
SHEET 1 OF 1
81-162

Pc.1206