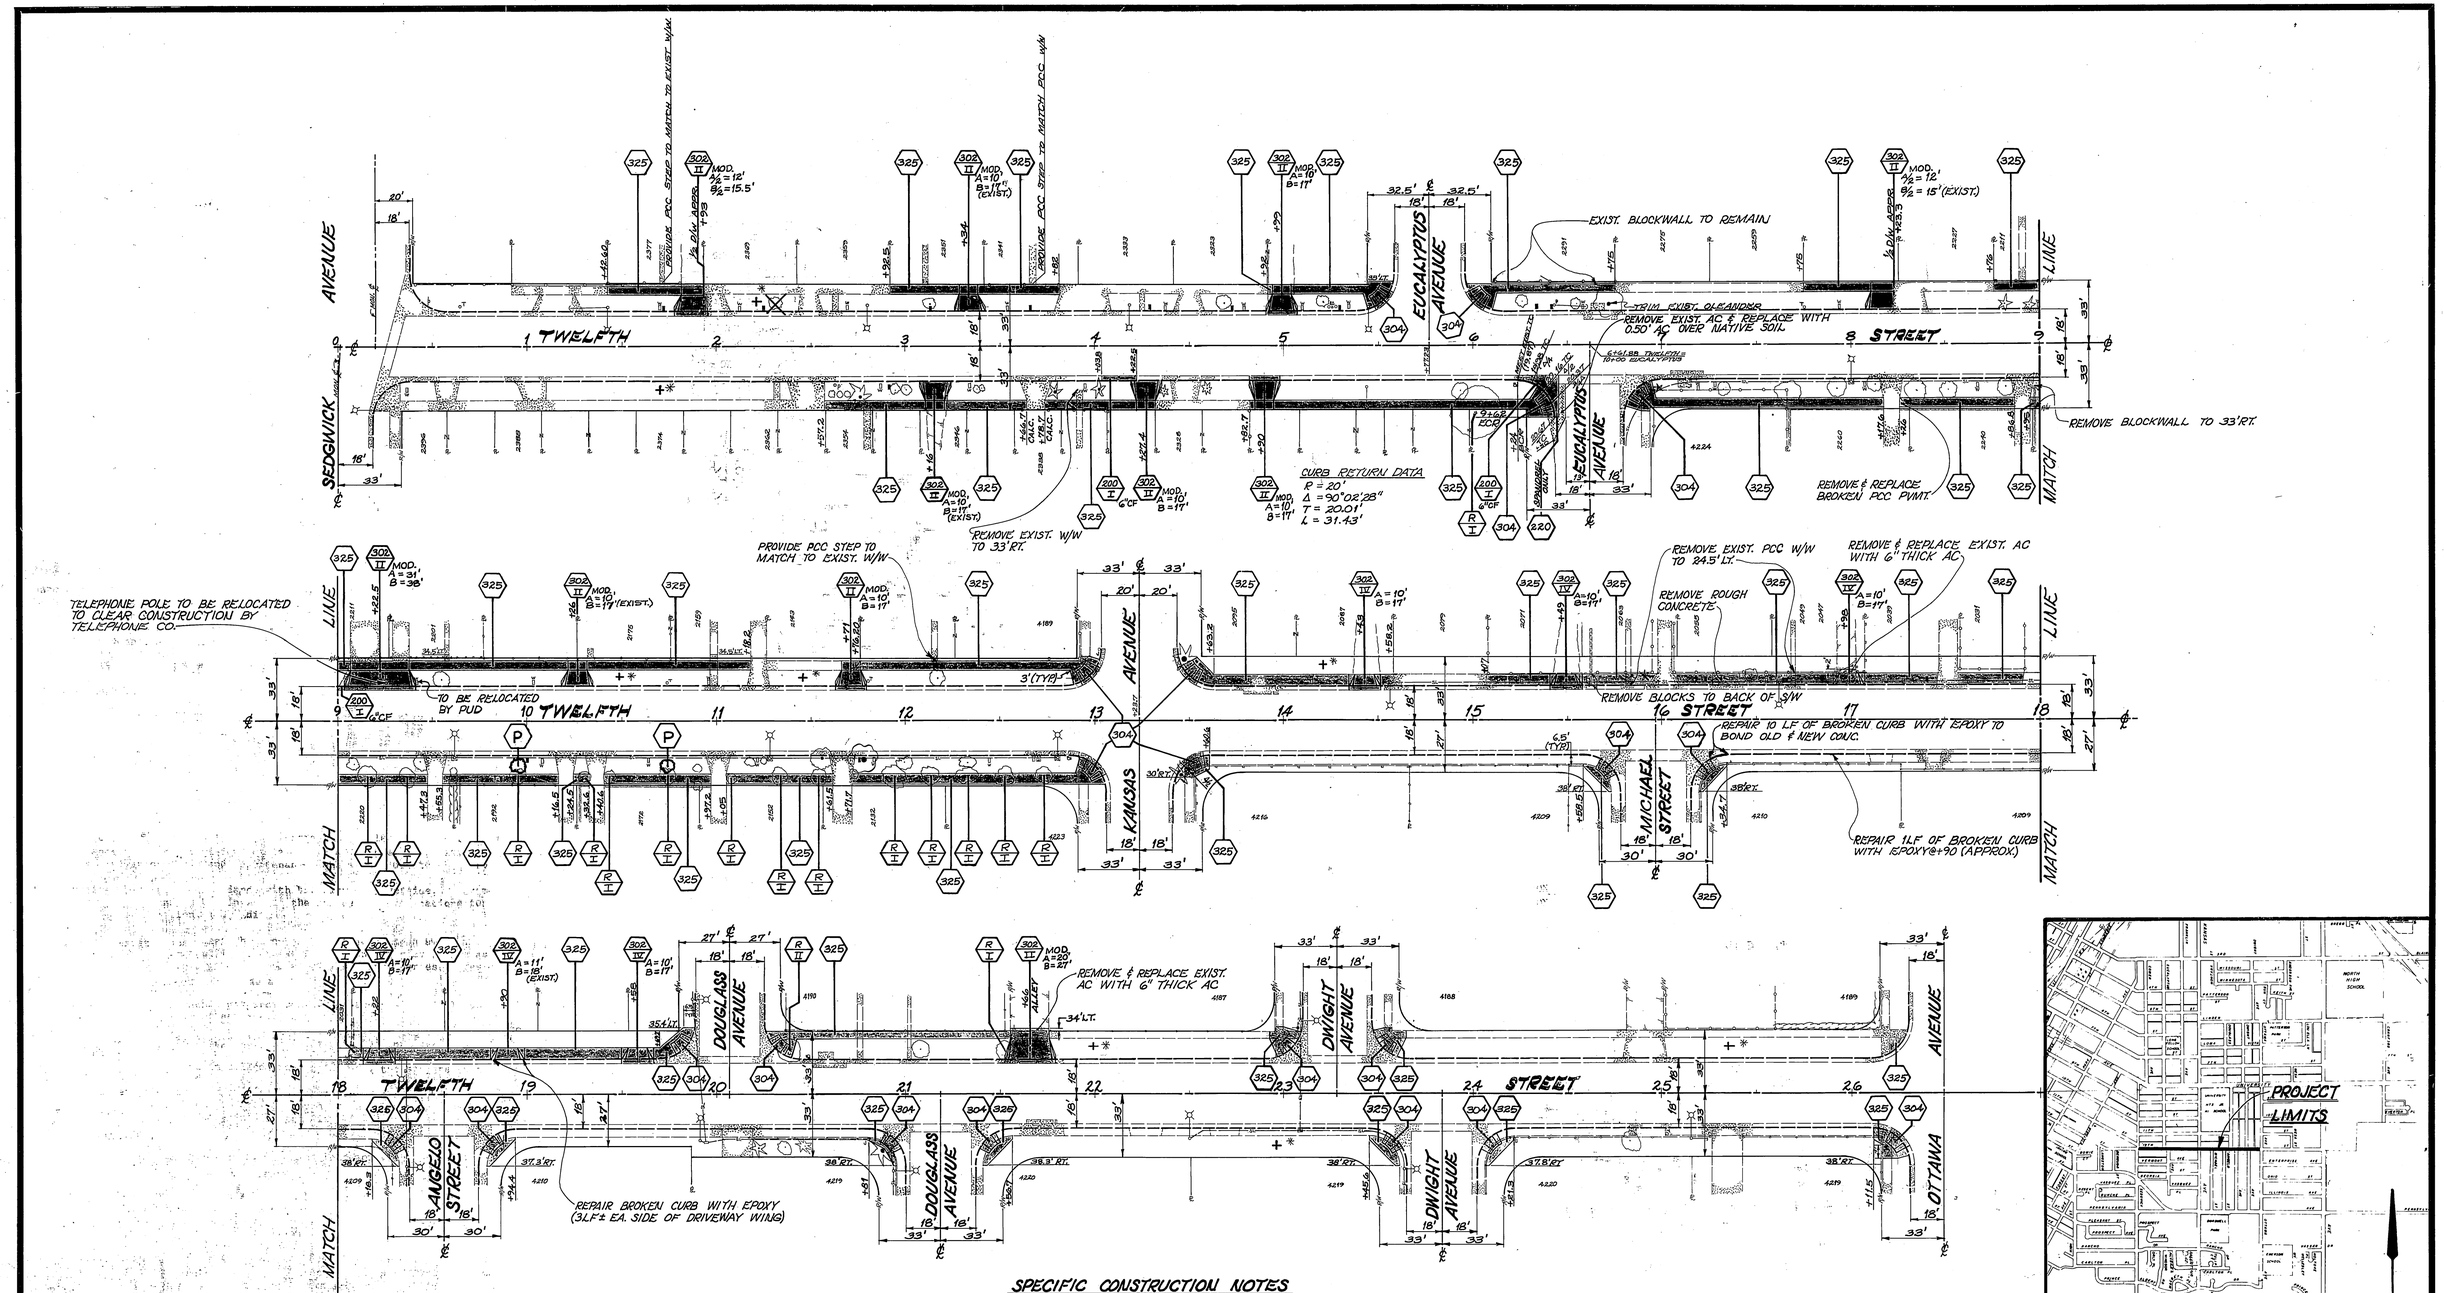

CONSTRUCTION LEGEND

CENTER LINE — ℄ —
RIGHT-OF-WAY — R/W —
SUBDIVISION LOT LINE — ℄ —
TOP OF SLOPE
TOE OF SLOPE
DIRECTION OF FLOW

GENERAL CONSTRUCTION NOTES

1. EXISTING IMPROVEMENTS SUCH AS FENCES AND BLOCKWALLS THAT CONFLICT WITH CONSTRUCTION SHALL BE REMOVED BY THE CONTRACTOR. SALVAGED MATERIALS SHALL BE PLACED ON ADJACENT PROPERTY.
2. SEE SPECIAL PROVISIONS FOR WORK INVOLVING SPRINKLER ADJUSTMENT AND GRADING ADJACENT TO NEW SIDEWALK.
3. THE PROPOSED SIDEWALK GRADE SHALL BE SUCH AS TO FOLLOW THE EXISTING TERRAIN AND MATCH EXISTING WALKWAYS AND DRIVEWAYS. AT SOME WALKWAYS STEPS WILL BE NECESSARY AS SHOWN ON PLAN.
4. UNDERGROUND UTILITIES ARE NOT SHOWN EXCEPT FOR STREET LIGHT CONDUITS.
5. ALL ELEVATIONS SHOWN ON THE PLAN SHALL BE STAKED IN FIELD.

SPECIFIC CONSTRUCTION NOTES

- NUMBERS ABOVE 100 IN A HEXAGON ON THE PLAN REFER TO THE RESPECTIVE STANDARD DRAWING AND SHALL BE CONSTRUCTED ACCORDINGLY UNLESS MODIFICATIONS ARE NOTED ON THE PLAN. ANY NUMBER SHOWN BELOW THE STANDARD DRAWING NUMBER INDICATES THE SPECIFIC ALTERNATE TO BE CONSTRUCTED.
- R/II REMOVE TREE. SEE SPECIAL PROVISIONS FOR TREE DIAMETER AND CLASS INVOLVED.
- P PLANT 15 GALLON HOLLY OAK TREE IN A GRADED TREE WELL (3' DIA. × 6" DEEP).
- 302/II MOD. CONSTRUCT DRIVEWAY APPROACH PER STD. DWG. 302 M.
- * + PLANT CRAPE MYRTLE TREE

* As built 9·25·85 TL
AS BUILT 3/3/83 RJM

INDEXED UP

MARK	REVISIONS	APPR.	DATE

DESIGNED BY [illegible] DRAWN BY [illegible] CHECKED BY WLK

CITY OF RIVERSIDE
PUBLIC WORKS DEPARTMENT

APPROVED	BY	DATE
PRINCIPAL ENGINEER	[illegible]	9-22-82
PARK DEPARTMENT	[illegible]	4/16/82
TRAFFIC DIVISION	[illegible]	4-16-82
CHIEF P. W. ENGINEER	[illegible]	4-23

APPROVED BY [signature]
PUBLIC WORKS DIRECTOR
DATE 4/23/82

TWELFTH STREET IMPROVEMENTS
(AN HCD EASTSIDE PROJECT)
SEDGWICK TO OTTAWA

HORIZ. SCALE: 1" = 40'

ACCOUNT NO. 15-550-580,581

R-2435

SHEET 1 OF 1