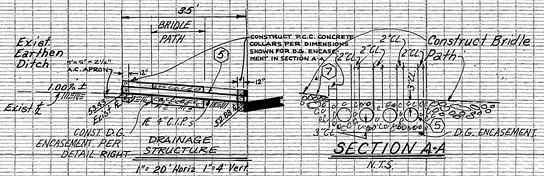

SECTION A-A

N.T.S.

Curve Data				
No.	Δ	R	L	T
(1)	34°12'52"	781.36'	466.61	240.50
(2)	34°09'33"	781.36'	465.84	240.08
(3)	01°02'24"	841.36'	15.27	7.64
(4)	34°09'33"	721.36'	430.07	221.64
(5)	101°28'40"	883.36'	161.54	81.00
(6)	101°19'47"	824.36'	148.62	74.51

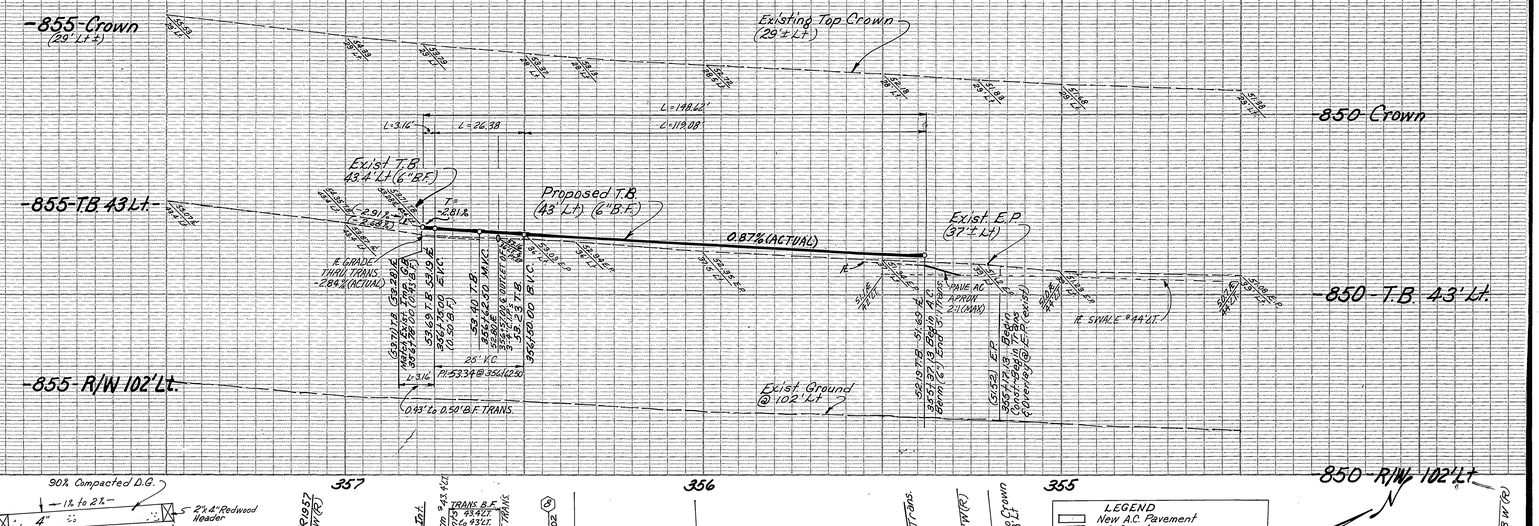

GENERAL NOTES:

1. It shall be the responsibility of the contractor and/or developer to clear the right-of-way in accordance with the provisions of the law as it affects each utility including irrigation lines and appurtenances and at no cost to the City.

2. Construction shall be in accordance with the City of Riverside, Department of Public Works, Standard Drawings and Specifications for Public Works Construction, 1982 Edition.

3. A.C. Berm shall be staked with 3.0 foot off-sets at 25-foot intervals.

4. NOTICE TO CONTRACTOR: The existence and location of any underground utility pipes of structures shown on these plans were obtained by a search of the available records. To the best of our knowledge there are no existing utilities except as shown on these plans. The contractor is required to take precautionary measures to protect the utility lines shown and any other lines not of record or not shown on these plans.

5. Driveway approach shall be constructed as shown on Plan.

6. Trim edge of existing pavement where new pavement joins to a smooth, straight line. Construct match-up paving as shown on Plan and overlay as directed in the field to produce a smooth section. Engineer estimates overlay to be 2-tons.

7. The private engineer signing these Plans is responsible for assuring the accuracy and acceptability of the work hereon. In the event of discrepancies arising during construction, the private engineer signing these plans shall be responsible for determining an acceptable solution and revising the Plans for approval by the City.

8. All flagged elevations shall be staked in the field by the private engineer.

9. Developer to give City Water Division five (5) working days written notice prior to start of construction and to allow City ten (10) working days for completion of work. (787-7611)

* NOTE: CHANGES REQUESTED BY RESIDENT OR BY PRIVATE ENG. & CITY ENG.

CONSTRUCTION NOTES:

1. Construct asphaltic concrete berm per City of Riverside Std. #250 Type "I".
2. Place asphaltic concrete (A.C.) over base as per typical section (with seal coat).
3. Place asphaltic concrete overlay as shown.
4. Place A.C. pavement transition @ 5:1.
5. ~~INSTALL 4-35~~ 48.5 L.F. LONG 4" C.T.P. per detail this sheet.
6. Remove existing 8" R.C.P. (46'+/-).
7. Construct bridle path per detail this sheet.
8. ~~Construct driveway per City of Riverside Std. #302.~~ *

Contractor agrees that he shall assume sole and complete responsibility for job site conditions during the course of construction of this Project, including safety of all persons and property; that this requirement shall apply continuously and not be limited to normal working hours; and that the Contractor shall defend, indemnify and hold the Owner and the Engineer harmless from any and all liability, real or alleged, in connection with the performance of work on this Project, excepting for liability arising from the sole negligence of the Owner or the Engineer.

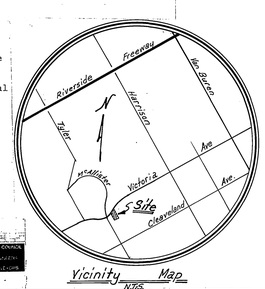

Vicinity Map N.T.S.

Bridle Path

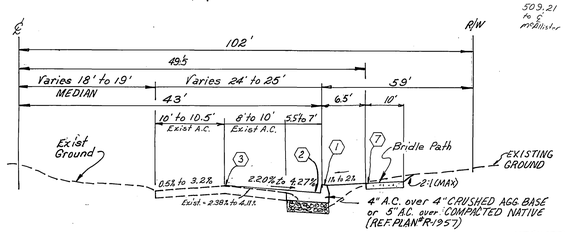

Sta. 355+37.13 to Sta 356+57.00

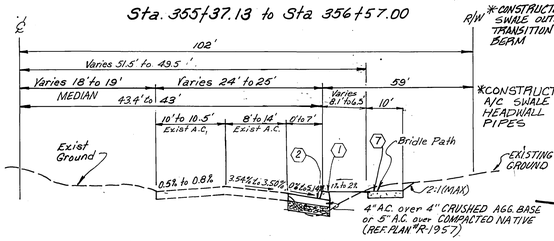

Sta. 356+57.00 to 356+78.00

TYPICAL SECTIONS

VICTORIA AVENUE T.I. = 7

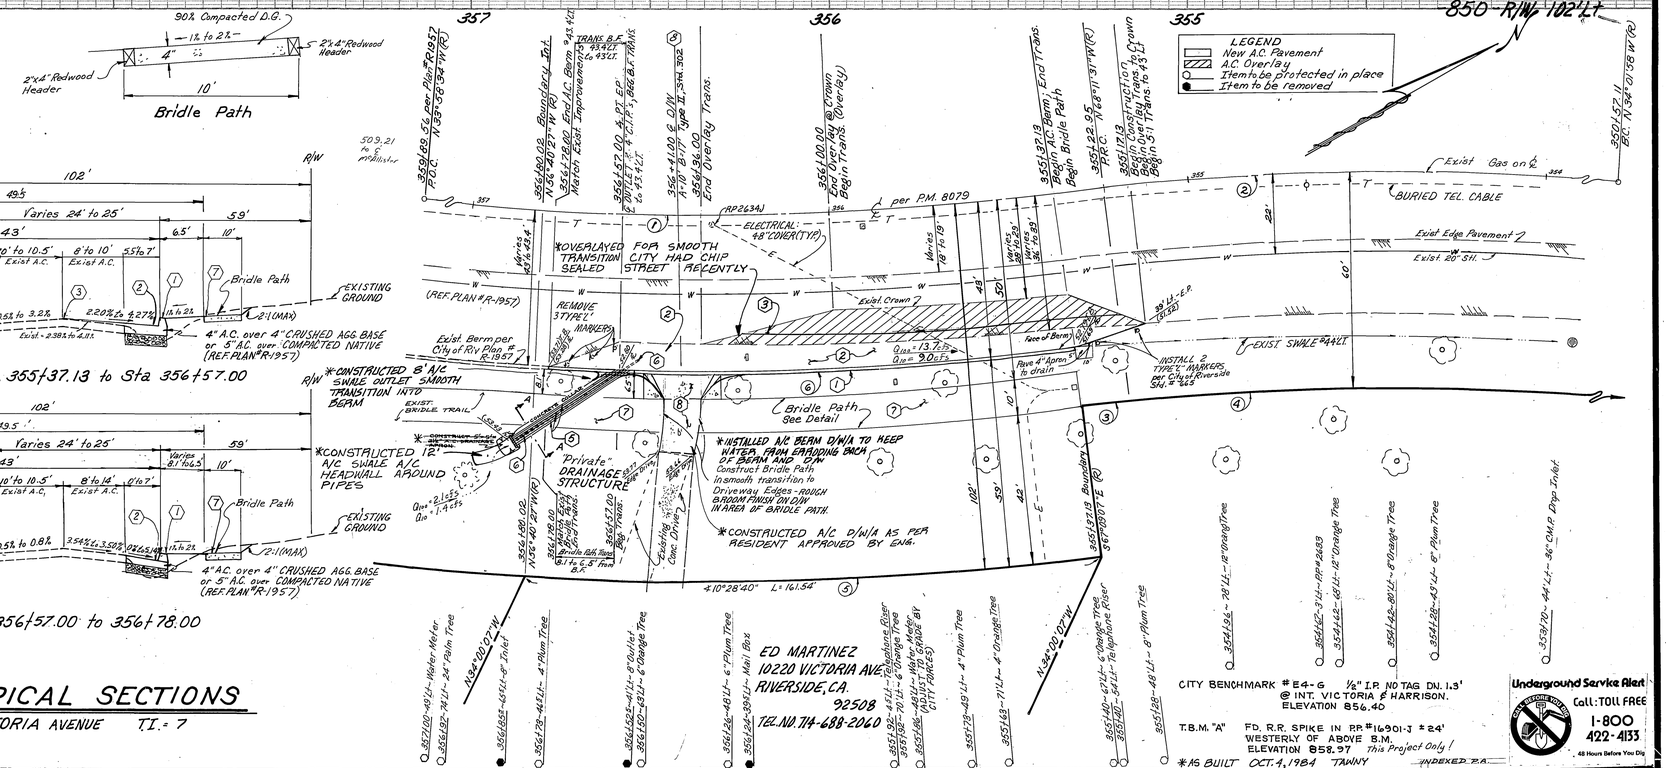

ED MARTINEZ
10220 VICTORIA AVE.
RIVERSIDE, CA. 92508
TEL. NO. 714-688-2060

CITY BENCHMARK # E4-G 1/2" I.P. NO TAG DN. 1.3' @ INT. VICTORIA & HARRISON. ELEVATION 856.40

T.B.M. "A" FD. R.R. SPIKE IN P.P. #16901-J ± 24' WESTERLY OF ABOVE B.M. ELEVATION 858.27 This Project Only!

* AS BUILT OCT. 4, 1984 TAWNY INDEXED P.A.

Underground Service Alert — Call: TOLL FREE 1-800 422-4133 — 48 Hours Before You Dig

Pacific Telephone

Fred M. Dewell Engr. 10-20-82
Name Title Date

CITY OF RIVERSIDE
PUBLIC UTILITIES
ELECTRICAL DIVISION

John Johnson 10-13-82
CHIEF UTILITIES ENGINEER, ELECTRICAL DATE

CITY OF RIVERSIDE
DOMESTIC SYSTEM & IRRIGATION SYSTEM

Fred Lantz 10/12/82
WATER SYSTEMS MANAGER DATE

J. F. DAVIDSON ASSOCIATES
CIVIL ENGINEERS - SURVEYORS - PLANNERS
RIVERSIDE, CALIFORNIA

APPROVED BY Joel W. Autry DATE 9/10/82
R.E. No. 17550

W.O. 82-7634 FOR: MARTINEZ F.B. 7634/-

MARK	REVISIONS	APPR.	DATE

DESIGNED BY R.L.S. DRAWN BY P. CHECKED BY M.M.P.

CITY OF RIVERSIDE, CALIFORNIA
PUBLIC WORKS DEPARTMENT

APPROVED BY	BY	DATE
PRINCIPAL ENGINEER		
PARK DEPARTMENT		
TRAFFIC DIVISION		
CHIEF PUB. WKS. ENGR.		

APPROVED BY
DIRECTOR OF PUBLIC WORKS
DATE 11/23/82

Victoria Avenue

SOUTHEAST SIDE FROM STA. 355+37.13 TO STA. 356+80.02

10220 VICTORIA AVENUE

BUILDING PERMIT

SCALE: 1"=20' Horiz. 1"=4' Vert.

ACCOUNT No.

DRAWING NUMBER R-2490

SHEET 1 OF 1

FILE No. 82-7659 (M)