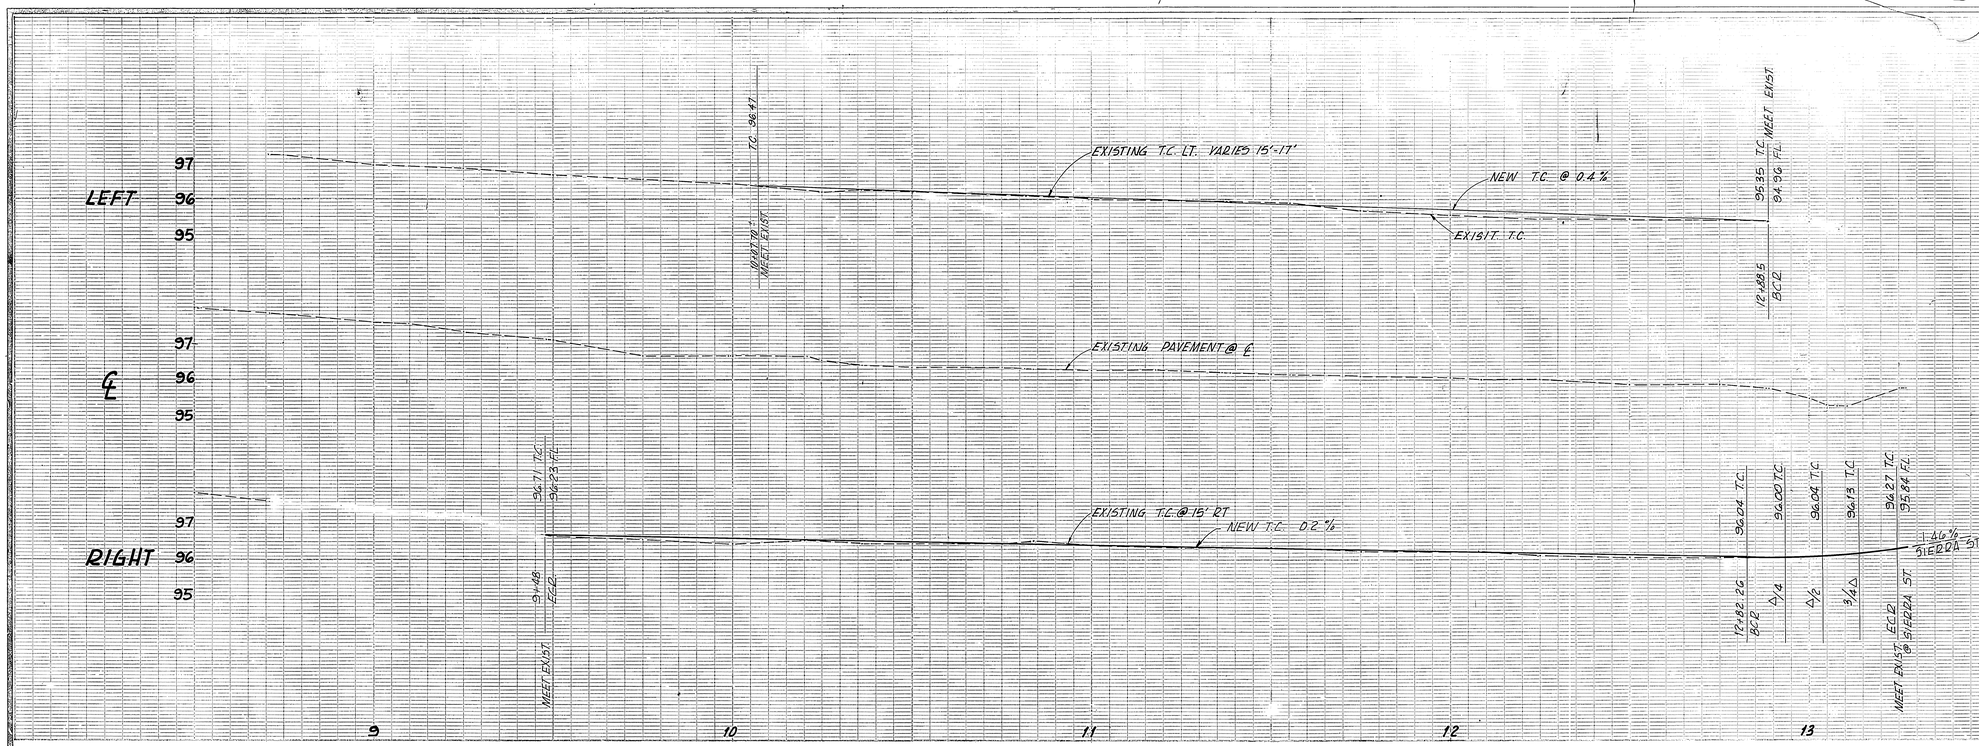

T.B.M.
N&T @ STA. 13+25 ℄ VALENCIA ST.
ELEV. 795.72

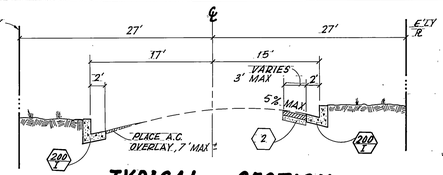

TYPICAL SECTION

"VALENCIA STREET"
NOT TO SCALE

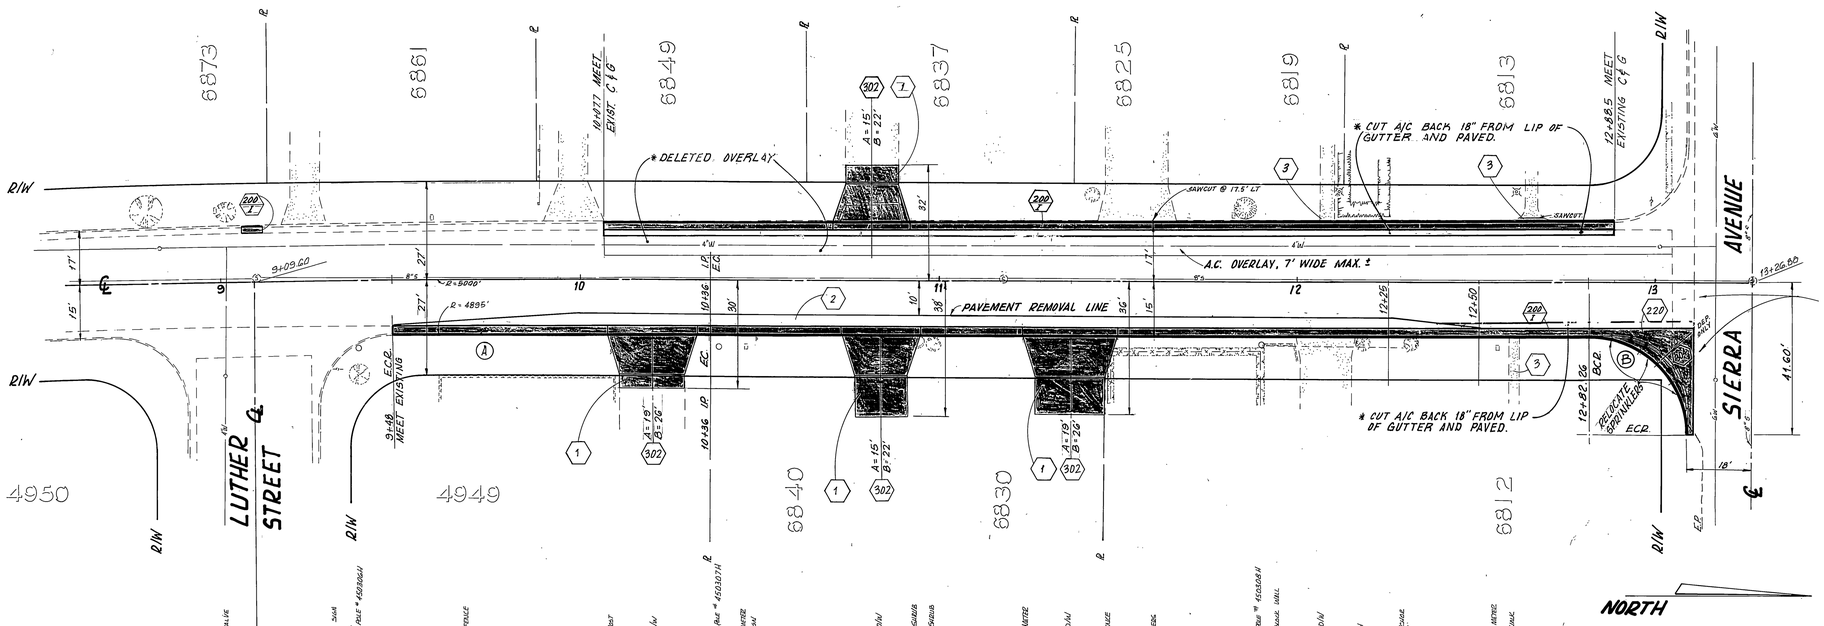

GENERAL NOTES

1. CONST. SHALL BE IN ACCORDANCE WITH THE CITY OF RIVERSIDE, STD. DWGS. AND STD. SPECS. FOR PUBLIC WORKS CONSTRUCTION, 1982 EDITION.

● NUMBERS ABOVE 100 IN HEXAGON ON THE PLAN REFER TO THE RESPECTIVE STANDARD DRAWING AND SHALL BE CONSTRUCTED ACCORDINGLY, UNLESS MODIFICATIONS ARE NOTED ON THE PLAN BELOW. ANY NUMBER SHOWN BELOW THE STANDARD DRAWING NUMBER INDICATES THE SPECIFIC ALTERNATE TO BE CONSTRUCTED.

REMOVE AND REPLACE BROKEN PAVEMENT AS DIRECTED (2)

▭ ASPHALT OVERLAY WIDTH VARIES (7' MAX. ±)

CONSTRUCTION NOTES

(200/1) - CONSTRUCT CURB & GUTTER PER STD. DWG. NO. 200. (6" C.F.)

(302/1) - CONSTRUCT CONC. DRIVEWAY APPROACH PER STD. DWG. NO. 302 I. A & B AS NOTED.

(304) - CONSTRUCT DEPRESSION ONLY FOR FUTURE WHEELCHAIR RAMP PER. STD. DWG. NO. 304.

(220) - CONSTRUCT SPANDREL AS PER STD. DGW. NO. 220.

(1) - ADJUST DWY. ON PRIV. PROP. TO GRADE. USE 4" P.C.C.

(2) - PAVEMENT REPLACEMENT TO BE 0.21' AC. OVER 6" CLASS 2 BASE.

(3) - ADJUST PCC WALKWAY

* AS BUILT 5-7-84 Shop.

INDEX 4F

CURB RETURN DATA

NO.	R	Δ	L	T
A	4985'	1° 00' 38"	87.92'	43.96'
B	27'	89° 29' 00"	42.17'	26.76'

MARK	REVISIONS	APPR.	DATE

DESIGNED BY [signature] DRAWN BY [signature] CHECKED BY

CITY OF RIVERSIDE
PUBLIC WORKS DEPARTMENT

APPROVED BY	DATE	BY
PRINCIPAL ENGINEER	[signature]	1/3/84
PARK DEPARTMENT		
TRAFFIC DIVISION	12/23/83	[signature]
CHIEF P. W. ENGINEER	[signature]	1.5

APPROVED BY [signature]
PUBLIC WORKS DIRECTOR
DATE 1/6/84

VALENCIA STREET
CURB & GUTTER REPLACEMENT
LUTHER STREET TO SIERRA AVE.

HORIZ. SCALE: 1" = 20' VERT. SCALE: 1" = 4'

ACCOUNT NO. - 30-575-257-30

R-2553

SHEET 1 OF 1