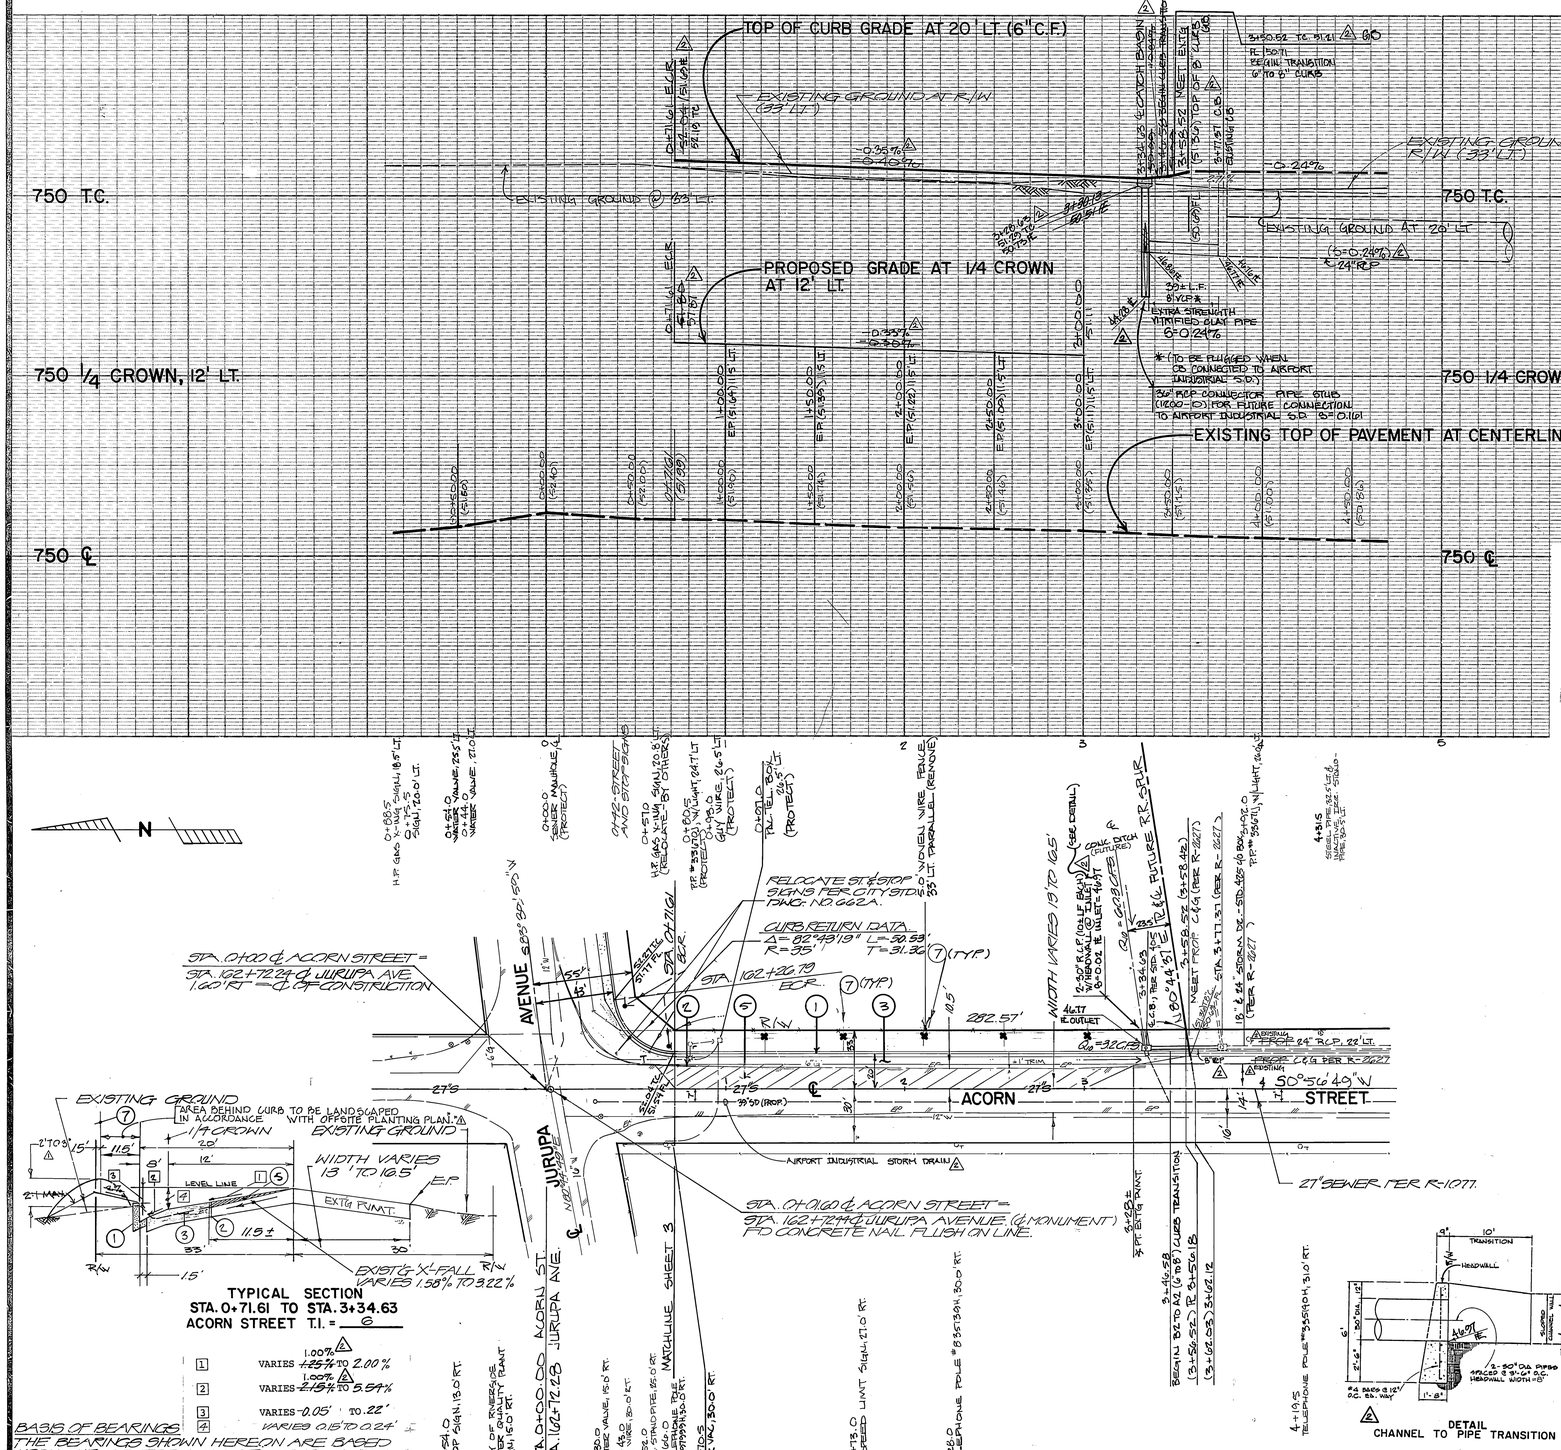
TOP OF CURB GRADE AT 20' LT (6" C.F.)
EXISTING GROUND AT R/W (33' LT.)
EXISTING GROUND @ 63' LT.
750 T.C.
PROPOSED GRADE AT 1/4 CROWN AT 12' LT.
750 1/4 CROWN, 12' LT.
EXISTING TOP OF PAVEMENT AT CENTERLINE
750 ℄
EXISTING GROUND AT R/W (33' LT.)
EXISTING GROUND AT 20' LT
750 T.C.
750 1/4 CROWN, 12' LT.
750 ℄
-0.35%
-0.40%
-0.24%
-0.33%
-0.39%
-0.24%
* (TO BE PLUGGED WHEN DS CONNECTED TO AIRPORT INDUSTRIAL S.D.)
36" RCP CONNECTOR PIPE STUB (1200-ID) FOR FUTURE CONNECTION TO AIRPORT INDUSTRIAL S.D. S=0.16%
CONCRETE CUTOFF WALL
CONCRETE HEADWALL
CATCH BASIN
CURB INLET
EXISTING 18" RCP
EXISTING 24" RCP
EXISTING

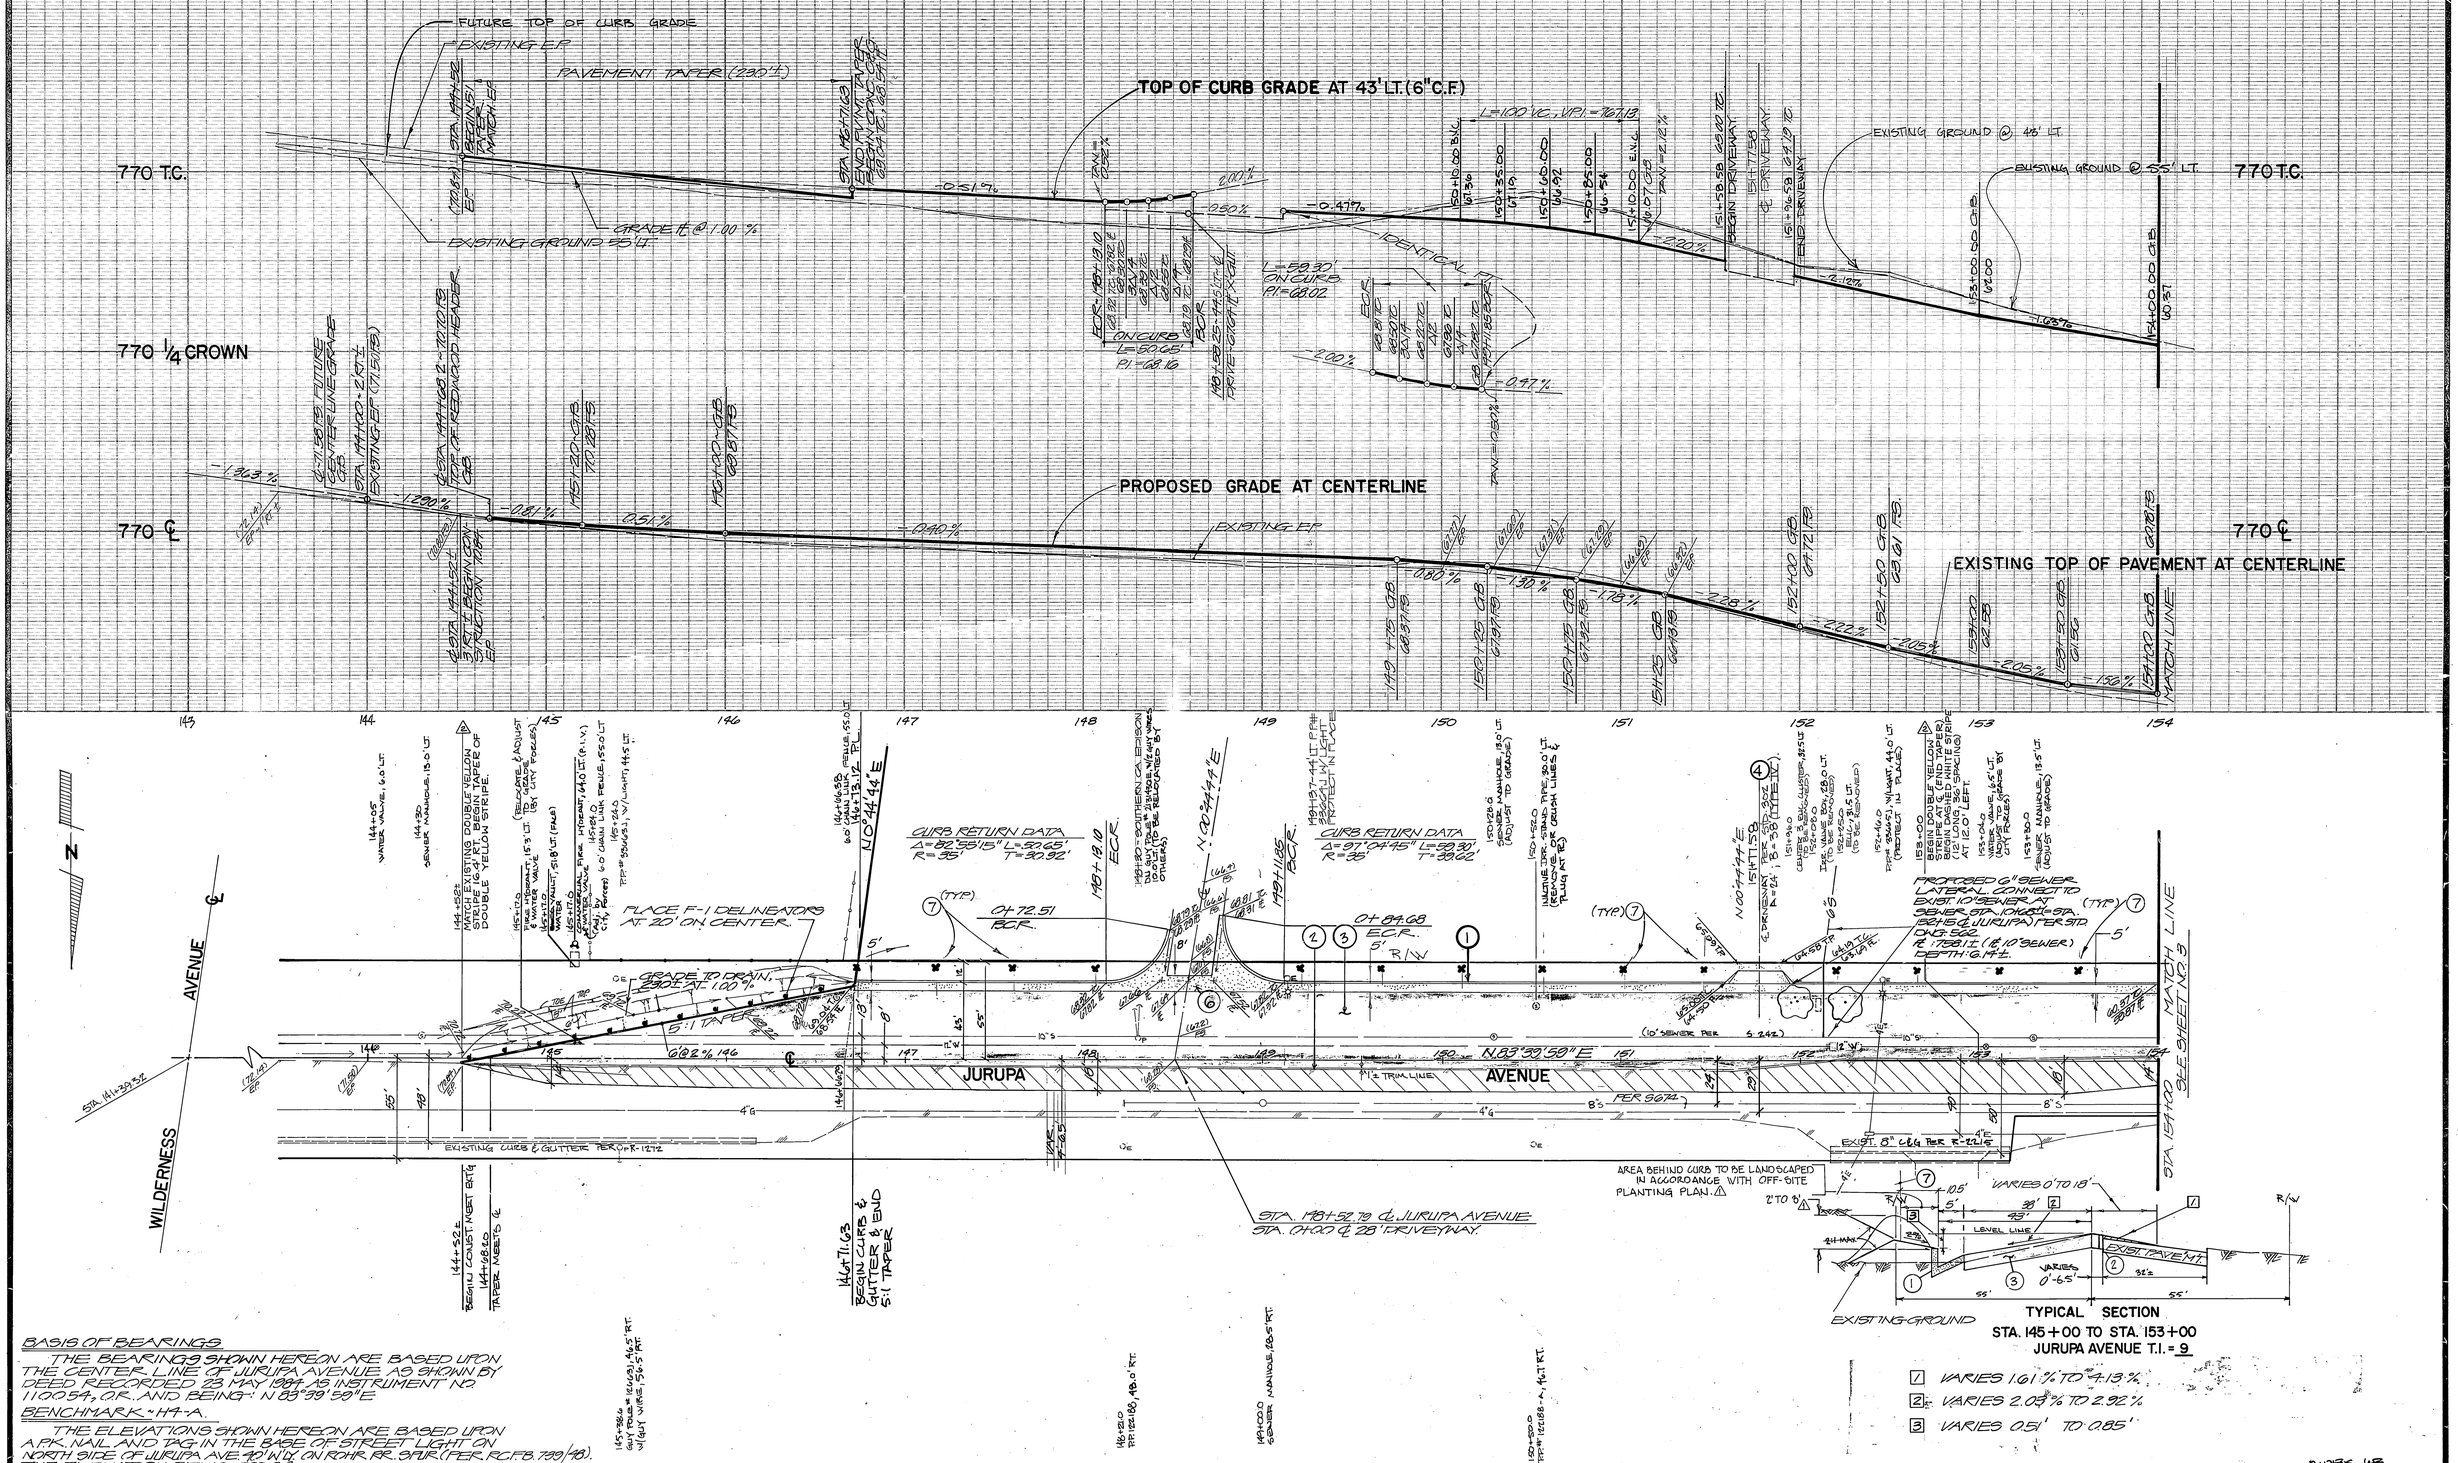

BASIS OF BEARINGS

THE BEARINGS SHOWN HEREON ARE BASED UPON THE CENTER LINE OF JURUPA AVENUE AS SHOWN BY DEED RECORDED 23 MAY 1984 AS INSTRUMENT NO. 110054, O.R. AND BEING: N 89°39'59"E

BENCHMARK - HT-A

THE ELEVATIONS SHOWN HEREON ARE BASED UPON A P.K. NAIL AND TAG IN THE BASE OF STREET LIGHT ON NORTH SIDE OF JURUPA AVE. 40' W'LY OF ROHR RR. SPUR. (PER RCFB 739/18). THE ELEVATION BEING: 788.34'.

SOUTHERN CALIFORNIA EDISON COMPANY Edward O Ruiz 3-25-85 REVIEWED BY:	CITY OF RIVERSIDE PUBLIC UTILITIES, ELECTRIC John Johnson 4/30/85 APPROVED BY: DATE	KRIEGER & STEWART ENGINEERING CONSULTANTS 3602 UNIVERSITY AVE., SUITE 201 RIVERSIDE, CALIFORNIA 92501 (714) 684-6900
PACIFIC TELEPHONE COMPANY W. H. Hanna 2-15-85 APPROVED BY: DATE	SOUTHERN CALIFORNIA GAS COMPANY E. P. Ruder 3-26-85 REVIEWED BY: DATE	CITY OF RIVERSIDE DOMESTIC WATER SYSTEM L. De L. Fowler 5-9-85 APPROVED BY: DATE

APPROVED BY: Julian D. Stevens
R.C.E. No. 17661 DATE 2-17-84

MARK	REVISIONS	APPR.	DATE
⚠	ADD STRIPING NOTES	Bmn	1-28-86
⚠	ADDED LANDSCAPING BERM. SDH 81/1985	WLL	11/14/85

DESIGNED BY: TDB DRAWN BY: SEM CHECKED BY: JDS/RB

CITY OF RIVERSIDE, CALIFORNIA PUBLIC WORKS DEPARTMENT			
APPROVED BY	BY	DATE	APPROVED BY
PRINCIPAL ENGINEER			William D. Gardner
PARK DEPARTMENT	BC	4-4-85	DIRECTOR OF PUBLIC WORKS
TRAFFIC DIVISION	Bmn	5/3/85	
CHIEF PUB. WKS. ENGR.			
	LEE	11/21/85	DATE Mar 24, 1985

STREET IMPROVEMENT PLANS

JURUPA AVENUE

FROM 312.68' W'LY OF WILDERNESS AVE. TO 1260.68' W'LY MP-9-837

SCALE: HORIZ. 1"=40' VERT. 1"=4'

ACCOUNT No.

DRAWING NUMBER R-2672

SHEET 2 OF 3

209-6

TOP OF CURB GRADE AT 43' LT. (6" C.F.)

EXISTING GROUND @ 43' LT.

EXISTING GROUND @ 55' LT.

760 T.C.

760 ℄

EXISTING TOP OF PAVEMENT N ℄

PROPOSED GRADE AT CENTERLINE

EXISTING E.P. SOUTH OF ℄

STA. 154+00 MATCH LINE

SEE SHEET NO. 2

STA. 154+00 MATCH LINE

SEE SHEET NO. 1

JURUPA AVENUE (122.40' R/W)

PAYTON AVE.

ACORN STREET

JURUPA AVENUE

EXISTING ℄ & PAVEMENT PER R-2662

PER R-258

PER 5674

1552.16' (FRONTAGE DISTANCE)

N 83°39'59" E

℄ STA. 156+10 TO JURUPA AVENUE = (R 250)

℄ STA. 0+00 PAYTON AVENUE FOUND 1/4" I.D.I.P. FLUSH IN PAVEMENT TAGGED RCE 16256 PER PM. 118/80-91 (0.05' S'LY OF LINE)

STA. 162+72.44 ℄ JURUPA AVENUE = STA. 0+16.00 ℄ ACORN STREET (℄ MONUMENT) FOUND CONCRETE NAIL FLUSH ON LINE.

162+36.79 END GUTTER TAPER (5' TO 1.5') GUTTER 1.5' WIDE

AREA BEHIND CURB TO BE LANDSCAPED IN ACCORDANCE WITH OFF-SITE PLANTING PLAN △1 (VARIES 2' TO 18')

TYPICAL SECTION
STA. 153+00 TO STA. 162+26.79
JURUPA AVENUE T.I. = 9

△1 VARIES 1.00% TO 1.91%

△2 VARIES 1.21% TO 2.61%

△3 VARIES 0.31' TO 0.73'

STA. 162+72.44 ℄ JURUPA AVE. 160 RT. = STA. 0+00 ℄ ACORN ST. = ℄ OF CONSTRUCTION.

EXISTING GROUND

EXISTING PAVEMENT

CURB RETURN DATA (BOTH)
Δ = 90°00'00" L = 94.98
R = 35.00' T = 35.00

CURB RETURN DATA
Δ = 82°48'10"
R = 35.00'
L = 50.58'
T = 30.81'

BASIS OF BEARINGS

THE BEARINGS SHOWN HEREON ARE BASED UPON THE CENTER LINE OF JURUPA AVENUE AS SHOWN BY DEED RECORDED 23 MAY 1924 AS INSTRUMENT NO. 11 IN BOOK 511, O.R. AND BEING: N 89°39'59" E.

BENCHMARK: HA-A

THE ELEVATIONS SHOWN HEREON ARE BASED UPON A PK NAIL AND TAG IN BASE OF STREET LIGHT ON NORTH SIDE OF JURUPA AVENUE 40' N'LY. ON ROHR R.R. SPUR (PER R.C.F.B. 739/98) ELEVATION BEING: 788.314.

INDEX 4P

SOUTHERN CALIFORNIA EDISON COMPANY Edward Ruiz 3-25-85 REVIEWED BY	CITY OF RIVERSIDE PUBLIC UTILITIES, ELECTRIC John Johnson 9/30/85 APPROVED BY DATE
PACIFIC TELEPHONE COMPANY W. R. Hamm 2-15-85 APPROVED BY DATE	SOUTHERN CALIFORNIA GAS COMPANY R. A. Parker 3-26-85 REVIEWED BY DATE
	CITY OF RIVERSIDE DOMESTIC WATER SYSTEM D. L. Parker 5-9-85 APPROVED BY DATE

KRIEGER & STEWART
ENGINEERING CONSULTANTS
3602 UNIVERSITY AVE., SUITE 201
RIVERSIDE, CALIFORNIA 92501
(714) 684-6900

APPROVED BY Julian Kl. Stewart
R.C.E. No. C-17661 DATE 3-17-84

MARK	REVISIONS	APPR.	DATE
△3	ADD STRIPING NOTES	Bm	1-28-86
△2	REVISE TO PROVIDE T-X-SECT NOTE SDH 10/18/85	WH	11/4/85
△1	ADDED LANDSCAPING BERM, SDH 8/19/85	WH	11/4/85

DESIGNED BY WFS DRAWN BY SFM CHECKED BY SDH

CITY OF RIVERSIDE, CALIFORNIA
PUBLIC WORKS DEPARTMENT

	BY	DATE
APPROVED BY PRINCIPAL ENGINEER		
PARC DEPARTMENT	Eric S.	2-5-85
TRAFFIC DIVISION	Kim	6-13-85
CHIEF PUB. WKS. ENGR.		

APPROVED BY William D. Gardner
DIRECTOR OF PUBLIC WORKS
DATE MAY 24, 1985

STREET IMPROVEMENT PLANS

JURUPA AVENUE

FROM 210.70' E'LY OF PAYTON AVE. TO ACORN ST.
M.P. 9-83?

SCALE: HORIZ. 1"=40' VERT. 1"=4'

ACCOUNT No.

DRAWING NUMBER
R-2672

SHEET 3 OF 3

209-6