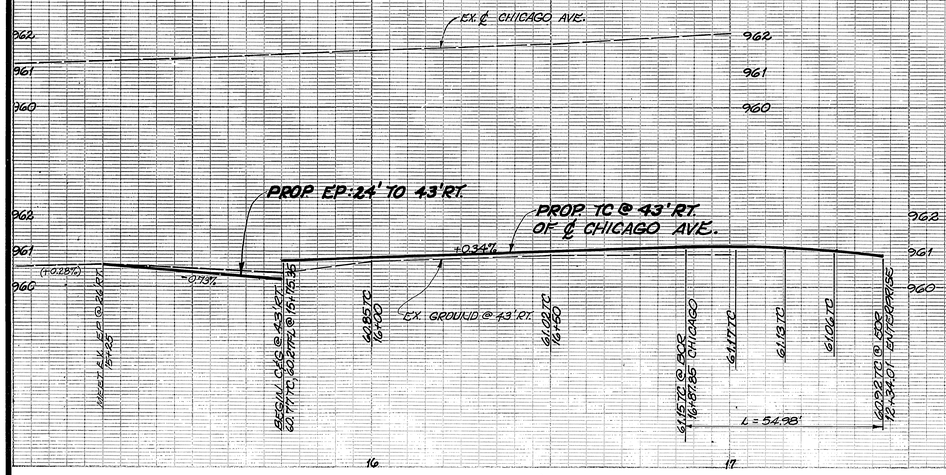

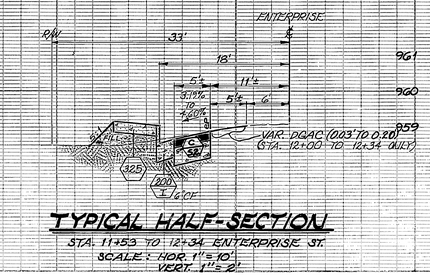

TYPICAL HALF-SECTION

STA. 11+53 TO 12+34 ENTERPRISE ST.
SCALE: HOR. 1" = 10'
VERT. 1" = 2'

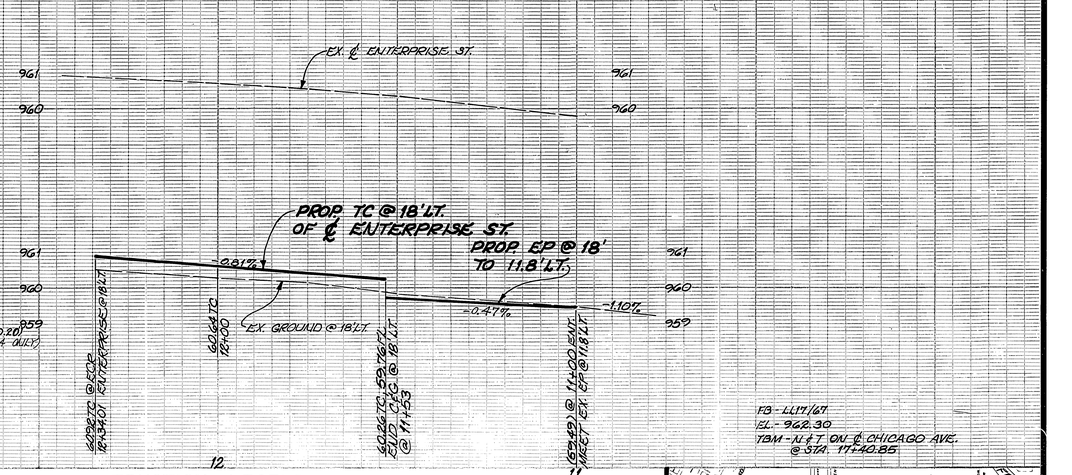

FB - LL17/67
EL. - 962.30
TBM - N ℄ T ON ℄ CHICAGO AVE. @ STA. 17+40.85

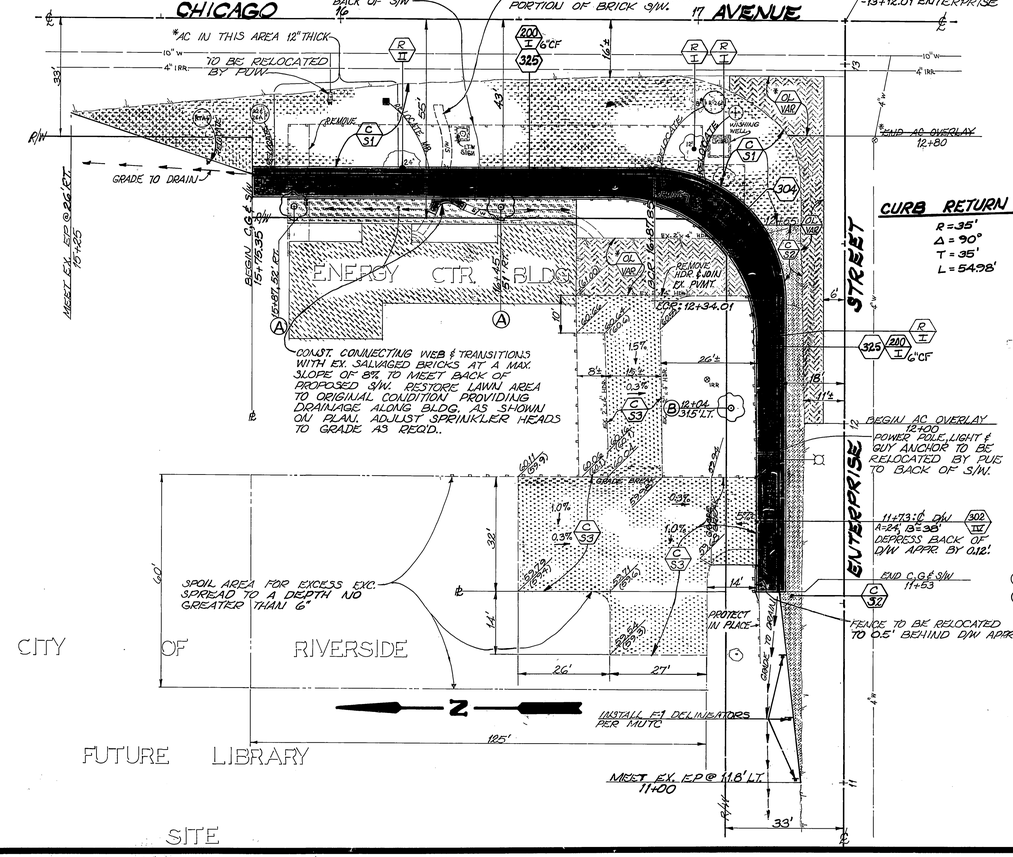

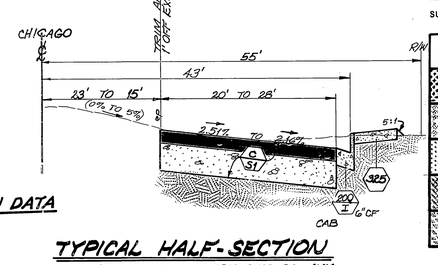

TYPICAL HALF-SECTION

STA. 15+75.35 TO 16+87.85 CHICAGO AVE.
SCALE: HOR. 1" = 10'
VERT. 1" = 2'

CURB RETURN DATA

R = 35'
Δ = 90°
T = 35'
L = 54.98'

LANDSCAPING NOTES

All related work shall conform to the City of Riverside, Park and Recreation Department Standards.

Contact the Park Projects Inspector a minimum of 48 hours in advance at 787-7223 to schedule inspections. Inspections shall be required:

a) When plant locations have been spotted in the field prior to digging plant pits.
b) While digging plant pits and planting/relocating trees.
c) After planting and all other indicated or specified work has been completed for start of maintenance.
d) At end of maintenance/full acceptance (contractor/developer will be released from maintenance only upon receipt of written notification from the city that the Park and Recreation Department is assuming maintenance responsibilities).

Street Tree planting shall be as follows:

	Street Name	Botanical Name/Common Name	Min. Size	Approx. Spacing	No. Req.
Ⓐ	Chicago Ave.	Washingtonia/California Fillifera / Fan Palm	8' of 45' Brown Trunk		2
Ⓑ	Enterprise St.	Geijera Parviflora/ Australian Willow	15 Gal. As Shown		1

Park and Recreation Department and Public Works Department permits are required prior to commencement of tree relocation and/or removal work. For all trees within the ultimate pavement area, backfill of all holes is to be inspected by the City for proper compaction.

CONSTRUCTION LEGEND

CENTER LINE ——℄——
RIGHT-OF-WAY LINE ——R/W——
SUBDIVISION LOT LINE ——℄——

TOP OF SLOPE
TOE OF SLOPE
DIRECTION OF FLOW

ADJ — ADJUST MH TO GRADE.
C S1 — ~~ALT I: CONST. STRUC. SEC. OF 0.33' DGAC OVER 0.75' CL. 2 CAB.~~
ALT. II: CONST. STRUC. SEC. OF 0.67' DGAC OVER COMPACTED NATIVE SOIL.
C S2 — ~~ALT I: CONST. STRUC. SEC. OF 0.25' DGAC OVER 0.50' CL. 2 CAB.~~
ALT. II: CONST. STRUC. SEC. OF 0.33' DGAC OVER COMPACTED NATIVE SOIL.
C S3 — CONST. PARKING LOT STRUC. SEC. OF 0.20' DGAC OVER 0.50' CL. 2 CAB. ADJUST EX. HEADER BOARDS & WHEEL STOPS TO FINISHED GRADE.
OL VAR — VARIABLE THICKNESS DGAC OVERLAY (0.03' TO 0.20')
RESTORED LAWN AREA

SPECIFIC CONSTRUCTION NOTES

⬢ NUMBERS ABOVE 100 IN A HEXAGON ON THE PLAN REFER TO THE RESPECTIVE STANDARD DRAWING AND SHALL BE CONSTRUCTED ACCORDINGLY, UNLESS MODIFICATIONS ARE NOTED ON THE PLAN OR COVER SHEET BELOW. ANY NUMBER SHOWN BELOW THE STANDARD DRAWING NUMBER INDICATES THE SPECIFIC ALTERNATE TO BE CONSTRUCTED.

GENERAL CONSTRUCTION NOTES

1. ALL ELEVATIONS SHOWN ON THE PLANS SHALL BE STAKED IN THE FIELD.
2. EXIST. UTILITY MANHOLES, GATE VALVES AND VAULTS ARE NOT NECESSARILY SHOWN ON THE PLAN. IT SHALL BE THE CONTRACTORS RESPONSIBILITY TO COORDINATE WITH THE RESPECTIVE UTILITY COMPANIES FOR THE ADJUSTMENT OR PROTECTION OF THEIR FACILITIES. THE PUBLIC UTILITIES DEPARTMENT FACILITIES SHALL BE TREATED AS OUTLINED IN THE SPECIFICATIONS.
3. PRIME CONTRACTORS BIDDING THIS PROJECT SHALL HAVE CLASS A OR C-12 LICENSE.
4. RIGHT OF ENTRY APPROVED - ON SITE WORK IS ON CITY OWNED PROPERTY.

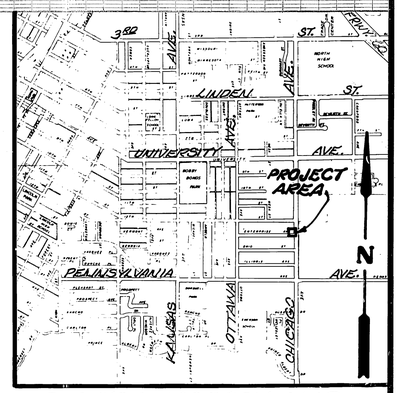

PROJECT LOCATION MAP

SCALE: 1" = 1600'

*AS BUILT 3-12-87 RPM

ENGINEER IN RESPONSIBLE CHARGE
Ronald C. Mueller
RONALD C. MUELLER
R.C.E. 29510 expires 3-31-87
DATE 10-15-86

REGISTERED PROFESSIONAL ENGINEER RONALD C. MUELLER NO. 29510 Expires 3-31-87 CIVIL STATE OF CALIFORNIA

INDEXED E.S.

APPROVED BY
PUBLIC UTILITIES ELECTRIC OFFICE OF ENERGY SERVICES
DATE Jan 29, 1986

MARK	REVISIONS	APPR.	DATE

DESIGNED BY GH DRAWN BY RPM CHECKED BY RCM

CITY OF RIVERSIDE
PUBLIC WORKS DEPARTMENT

APPROVED BY	DATE	BY
PRINCIPAL ENGINEER	10/15/86	
PARK DEPARTMENT	9-30-86	GS
TRAFFIC DIVISION	9-30-86	RSD
CHIEF P.W. INSPECTOR	10-2-86	GS
SURVEYOR	10-1-86	APH

APPROVED BY
William D. Anderson
PUBLIC WORKS DIRECTOR
DATE 10-15-86

CHICAGO AVE. @ ENTERPRISE ST. WIDENING FOR ENERGY CTR.

HORIZ. SCALE: 1" = 20' VERT. SCALE: 1" = 2'

ACCOUNT NO. 60-606-946-908
C23 - B45
R-2799
SHEET 1 OF 1

81630
OZALID - NO. 1