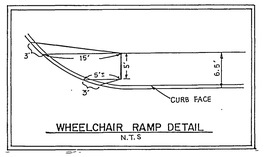

WHEELCHAIR RAMP DETAIL
N.T.S

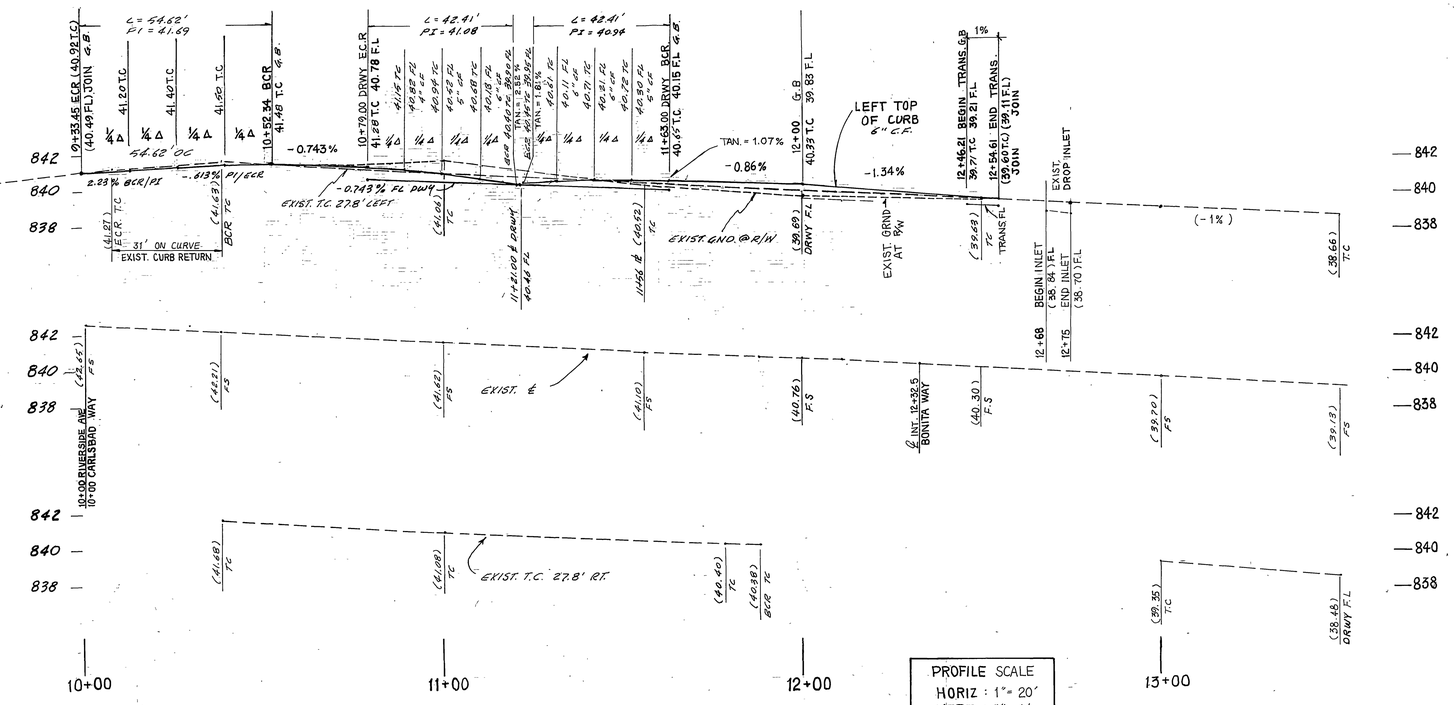

PROFILE SCALE
HORIZ : 1"= 20'
VERT : 1"= 4'

GENERAL NOTES RIVERSIDE PARK & RECREATION DEPARTMENT

1. ALL RELATED WORK SHALL CONFORM TO THE CITY OF RIVERSIDE, PARK AND RECREATION DEPARTMENT STANDARDS
2. CONTACT THE PARK PROJECTS INSPECTOR A MINIMUM OF 48 HOURS IN ADVANCE AT 787-7223 TO SCHEDULE INSPECTIONS. INSPECTIONS SHALL BE REQUIRED:
   A. WHEN PLANT LOCATIONS HAVE BEEN SPOTTED IN THE FIELD PRIOR TO DIGGING PLANT PITS.
   B. WHILE DIGGING PLANT PITS AND PLANTING/RELOCATING TREES.
   C. AFTER PLANTING AND ALL OTHER INDICATED OR SPECIFIED WORK HAS BEEN COMPLETED FOR START OF MAINTENANCE.
   D. AT END OF MAINTENANCE/FINAL ACCEPTANCE (CONTRACTOR/DEVELOPER WILL BE RELEASED FROM MAINTENANCE ONLY UPON RECEIPT OF WRITTEN NOTIFICATION FROM THE CITY THAT THE PARK AND RECREATION DEPARTMENT IS ASSUMING MAINTENANCE RESPONSIBILITIES.)
3. THE CONTRACTOR/DEVELOPER SHALL MAINTAIN ALL PLANTINGS FOR A MINIMUM PERIOD OF ONE (1) YEAR.
4. STREET TREE PLANTING SHALL BE AS FOLLOWS:

ST. NAME	BOTANICAL NAME/COMMON NAME
RIVERSIDE AVE.	PODOCARPUS GRACILOR (FERN PINE)
MIN.SIZE	APPR.SPACING : NO. REQ.
15 GAL.	45 : 2

5. PARK AND RECREATION DEPARTMENT AND PUBLIC WORKS DEPARTMENT PERMITS ARE REQUIRED PRIOR TO COMMENCEMENT OF TREE RELOCATION AND/OR REMOVAL WORK. FOR ALL TREES WITHIN THE ULTIMATE PAVEMENT AREA, BACKFILL OF ALL HOLES IS TO BE INSPECTED BY THE CITY FOR PROPER COMPACTION.
6. ALL STREET TREES TO BE AUTOMATICALLY IRRIGATED.

GENERAL NOTES

1. IT SHALL BE THE RESPONSIBILITY OF THE CONTRACTOR TO CLEAR THE RIGHT-OF-WAY IN ACCORDANCE WITH THE PROVISION OF LAW AS IT AFFECTS EACH UTILITY INCLUDING IRRIGATION LINES AND APPURTENANCES AND AT NO COST TO THE CITY.
2. CONSTRUCTION SHALL BE IN ACCORDANCE WITH THE CITY OF RIVERSIDE DEPARTMENT OF PUBLIC WORKS, STANDARD DRAWINGS, AND THE STANDARD SPECIFICATIONS FOR PUBLIC WORKS CONSTRUCTION, CURRENT EDITION.
3. TRIM EDGE OF EXISTING PAVEMENT WHERE NEW PAVEMENT JOINS TO A SMOOTH, STRAIGHT LINE. CONSTRUCT MATCH-UP PAVEMENT AS SHOWN ON PLAN AND OVERLAY PAVING AS DIRECTED IN THE FIELD TO PRODUCE A SMOOTH SECTION.
4. NO FINISHED FLOOR ELEVATION SHALL BE LESS THAN 4 FEET ABOVE THE SEWER FLOW LINE AT POINT OF CONNECTION WITHOUT HAVING A PROPER BACKWATER VALVE INSTALLED IN THE LATERAL.
5. QUANTITIES SHOWN ARE FOR INFORMATION ONLY AND THE CITY OF RIVERSIDE IS NOT RESPONSIBLE FOR THEIR ACCURACY.
6. ALL FLAGGED ELEVATIONS SHALL BE STAKED IN THE FIELD BY THE PRIVATE ENGINEER.
7. ALL ELEVATIONS SHOWN IN PARENTHESIS ARE EXISTING ELEVATIONS.
8. THE FEE FOR POWER POLE RELOCATION MUST BE PAID PRIOR TO COMMENCEMENT OF STREET IMPROVEMENT WORK.
9. THE PRIVATE ENGINEER SIGNING THESE PLANS IS RESPONSIBLE FOR ASSURING THE ACCURACY AND ACCEPTABILITY OF THE WORK HEREON. IN THE EVENT OF DISCREPANCIES ARISING DURING CONSTRUCTION, THE PRIVATE ENGINEER SHALL BE RESPONSIBLE FOR DETERMINING AN ACCEPTABLE SOLUTION AND REVISING THE PLANS FOR APPROVAL BY THE CITY.
10. THE DEVELOPER SHALL BE RESPONSIBLE FOR THE PRESERVING OR REESTABLISHING AND REFERENCING SURVEY MONUMENTS DESTROYED, DISTURBED OR BURIED AS A RESULT OF CONSTRUCTION SHOW HEREON.
11. ON ALL AREAS WITHIN PUBLIC RIGHT-OF-WAY WHERE THE FILL IS ONE (1) FOOT OR GREATER, A LETTER WILL BE REQUIRED FROM THE SOILS ENGINEER, CERTIFYING THE COMPACTION OF THE FILL BELOW SUBGRADE, PRIOR TO ISSUANCE OF THE CONSTRUCTION PERMIT/CUT SHEETS.
12. DEVELOPER TO GIVE CITY WATER DIVISION FIVE (5) WORKING DAYS WRITTEN NOTICE TO START OF CONSTRUCTION AND TO ALLOW CITY TEN (10) WORKING DAYS FOR COMPLETION OF WORK. ~~(787-7611)~~ (351-6150)
13. ANY TRAFFIC CONTROL STRIPING OBLITERATED AND/OR BADLY WORN DURING CONSTRUCTION SHALL BE RESTORED BY THE CONTRACTOR WITHIN FIVE (5) DAYS AFTER NOTIFICATION FROM THE CITY INSPECTORS.
14. FINAL STRIPING FOR TRAFFIC CONTROL AND/OR PAVEMENT MARKING TO BE THE RESPONSIBILITY OF THE DEVELOPER.

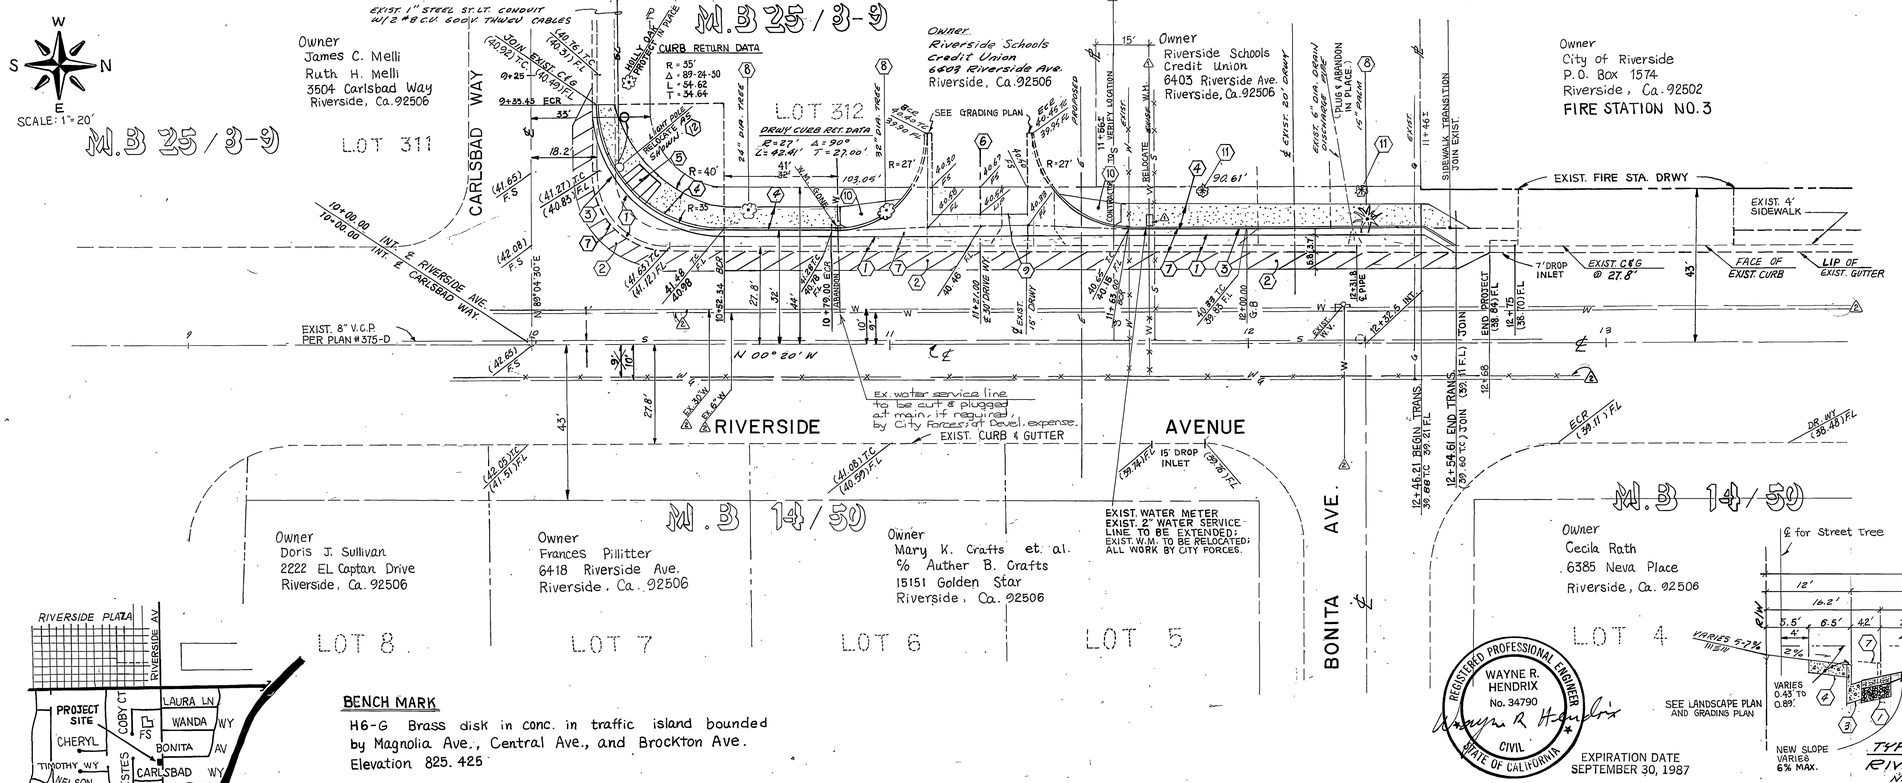

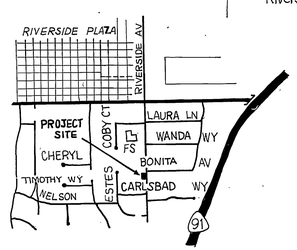

LOCATION MAP 4
NOT TO SCALE

BENCH MARK

H6-G Brass disk in conc. in traffic island bounded by Magnolia Ave., Central Ave., and Brockton Ave. Elevation 825.425

REGISTERED PROFESSIONAL ENGINEER
WAYNE R. HENDRIX
No. 34790
CIVIL
STATE OF CALIFORNIA
EXPIRATION DATE SEPTEMBER 30, 1987

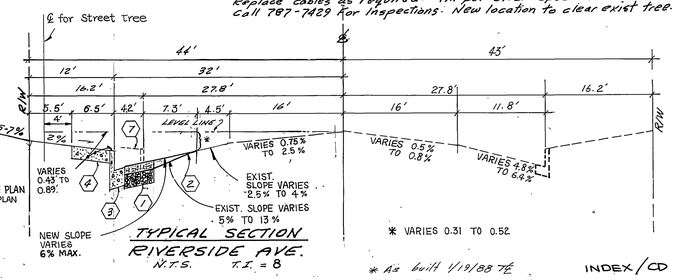

CONSTRUCTION NOTES

1. Construct 3½"A.C over 8½" A.B. (Or 4"A.C over 7½"A.B.) per S.R. 1312 ; R=48.
2. Construct variable A.C. cap. (feather & join)
3. Construct 6" curb and gutter (Type I) per City of Riverside Std.#200
4. Construct P.C.C. sidewalk per City of Riverside Std. # 325
5. Construct wheelchair ramp per City of Riverside Std. # 304.
6. Construct driveway approach per details hereon.
7. Remove existing curb, gutter, and sidewalk.
8. Remove existing tree.
9. Construct cross gutter per City of Riverside Std. # 220 (6' WIDE)
10. Construct wheelchair ramp per detail here on.
11. Plant Street tree to the specifications of the Park and Recreation Department.
12. Relocate St. Light to new foundation per Item #8-6 of U.G.S. 802. Replace cables as required. All per St. Lt. Spec. 119. Call 787-7429 for Inspections. New location to clear exist tree.

CITY OF RIVERSIDE WATER DEPARTMENT	CITY OF RIVERSIDE ELECTRIC DIVISION
APPROVED Carl Weingartner	APPROVED Wm Whittemore
DATE: 7/31/87	DATE: 4-2-87

WKHendrix Engineering
CIVIL ENGINEERING · LAND PLANNING
WATER / SANITARY ENGINEERING
255 N."D" STREET, SUITE 218 - SAN BERNARDINO, CA. 92401
PHONE (714) 381-5483
Wayne R. Hendrix 2-27-87
WAYNE R. HENDRIX R.C.E. 34790 DATE

	REVISIONS	DATE	CHECK
A	RELOCATED EXIST. 6" WATER MAIN	5-8-87	MC
A	ADDED EXIST. 30" WATER MAIN	4-2-87	MC
A	REVISED SEWER, WATER LATERAL LOCATION	5-7-87	MC
	ADD EXIST. WATER METER	5/8/87	MC

DESIGNED BY T.S DR. BY S.W CHECKED BY W.H

William D. Gardner 5-12-87

* As built 1/19/88 TE

INDEX/CD

STREET PLAN & PROFILE
RIVERSIDE AVENUE
WEST SIDE
FROM CARLSBAD WAY TO 255' N'LY OF CARLSBAD WAY

R-68-856

R-2876

20' = 4'

1 1

177-01.25