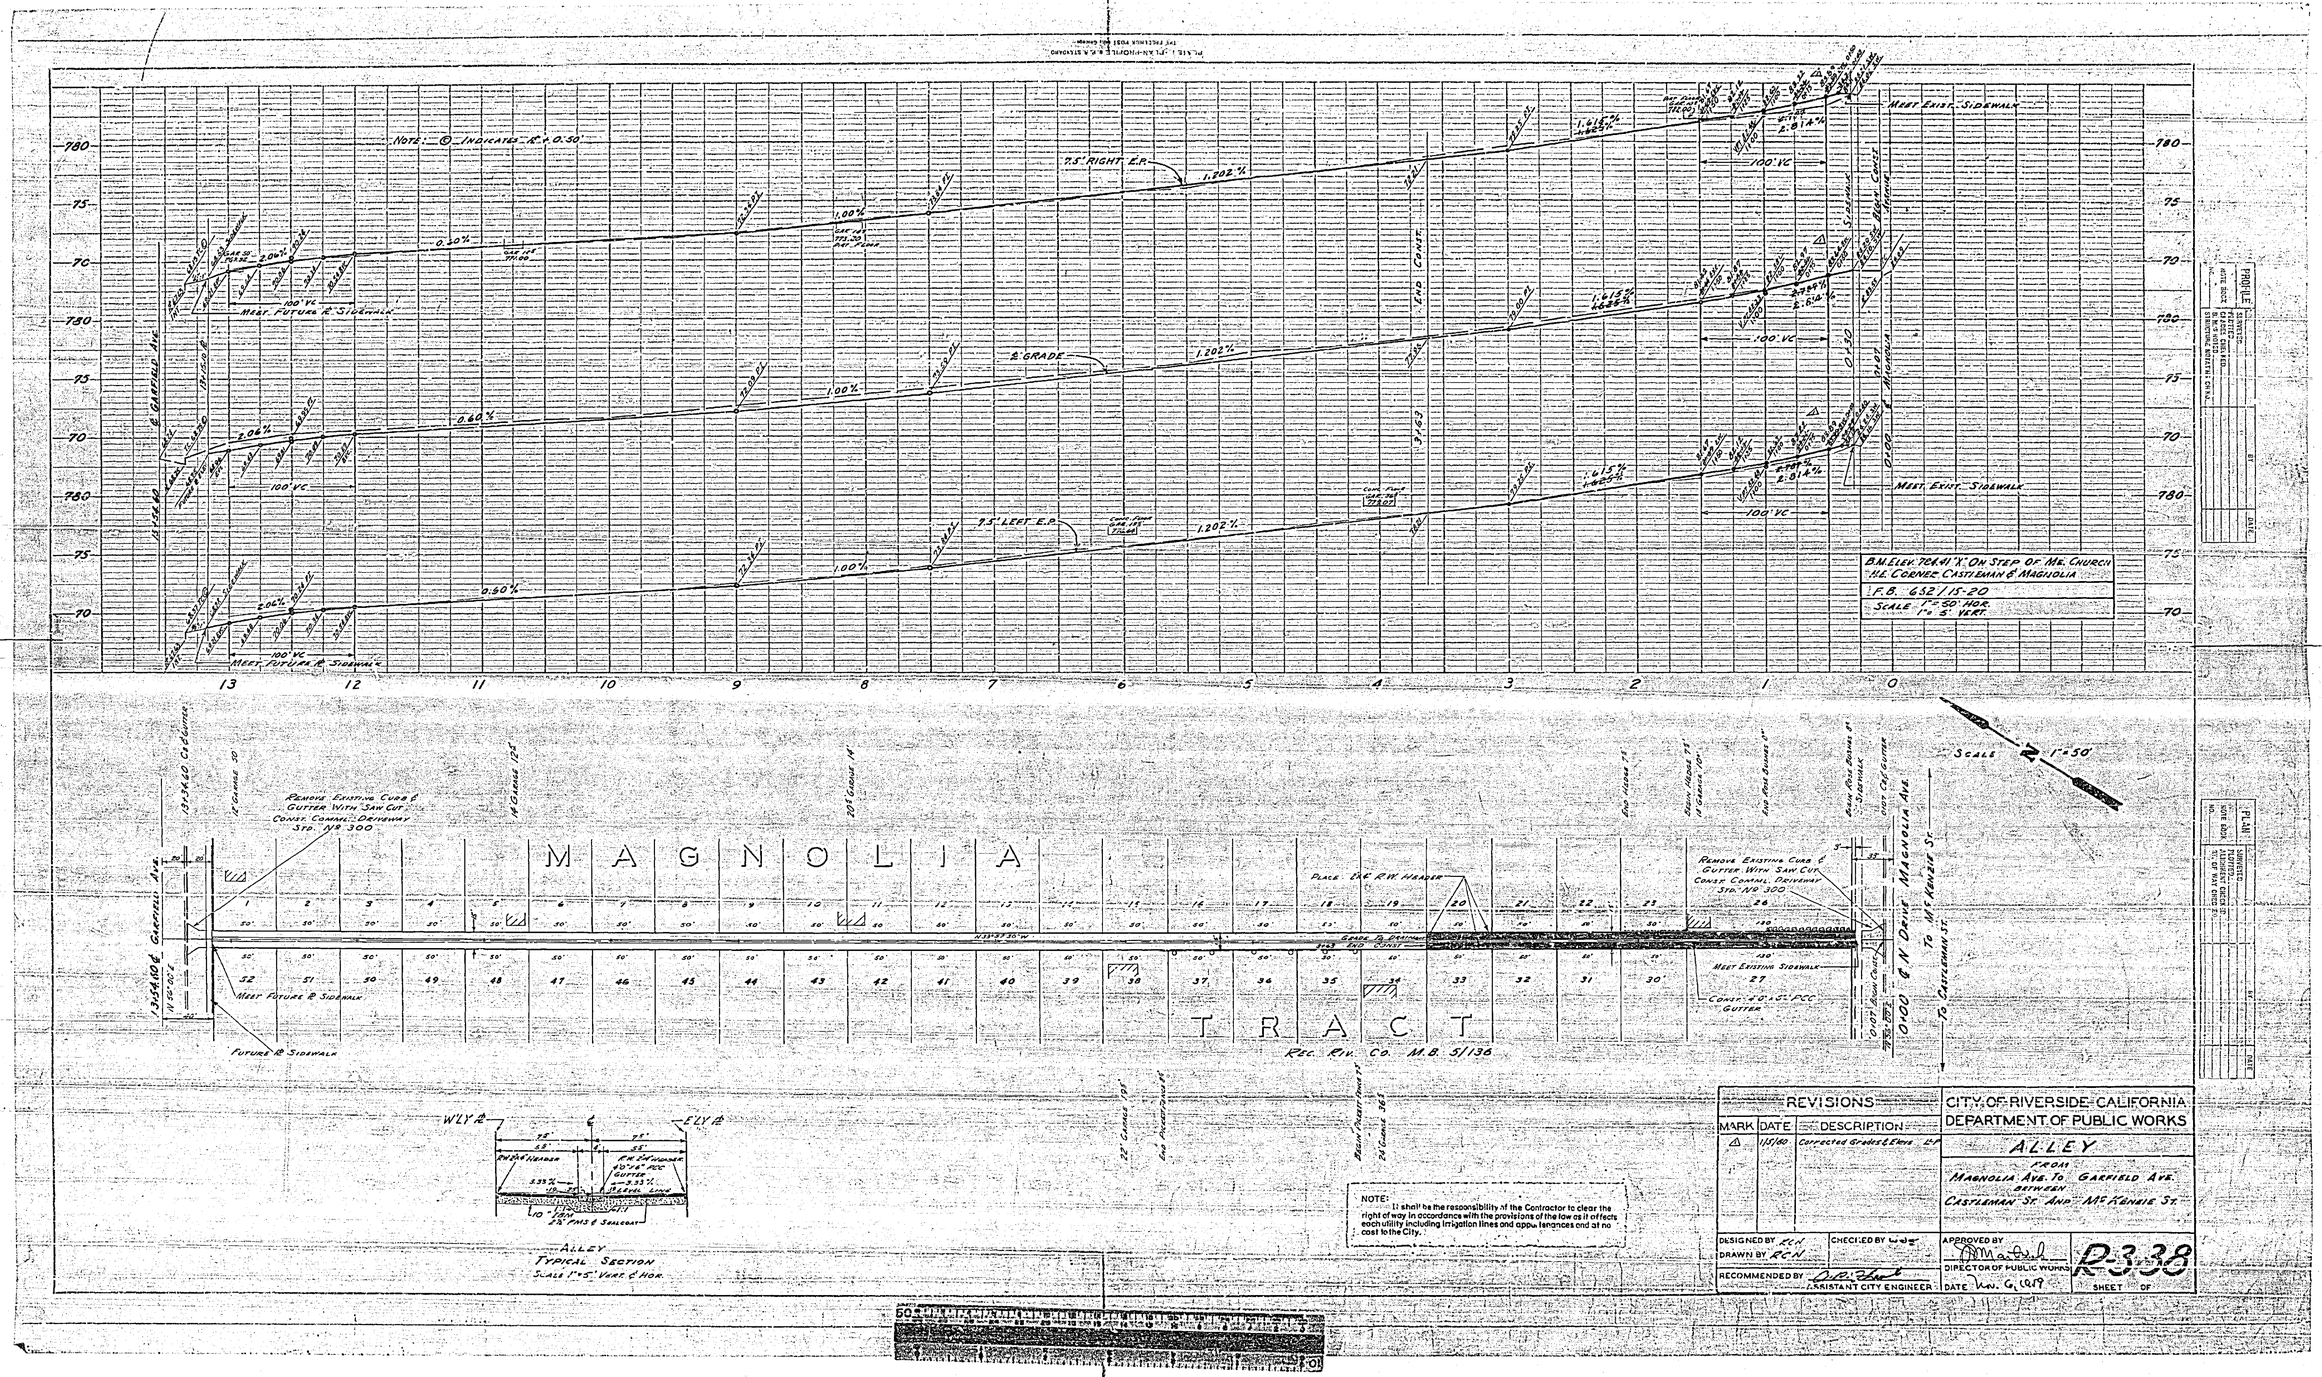

NOTE: It shall be the responsibility of the Contractor to clear the right of way in accordance with the provisions of the law as it affects each utility including irrigation lines and appurtenances and at no cost to the City.

REVISIONS		
MARK	DATE	DESCRIPTION
△	1/5/60	Corrected Grades & Elevs. L.P.

CITY OF RIVERSIDE, CALIFORNIA
DEPARTMENT OF PUBLIC WORKS

ALLEY
FROM
MAGNOLIA AVE. TO GARFIELD AVE.
BETWEEN
CASTLEMAN ST. AND MC KENZIE ST.

DESIGNED BY RCN
DRAWN BY RCN
CHECKED BY [illegible]
RECOMMENDED BY [illegible]
ASSISTANT CITY ENGINEER
APPROVED BY [illegible]
DIRECTOR OF PUBLIC WORKS
DATE Nov. 6, 1959

R-3-38
SHEET OF