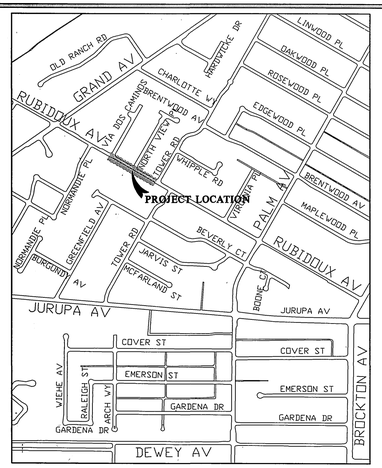

PROJECT LOCATION PLAN

0 KM. 0.5 KM. 1 KM 1.5 KM.

0' 500' 1000' 2000' 3000' 4000' 5000' 6000'

SCALE:1"=1000'

GENERAL CONSTRUCTION NOTES:

1. EXISTING UTILITIES SHOWN ON THE PLAN, ARE PLOTTED FROM UTILITY RECORDS. THE CONTRACTOR IS REQUIRED TO TAKE DUE PRECAUTIONARY MEASURES TO LOCATE AND PROTECT ALL UTILITIES WHETHER OR NOT SHOWN ON THIS PLAN.
2. ALL ELEVATIONS SHOWN ON THE PLANS SHALL BE STAKED IN THE FIELD.
3. ALL TREES SHALL BE PROTECTED IN PLACE.
4. CONSTRUCTION SHALL BE IN ACCORDANCE WITH THE CITY OF RIVERSIDE STANDARD DRAWINGS AND STANDARD SPECIFICATIONS FOR PUBLIC WORKS CONSTRUCTION, 1994 EDITION.
5. CONFLICTING UTILITIES IN THE CONSTRUCTION AREA SHALL BE RELOCATED OR ABANDONED.

CONSTRUCTION LEGEND:

- ⬢ NUMBERS ABOVE 100 IN A HEXAGON ON THE PLAN REFER TO THE RESPECTIVE STANDARD DRAWING AND SHALL BE CONSTRUCTED ACCORDINGLY, UNLESS MODIFICATIONS ARE NOTED ON THE PLAN. ANY NUMBER SHOWN BELOW THE STANDARD DRAWING NUMBER INDICATES THE SPECIFIC ALTERNATE TO BE CONSTRUCTED.
- S1 — 0.31' AC OVER 1.07' CLASS II AGGREGATE BASE.
- S2 — REMOVE EXISTING PAVING AND CONSTRUCT 0.31' AC OVER 1.07' CLASS II AGGREGATE BASE.
- 421 — A=60°, B=18", C'=4.2', D=48", E'=2.8', L=2.6', ELEV R=796.66, ELEV S=796.16
- LAT — INSTALL 18" RCP STORM DRAIN LATERAL PER DETAIL THIS SHEET.
- BM — INSTALL TWO WAY REFLECTIVE BLUE MARKER.
- ADJ — ADJUST TO GRADE BY CONTRACTOR.
- CFW — RELOCATE BY C/R PUBLIC UTILITIES DEPT., WATER DIVISION.

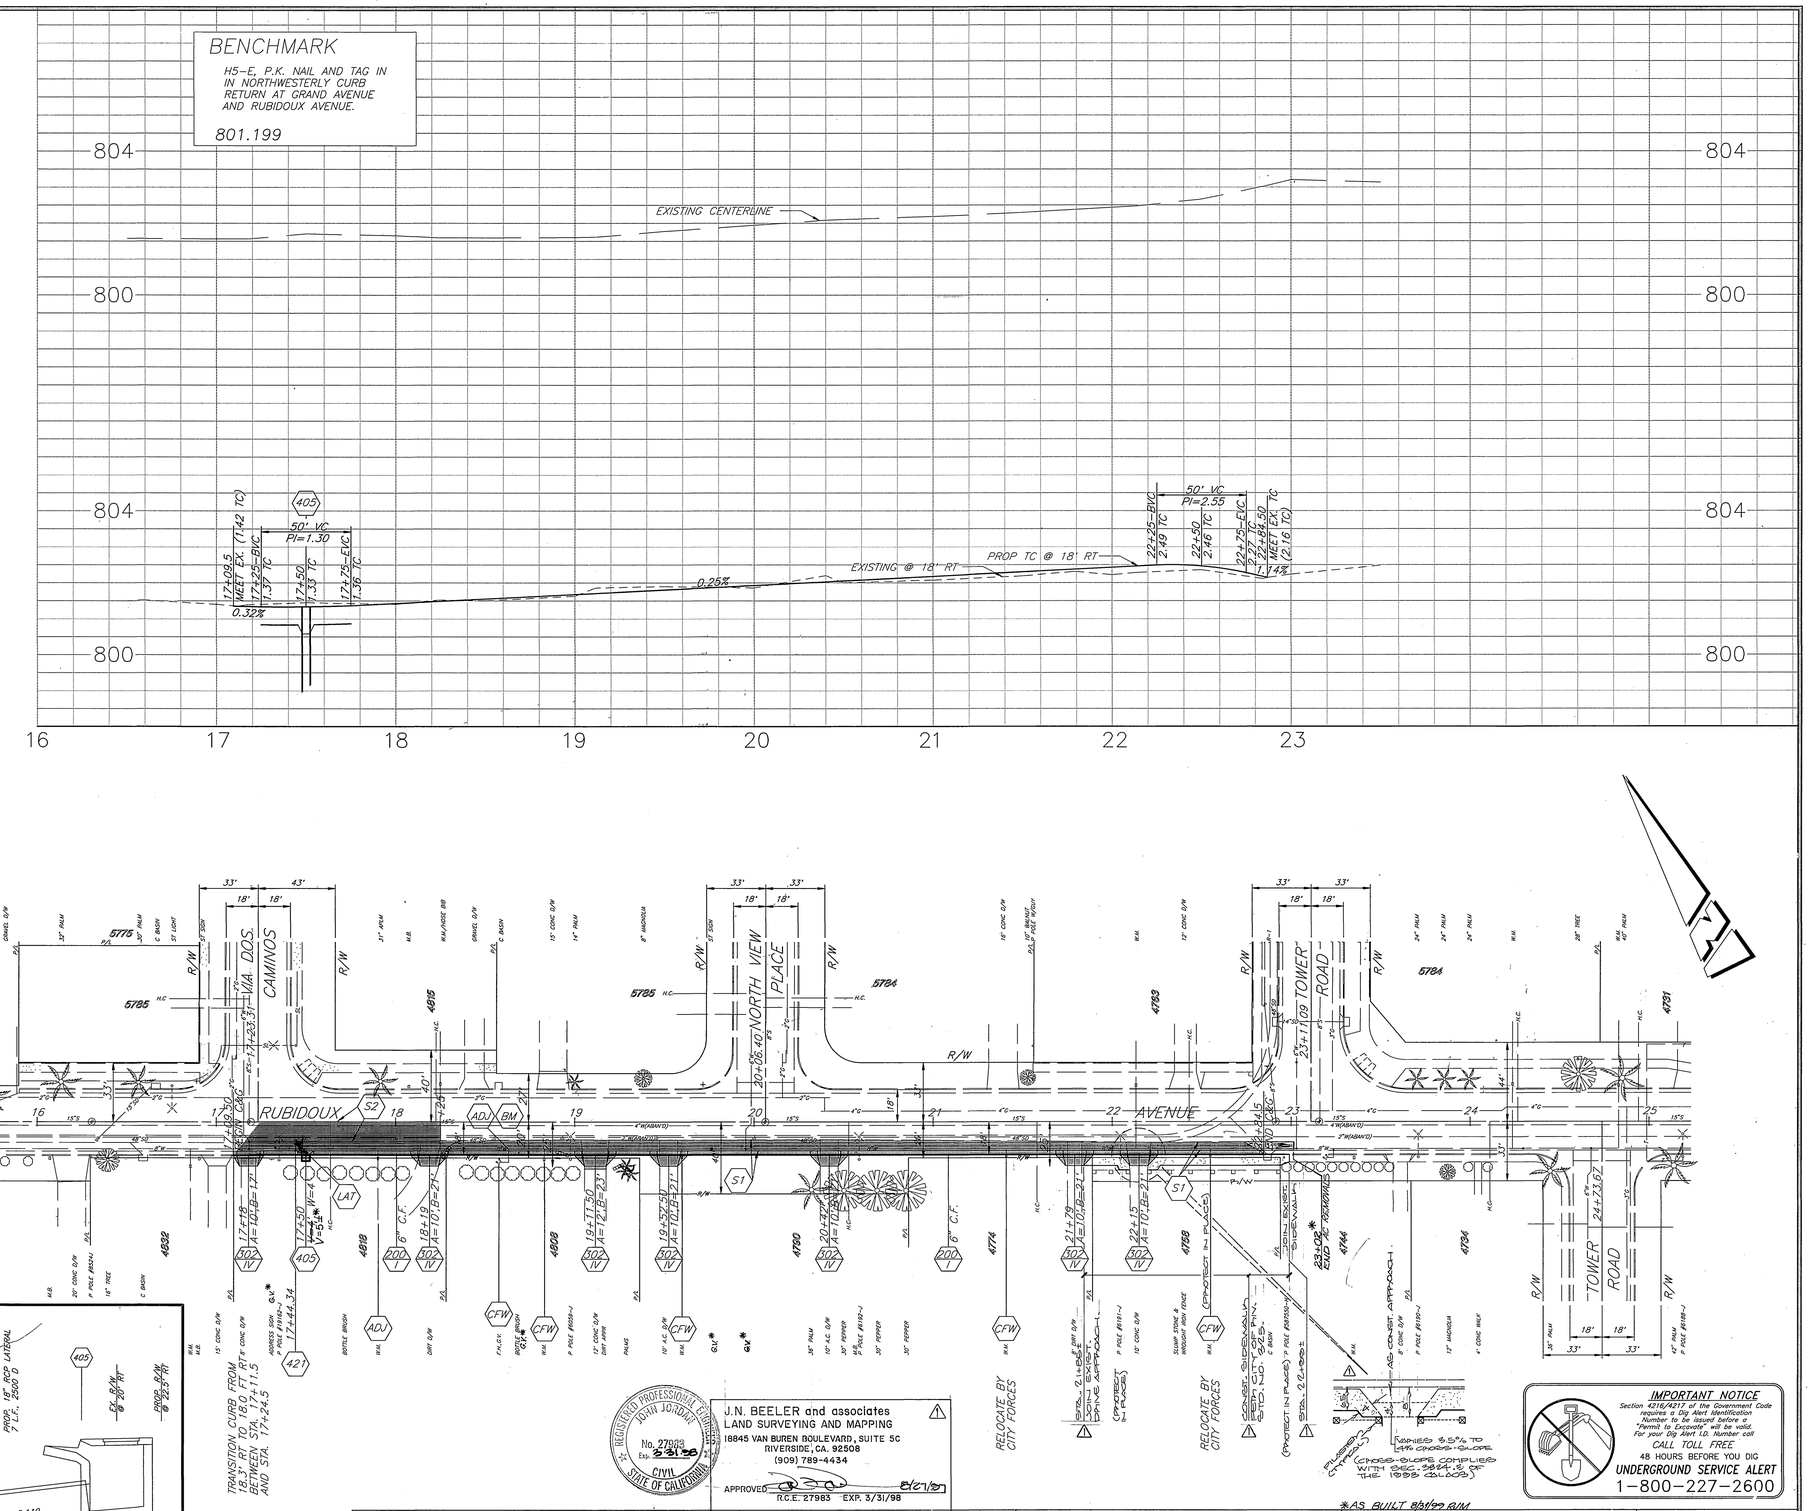

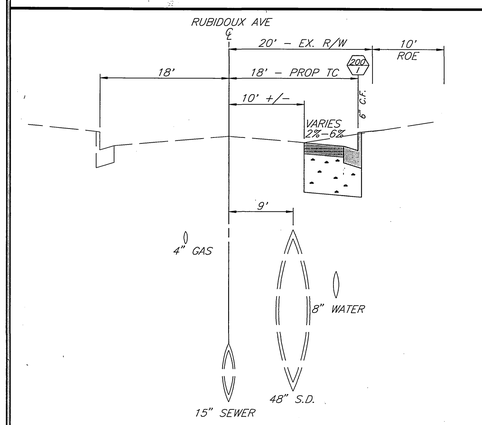

RUBIDOUX AVENUE TYPICAL SECTION

SCALE: HORIZ 1"=10'
VERT 1"=2'

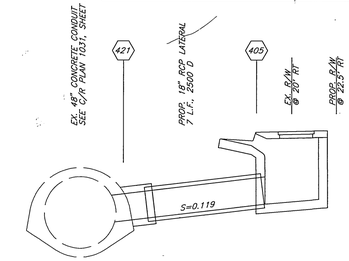

STORM DRAIN LATERAL

SCALE: 1"=4'

*AS BUILT 8/8/99 GW

REGISTERED PROFESSIONAL ENGINEER JOHN JORDAN No. 27983 Exp. 3-31-98 CIVIL STATE OF CALIFORNIA

J.N. BEELER and associates
LAND SURVEYING AND MAPPING
18845 VAN BUREN BOULEVARD, SUITE 5C
RIVERSIDE, CA. 92508
(909) 789-4434

APPROVED 8/27/98
R.C.E. 27983 EXP. 3/31/98

ENGINEER IN RESPONSIBLE CHARGE

LAUREN F. CALDWELL
R.C.E. No. 39441 expires 12/31/97
DATE 11/19/96

REGISTERED PROFESSIONAL ENGINEER LAUREN F. CALDWELL No. 39441 Exp. 12-31-97 CIVIL STATE OF CALIFORNIA

MARK	REVISIONS	APPR.	DATE
1	ADDED SIDEWALK & GUTTER TO SOUTH RUBIDOUX AVE. FOR LL-COR-97-0150	JWL	9/9/97

DESIGNED BY dpy DRAWN BY dmy CHECKED BY

CITY OF RIVERSIDE, CALIFORNIA
PUBLIC WORKS DEPARTMENT

APPROVED BY	BY	DATE
DEPUTY P.W. DIRECTOR		11/19/96
PRINCIPAL ENGINEER		11/19/96
PUBLIC UTILITIES--WATER		
STREET SERVICES		
SURVEYOR		11/19/96
TRAFFIC DIVISION		11/19/96

APPROVED BY
PUBLIC WORKS DIRECTOR
DATE 11/25/96

RUBIDOUX AVENUE CURB AND GUTTER WESTERLY OF TOWER

HORIZ. SCALE: 1" = 40' VERT. SCALE: 1" = 2'

ACCT. NO. 230-541500-440223-30287

R-3445

SHEET 1 OF 1

FILE NO.

IMPORTANT NOTICE
Section 4216/4217 of the Government Code requires a Dig Alert Identification Number to be issued before a "Permit to Excavate" will be valid. For your Dig Alert I.D. Number call
CALL TOLL FREE
48 HOURS BEFORE YOU DIG
UNDERGROUND SERVICE ALERT
1-800-227-2600

INDEXED 3-20-97 GH