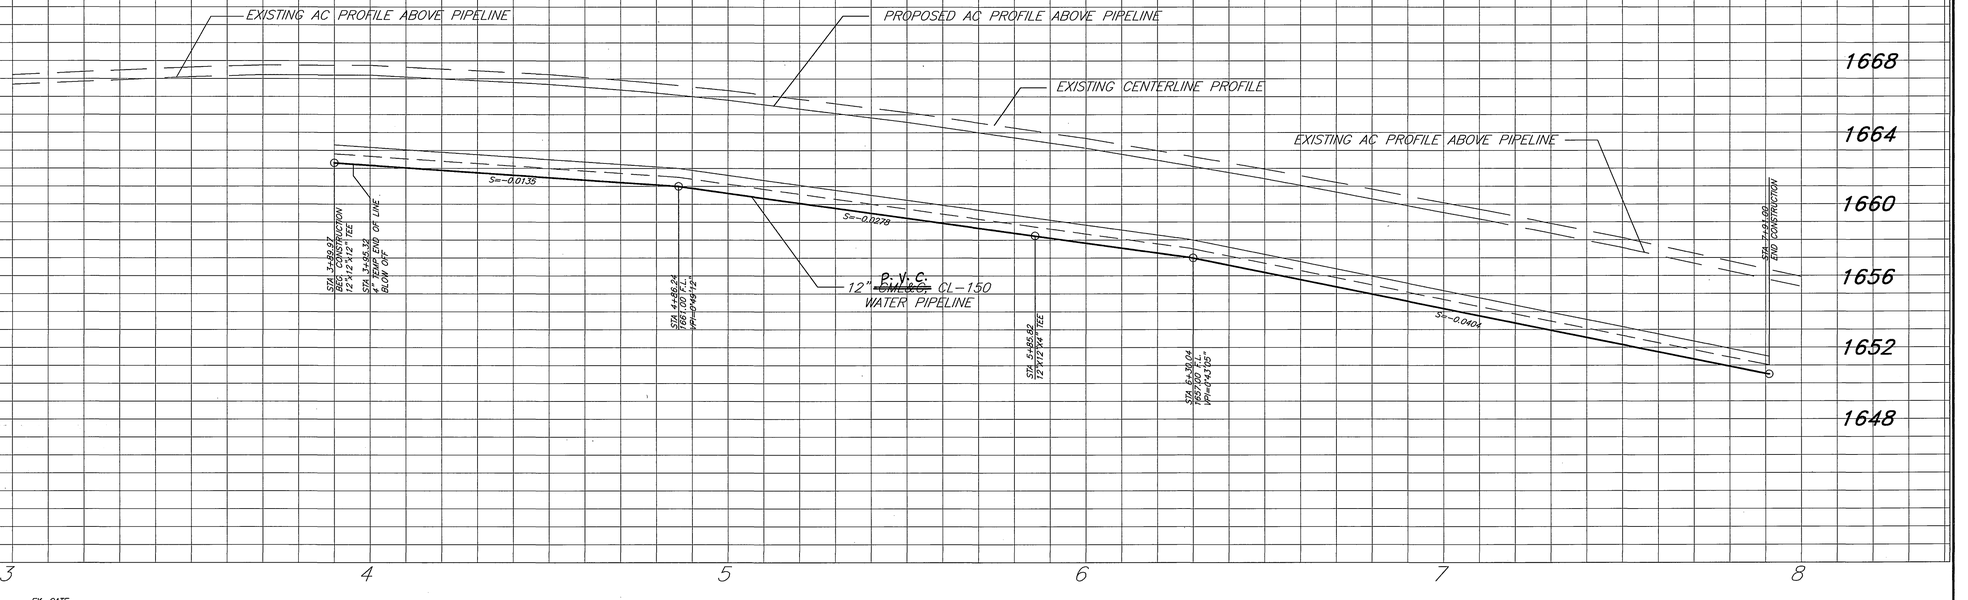

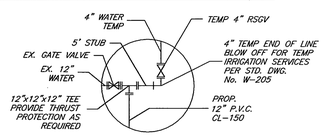

DETAIL No. 1
STEP A

STA. 3+89.97 & STA. 3+95.32
(NTS)

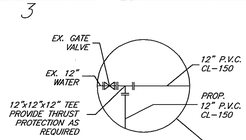

DETAIL No. 1
STEP B

STA. 3+89.97 & STA. 3+95.32
(NTS)

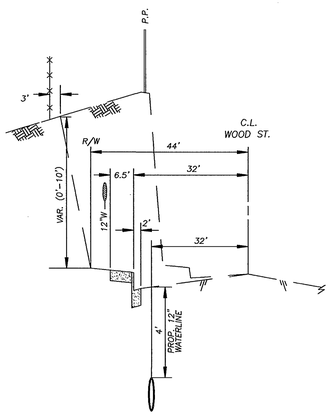

WOOD ROAD TYPICAL SECTION
(NTS)

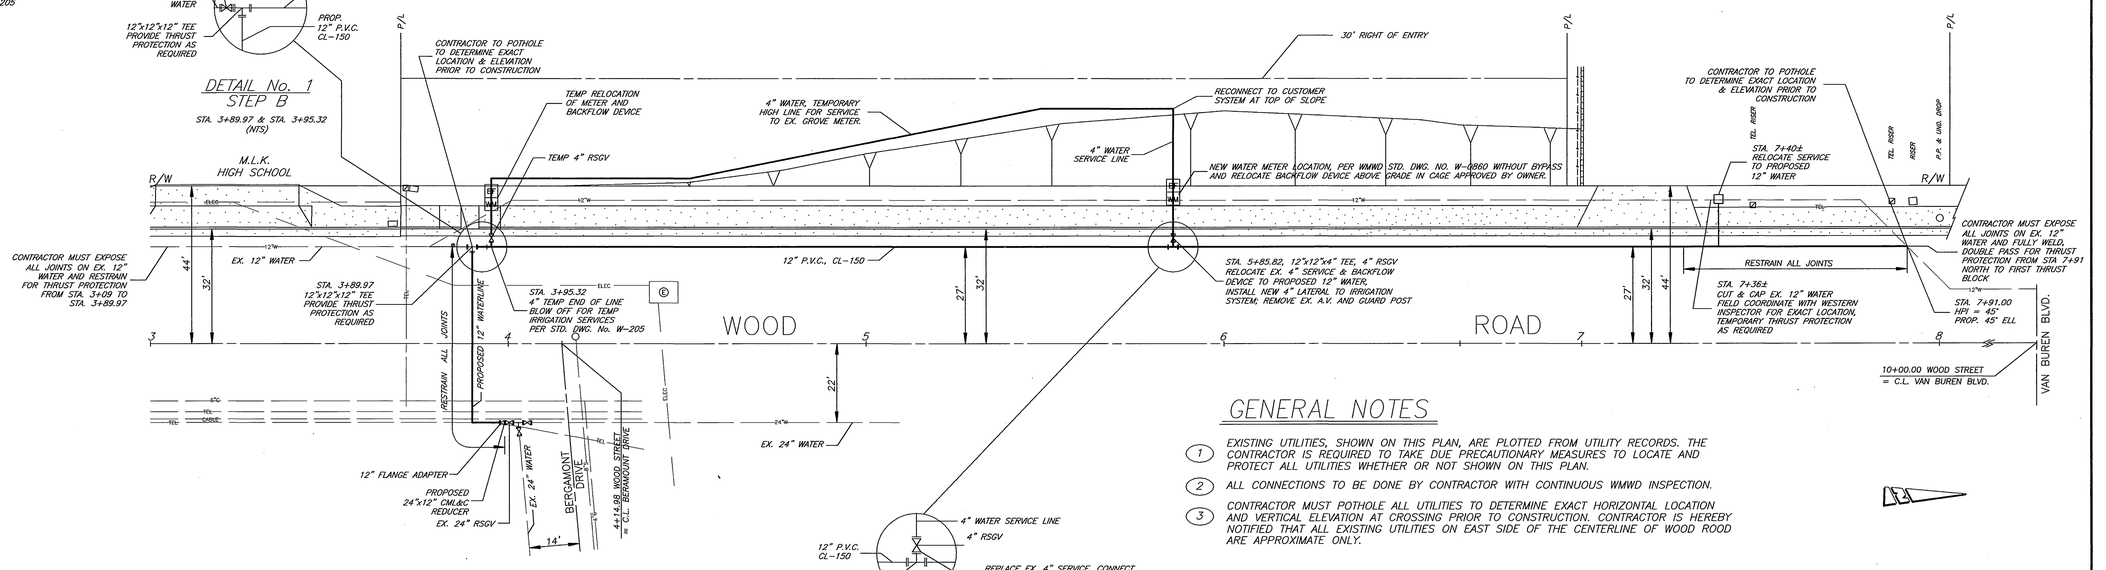

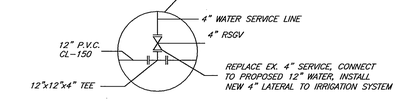

DETAIL No. 2
STA. 5+85.82
(NTS)

GENERAL NOTES

1. EXISTING UTILITIES, SHOWN ON THIS PLAN, ARE PLOTTED FROM UTILITY RECORDS. THE CONTRACTOR IS REQUIRED TO TAKE DUE PRECAUTIONARY MEASURES TO LOCATE AND PROTECT ALL UTILITIES WHETHER OR NOT SHOWN ON THIS PLAN.
2. ALL CONNECTIONS TO BE DONE BY CONTRACTOR WITH CONTINUOUS WMWD INSPECTION.
3. CONTRACTOR MUST POTHOLE ALL UTILITIES TO DETERMINE EXACT HORIZONTAL LOCATION AND VERTICAL ELEVATION AT CROSSING PRIOR TO CONSTRUCTION. CONTRACTOR IS HEREBY NOTIFIED THAT ALL EXISTING UTILITIES ON EAST SIDE OF THE CENTERLINE OF WOOD ROOD ARE APPROXIMATE ONLY.

APPROVED BY CITY OF RIVERSIDE

Michael Katusian
MICHAEL KATUSIAN R.C.E. 36686
DATE: 11/2/04

APPROVED BY WESTERN MUNICIPAL WATER DISTRICT FOR CONSTRUCTION

Nov. 1, 2004
CIVIL ENGINEER, R.C.E. 46212 DATE

VOID AFTER ONE YEAR FROM THIS DATE

IMPORTANT NOTICE
Section 4216/4217 of the Government Code requires a Dig Alert Identification Number to be issued before a "Permit to Excavate" will be valid. For your Dig Alert I.D. Number call
CALL TOLL FREE
48 HOURS BEFORE YOU DIG
UNDERGROUND SERVICE ALERT
1-800-227-2600

BENCHMARK: E8-G3

PK. NAIL & CITY ENGINEER TAG IN THE TOP OF THE SIDEWALK OVER THE EASTERLY WALL OF A CATCH BASIN ALONG THE SOUTHERLY CURB OF VAN BUREN BLVD. AND 700 FEET EASTERLY OF WOOD ROAD.

ELEV. - 1642.465

SEAL - ENGINEER
REGISTERED PROFESSIONAL ENGINEER BRUCE A. DAVIS No. C47200 Exp. 12-31-05 CIVIL STATE OF CALIFORNIA

ALBERT A. WEBB ASSOCIATES
ENGINEERING CONSULTANTS
CIVIL ENGINEERS
3788 McCRAY ST.
RIVERSIDE CA. 92506
PH. (909) 686-1070
FAX (909) 788-1256

PROJECT MANAGER — C47200 R.E. NO. — 7/6/04 DATE

MARK	REVISIONS	APPR.	DATE

DESIGNED BY BAS DRAWN BY EP CHECKED BY FYL

CITY OF RIVERSIDE, CALIFORNIA
PUBLIC WORKS DEPARTMENT

APPROVED BY	BY	DATE
PRINCIPAL ENGINEER		
CONSTRUCTION ADMIN.		
SURVEYOR		
STREET SERVICES		
TRAFFIC ENGINEER		
PARK & REC. DEP.		

APPROVED BY CITY ENGINEER
DATE 4/5/05

WOOD ROAD WIDENING
(FROM BERGAMONT DR. TO VAN BUREN BLVD.)

HORIZ. SCALE: 1" = 20' VERT. SCALE: 1" = 2'

ACCT. NO.: 9579327152-44022XX

R-3788W

SHEET 1 OF 1

FILE: COMMON/COMPLETE/R3788W

INDEXED 6-24-05 FH