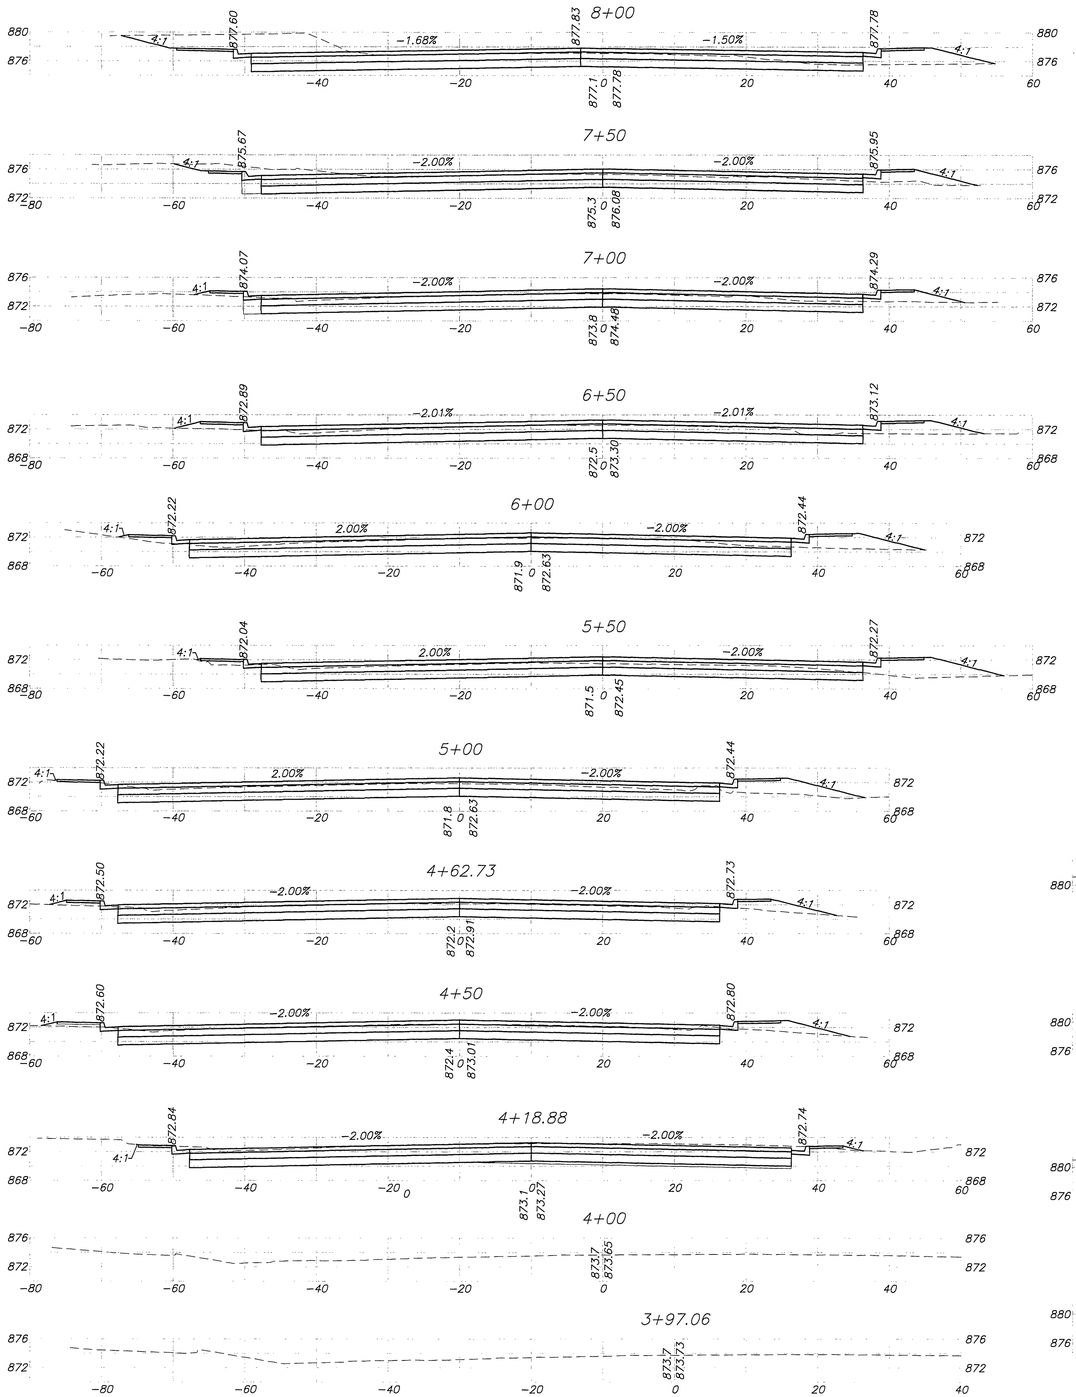

AS BUILT
DATE 9-14-10

NOTES:

1. STATIONING IS BASED ON COLUMBIA AVENUE RECORD ℄ ("R" LINE).

DMJM HARRIS | AECOM
800 NORTH HAVEN, SUITE 410
ONTARIO, CA 91764
T (909)291-8150 F (909)291-8166

REGISTERED PROFESSIONAL ENGINEER
CHRIS H. BECHA
No. C41824
Exp. 3-31-10
CIVIL
STATE OF CALIFORNIA

MARK	REVISIONS	APPR.	DATE

DESIGNED BY S.A. DRAWN BY S.A. CHECKED BY C.B.

COLUMBIA AVENUE OVERPASS AT BNSF RAILROAD

CROSS SECTIONS – COLUMBIA AVENUE

SCALE: 1"=10'

ACCT. NO. –

R-4036
CX-01

SHEET 92 OF 103

FILE INFO:P:\60004223 Columbia Grade Sep\CAD\Civil\Sheet\CX-01.dwg PLOTTED: Sep 29, 2008 2:13pm BY:emporos PLOT SCALE: 1=1
XREFS Xdef: xpro-cdu MODIFIED: Jul 14, 2008 4:53pm

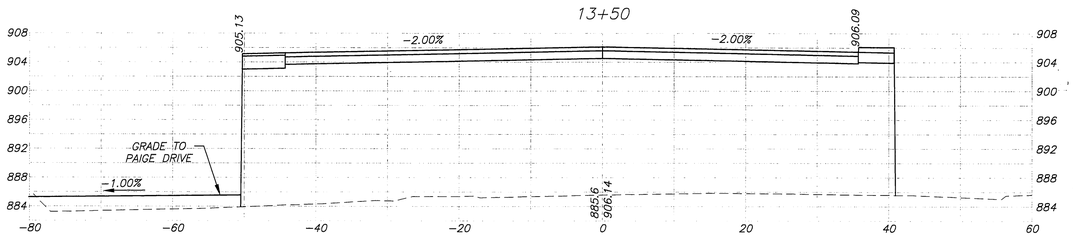

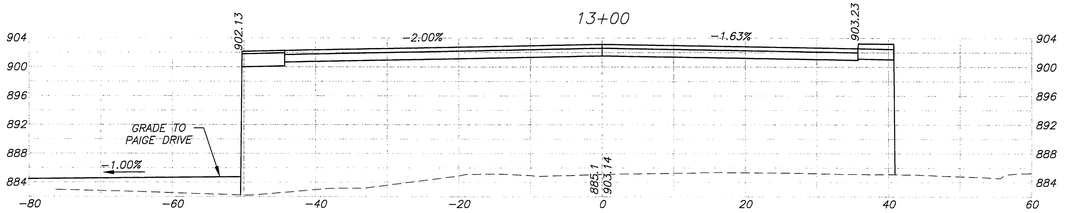

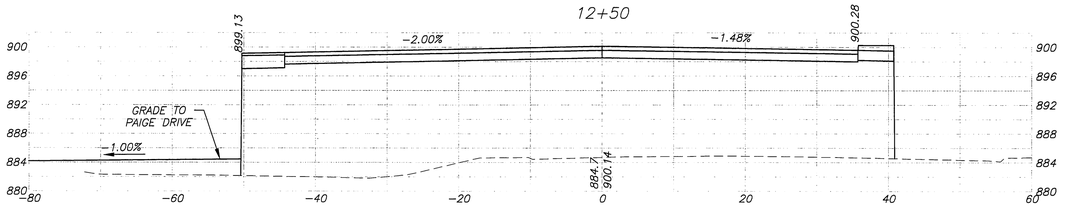

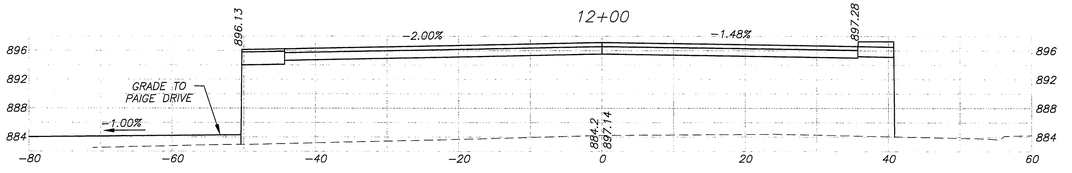

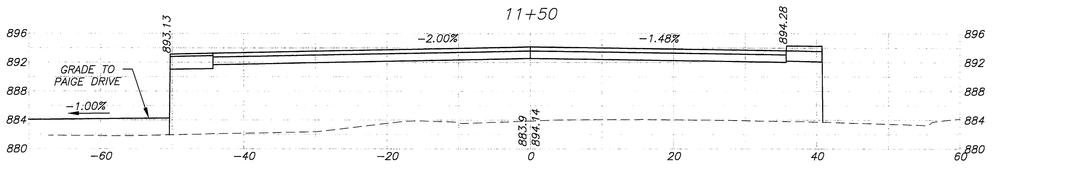

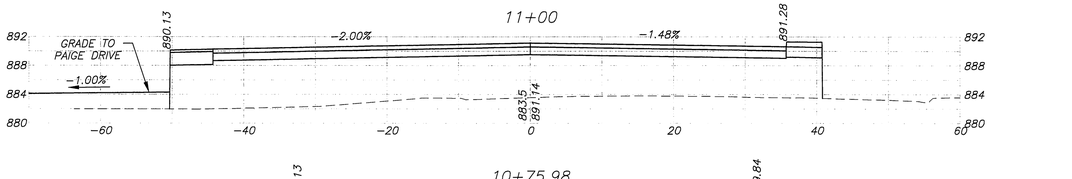

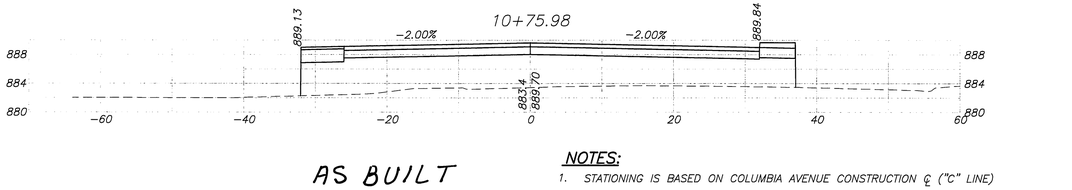

AS BUILT

DATE 9-14-10

NOTES:

1. STATIONING IS BASED ON COLUMBIA AVENUE CONSTRUCTION ℄ ("C" LINE)

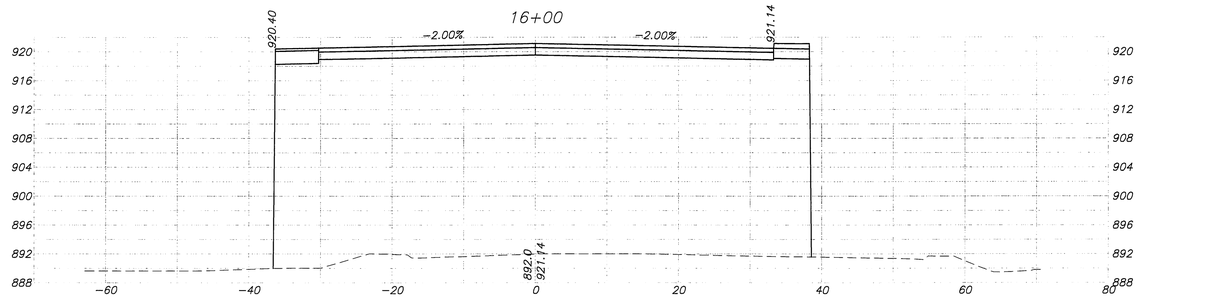

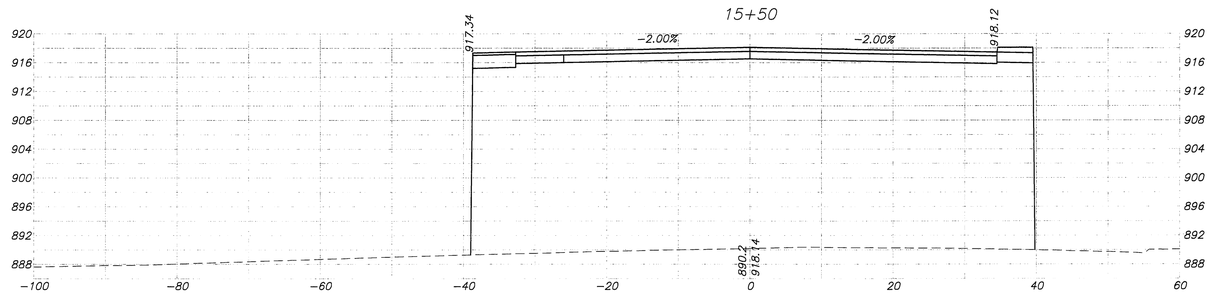

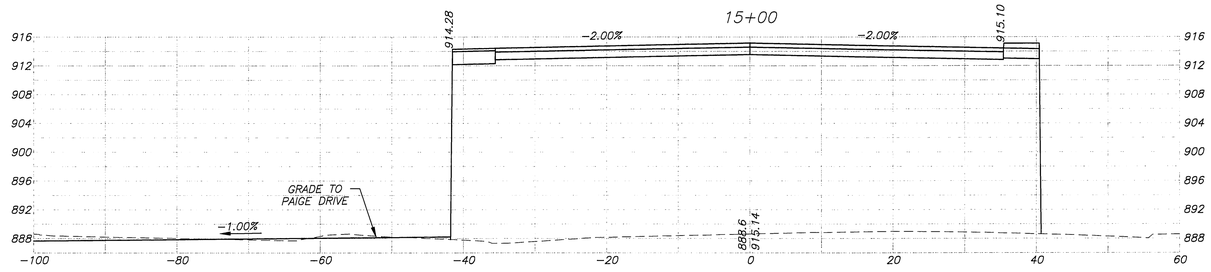

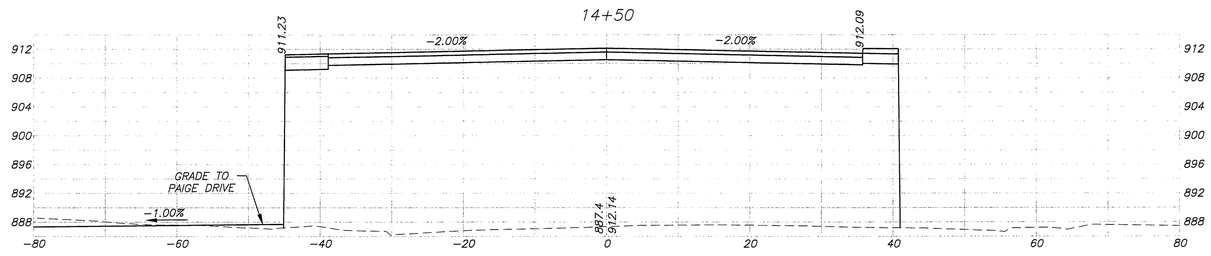

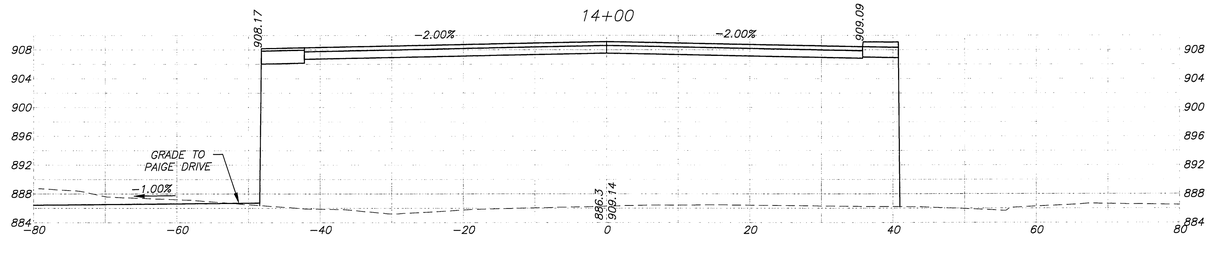

DMJM HARRIS | AECOM
800 NORTH HAVEN, SUITE 410
ONTARIO, CA 91764
T (909)291-8150 F (909)291-8166

REGISTERED PROFESSIONAL ENGINEER
CHRIS H. BREWER
No. C41824
Exp. 3-31-10
CIVIL
STATE OF CALIFORNIA

MARK	REVISIONS	APPR.	DATE

DESIGNED BY S.A. DRAWN BY S.A. CHECKED BY C.B.

COLUMBIA AVENUE OVERPASS AT BNSF RAILROAD

CROSS SECTIONS – COLUMBIA AVENUE

SCALE: 1"=10'

ACCT. NO. -

R-4036

CX-02

SHEET 93 OF 103

FILE INFO:P:\60004223 Columbia Grade Sep\CADD\Civil\Sheet\CX-02.dwg PLOTTED: Sep 29, 2008 2:13pm BY:amparos PLOT SCALE: 1=1
XREFS: xbdr, xpro-calu MODIFIED: Jul 14, 2008 1:56pm

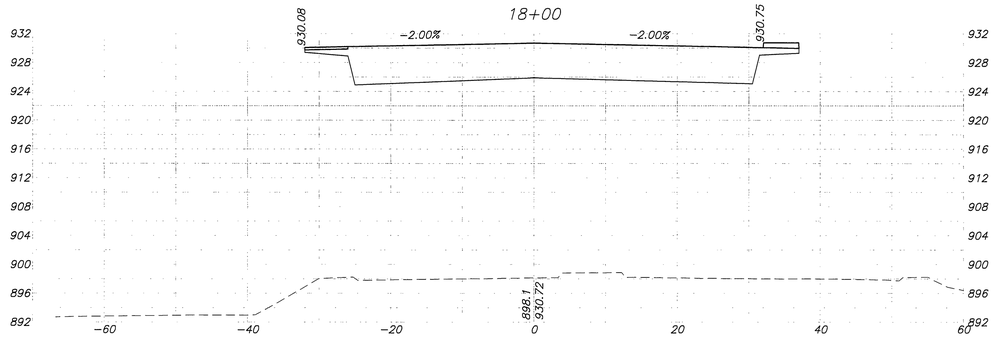

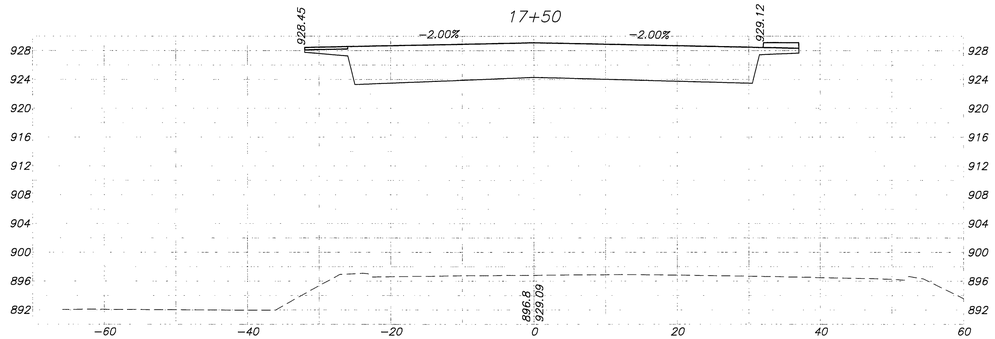

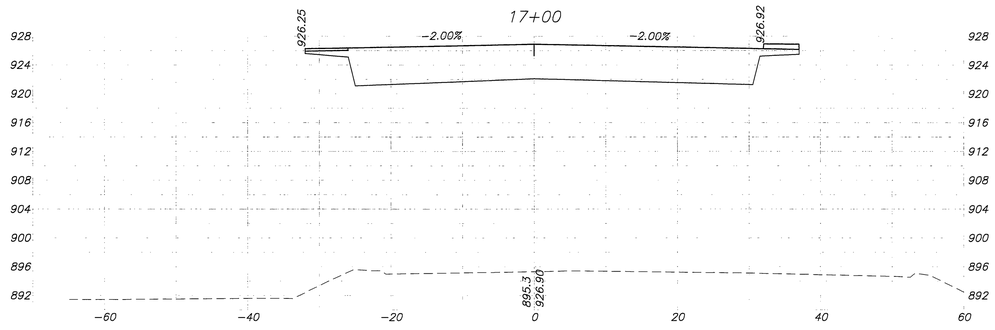

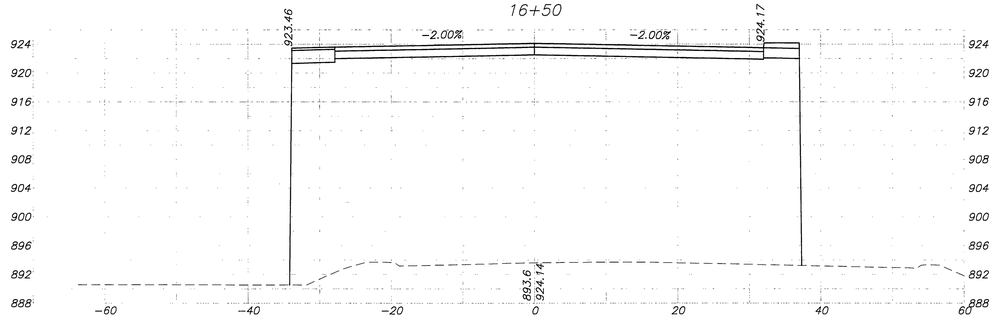

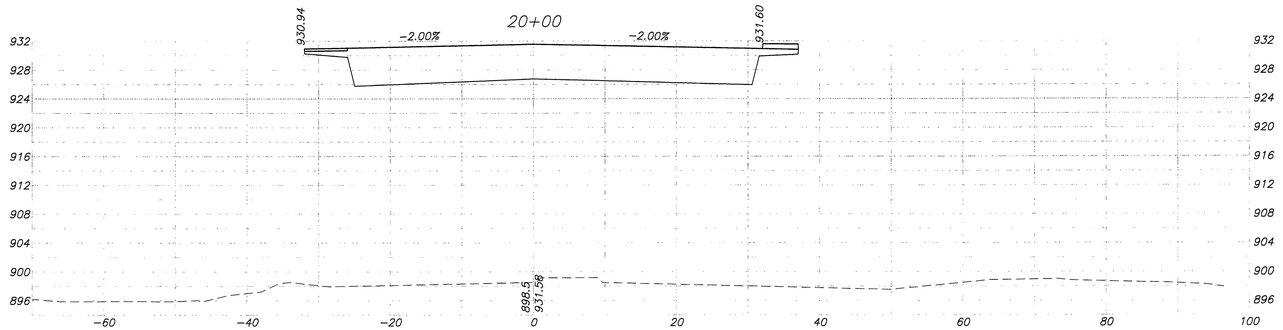

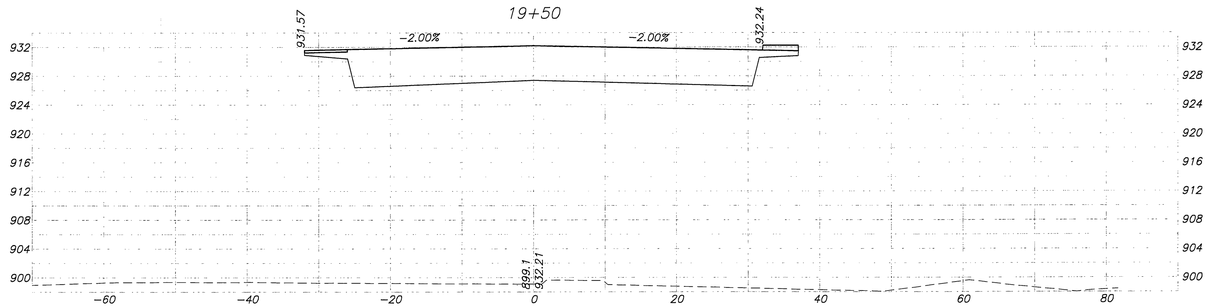

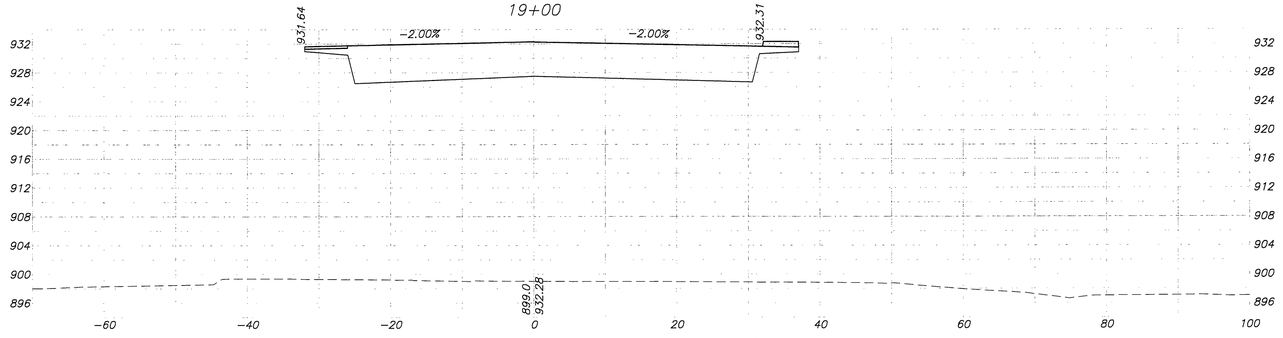

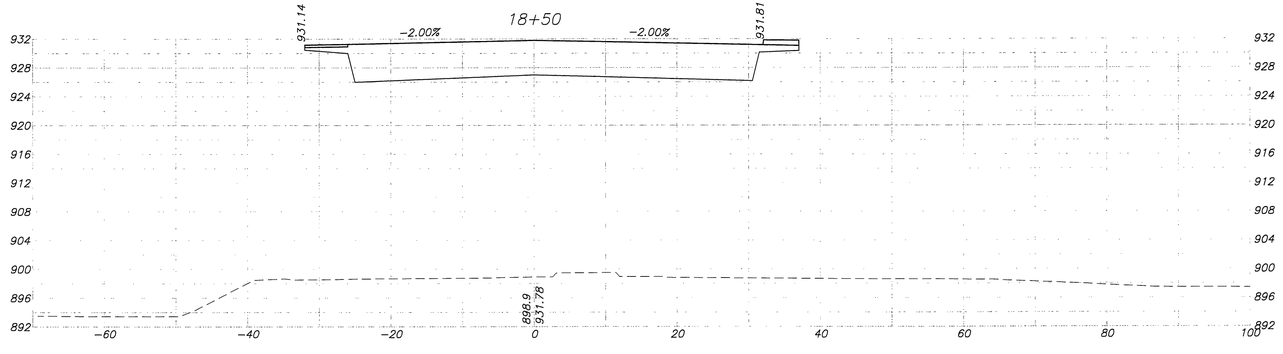

AS BUILT
DATE 9-14-10

NOTES:

1. STATIONING IS BASED ON COLUMBIA AVENUE CONSTRUCTION ℄ ("C" LINE)

DMJM HARRIS | AECOM
800 NORTH HAVEN, SUITE 410
ONTARIO, CA 91764
T (909)291-8150 F (909)291-8166

REGISTERED PROFESSIONAL ENGINEER
CHRIS H. BRADY
No. C 41824
Exp. 3-31-10
CIVIL
STATE OF CALIFORNIA

MARK	REVISIONS	APPR.	DATE

DESIGNED BY S.A. DRAWN BY S.A. CHECKED BY C.B.

COLUMBIA AVENUE OVERPASS AT BNSF RAILROAD

CROSS SECTIONS – COLUMBIA AVENUE

SCALE: 1"=10'

ACCT. NO. –

R-4036
CX-03

SHEET 94 OF 103

FILE: INFO:P:\60004223 Columbia Grade Sep\CADD\Civil\Sheet\Cx-03.dwg PLOTTED: Sep 29, 2008 2:13pm BY: amporas PLOT SCALE: 1=1
XREFS: xdir: xref-cdu MODIFIED: Jul 14, 2008 3:36pm

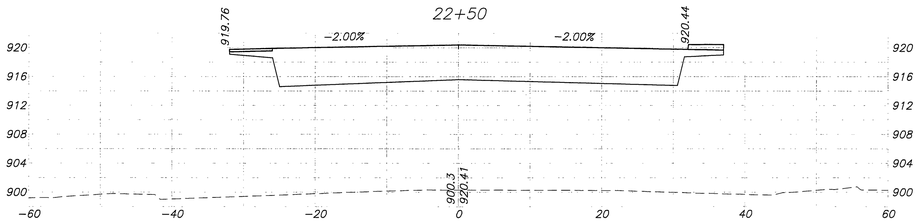

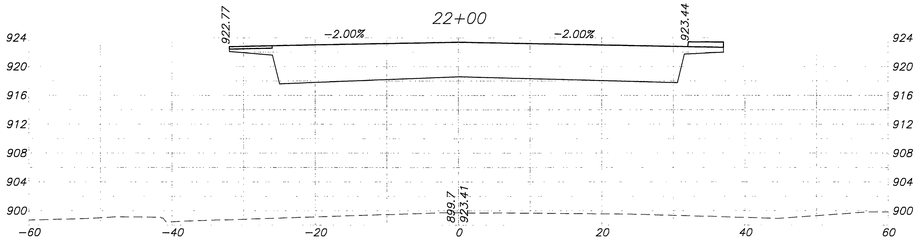

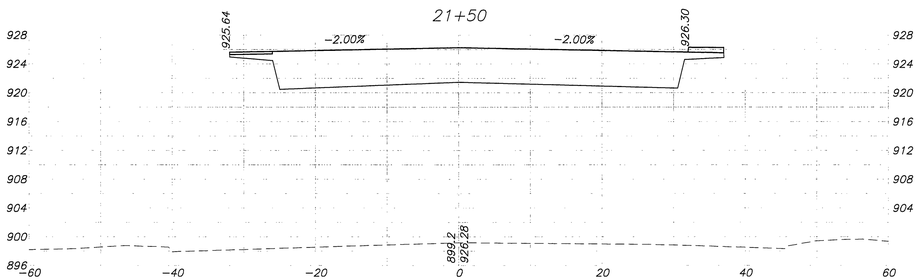

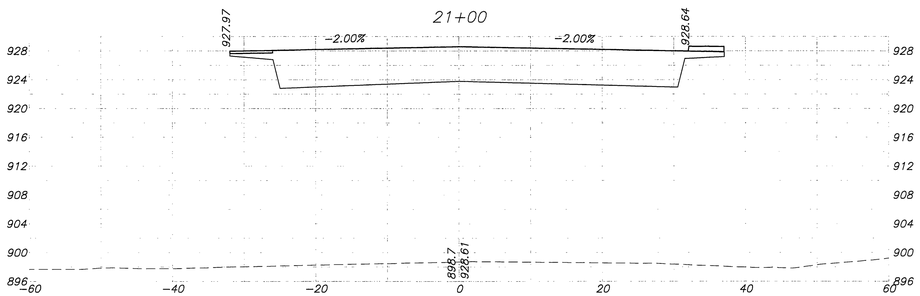

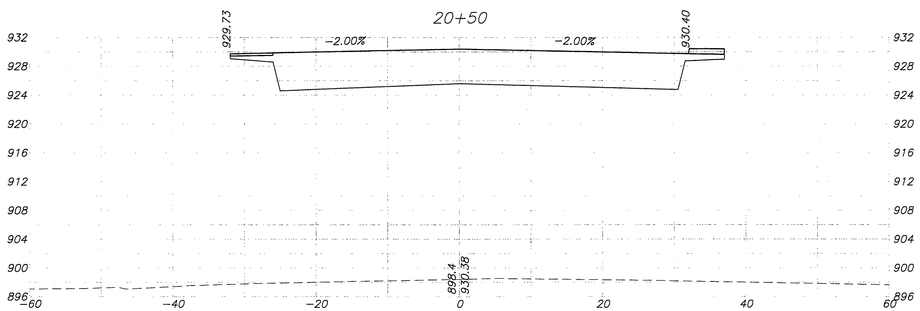

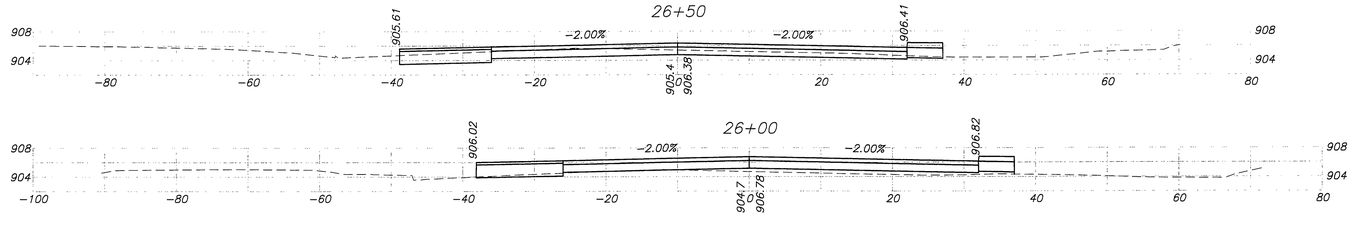

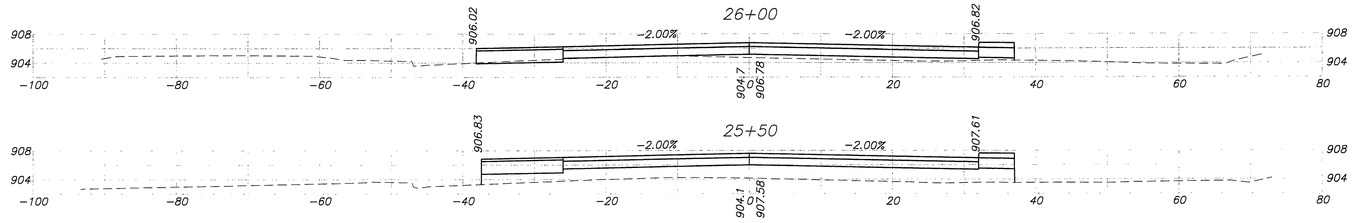

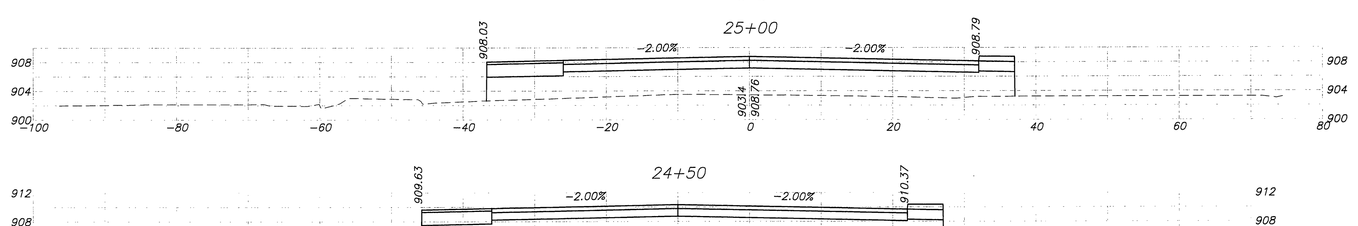

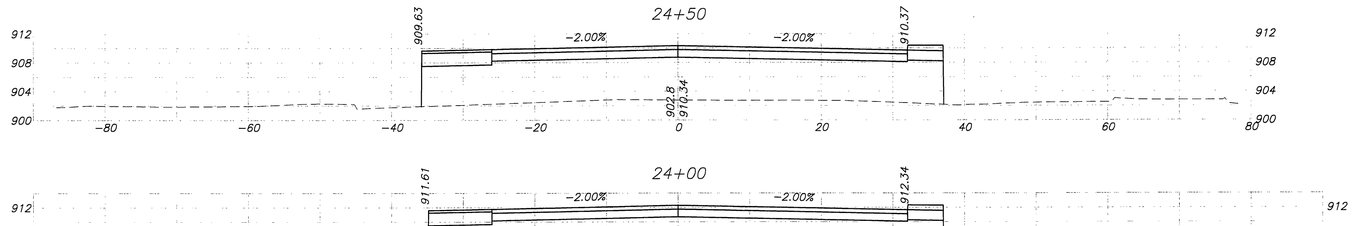

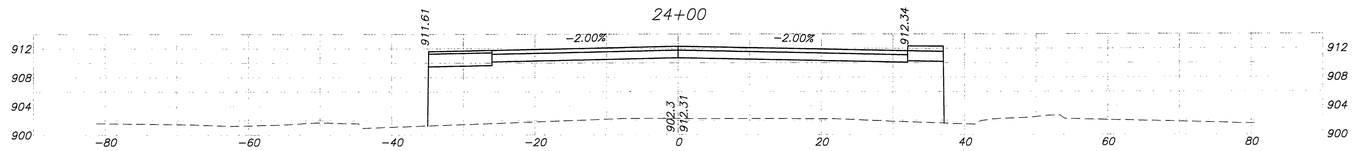

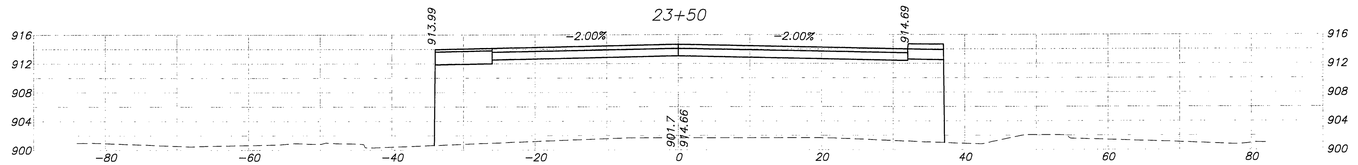

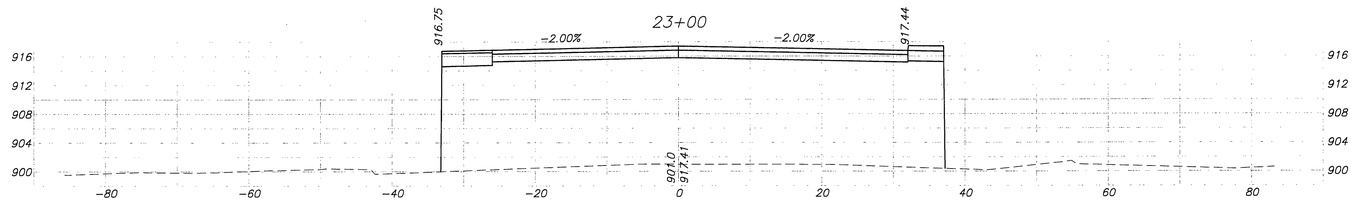

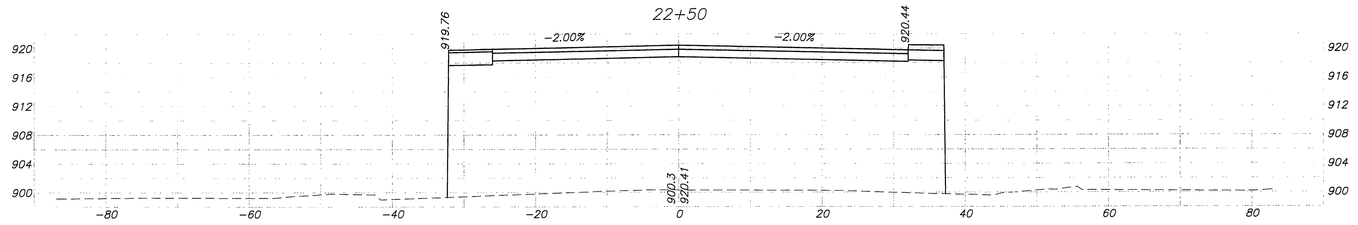

AS BUILT
DATE 9-14-10

NOTES:

1. STATIONING IS BASED ON COLUMBIA AVENUE CONSTRUCTION ℄ ("C" LINE)

DMJM HARRIS | AECOM
800 NORTH HAVEN, SUITE 410
ONTARIO, CA 91764
T (909)291-8150 F (909)291-8166

REGISTERED PROFESSIONAL ENGINEER
CHRIS H. BREWER
No. C 41824
Exp. 3-31-10
CIVIL
STATE OF CALIFORNIA

MARK	REVISIONS	APPR.	DATE

DESIGNED BY S.A. DRAWN BY S.A. CHECKED BY C.B.

COLUMBIA AVENUE OVERPASS AT BNSF RAILROAD

CROSS SECTIONS – COLUMBIA AVENUE

SCALE: 1"=10'

ACCT. NO. -

R-4036
CX-04
SHEET 95 OF 103

FILE INFO:P:\60004223 Columbia Grade Sep\CADD\Civil\Sheet\CX-04.dwg PLOTTED: Sep 29, 2008 2:14pm BY: amporos PLOT SCALE: 1=1
XREFS: xbd=; vpro-cdu MODIFIED: Jul 14, 2008 4:47pm

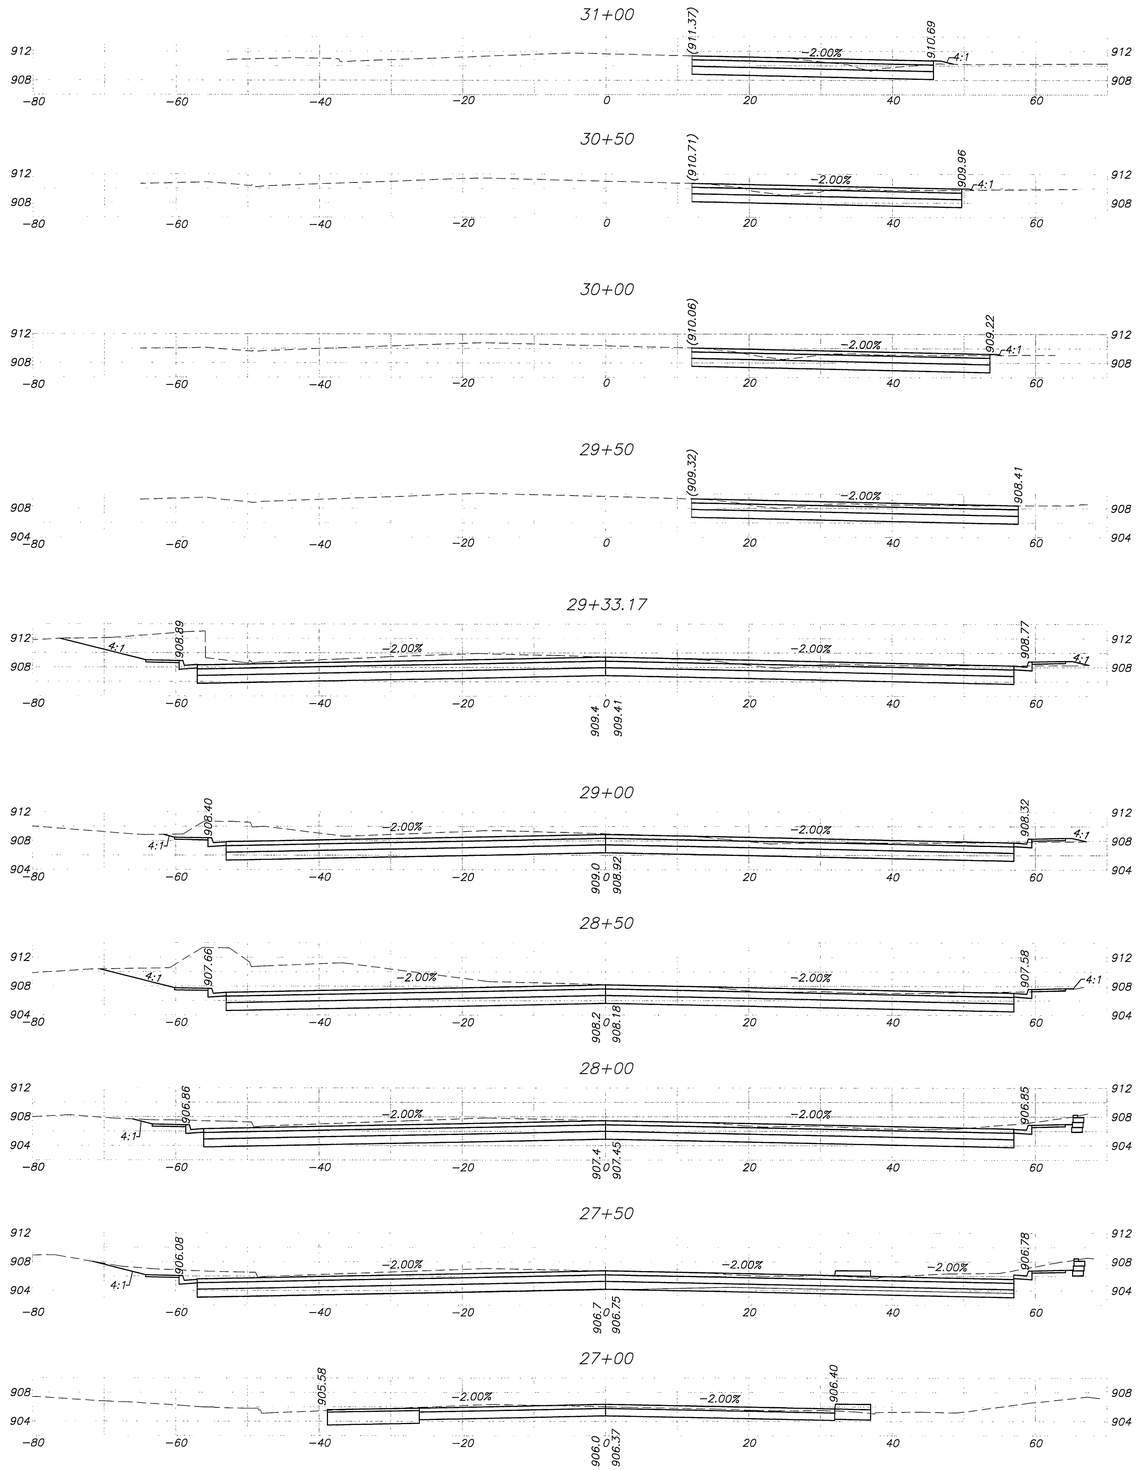

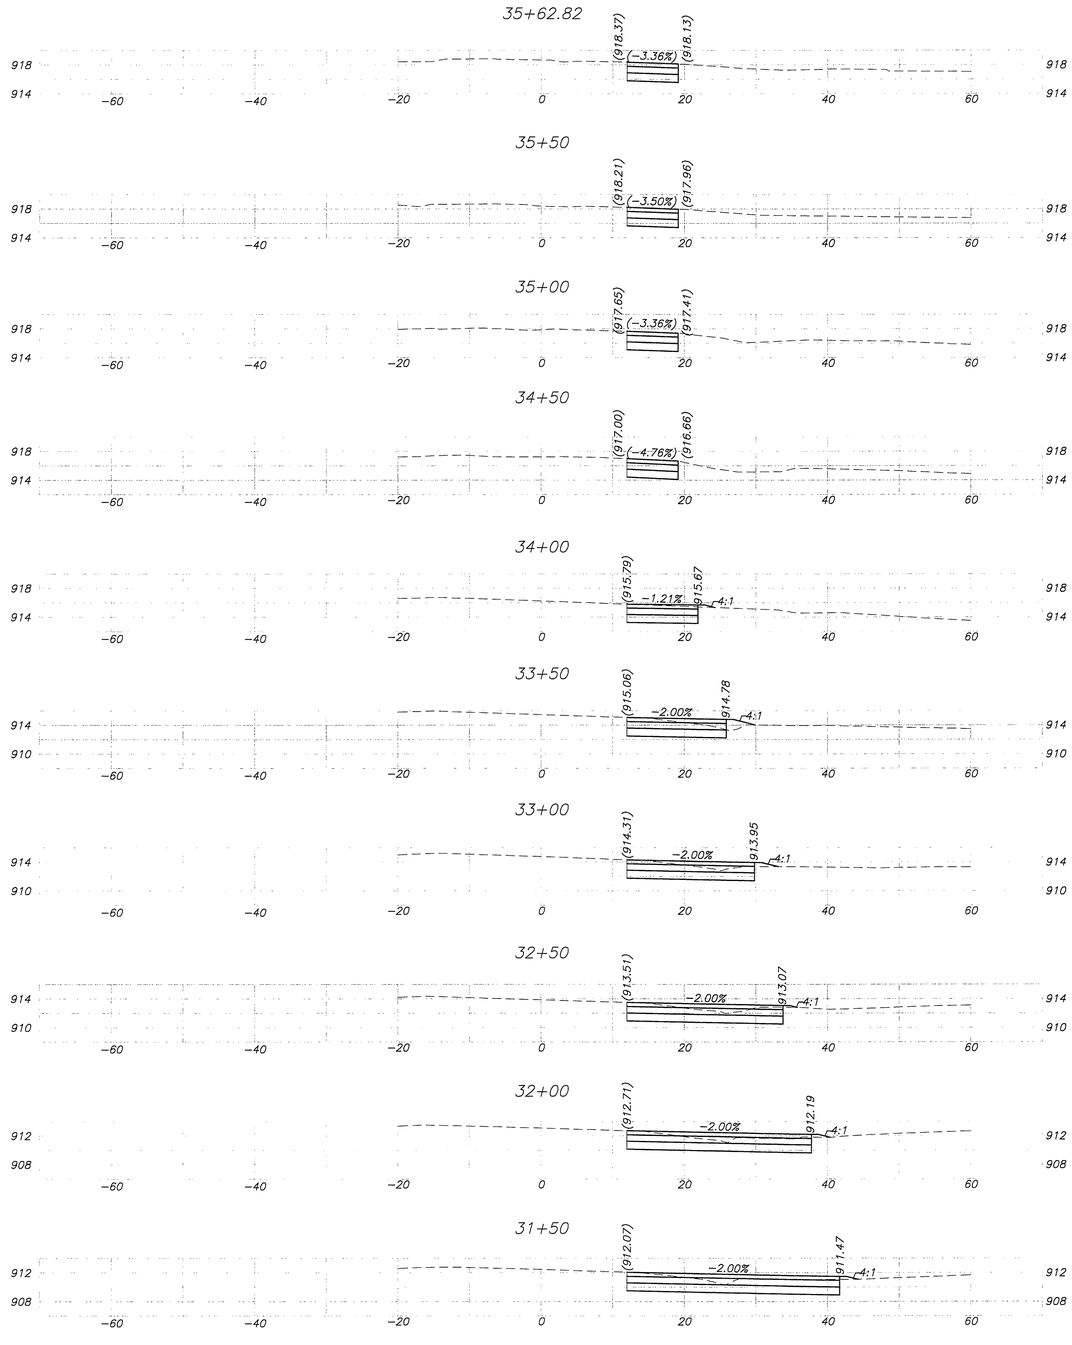

AS BUILT
DATE 9-14-10

NOTES:

1. STATIONING IS BASED ON COLUMBIA AVENUE CONSTRUCTION ℄ ("C" LINE)

DMJM HARRIS | AECOM
800 NORTH HAVEN, SUITE 410
ONTARIO, CA 91764
T (909)291-8150 F (909)291-8166

REGISTERED PROFESSIONAL ENGINEER
CHRIS H. BRECKLEIN
No. C 41824
Exp. 3-31-10
CIVIL
STATE OF CALIFORNIA

MARK	REVISIONS	APPR.	DATE

DESIGNED BY S.A. DRAWN BY S.A. CHECKED BY C.B.

COLUMBIA AVENUE OVERPASS AT BNSF RAILROAD

CROSS SECTIONS – COLUMBIA AVENUE

SCALE: 1"=10'

ACCT. NO. –

R-4036
CX-05
SHEET 96 OF 103

FILE INFO: P:\60004223 Columbia Grade Sep\CADD\Civil\Sheet\CX-05.dwg PLOTTED: Sep 29, 2008 2:14pm BY: amparos PLOT SCALE: 1=1
XREFS: xbdr: xpro-colu MODIFIED: Jul 14, 2008 7:16am

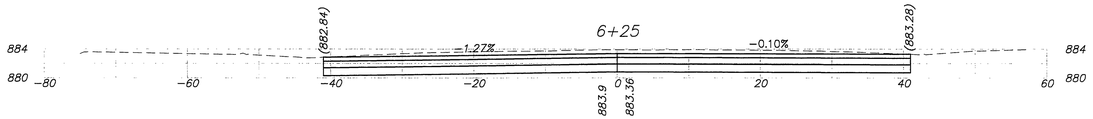

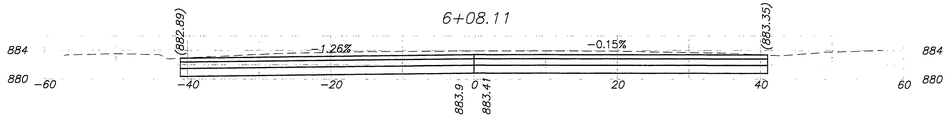

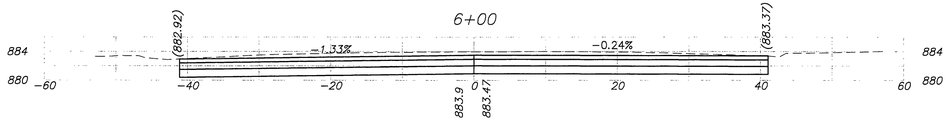

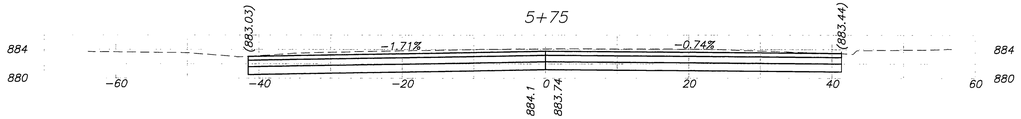

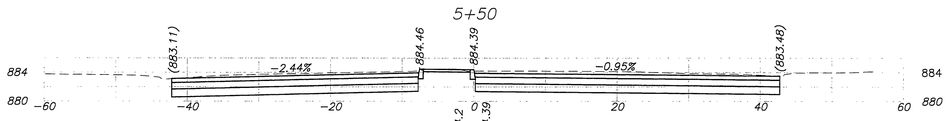

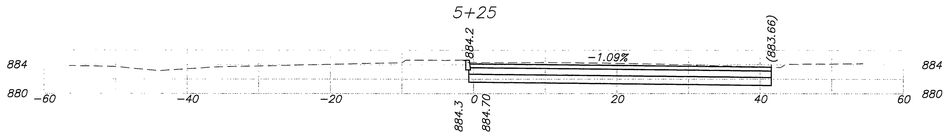

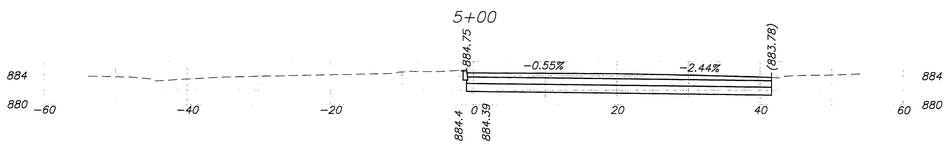

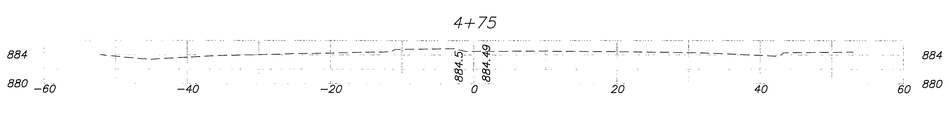

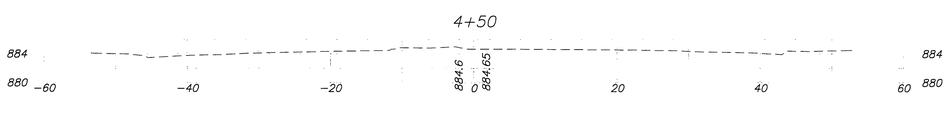

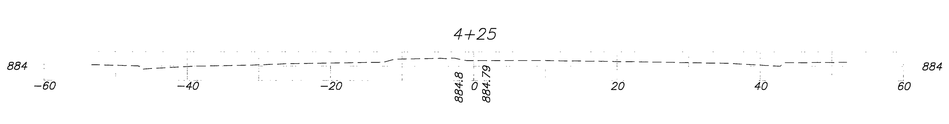

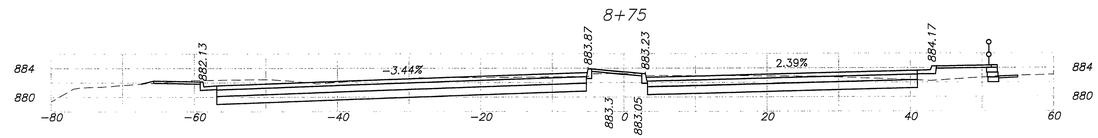

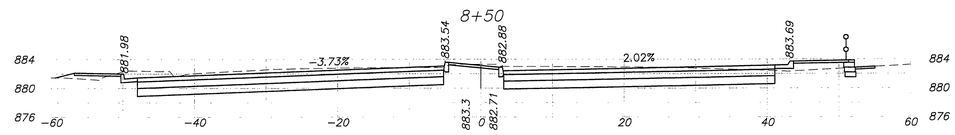

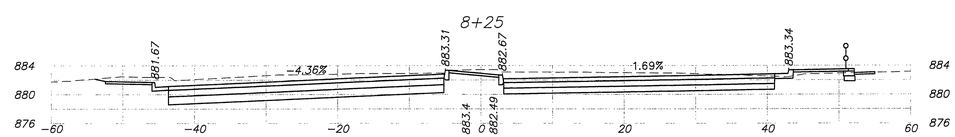

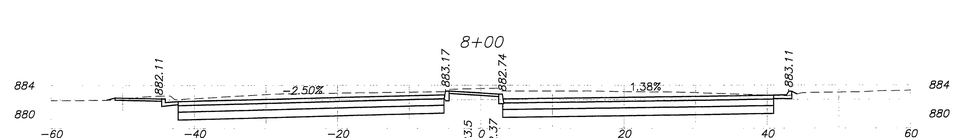

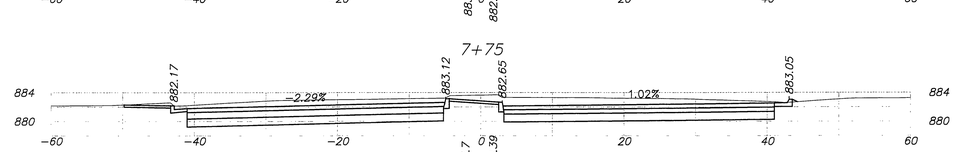

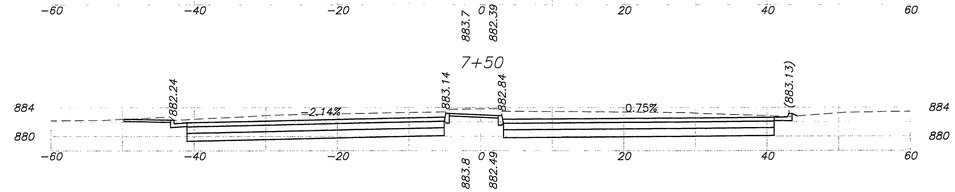

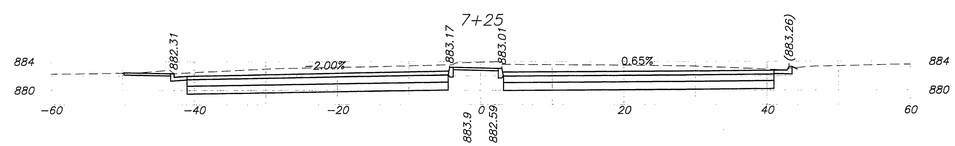

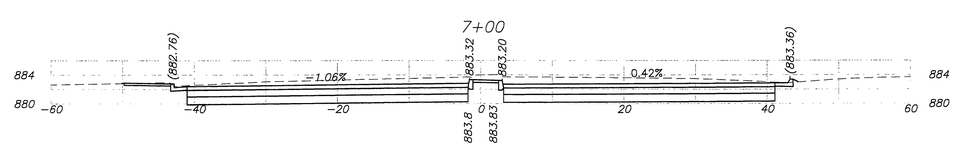

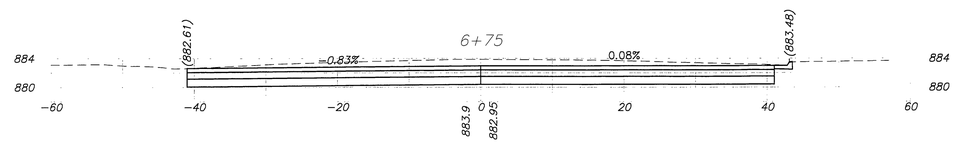

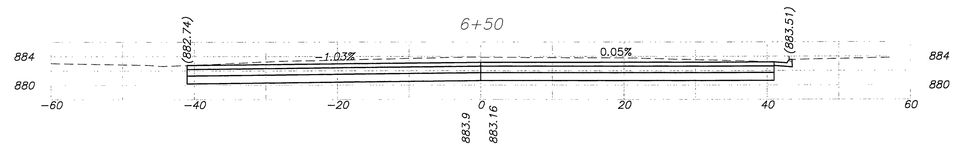

AS BUILT
DATE 9-14-10

NOTES:

1. STATIONING IS BASED ON CHICAGO AVENUE CONSTRUCTION ℄ ("CH" LINE).

DMJM HARRIS | AECOM
800 NORTH HAVEN, SUITE 410
ONTARIO, CA 91764
T (909)291-8150 F (909)291-8166

REGISTERED PROFESSIONAL ENGINEER
CHRIS H. BREVIK
No. C41824
Exp. 3-31-10
CIVIL
STATE OF CALIFORNIA

MARK	REVISIONS	APPR.	DATE

DESIGNED BY S.A. DRAWN BY S.A. CHECKED BY C.B.

COLUMBIA AVENUE OVERPASS AT BNSF RAILROAD

CROSS SECTIONS – CHICAGO AVENUE

SCALE: 1"=10'

ACCT. NO. -

R-4036
CX-06
SHEET 97 OF 103

FILE INFO:P:\60004223 Columbia Grade Sep\CAD\Civil\Sheet\CX-06.dwg PLOTTED: Sep 29, 2008 2:14pm BY: amparos PLOT SCALE: 1=1
XREFS: sbdr: xpro-chic MODIFIED: Jul 14, 2008 7:15am

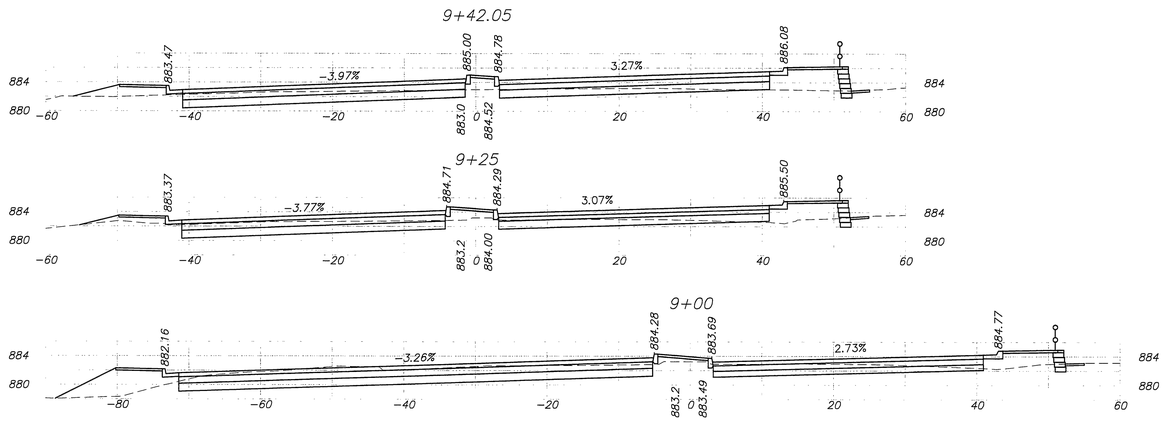

AS BUILT
DATE 9-14-10

NOTES:

1. STATIONING IS BASED ON CHICAGO AVENUE CONSTRUCTION ℄ ("CH" LINE).

DMJM HARRIS | AECOM
800 NORTH HAVEN, SUITE 410
ONTARIO, CA 91764
T (909)291-8150 F (909)291-8166

REGISTERED PROFESSIONAL ENGINEER
CHRIS H. BREWER
No. C41824
Exp. 3-31-10
CIVIL
STATE OF CALIFORNIA

MARK	REVISIONS	APPR.	DATE

DESIGNED BY S.A. DRAWN BY S.A. CHECKED BY C.B.

COLUMBIA AVENUE OVERPASS AT BNSF RAILROAD

CROSS SECTIONS – CHICAGO AVENUE

SCALE: 1"=10'

ACCT. NO. -

R-4036
CX-07
SHEET 98 OF 103

FILE INFO:P:\60004223 Columbia Grade Sep\CADD\Civil\Sheet\CX-07.dwg PLOTTED: Sep 29, 2008 2:15pm BY:amparos PLOT SCALE: 1=1
XREFS.dwb: xprg-dhc MODIFIED: Jul 14, 2008 7:15am

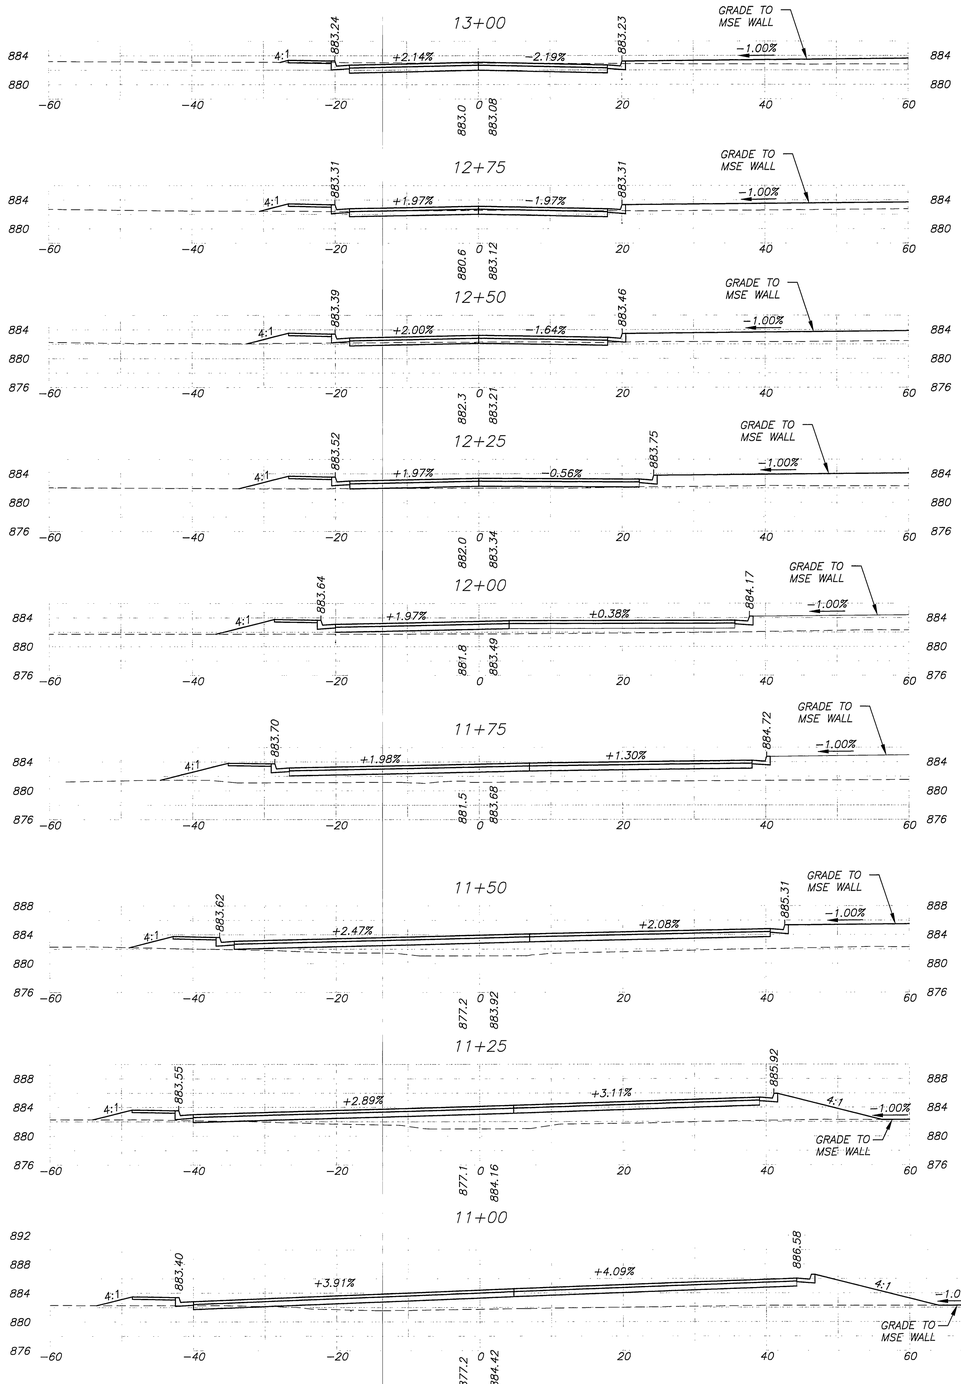

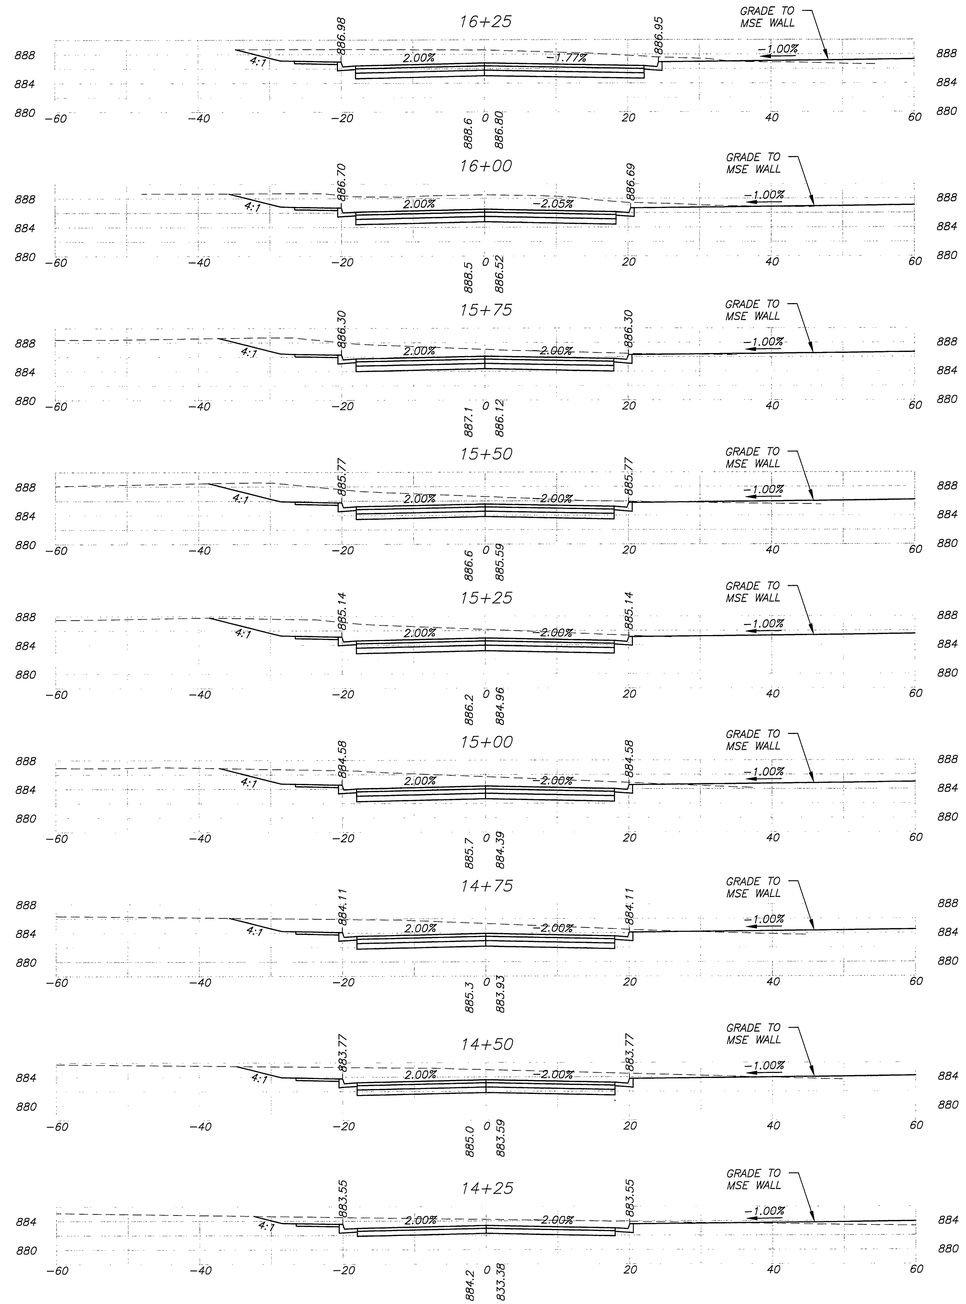

AS BUILT
DATE 9-14-10

NOTES:

1. STATIONING IS BASED ON PAIGE DRIVE CONSTRUCTION ℄ ("P" LINE).

DMJM HARRIS | AECOM
800 NORTH HAVEN, SUITE 410
ONTARIO, CA 91764
T (909)291-8150 F (909)291-8166

REGISTERED PROFESSIONAL ENGINEER
CHRIS H. BRENNAN
No. C41824
Exp. 3-31-10
CIVIL
STATE OF CALIFORNIA

MARK	REVISIONS	APPR.	DATE

DESIGNED BY S.A. DRAWN BY S.A. CHECKED BY C.B.

COLUMBIA AVENUE OVERPASS AT BNSF RAILROAD

CROSS SECTIONS – PAIGE DRIVE

SCALE: 1"=10'

ACCT. NO. -

R-4036

CX-08

SHEET 99 OF 103

FILE INFO:P:\60004223 Columbia Grade Sep\CAD\Civil\Sheet\CX-08.dwg PLOTTED: Sep 29, 2008 2:15pm BY amparos PLOT SCALE 1=1
XREFS:xbdr; xpro-paige MODIFIED: Sep 18, 2008 12:55pm

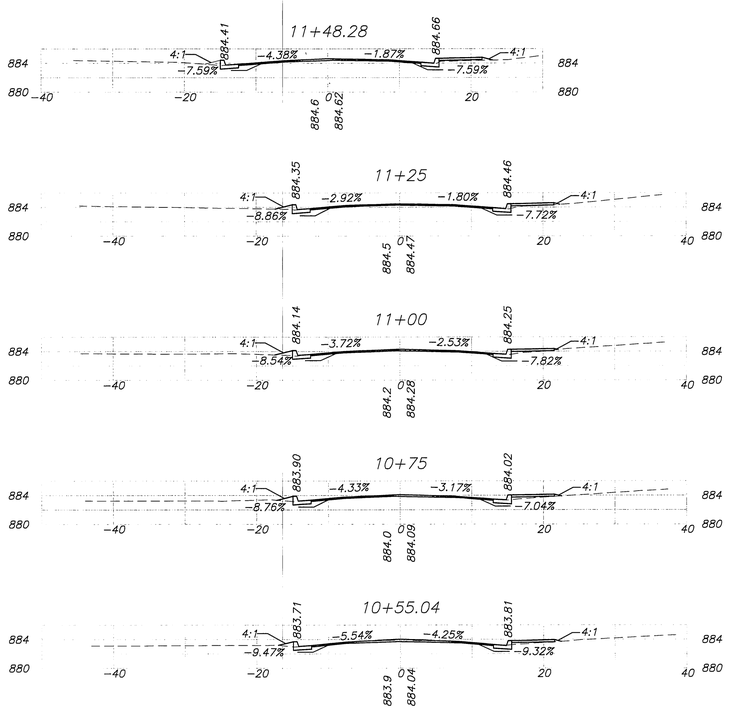

STACY COURT

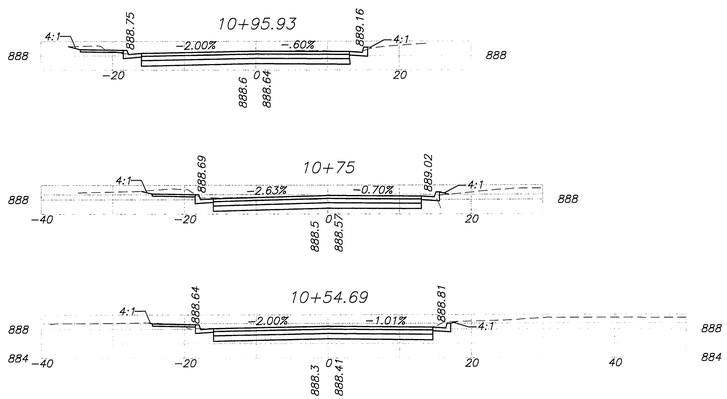

ARDMORE STREET

AS BUILT
DATE 9-14-10

NOTES:
1. STATIONING IS BASED ON STACY COURT CONSTRUCTION ℄ ("S" LINE).
2. STATIONING IS BASED ON ARDMORE STREET CONSTRUCTION ℄ ("A" LINE).

DMJM HARRIS | AECOM
800 NORTH HAVEN, SUITE 410
ONTARIO, CA 91764
T (909)291-8150 F (909)291-8166

REGISTERED PROFESSIONAL ENGINEER
CHRIS H. BRETAN
No. C41824
Exp. 3-31-10
CIVIL
STATE OF CALIFORNIA

MARK	REVISIONS	APPR.	DATE

DESIGNED BY S.A. DRAWN BY S.A. CHECKED BY C.B.

COLUMBIA AVENUE OVERPASS AT BNSF RAILROAD

CROSS SECTIONS – STACY COURT AND ARDMORE STREET

SCALE: 1"=10'

ACCT. NO. -

R-4036
CX-09
SHEET 100 OF 103

FILE INFO: P:\60004223 Columbia Cross Sec\CADD\Civil\Sheet\CX-09.dwg PLOTTED: Sep 29, 2008 2:15pm BY amparos PLOT SCALE: 1=1
XREFS: xsdr, xpro-stacy_ardmore MODIFIED: Jul 14, 2008 7:02am

13+25

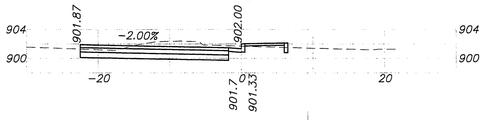

13+00

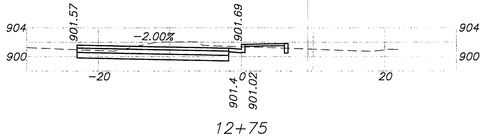

12+75

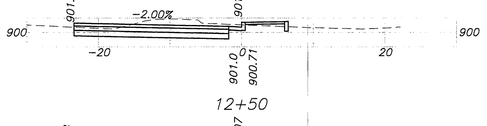

12+50

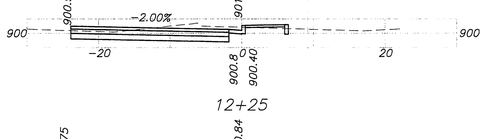

12+25

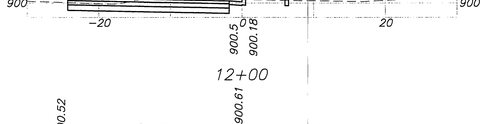

12+00

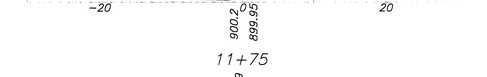

11+75

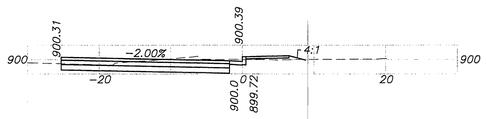

11+50

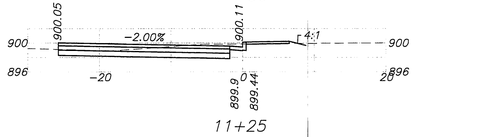

11+25

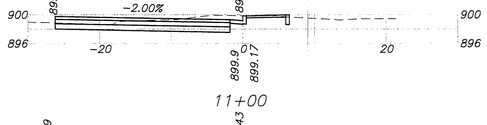

11+00

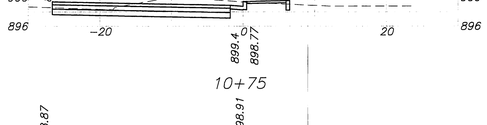

10+75

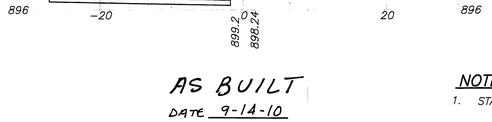

16+00

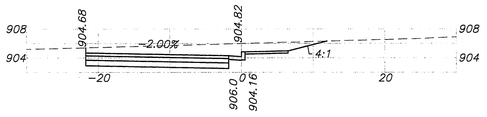

15+75

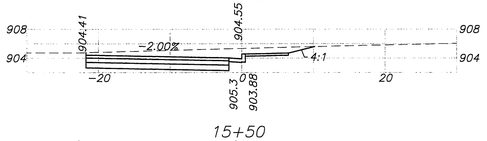

15+50

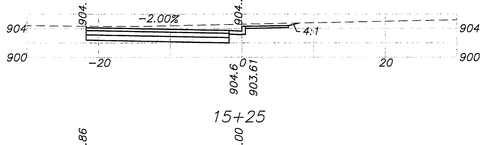

15+25

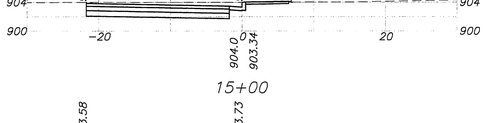

15+00

14+75

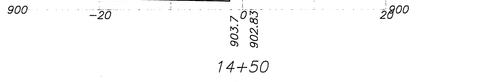

14+50

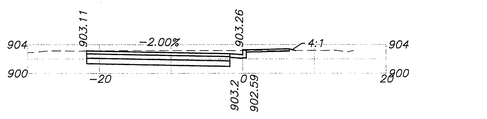

14+25

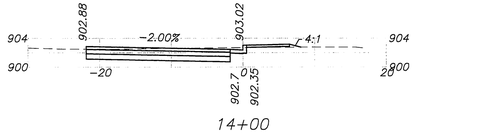

14+00

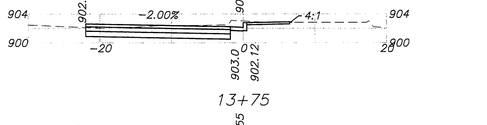

13+75

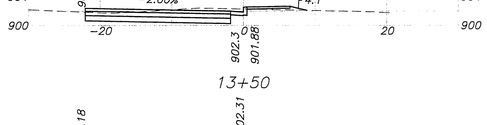

13+50

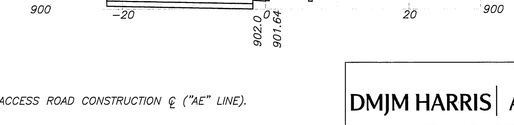

18+86.44

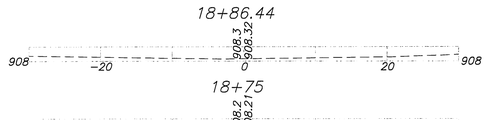

18+75

18+50

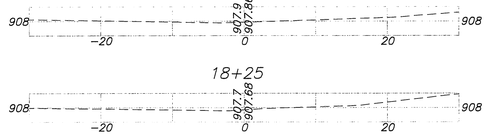

18+25

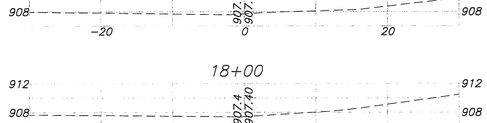

18+00

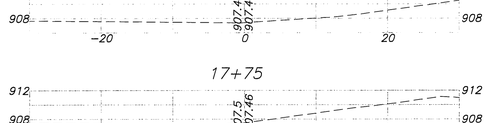

17+75

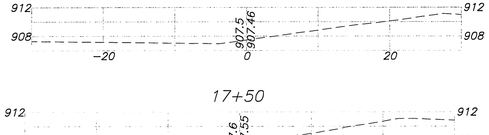

17+50

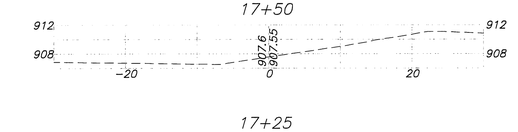

17+25

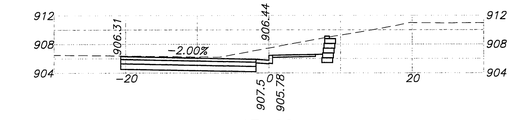

17+00

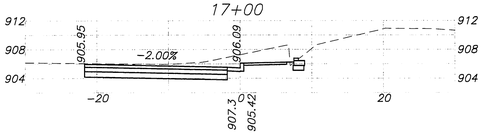

16+75

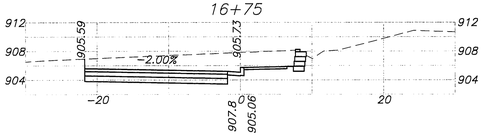

16+50

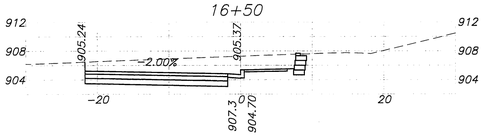

16+25

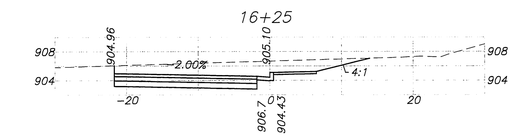

AS BUILT
DATE 9-14-10

NOTES:

1. STATIONING IS BASED ON EASTBOUND ACCESS ROAD CONSTRUCTION ℄ ("AE" LINE).

DMJM HARRIS | AECOM
800 NORTH HAVEN, SUITE 410
ONTARIO, CA 91764
T (909)291-8150 F (909)291-8166

REGISTERED PROFESSIONAL ENGINEER
CHRIS H. BREMER
No. C41824
Exp. 3-31-10
CIVIL
STATE OF CALIFORNIA

MARK	REVISIONS	APPR.	DATE

DESIGNED BY S.A. DRAWN BY S.A. CHECKED BY C.B.

COLUMBIA AVENUE OVERPASS AT BNSF RAILROAD

CROSS SECTIONS – EASTBOUND ACCESS ROAD

SCALE: 1"=10'

ACCT. NO. –

R-4036

CX-10

SHEET 101 OF 103

FILE INFO:P:\60004223 Columbia Grade Sep\CADD\Civil\Sheet\CX-10.dwg PLOTTED: Sep 29, 2008 2:16pm BY: amparos PLOT SCALE: 1=1
XREFS: xdc: xpro-dods MODIFIED: Jul 14, 2008 7:02am

12+50

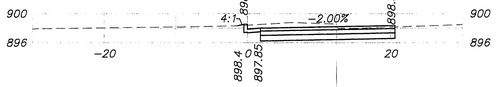

12+25

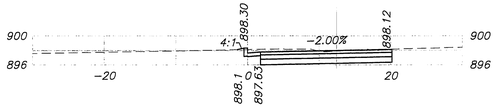

12+00

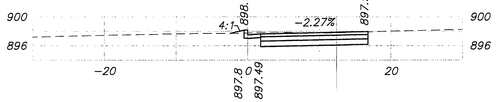

11+75

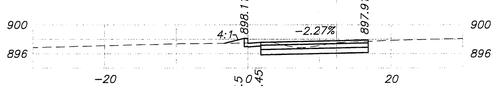

11+50

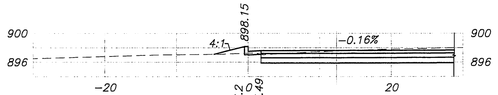

11+25

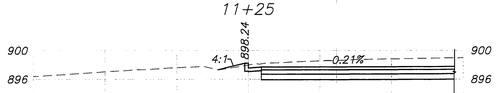

11+00

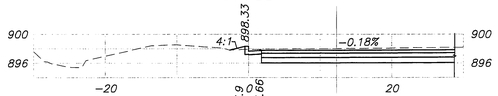

10+75

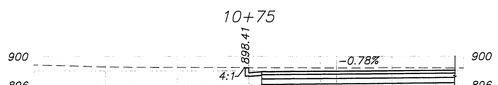

10+50

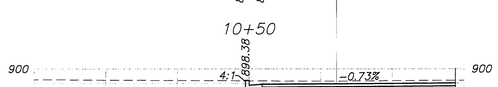

10+25

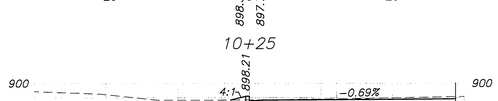

10+00

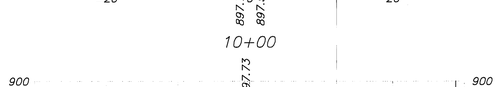

15+25

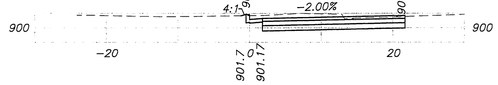

15+00

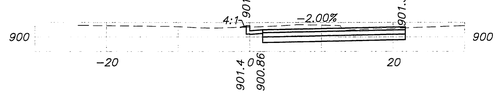

14+75

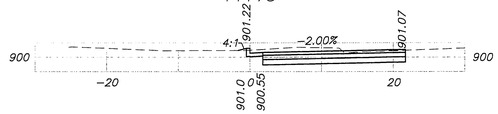

14+50

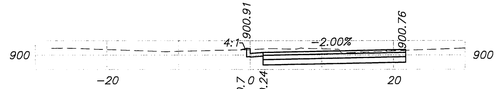

14+25

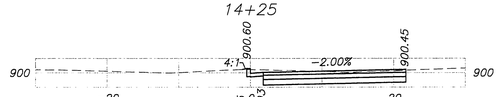

14+00

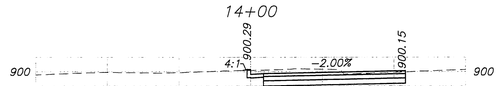

13+75

13+50

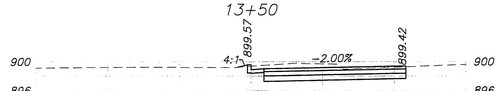

13+25

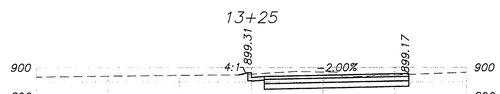

13+00

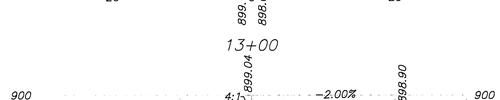

12+75

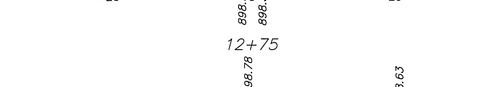

18+00

17+75

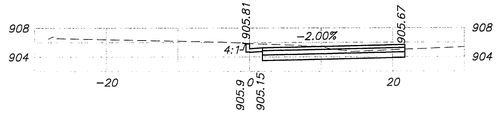

17+50

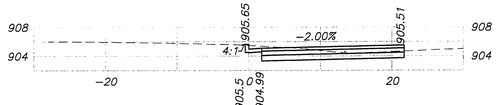

17+25

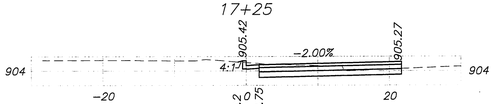

17+00

16+75

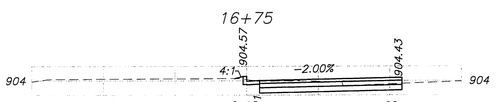

16+50

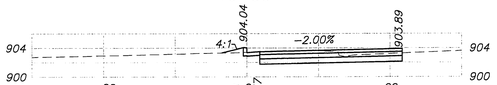

16+25

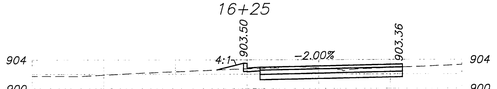

16+00

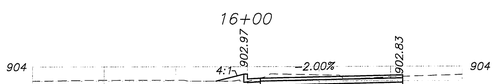

15+75

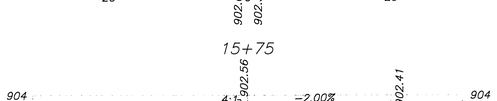

15+50

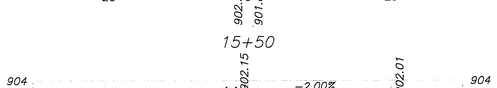

18+49.11

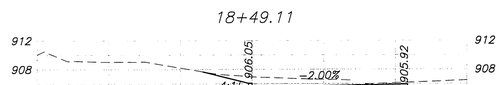

18+25

AS BUILT
DATE 9-14-10

NOTES:

1. STATIONING IS BASED ON WESTBOUND ACCESS ROAD CONSTRUCTION ℄ ("AW" LINE).

DMJM HARRIS | AECOM
800 NORTH HAVEN, SUITE 410
ONTARIO, CA 91764
T (909)291-8150 F (909)291-8166

REGISTERED PROFESSIONAL ENGINEER
CHRIS H. BREPPA
No. C 41824
Exp. 3-31-10
CIVIL
STATE OF CALIFORNIA

MARK	REVISIONS	APPR.	DATE

DESIGNED BY S.A. DRAWN BY S.A. CHECKED BY C.B.

COLUMBIA AVENUE OVERPASS AT BNSF RAILROAD

CROSS SECTIONS – WESTBOUND ACCESS ROAD

SCALE: 1"=10'

ACCT. NO. –

R-4036
CX-11
SHEET 102 OF 103

FILE INFO:P:\60004223 Columbia Grade Sep\CADD\Civil\Sheet\CX-11.dwg PLOTTED: Sep 29, 2008 2:16pm BY:omporos PLOT SCALE: 1=1
XREFS:xbd=; xpro=dads MODIFIED: Jul 14, 2008 7:02am

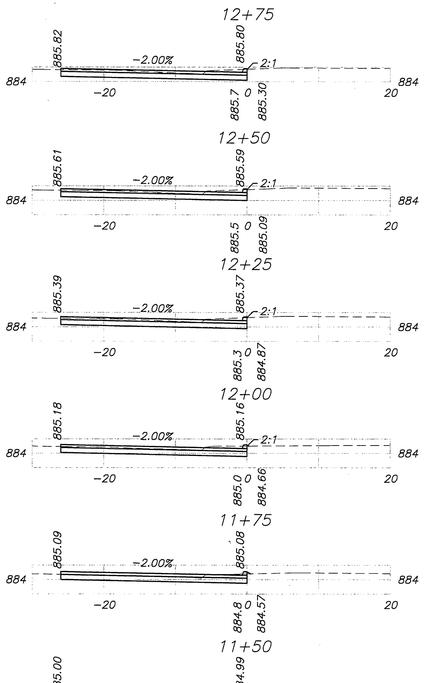

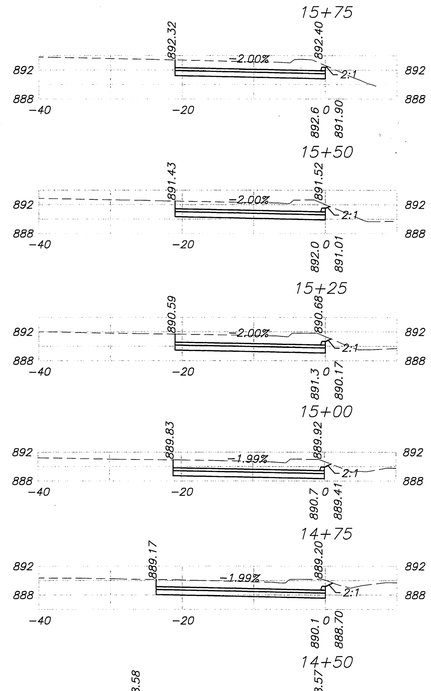

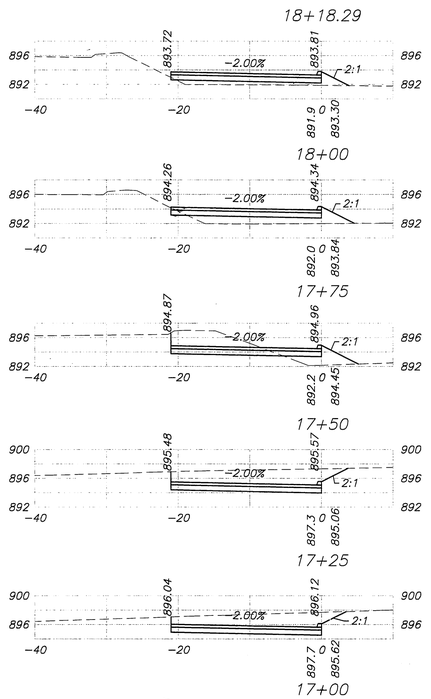

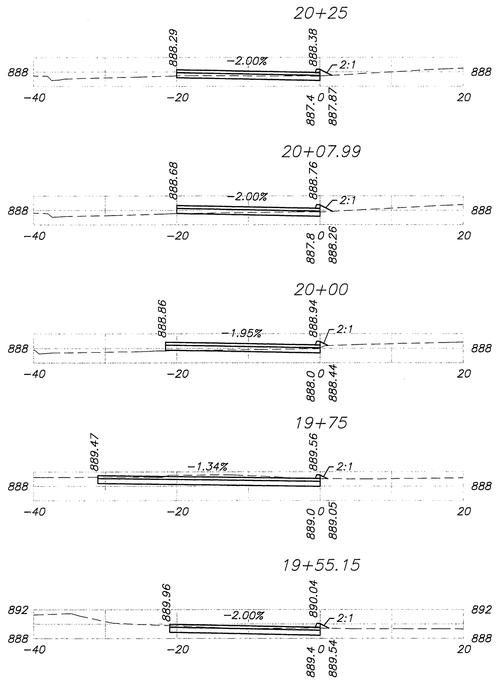

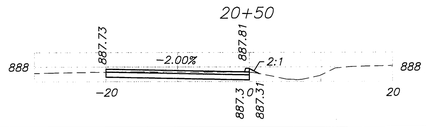

AS BUILT
DATE 9-14-10

NOTES:

1. STATIONING IS BASED ON MAINTENANCE ROAD CONSTRUCTION ℄ ("MR" LINE).

DMJM HARRIS | AECOM
800 NORTH HAVEN, SUITE 410
ONTARIO, CA 91764
T (909)291-8150 F (909)291-8166

REGISTERED PROFESSIONAL ENGINEER — CHRIS H. BREWER — No. C41824 — Exp. 3-31-10 — CIVIL — STATE OF CALIFORNIA

MARK	REVISIONS	APPR.	DATE

DESIGNED BY S.A. DRAWN BY S.A. CHECKED BY C.B.

COLUMBIA AVENUE OVERPASS AT BNSF RAILROAD

CROSS SECTIONS – MAINTENANCE ROAD

SCALE: 1"=10'

ACCT. NO. –

R–4036

CX–12

SHEET 103 OF 103

FILE INFO: P:\60004223 Columbia Grade Sep\CAD\Civil\Sheet\CX-12.dwg PLOTTED: Sep 29, 2008 2:16pm BY: amparos PLOT SCALE: 1=1
XREFS: xbar; xpro-mntc MODIFIED: Jul 14, 2008 7:02am