


**GENERAL CONSTRUCTION NOTES:**

1. THE CONTRACTOR SHALL PROVIDE AND MAINTAIN TRAFFIC AS INDICATED IN THE ASSOCIATED PROJECT SPECIAL PROVISIONS.
2. CONSTRUCTION SHALL BE IN ACCORDANCE WITH THE CITY OF RIVERSIDE STANDARD DRAWINGS AND STANDARD SPECIFICATIONS FOR PUBLIC WORKS CONSTRUCTION, 2012 EDITION.
3. EXISTING UTILITIES SHOWN ON THIS PLAN ARE PLOTTED FROM UTILITY RECORDS. THE CONTRACTOR IS REQUIRED TO TAKE DUE PRECAUTIONARY MEASURES TO LOCATE AND PROTECT ALL UTILITIES WHETHER OR NOT SHOWN ON THIS PLAN.
4. CONFLICTING UTILITIES SHOWN WITHIN CONSTRUCTION AREA WILL BE RELOCATED PRIOR TO CONSTRUCTION.
5. ALL STREET PULL BOXES, AFFECTED BY CONSTRUCTION, SHALL BE ADJUSTED TO THE PROPOSED GRADE.
6. PRIME CONTRACTOR BIDDING THIS WORK SHALL HAVE A CLASS "A" OR "C-12".
7. THE SEAM BETWEEN PASSES OF THE AC OVERLAY SHALL COINCIDE, AS CLOSE AS POSSIBLE, TO THE LANE LINES.
8. COLD MILLING SHALL BE AS DESCRIBED ON THE PLANS AND SPECIAL PROVISIONS OR AS DIRECTED BY THE ENGINEER.
9. ANY DISTRESSED EXISTING PAVEMENT SHALL BE REMOVED AND REPLACED AS DIRECTED BY THE ENGINEERING AFTER COLD-MILLING AND PRIOR TO PLACEMENT OF DGAC.
10. CONTRACTOR SHALL REMOVE ALL VEGETATION WITHIN ALL SIDEWALK PANELS WITHIN THE PROJECT LIMITS.
11. ALL EXISTING IMPROVEMENTS SHOWN HEREON SHALL BE PROTECTED IN PLACE UNLESS OTHERWISE NOTED.
12. EXISTING IRRIGATION SHALL BE PROTECTED OR MODIFIED AS NECESSARY TO CONSTRUCT NEW CONCRETE IMPROVEMENTS.
13. ALL DIMENSIONS SHOWN ADJACENT TO C&G ARE TO THE FACE OF CURB.
14. SEE STRIPING & TRAFFIC SIGNAL PLANS FOR REMOVAL, REPLACEMENT, AND RELOCATION OF EXISTING SIGNING, STRIPING, LOOPS, AND TRAFFIC EQUIPMENT.

**RIVERSIDE**

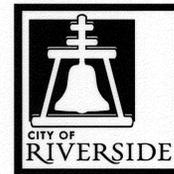

**CALIFORNIA**

**PUBLIC WORKS DEPARTMENT**

**2012/2013**

**ARTERIAL STREETS MAINTENANCE  
PHASE 3**

**CONSTRUCTION LEGEND:**


- CM2/OL, APPLY TYPE II SLURRY WHERE INDICATED  
COLDMILL TYPE CM2, DEPTH PER PLAN  
NEW DGAC PAVEMENT &  
0.12' DGAC OVERLAY
- PROPOSED CONCRETE SURFACE
- SLURRY SEAL, TYPE II

**EXISTING TOPOGRAPHY:**

- SANITARY SEWER M.H.
- STORM DRAIN M.H.
- ELECTRIC M.H.
- WATER M.H.
- GATE VALE
- ELECTRIC STRUCTURES
- FIRE HYDRANT
- ELECTROLYSIS TEST STATION

**CONSTRUCTION NOTES:**

- REMOVE AND REPLACE IN KIND NUMBERS ABOVE 100 IN A HEXAGON ON THE PLAN PER THE RESPECTIVE STANDARD DRAWING AND SHALL BE CONSTRUCTED ACCORDINGLY. ANY NOTE SHOWN BELOW THE STANDARD DRAWING NUMBER INDICATES THE SPECIFIC TYPE, ACTION, OR MODIFICATION TO BE CONSTRUCTED. (RM) REMOVAL.
- ADJUST TO GRADE, DESCRIPTION PER PLAN. (MH) ELECTRIC, TELEPHONE, SEWER OR STORM DRAIN. (GV) GATE VALVE. (ETS) ELECTRIC TEST STATION. (WM) WATER METER. (PB) PULLBOX. (VLT) WATER VAULT.
- PROTECT IN PLACE, DESCRIPTION PER PLAN. (MH) SEWER OR STORM DRAIN. (GV) GATE VALVE. (WM) WATER METER. (PB) PULLBOX. (SL) STREET LIGHT. (TR) TRAFFIC SIGNAL EQUIPMENT. (TRE) TREE. (DWY) DRIVEWAY.
- GRIND LIP OF EXISTING WHEELCHAIR RAMP TO PROVIDE A SMOOTH TRANSITION BETWEEN SIDEWALK AND PAVEMENT
- RECONSTRUCT CONCRETE SIDEWALK SURFACE PER CITY STANDARD 325 MODIFIED TO INCLUDE A CONCRETE/MORTAR MIXTURE TO MATCH EXISTING COLOR, ROCK SIZE AND TEXTURE.
- VARIABLE AREA COLD MILL OF EXISTING AC PAVEMENT AND NEW DGAC OVERLAY BETWEEN EDGES OF PAVEMENT OR AS OTHERWISE INDICATED ON PLAN.  
• XX = DEPTH(FEET) OF VARIABLE AREA COLD MILL.
- BUS PAD SHALL BE CONSTRUCTED 60' LONG AND 12' WIDE MEASURED FROM MONOLITHIC CURB FACE. BASE OR SUBGRADE OR EXISTING PAD SHALL BE REMOVED AND COMPACTED AS NECESSARY TO INSTALL BUS PAD PER DETAIL IN PART 10 OF THE SPECIFICATIONS.
- CUT NEW GROOVES IN THE EXISTING RAMP AS DIRECTED BY THE ENGINEER, PER CITY STANDARD 304.
- CONSTRUCT TYPE II SLURRY SEAL AS DESCRIBED IN SPECIAL PROVISIONS. SLURRY TO BE APPLIED WITHIN ENTIRE LIMITS INDICATED ON PLAN INCLUDING OVER NEW DGAC AREAS.
- DGAC OVERLAY TO MATCH LIMITS AND DEPTH OF COLDMILL.

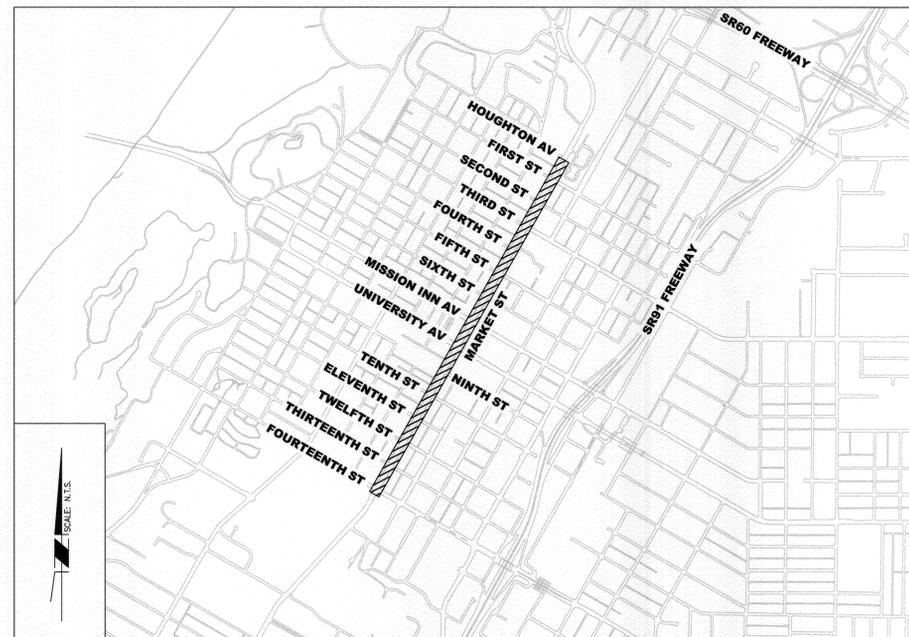

**LOCATION MAP  
MARKET STREET (FOURTEENTH STREET - HOUGHTON AVENUE)  
N.T.S.**

**LOCATION MAP LEGEND**  
 PROJECT LOCATION

**STREET IMPROVEMENT PLAN INDEX (R-4269)**

SHEET NO.	DESCRIPTION
1	TITLE SHEET AND NOTES
2	MARKET STREET (FOURTEENTH STREET - SIXTH STREET)
3	MARKET STREET (FIFTH STREET - HOUGHTON AVENUE)

**STRIPING PLAN INDEX (XL-710)**

SHEET NO.	DESCRIPTION
1	MARKET STREET (FOURTEENTH STREET - TWELFTH STREET)
2	MARKET STREET (ELEVENTH STREET - MISSION INN AVENUE)
3	MARKET STREET (SIXTH STREET - HOUGHTON AVENUE)



**ENGINEER IN RESPONSIBLE CHARGE**  
Edward Lara  
R.C.E. No. 63753 EXPIRES: 9-30-14  
DATE June 14, 2013





MARK	REVISIONS	APPR.	DATE

**CITY OF RIVERSIDE, CALIFORNIA  
DEPARTMENT OF PUBLIC WORKS**

APPROVED BY	BY	DATE	APPROVED BY
ENGINEERING MANAGER	E.M.	6-12-13	[Signature]
CONSTRUCTION ADMIN.	C.A.	6/18/13	CITY ENGINEER
TRAFFIC DIVISION	T.D.	6-14-13	DATE: 6/19/2013
SURVEY	S.		

**STREET MAINTENANCE**  
**2012/2013 ARTERIAL STREETS MAINTENANCE - PHASE 3**  
**TITLE SHEET AND NOTES**  
HORIZ. SCALE: N/A VERT. SCALE: N/A

DESIGN WORK ORDER NO.: 1306414  
CONSTR. WORK ORDER NO.: 1328213  
**R-4269**  
SHEET **1** OF **3**  
FILE NAME: R4269-01.DWG

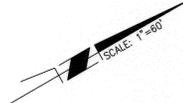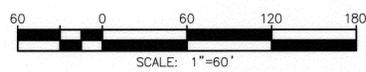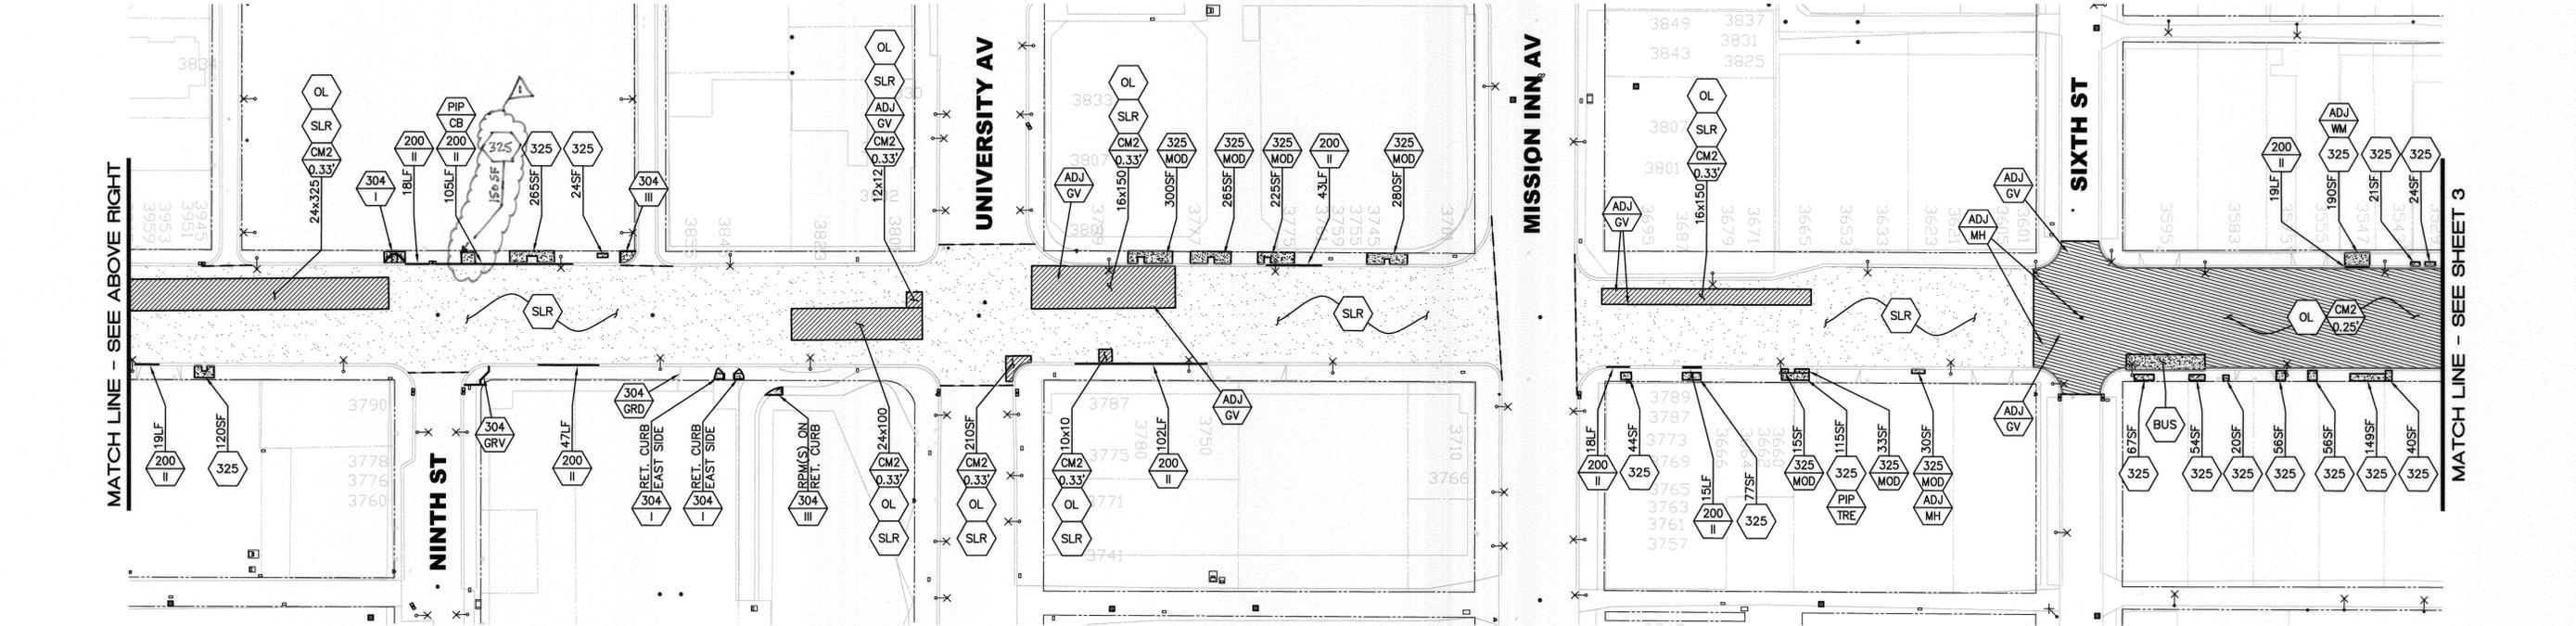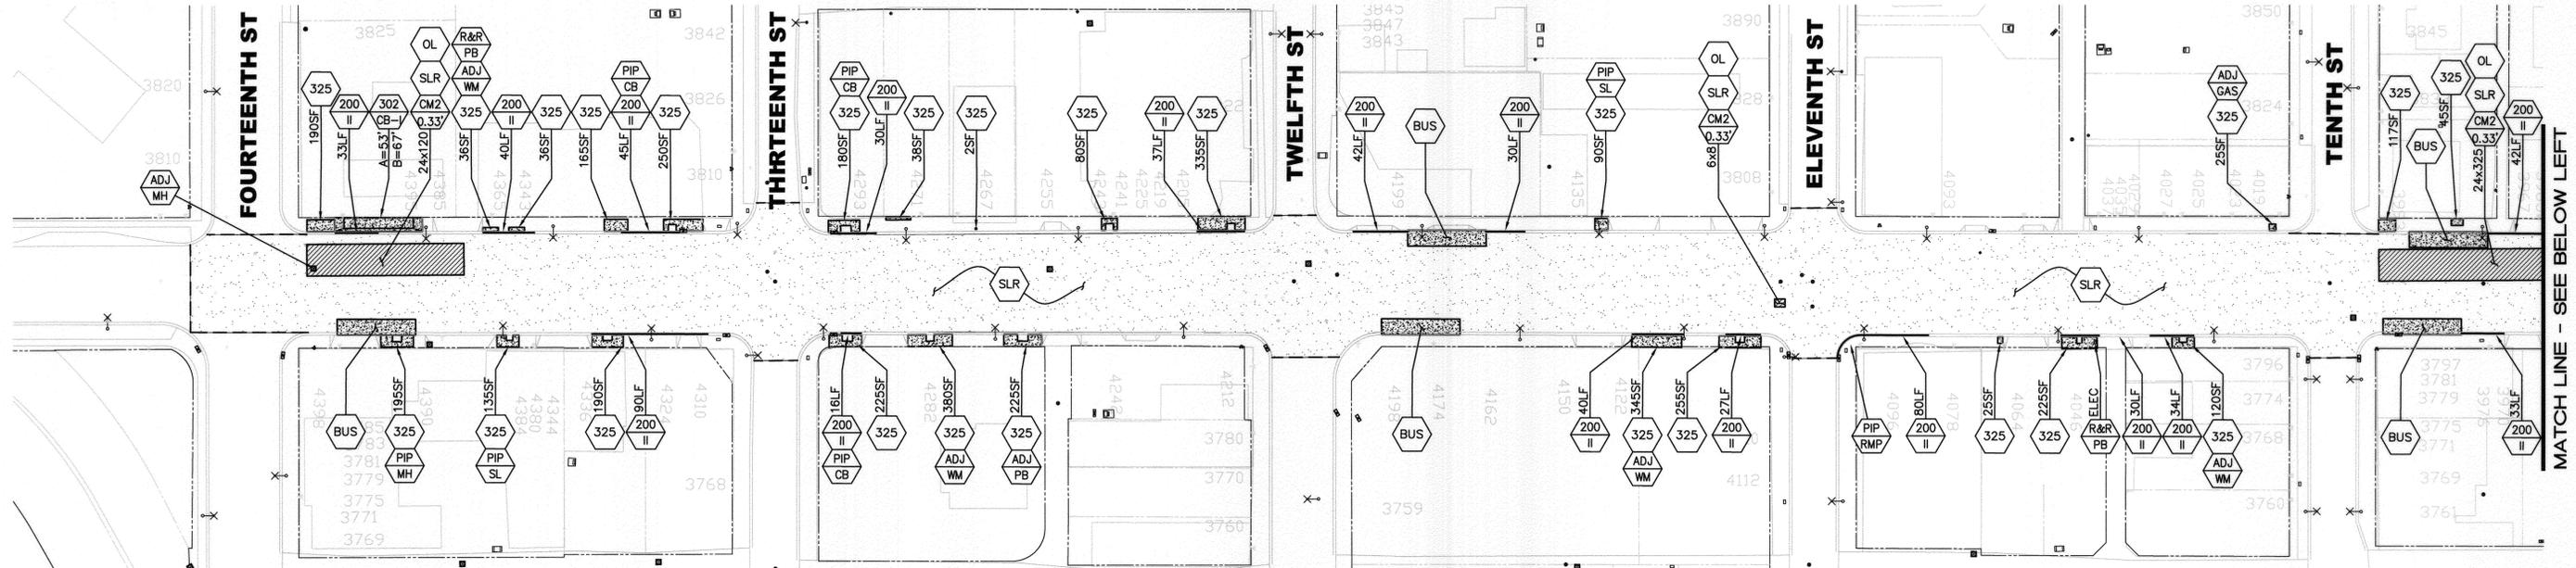

Under Ground Service Alert of Southern California  
 Call: TOLL FREE 1-800-227-2600  
 TWO WORKING DAYS BEFORE YOU DIG



**ENGINEER IN RESPONSIBLE CHARGE**  
 Edward Lara  
 R.C.E. No. 63753 EXPIRES: 9-30-14  
 DATE: June 17, 2013







DESIGNED BY	DMC	DRAWN BY	DMC	CHECKED BY	EL						
APPROVED BY	<table border="1"> <tr> <td>ADD SIDEWALK/REMOVE RAMP</td> <td>APPR.</td> <td>DATE</td> </tr> <tr> <td></td> <td>E.L.</td> <td>6/17/13</td> </tr> </table>					ADD SIDEWALK/REMOVE RAMP	APPR.	DATE		E.L.	6/17/13
ADD SIDEWALK/REMOVE RAMP	APPR.	DATE									
	E.L.	6/17/13									

CITY OF RIVERSIDE, CALIFORNIA DEPARTMENT OF PUBLIC WORKS			
APPROVED BY	BY	DATE	APPROVED BY
ENGINEERING MANAGER	E.M.	6/17/13	City Engineer
CONSTRUCTION ADMIN.	DC	6/18/13	
TRAFFIC DIVISION	TH	6-17-13	
SURVEY			
DATE: 6/17/2013			

STREET MAINTENANCE	
2012/2013 ARTERIAL STREETS MAINTENANCE - PHASE 3	
MARKET STREET	
HORIZ. SCALE: 1"=60'	VERT. SCALE:

DESIGN WORK ORDER NO. 1306414	R-4269
CONSTR. WORK ORDER NO. 1328213	
SHEET 2 OF 3	
FILE NAME: R4269-02.DWG	

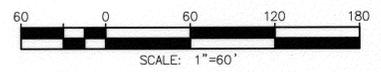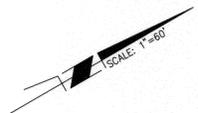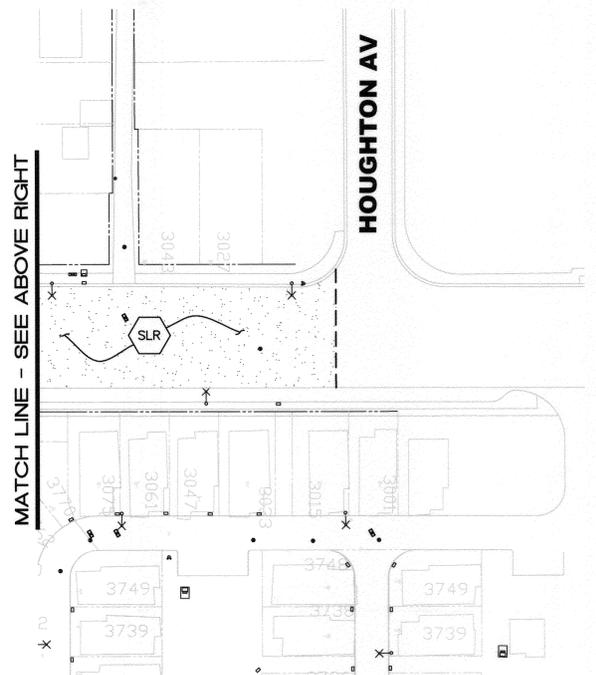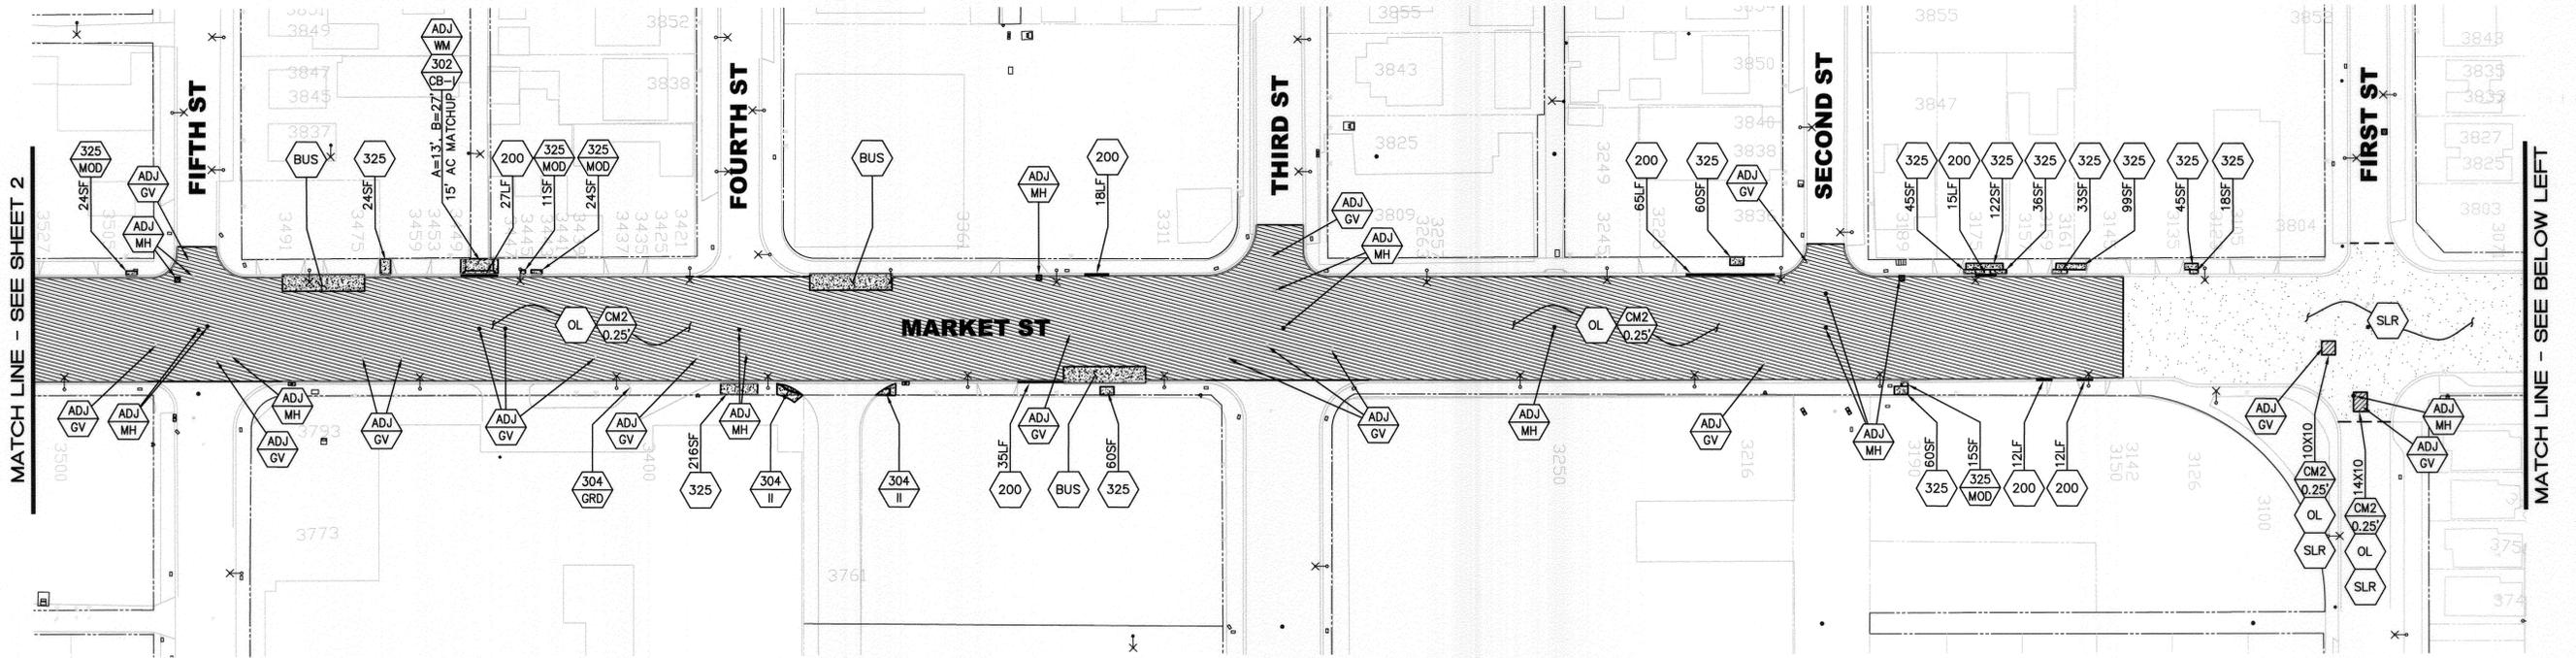



 Under Ground Service Alert  
 of Southern California  
 Call: TOLL FREE 1-800-227-2600  
 TWO WORKING DAYS BEFORE YOU DIG


**ENGINEER IN RESPONSIBLE CHARGE**  
  
 Edward Lara  
 R.C.E. No. 63753 EXPIRES: 9-30-14  
 DATE June 14, 2013



MARK	REVISIONS	APPR.	DATE

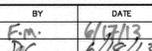**CITY OF RIVERSIDE, CALIFORNIA**  
**DEPARTMENT OF PUBLIC WORKS**  
 APPROVED BY:  DATE: 6/17/13  
 ENGINEERING MANAGER  
 CONSTRUCTION ADMIN. DC DATE: 6/18/13  
 TRAFFIC DIVISION F.H. DATE: 6/14/13  
 SURVEY

**STREET MAINTENANCE**  
**2012/2013 ARTERIAL STREETS MAINTENANCE - PHASE 3**  
**MARKET STREET**  
 HORIZ. SCALE: 1"=60' | VERT. SCALE:

DESIGN WORK ORDER NO.: 1306414  
 CONSTR. WORK ORDER NO.: 1328213  
**R-4269**  
 SHEET **3** OF **3**  
 FILE NAME: R4269-03.DWG

DESIGNED BY: DMC DRAWN BY: DMC CHECKED BY: EL