~~3798~~, T1P

Street: HILLSIDE AVE

X-Street: MT. VIEW AVE

OFFICIAL USE ONLY

HISTORICAL DATA
FB. 551/33
HILLSIDE MANOR
UNIT NO. 2
~~POINTE MANOR~~

Field PARTY
LOWRY
GRANDINETTE
FYFE
FB. 855/27
10-4-1968

FIELD CHECK
5-28-69 JWS

TAG OUT JHT
5 17 77

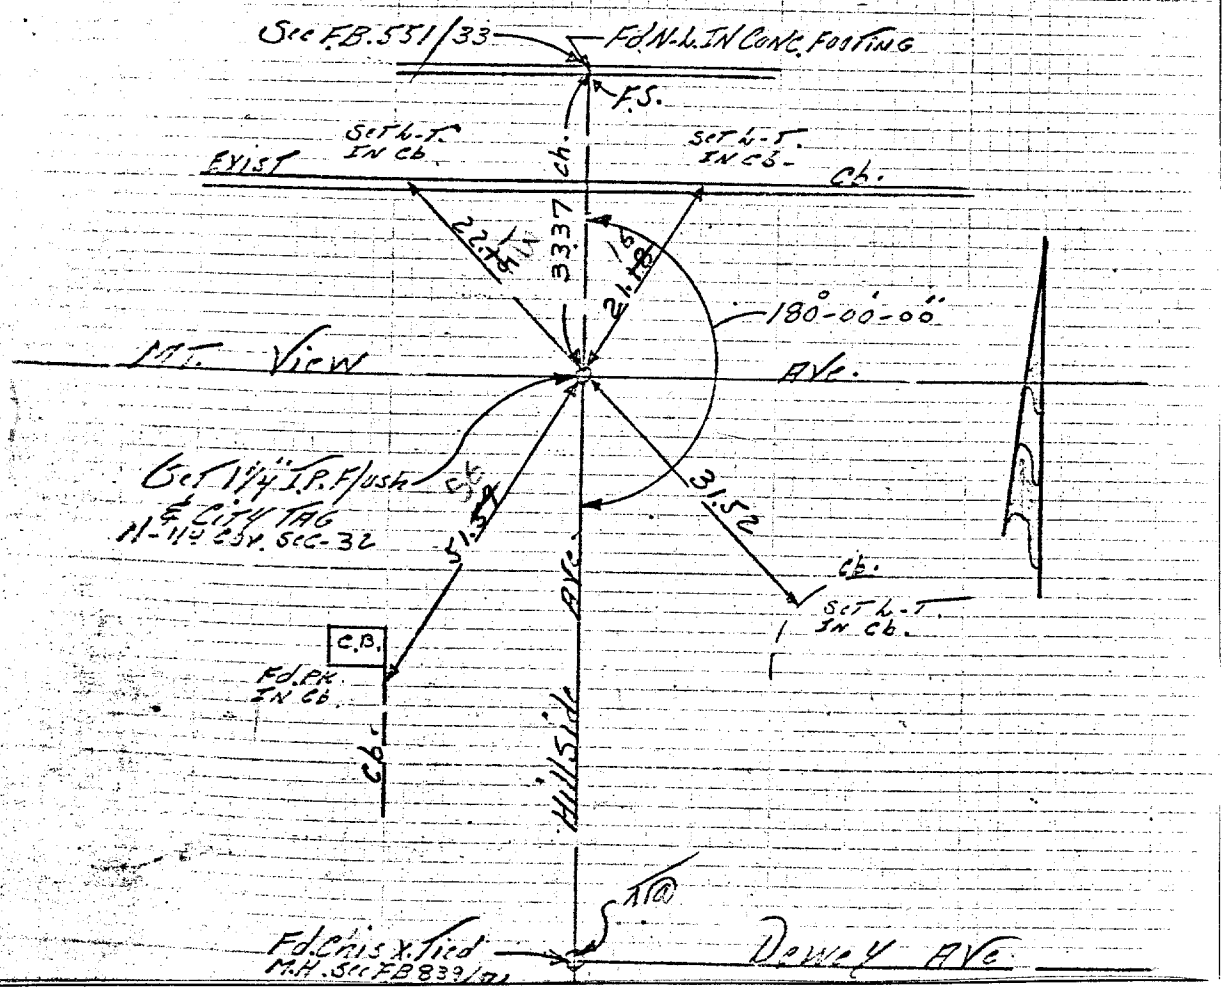

✕ FD. Ramset Nail on T/C
■ FD. "C" Nail on T/C
● FD. LD. & TK. on T/C
○ Set LD. & TK. on T/C

Scale:	**OFFICIAL TIE PLAT** **CITY OF RIVERSIDE**	
Date:		
Drawn by:	*These ties are for the purpose of perpetuating the found monumentation. No claim is made as to the relationship of the points or lines shown hereon to true boundary locations.*	Sheet 1 of 1
W.O.:		File No.:
F.B.:		