4175.TIF

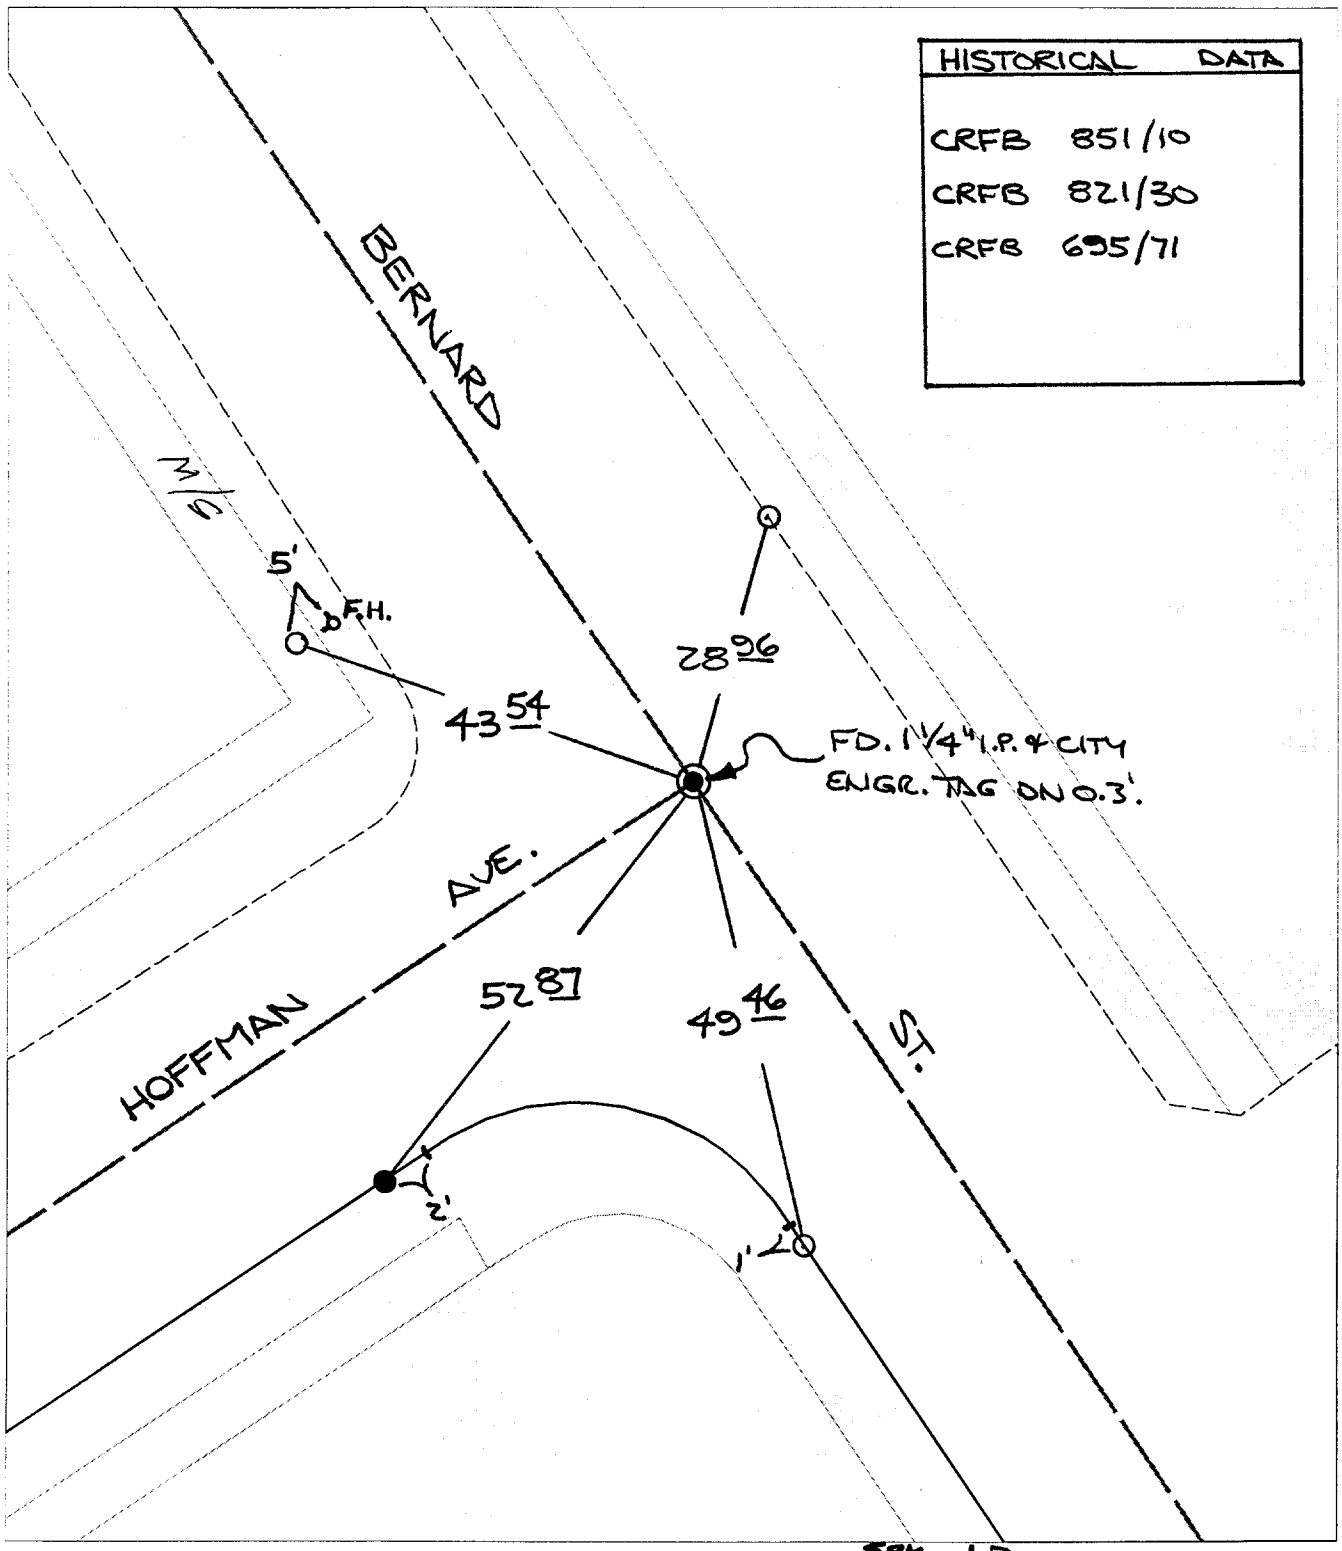

Street: BERNARD ST

X-Street: HOFFMAN AVE

OFFICIAL USE ONLY

✕ FD. Ramset Nail on T/C

■ FD. "C" Nail on T/C

● FD. ~~LD.~~ SPK. & ~~TK.~~ LD. on T/C

○ Set LD. & TK. on T/C

Scale: 1" = 20'	**OFFICIAL TIE PLAT**	N W E S
Date: 03/02/99	**CITY OF RIVERSIDE**	
Drawn by: scurtis	*These ties are for the purpose of perpetuating the found monumentation. No claim is made as to the relationship of the points or lines shown hereon to true boundary locations.*	Sheet 1 of 1
W.O.:		File No.:
F.B.:		