SWING TIES

4991. TIF

NOTE:

◉ ~~FD. 3/4" I.P. W/RE 9876~~
~~TAG FLUSH~~
RESET P.K. & CITY
ENGR. TAG

HISTORICAL DATA

MB 34/75-76

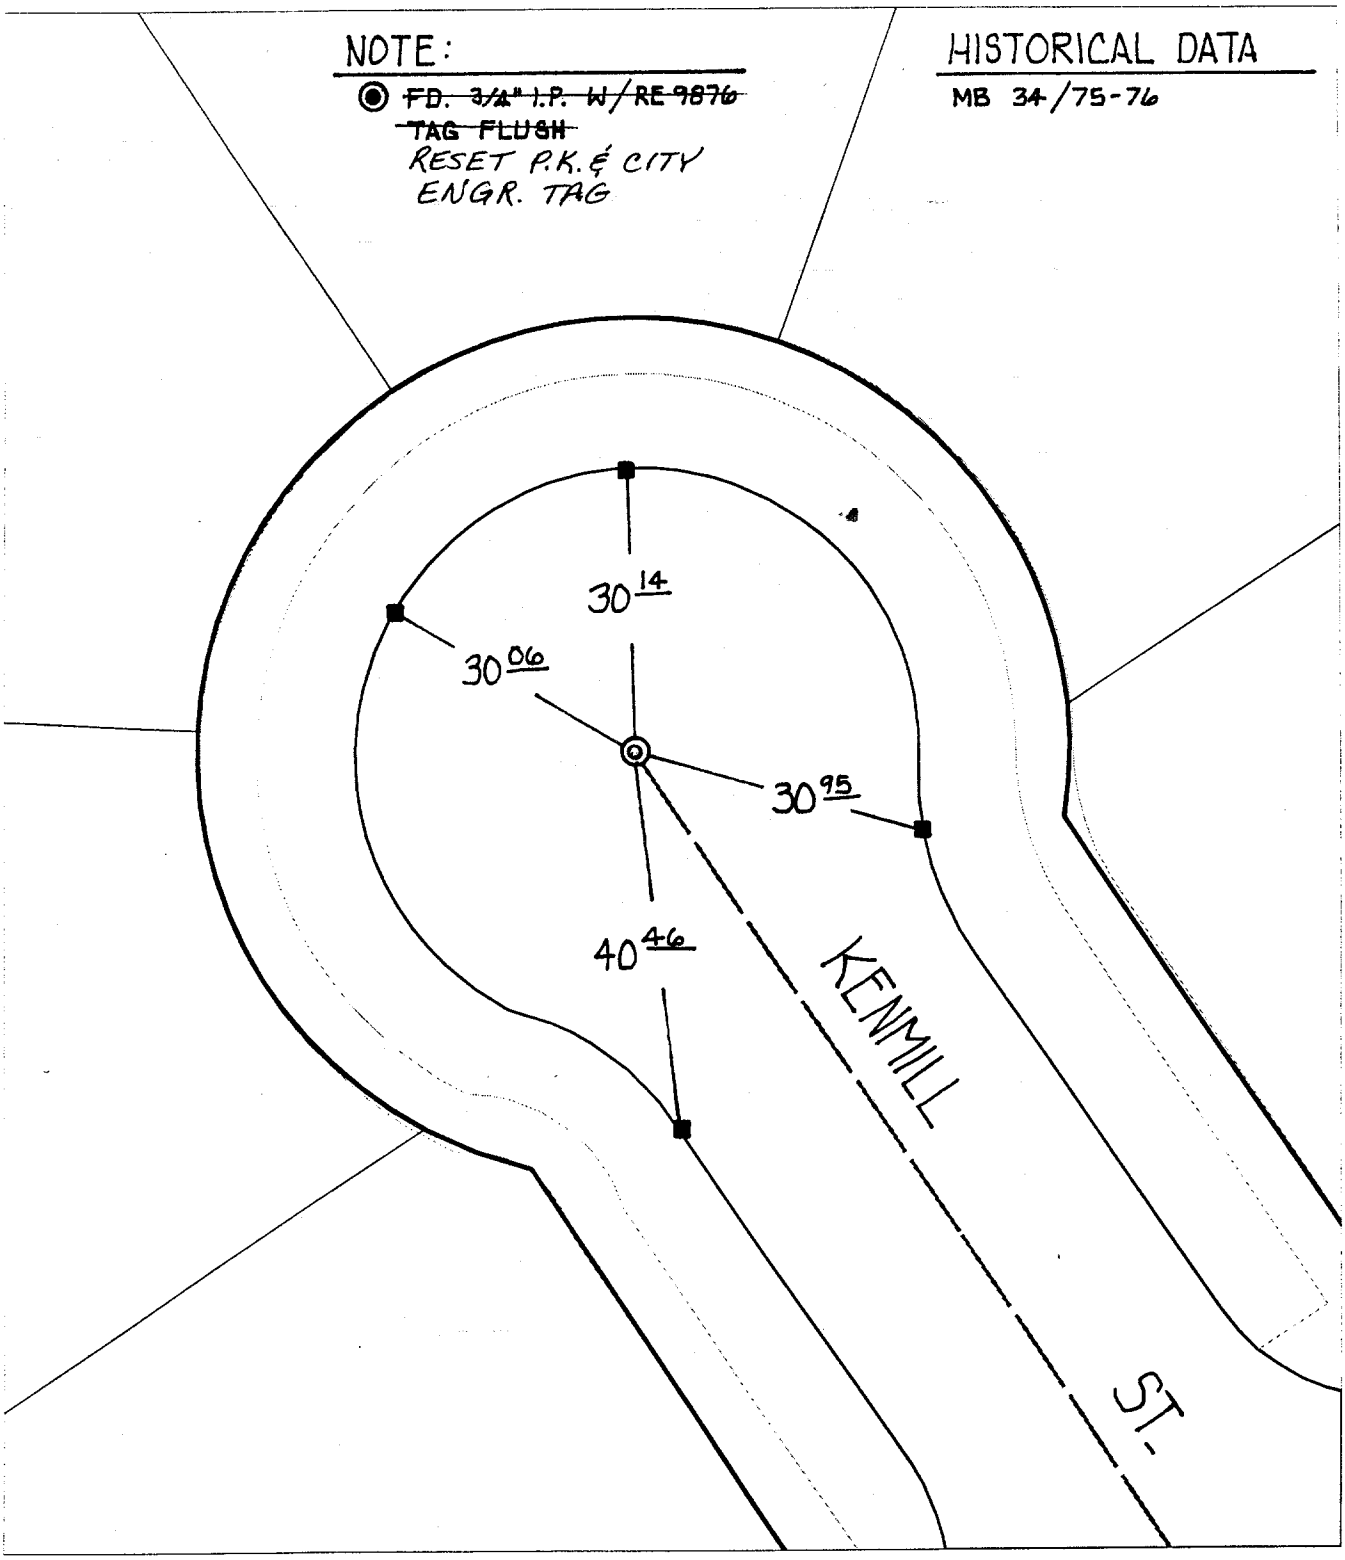


Street: KENMILL ST

X-Street: N'LY CUL-DE-SAC

OFFICIAL USE ONLY

4991 TIF

✕ FD. Ramset Nail on T/C
■ FD. "C" Nail on T/C
● FD. LD. & TK. on T/C
○ Set LD. & TK. on T/C

| | | |
|---|---|---|
| Scale: 1" = 20' | **OFFICIAL TIE PLAT** | N W E S |
| Date: 11/23/99 | **CITY OF RIVERSIDE** | |
| Drawn by: scurtis | *These ties are for the purpose of perpetuating the found monumentation. No claim is made as to the relationship of the points or lines shown hereon to true boundary locations.* | Sheet 1 of 1 |
| W.O.: | | File No.: |
| F.B.: | | |