5426.TIF

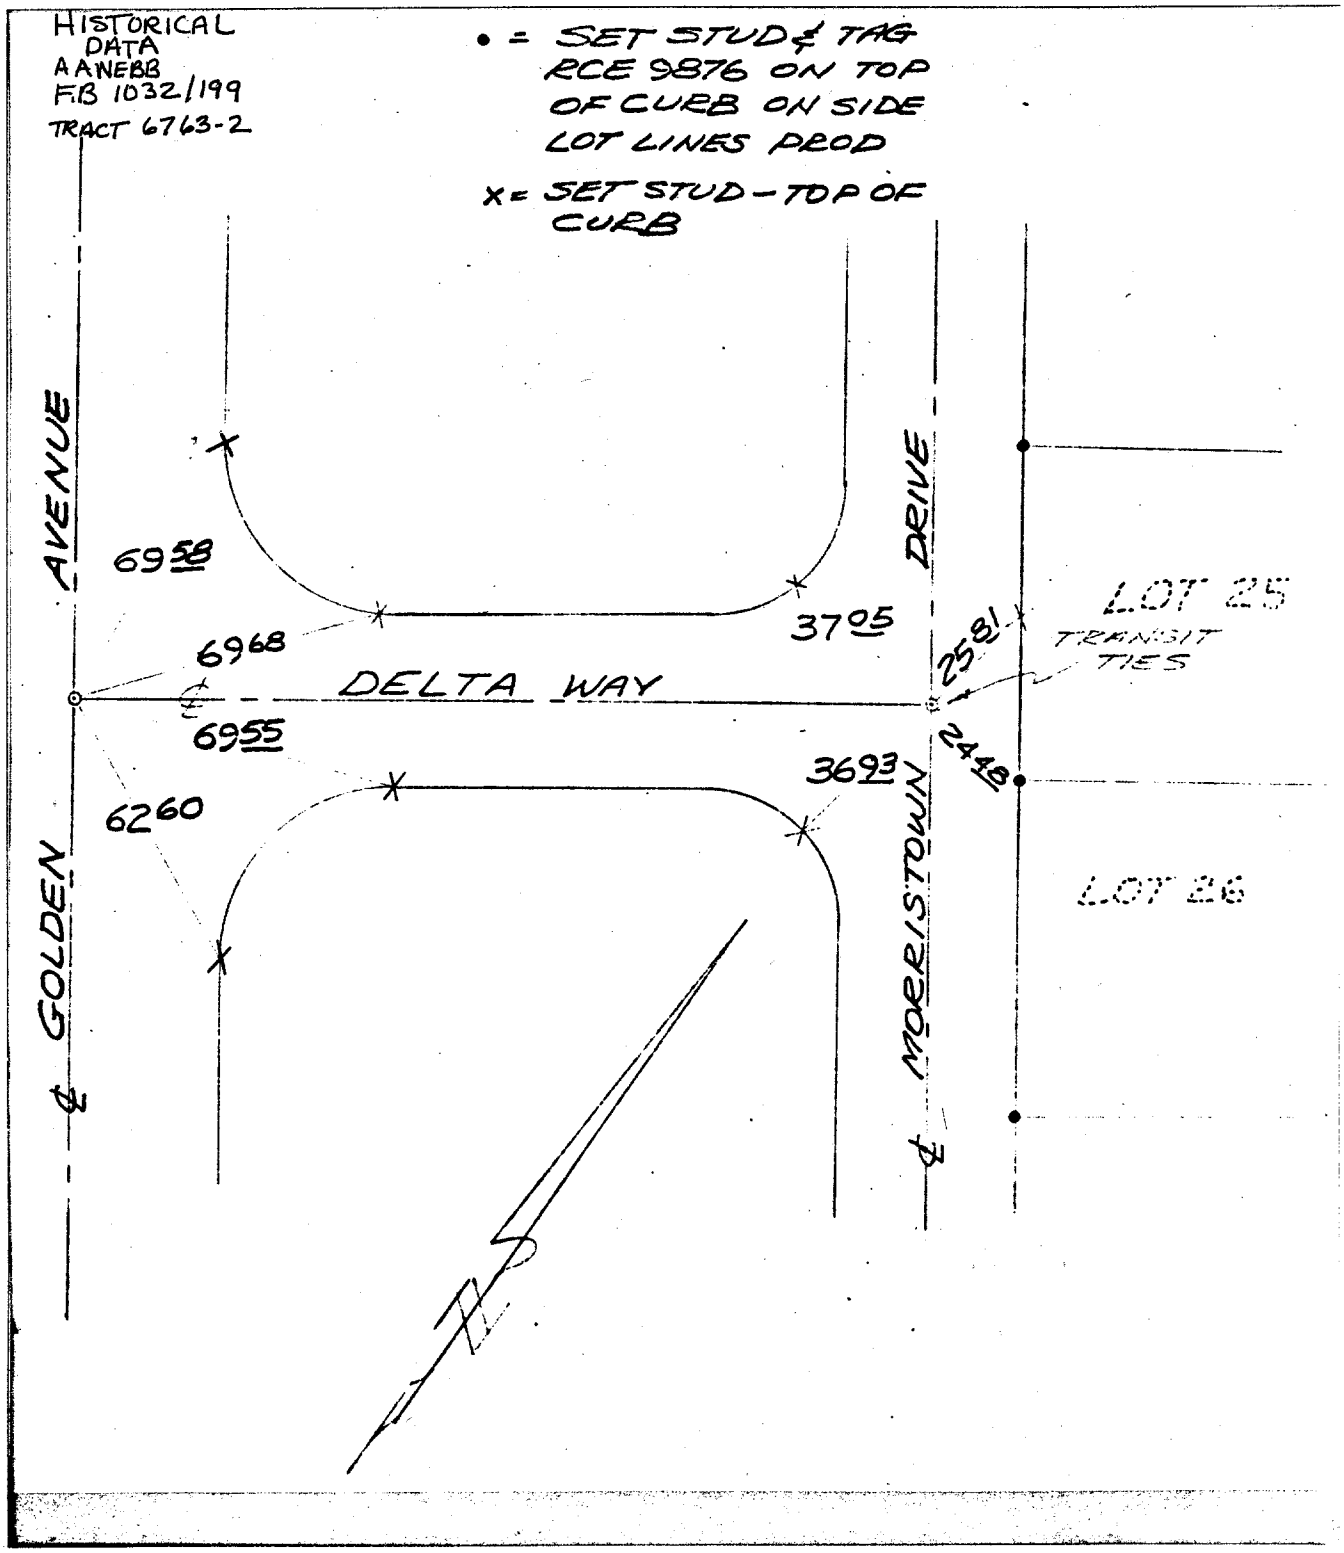

Street: MORRISTOWN DR

X-Street: DELTA WAY

Scale: ~~1" = 0'~~	**OFFICIAL TIE PLAT** **CITY OF RIVERSIDE**	
Date: 0~~1/27/00~~		
Drawn by: survey	*These ties are for the purpose of perpetuating the found monumentation. No claim is made as to the relationship of the points or lines shown hereon to true boundary locations.*	
W.O.:		Sheet 1 of 1
F.B.:		File No.: