5685, T/F

Street: Coolidge Ave X-Street: Mary St

OFFICIAL USE ONLY

TRANSIT TIES

C.R.F.B. 989-50

MARY ST & COOLIDGE AVE

ALLEN

DEC 19, 1975

HISTORICAL DATA

CR F.B. 943-6
~~CR F.B. 575-34~~
~~CR F.B. 595-9~~
~~CR F.B. 741-27~~

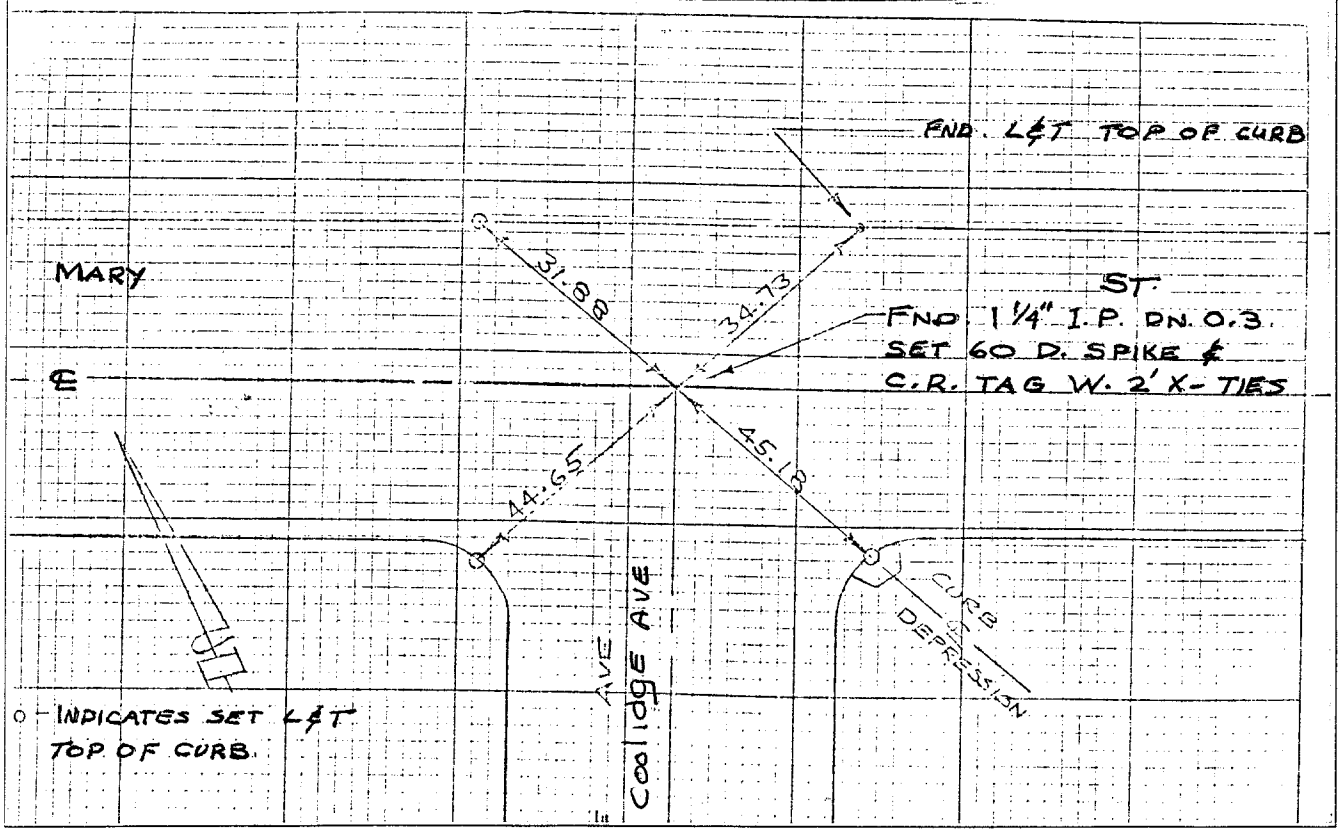

✕ FD. Ramset Nail on T/C
■ FD. "C" Nail on T/C
● FD. LD. & TK. on T/C
○ Set LD. & TK. on T/C

Scale:	**OFFICIAL TIE PLAT** **CITY OF RIVERSIDE**	
Date:		
Drawn by:	*These ties are for the purpose of perpetuating the found monumentation. No claim is made as to the relationship of the points or lines shown hereon to true boundary locations.*	
W.O.:		Sheet 1 of 1
F.B.:		File No.: