TRACT NO. 27919

6S.TIF

STREET ~~HORACE ST.~~ ADAGE WAY X-STREET ~~DULCET PL.~~ APPIAN WAY

OFFICE USE ONLY

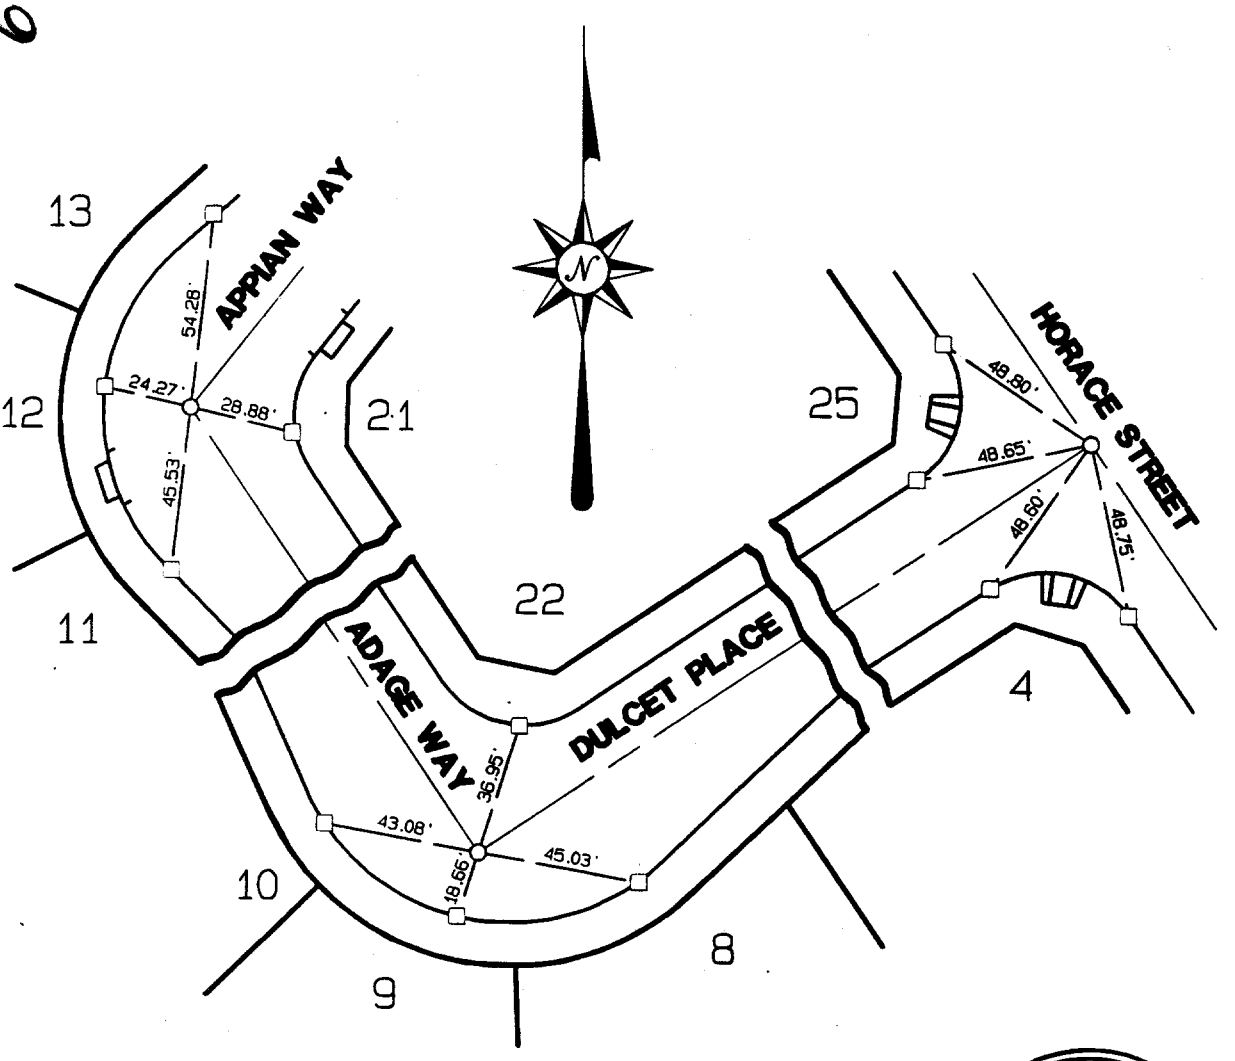

○ *INDICATES SET 1" I.P. TAGGED L.S. 5529, F1.*

□ *INDICATES SET RAMSET & TAG*

LICENSED LAND SURVEYOR
MATTHEW E. WEBB
NO. 5529
EXP. 9-30-00
STATE OF CALIFORNIA

SCALE: 1"=50'	OFFICIAL TIE PLAT CITY OF RIVERSIDE	SHEET 2
DATE: 5/13/98		
DR. BY: AE	PREPARED BY: ALBERT A. WEBB ASSOCIATES ENGINEERING CONSULTANTS 3788 McCRAY ST. RIVERSIDE, CA. 92506	OF 3 SHEETS
W.O.: 96-0076		FILE NO.: 960076.PRO
F.B.:		