662.TIF

Street: 662.TIF BERNARD ST

X-Street: HOFFMAN AVE

OFFICIAL USE ONLY

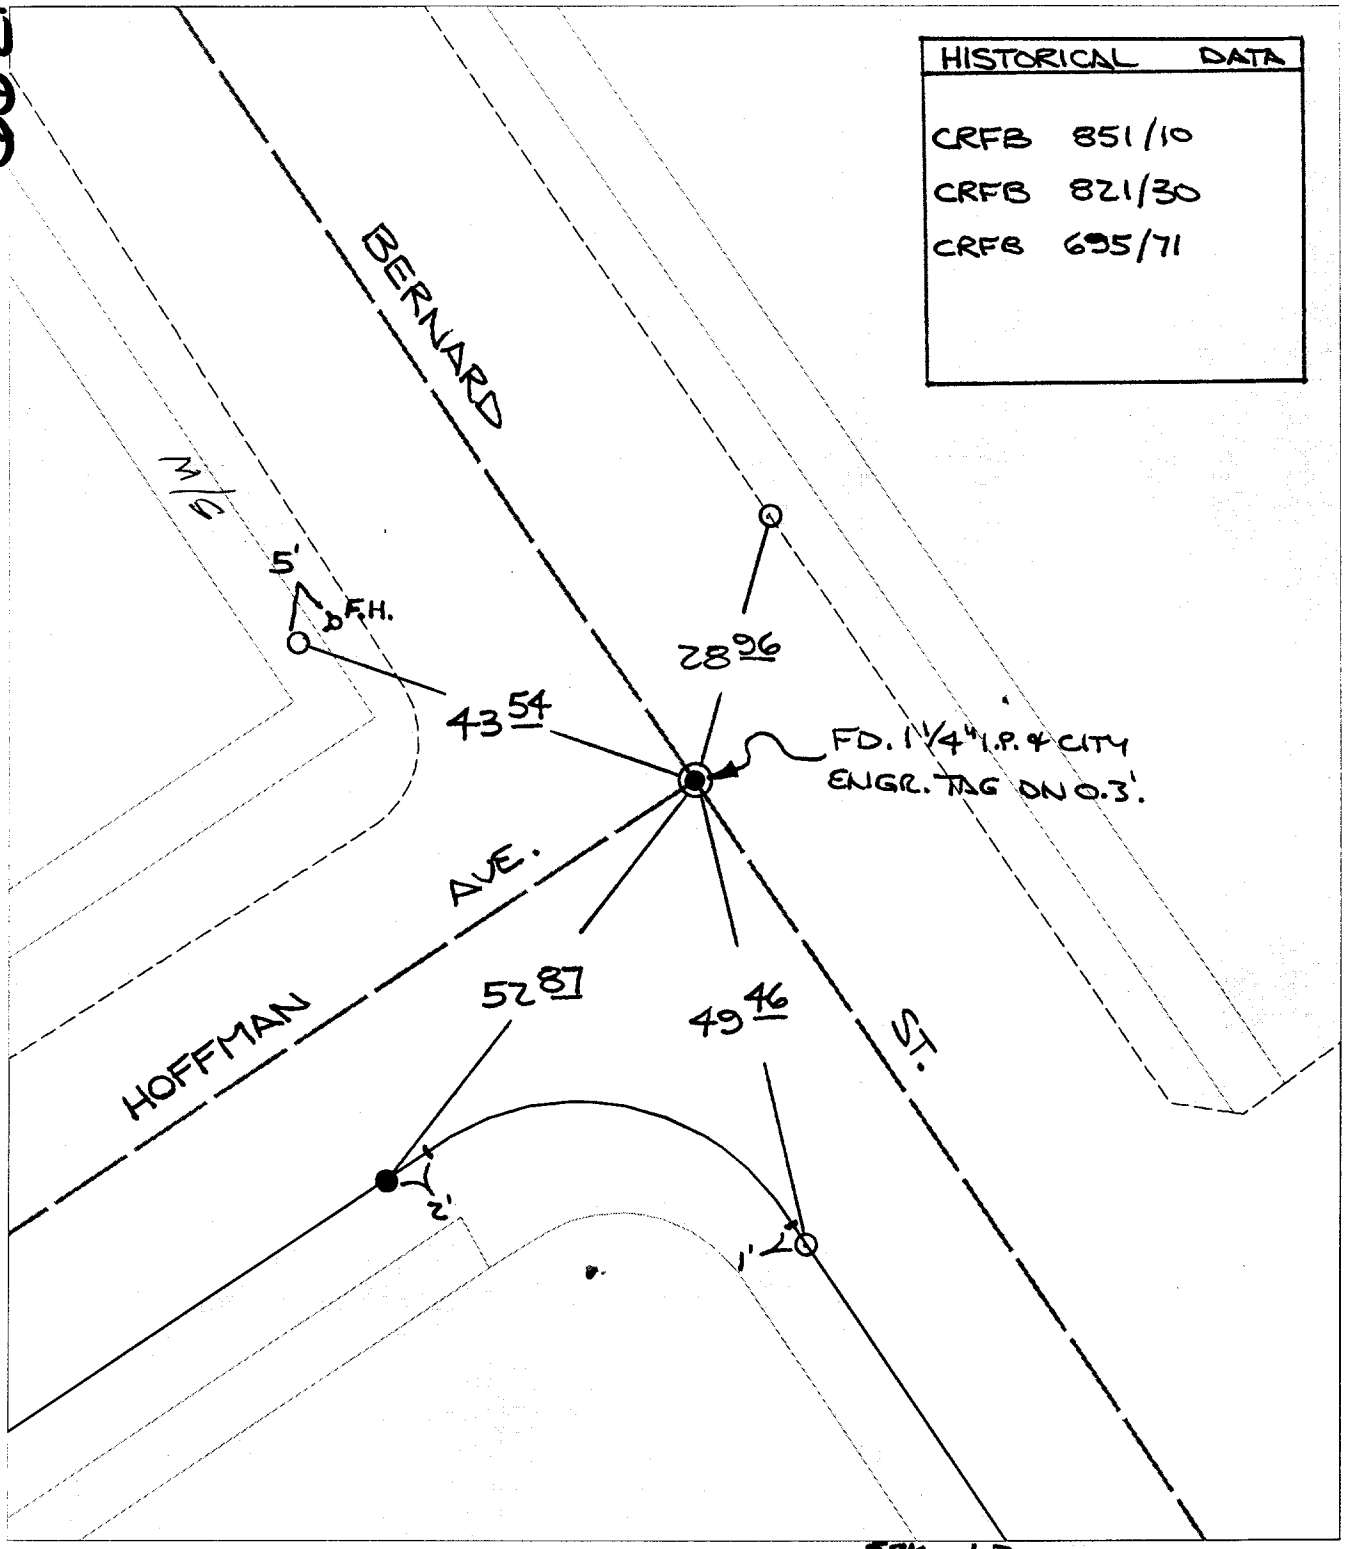

✕ FD. Ramset Nail on T/C

■ FD. "C" Nail on T/C

● FD. ~~LD.~~ SPK. & ~~TK.~~ LD. on T/C

○ Set LD. & TK. on T/C

Scale: 1" = 20'	**OFFICIAL TIE PLAT** CITY OF RIVERSIDE	N W E S
Date: 03/02/99		
Drawn by: scurtis		
W.O.:	*These ties are for the purpose of perpetuating the found monumentation. No claim is made as to the relationship of the points or lines shown hereon to true boundary locations.*	Sheet 1 of 1
F.B.:		File No.: