Street: MARLBOROUGH AVE. X-Street: NORTHGATE ST.
8586. TTF
OFFICIAL USE ONLY

NORTHGATE
~~CALIFORNIA~~ AVENUE (HIGH GROVE)
AT
~~MARLBOUGH~~ AVENUE.
MARLBOROUGH

HISTORICAL DATA
RECORD OF SURVEY 38/7
CITY FB N-23
RIV CNTY ~~FB 980/60~~

SWING TIES

CREW
6/21/68
GRANDINETTE
FRYC
C.F.B. 851/47

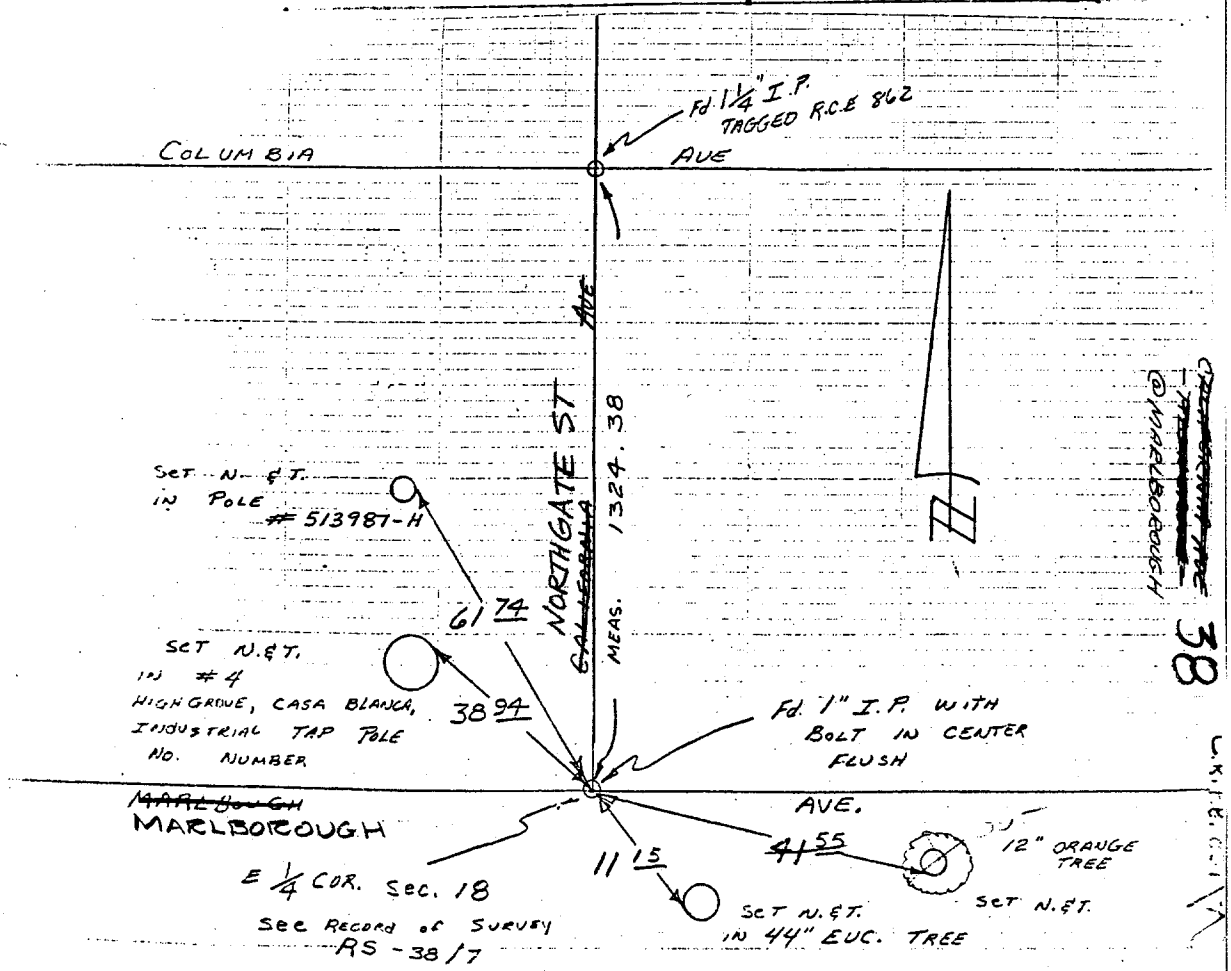

✕ FD. Ramset Nail on T/C
■ FD. "C" Nail on T/C
● FD. LD. & TK. on T/C
○ Set LD. & TK. on T/C

Scale:	**OFFICIAL TIE PLAT** **CITY OF RIVERSIDE**	
Date:		
Drawn by:	*These ties are for the purpose of perpetuating the found monumentation. No claim is made as to the relationship of the points or lines shown hereon to true boundary locations.*	
W.O.:		Sheet 1 of 1
F.B.:		File No.: