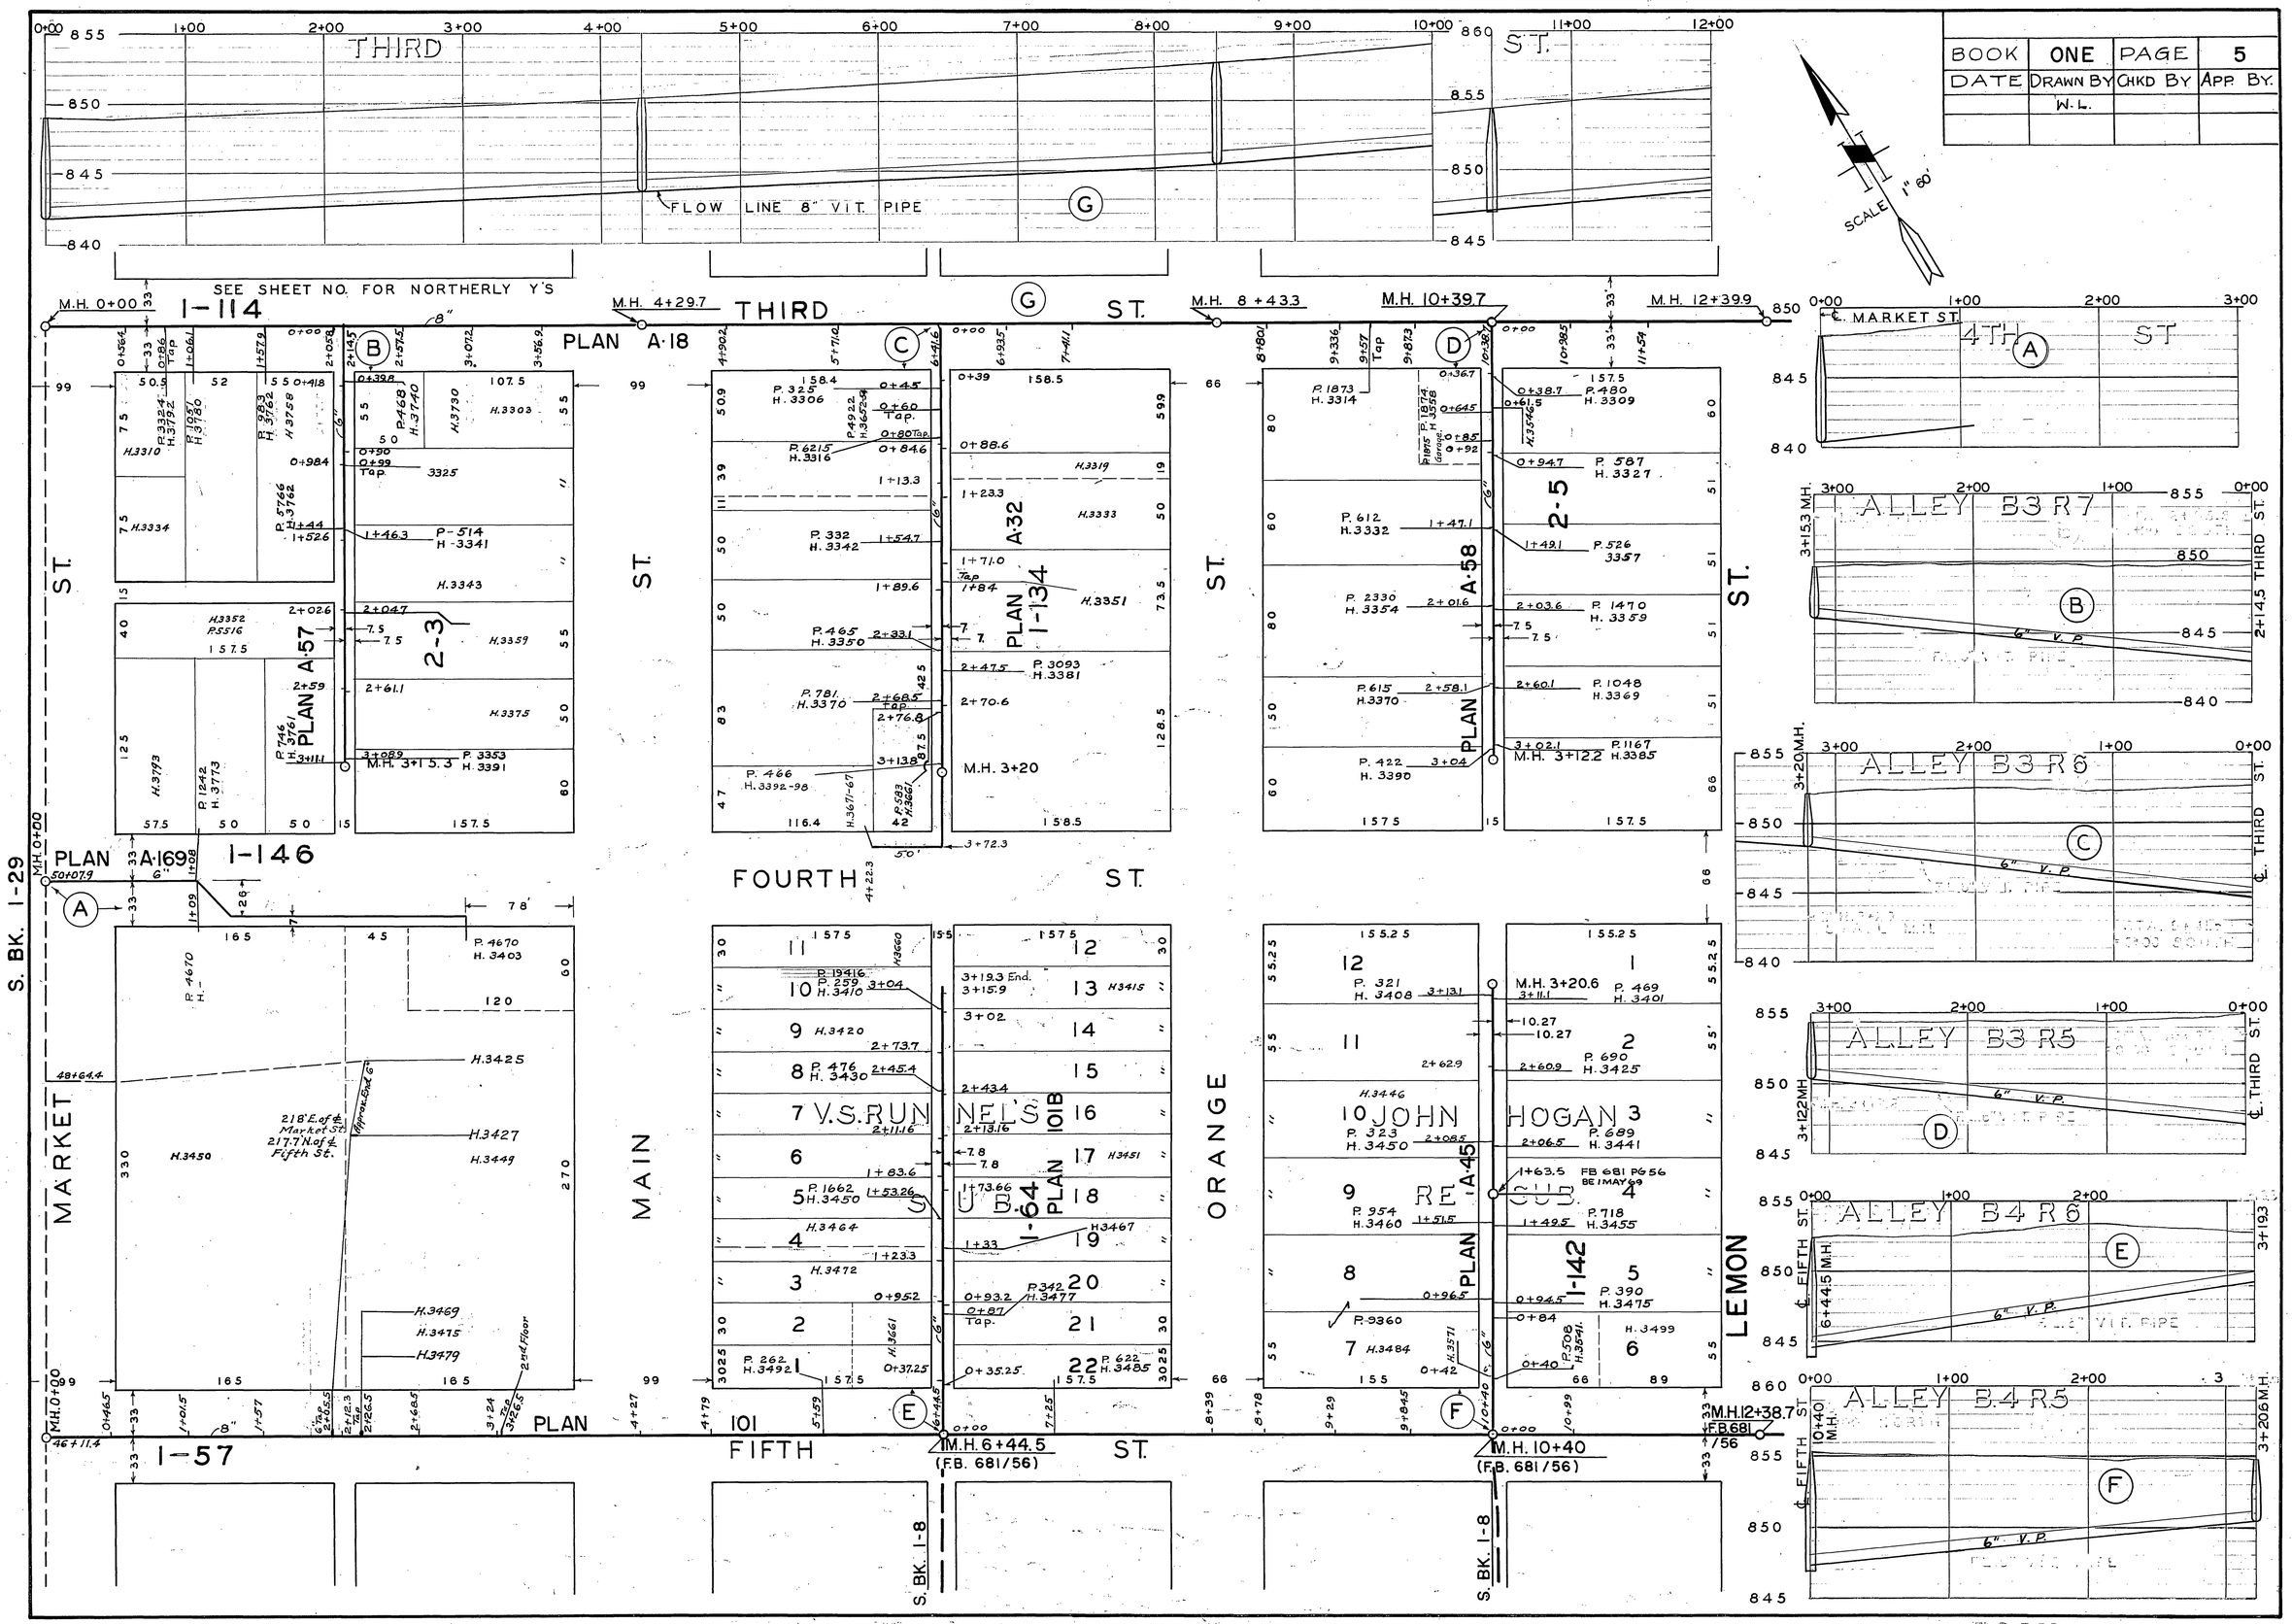BOOK	ONE	PAGE	5
DATE	DRAWN BY	CHKD BY	APP. BY.
	W. L.