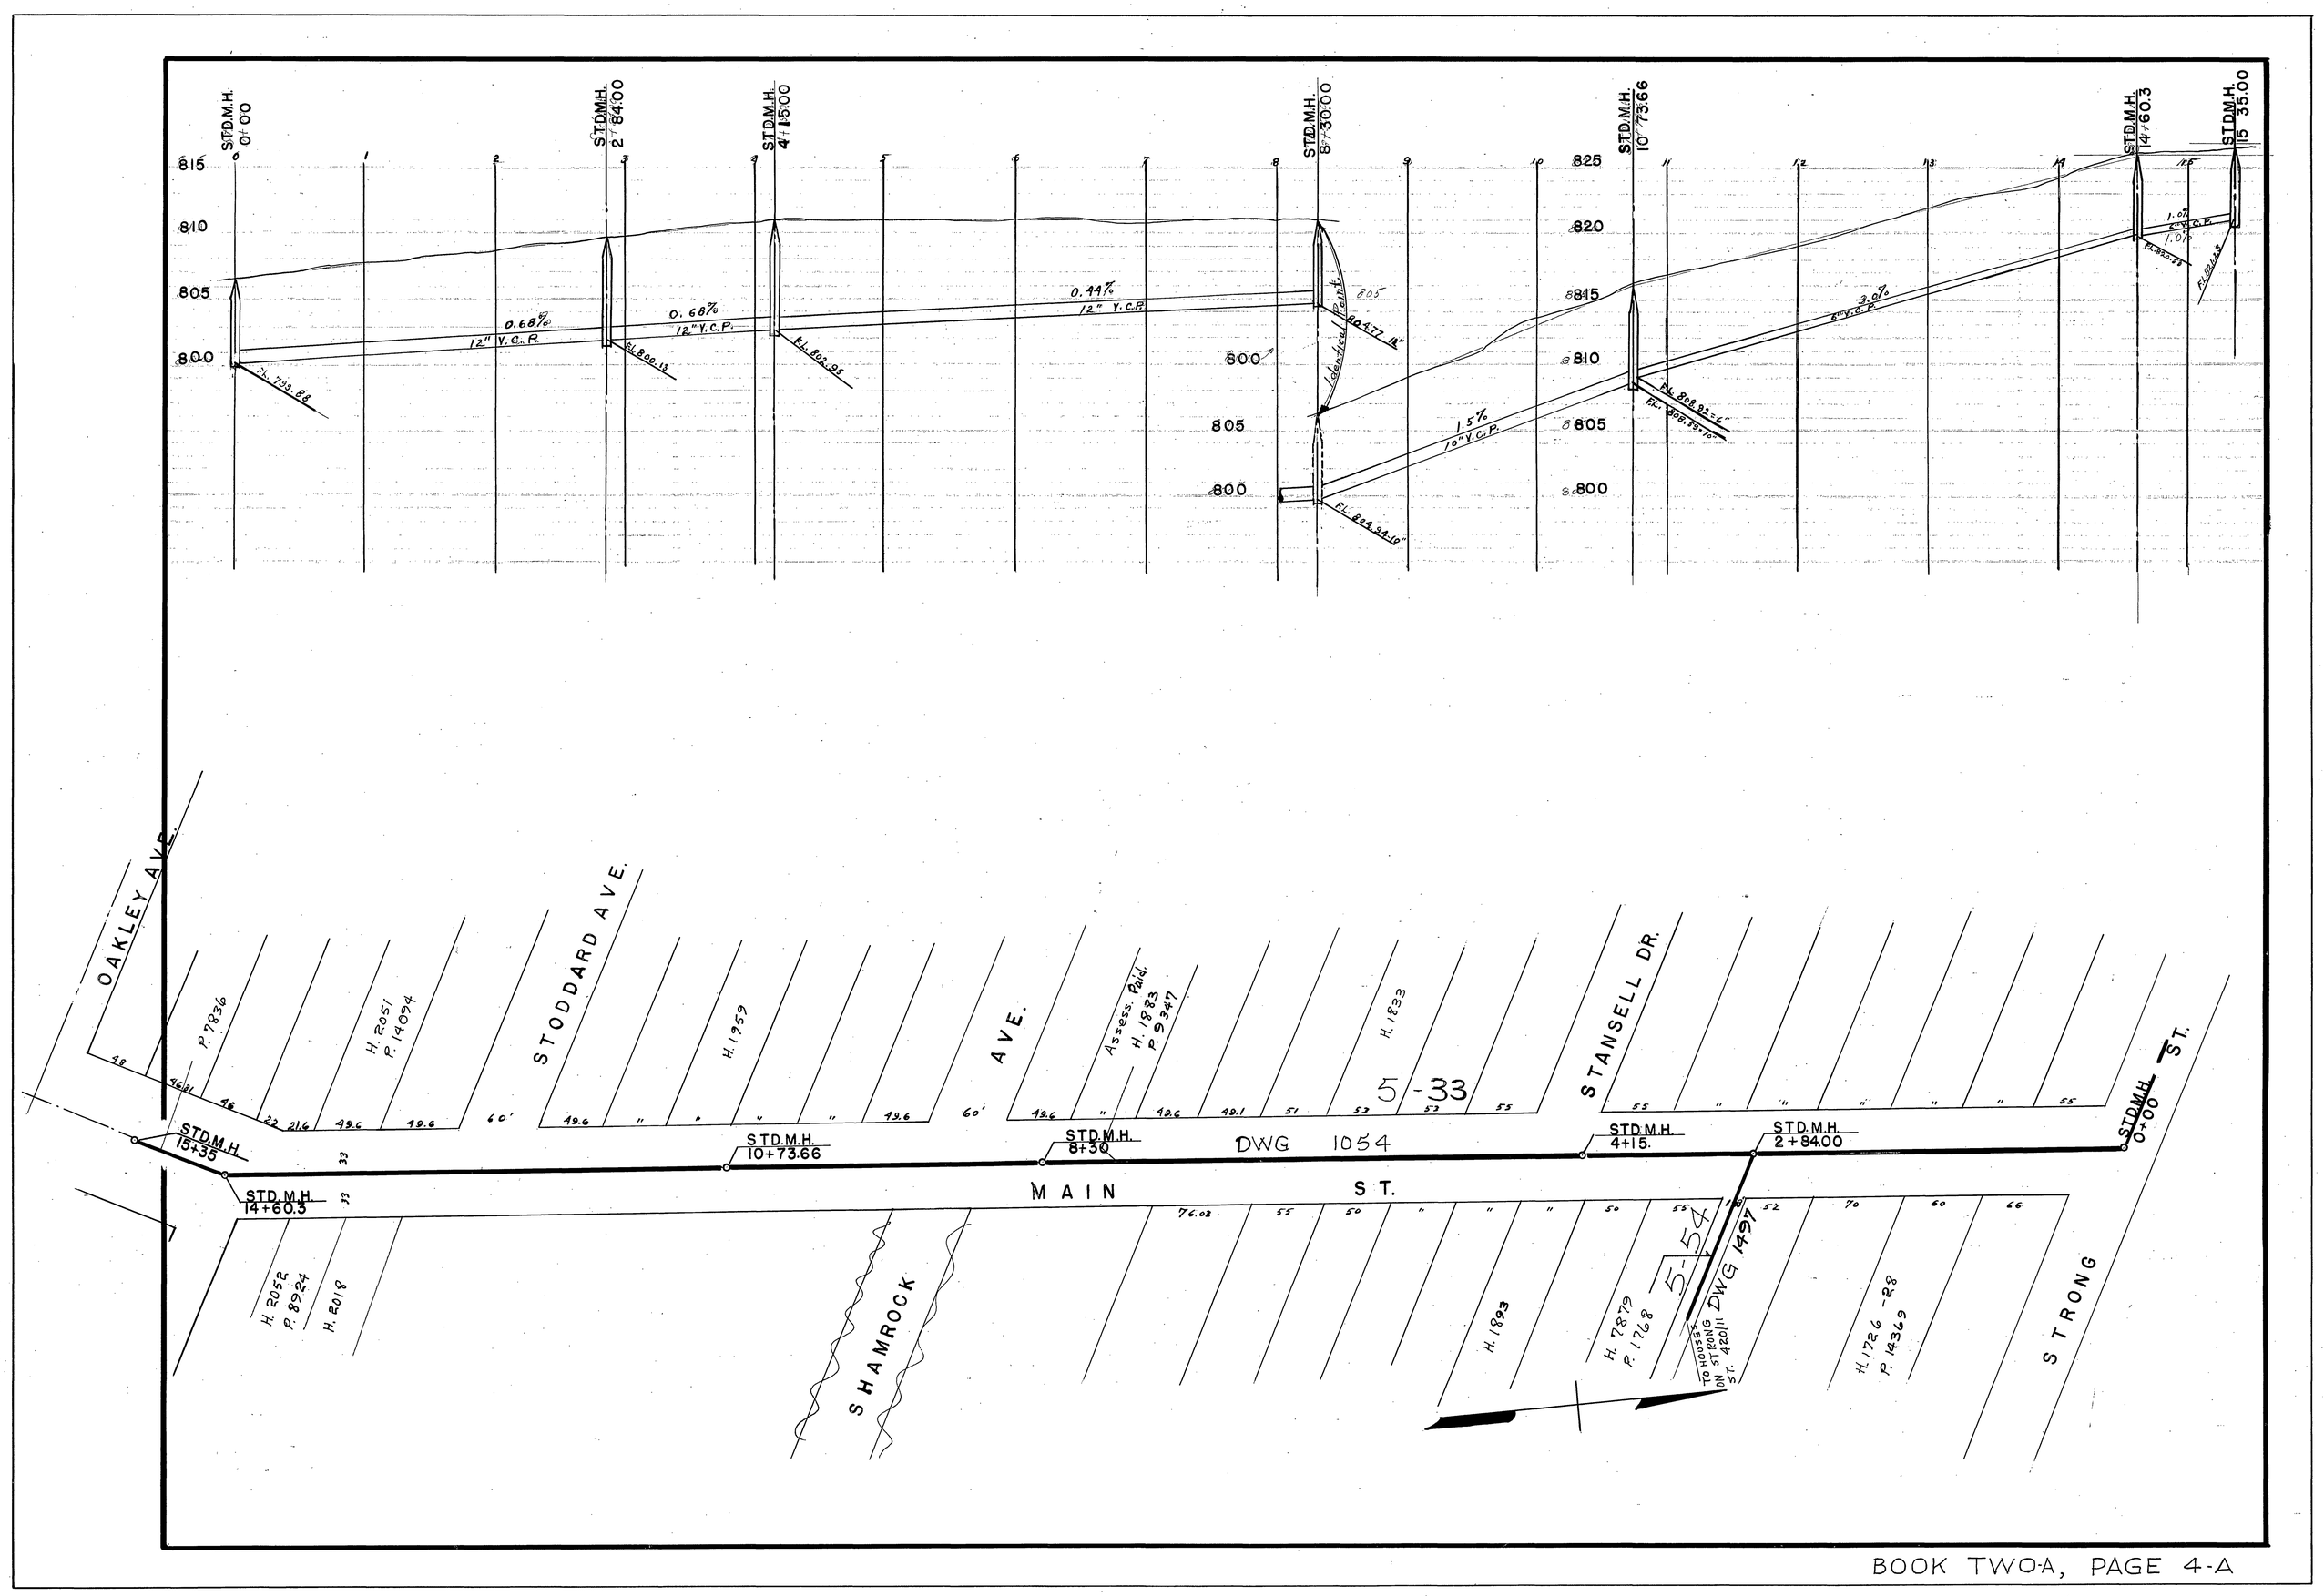

STD.M.H. 0+00
STD.M.H. 2+84.00
STD.M.H. 4+15.00
STD.M.H. 8+30.00
STD.M.H. 10+73.66
STD.M.H. 14+60.3
STD.M.H. 15+35.00
0.68%
12" V.C.P.
0.44%
12" V.C.P.
1.5%
10" V.C.P.
3.0%
6" V.C.P.
Identical Point
OAKLEY AVE.
STODDARD AVE.
AVE.
STANSELL DR.
STRONG ST.
MAIN ST.
SHAMROCK
DWG 1054
DWG 1497
5-33
5-54
STD.M.H. 15+35
STD.M.H. 14+60.3
STD.M.H. 10+73.66
STD.M.H. 8+30
STD.M.H. 4+15.
STD.M.H. 2+84.00
STD.M.H. 0+00