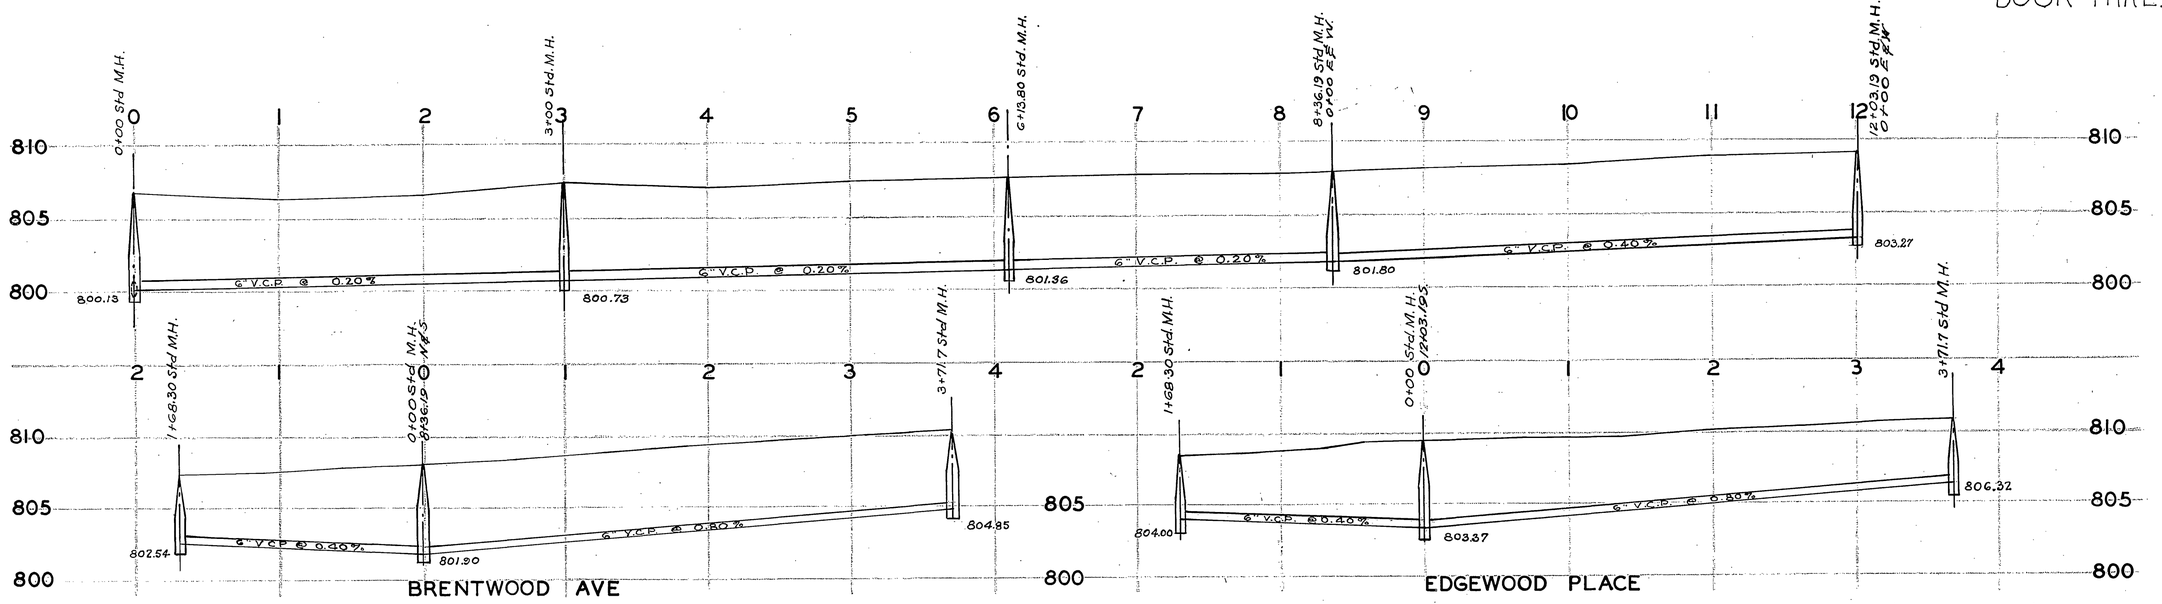
0+00 Std. M.H.
3+00 Std. M.H.
6+13.80 Std. M.H.
8+36.19 Std. M.H. 0+00 E & W
12+03.19 Std. M.H. 0+00 E & W
6" V.C.P. @ 0.20%
6" V.C.P. @ 0.20%
6" V.C.P. @ 0.40%
800.13
800.73
801.36
801.80
803.27
1+68.30 Std. M.H.
0+00 Std. M.H. 8+36.19 N & S
3+71.7 Std. M.H.
6" V.C.P. @ 0.40%
6" V.C.P. @ 0.80%
802.54
801.90
804.85
BRENTWOOD AVE
1+68.30 Std. M.H.
0+00 Std. M.H. 12+03.19 S
3+71.7 Std. M.H.
6" V.C.P. @ 0.40%
6" V.C.P. @ 0.80%
804.00
803.37
806.32
EDGEWOOD PLACE

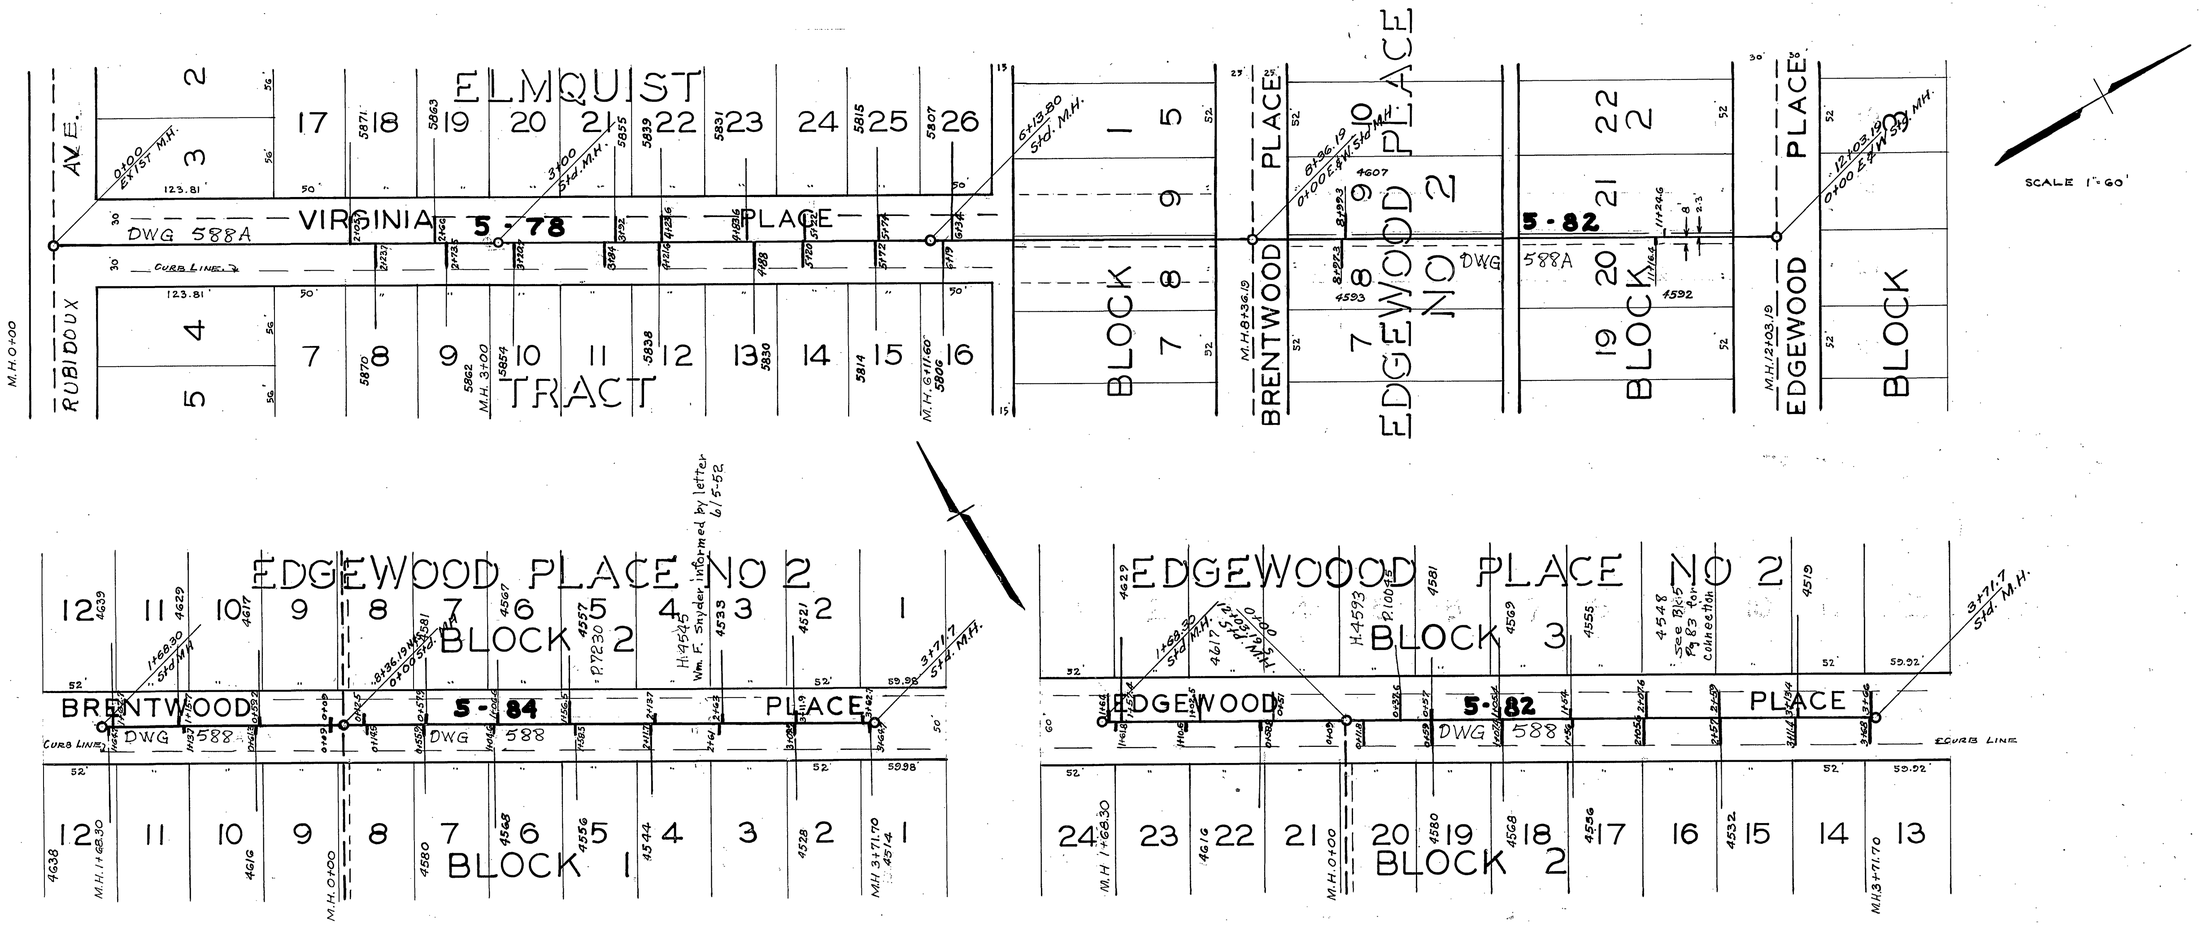
ELMQUIST
VIRGINIA PLACE
5-78
DWG 588A
CURB LINE
RUBIDOUX AVE.
TRACT
BLOCK 7
BRENTWOOD PLACE
EDGEWOOD PLACE NO 2
5-82
DWG 588A
BLOCK 20
EDGEWOOD PLACE
BLOCK
SCALE 1" = 60'
EDGEWOOD PLACE NO 2
BLOCK 2
BRENTWOOD PLACE
5-84
DWG 588
BLOCK 1
EDGEWOOD PLACE NO 2
BLOCK 3
EDGEWOOD PLACE
5-82
DWG 588
BLOCK 2
Wm. F. Snyder informed by letter 6/5-52
See Bk 5 Pg 83 for Connection