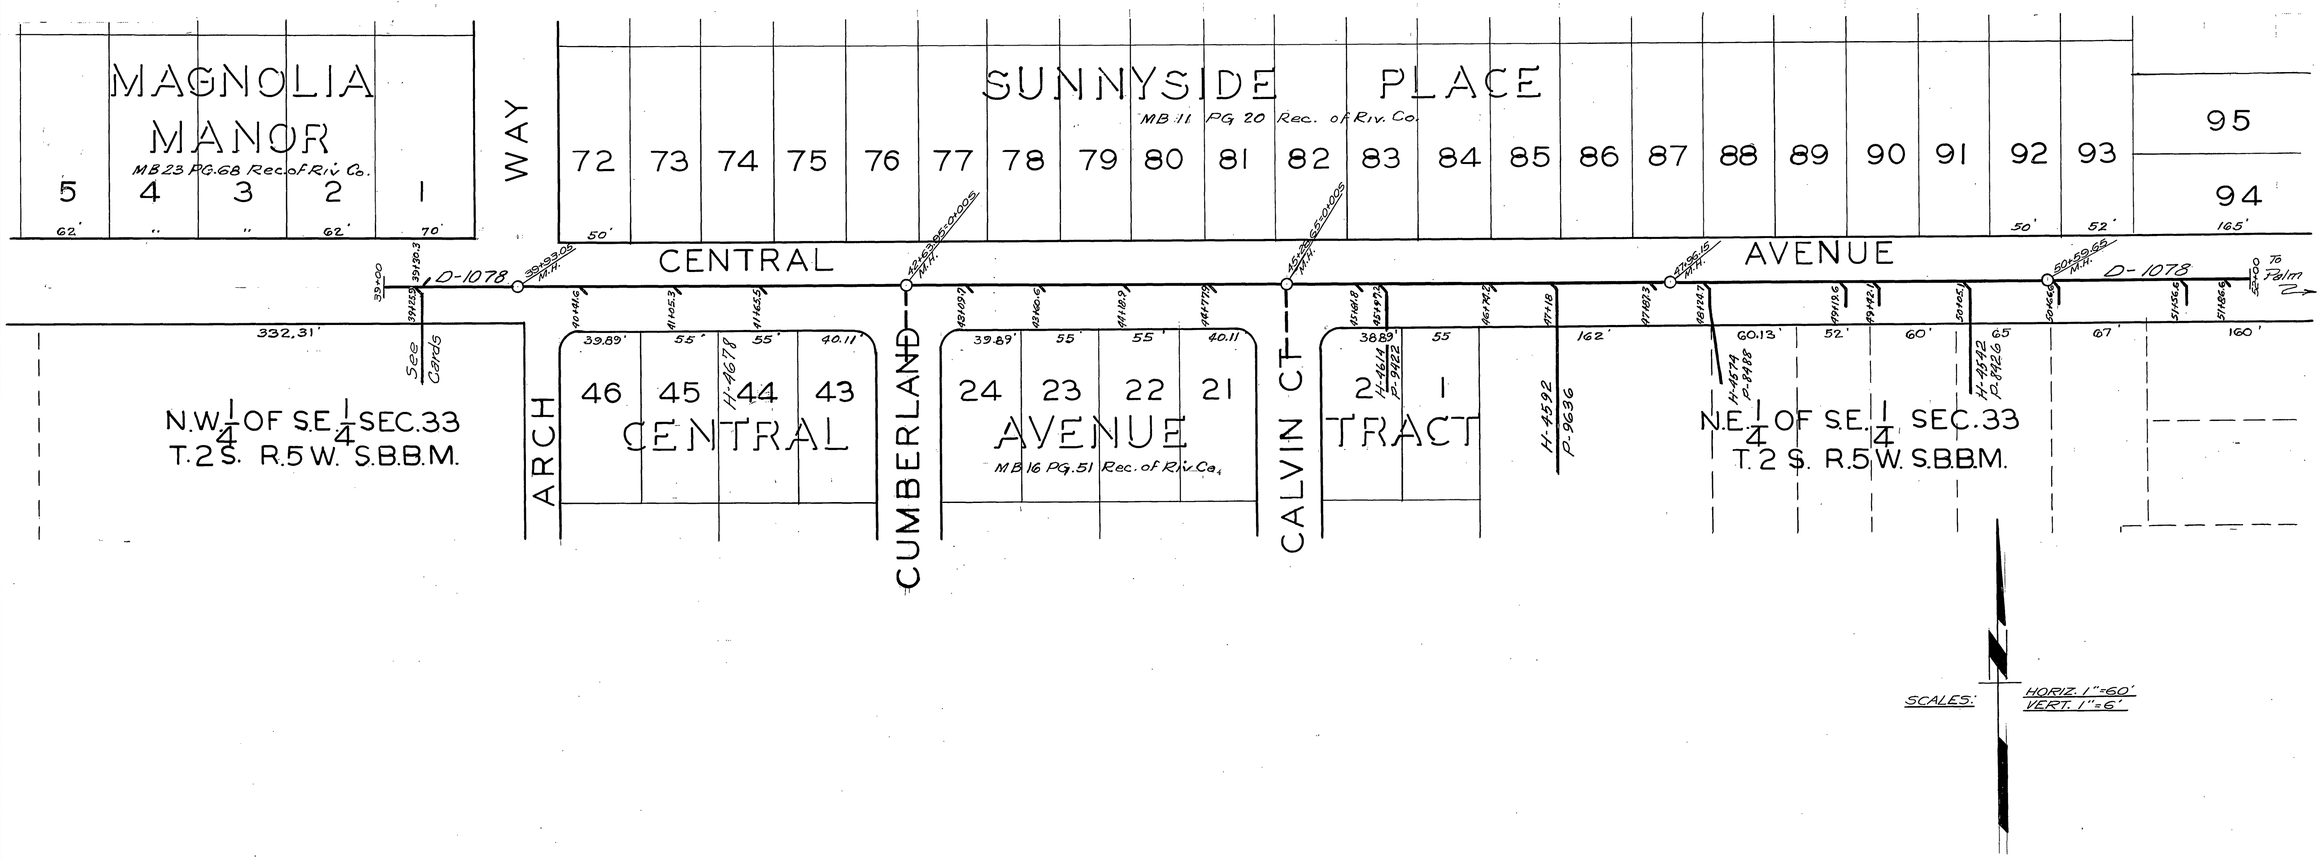
MAGNOLIA MANOR
MB 23 PG. 68 Rec. of Riv. Co.
5 4 3 2 1
62' " " 62' 70'
WAY
SUNNYSIDE PLACE
MB 11 PG. 20 Rec. of Riv. Co.
72 73 74 75 76 77 78 79 80 81 82 83 84 85 86 87 88 89 90 91 92 93
95
94
50' 52' 165'
CENTRAL AVENUE
D-1078
To Palm
332.31'
See Cards
N.W. 1/4 OF S.E. 1/4 SEC. 33
T. 2 S. R. 5 W. S.B.B.M.
ARCH
46 45 44 43
H-4678
CENTRAL
CUMBERLAND
24 23 22 21
AVENUE
MB 16 PG. 51 Rec. of Riv. Co.
CALVIN CT
2 1
TRACT
H-4614 P-9422
H-4592 P-9636
H-4674 P-8488
H-4542 P-8426
N.E. 1/4 OF S.E. 1/4 SEC. 33
T. 2 S. R. 5 W. S.B.B.M.
SCALES: HORIZ. 1"=60' VERT. 1"=6'