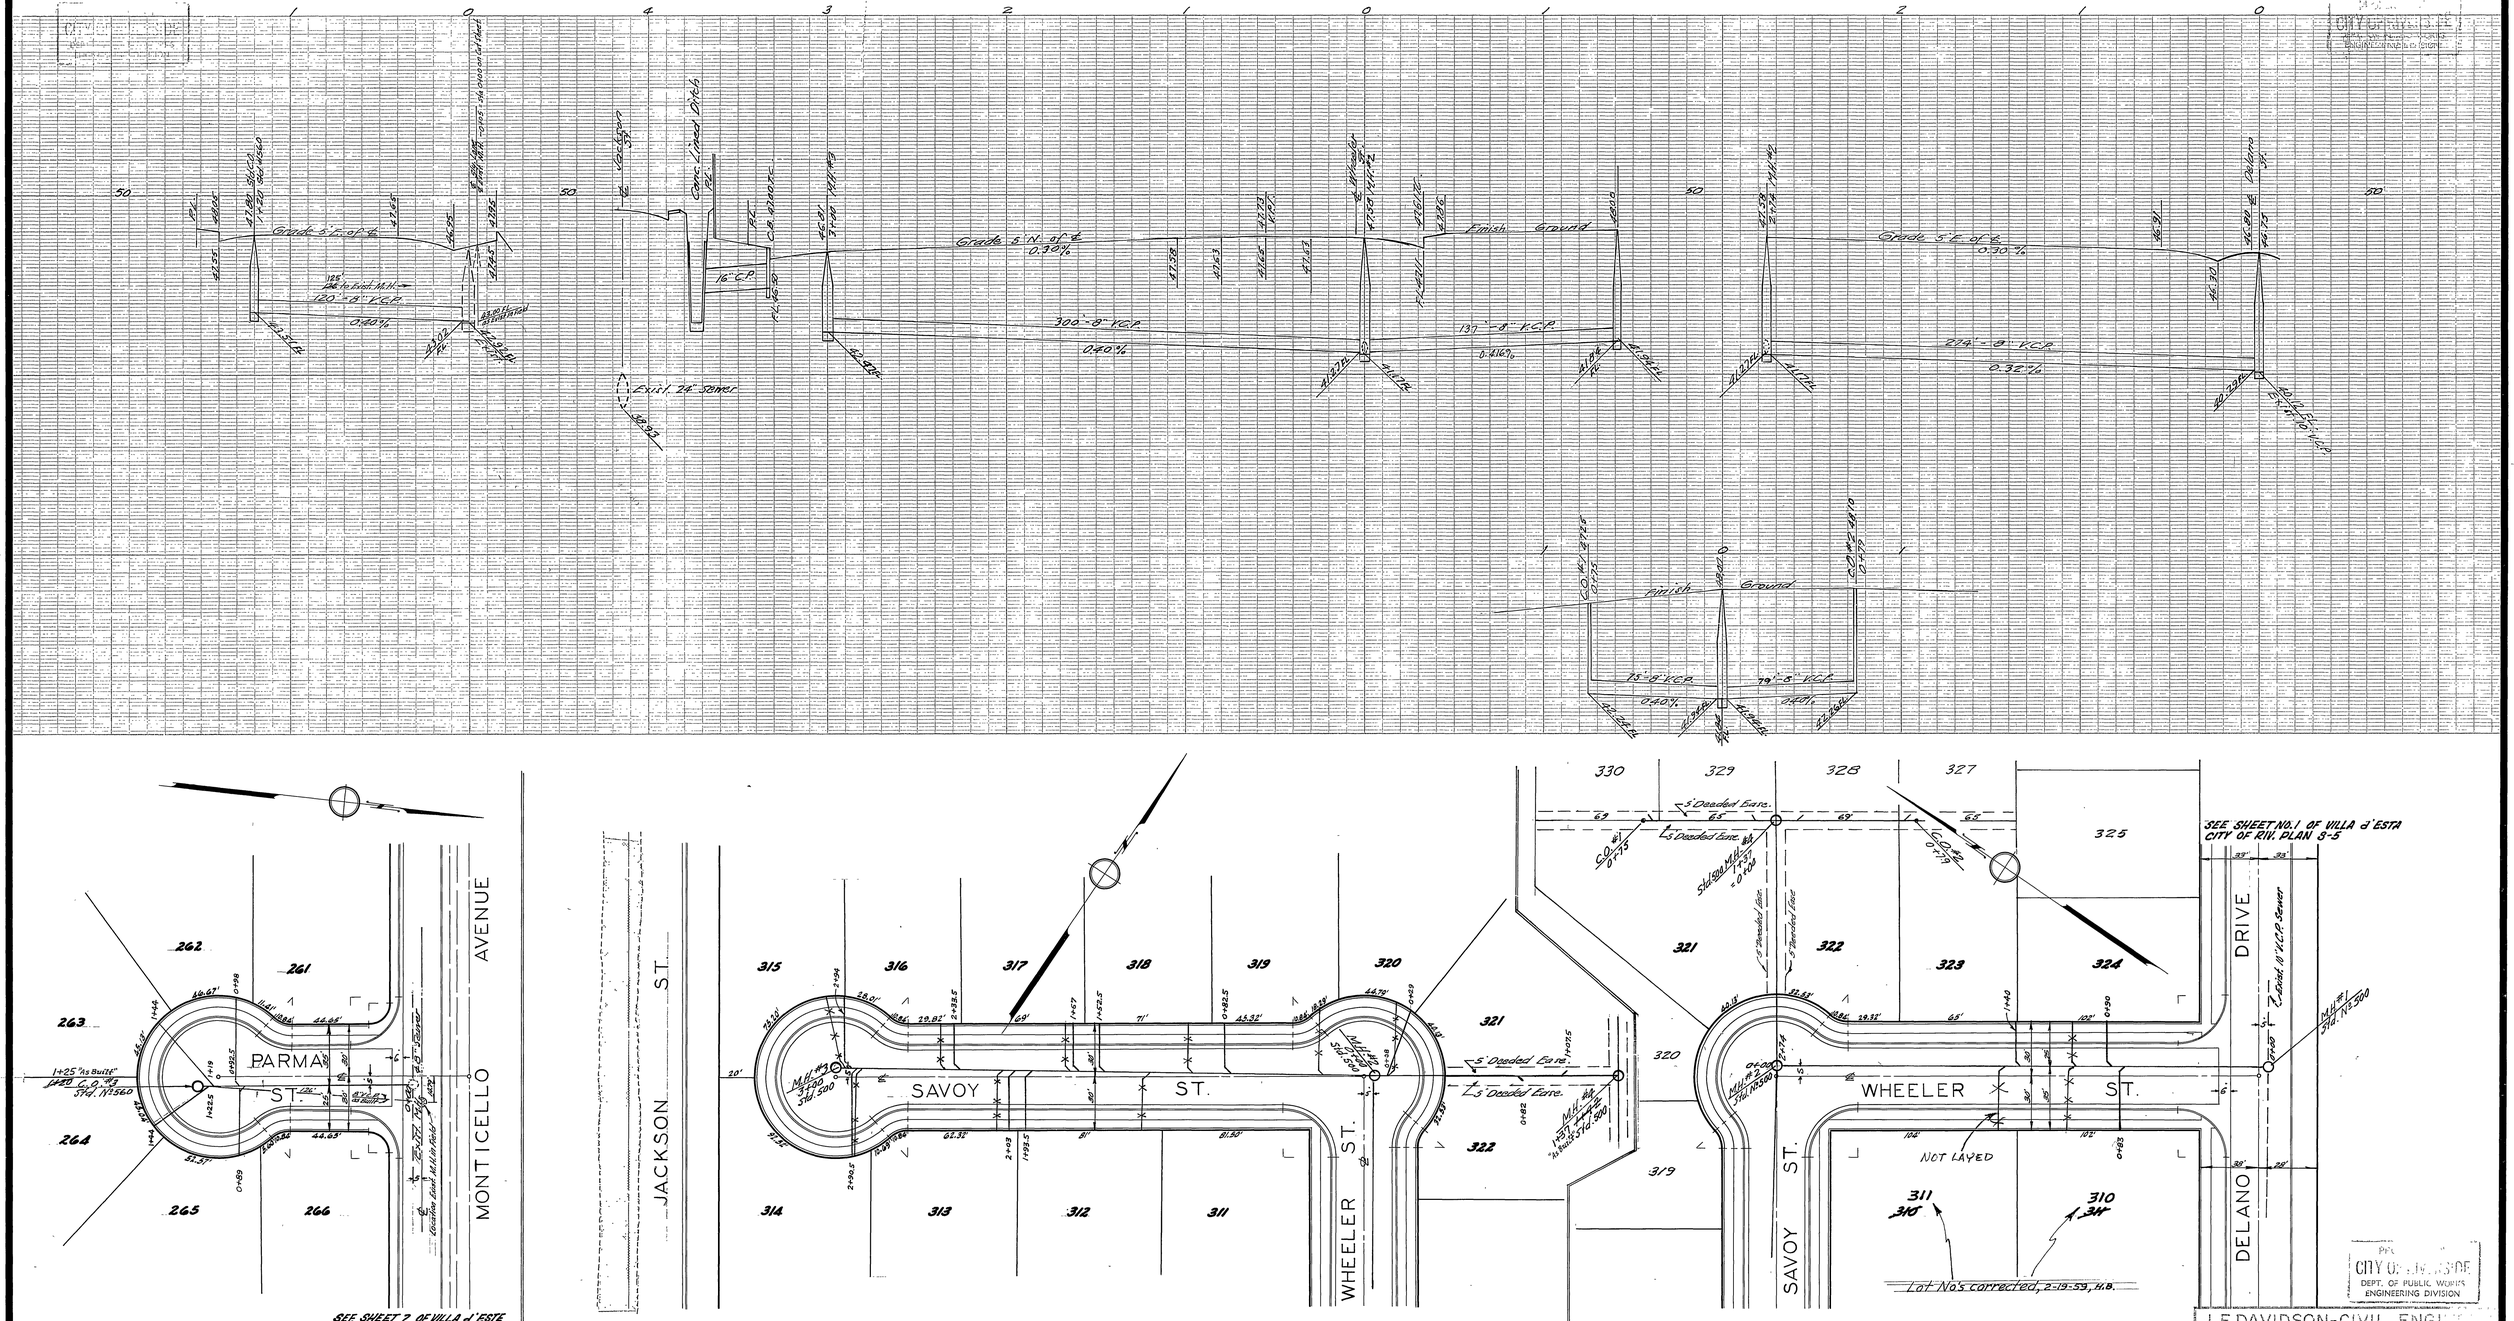
PARMA ST.
MONTICELLO AVENUE
JACKSON ST.
SAVOY ST.
WHEELER ST.
DELANO DRIVE
Grade 5'N. of ℄ 0.30%
Grade 5'E. of ℄ 0.30 %
Finish Ground
300'-8" V.C.P. 0.40%
137'-8" V.C.P. 0.416%
224'-8" V.C.P. 0.32%
75'-8" V.C.P. 0.40%
79'-8" V.C.P. 0.40%
16" C.P.
Exist. 24" Sewer
Exist. 10" V.C.P. Sewer
