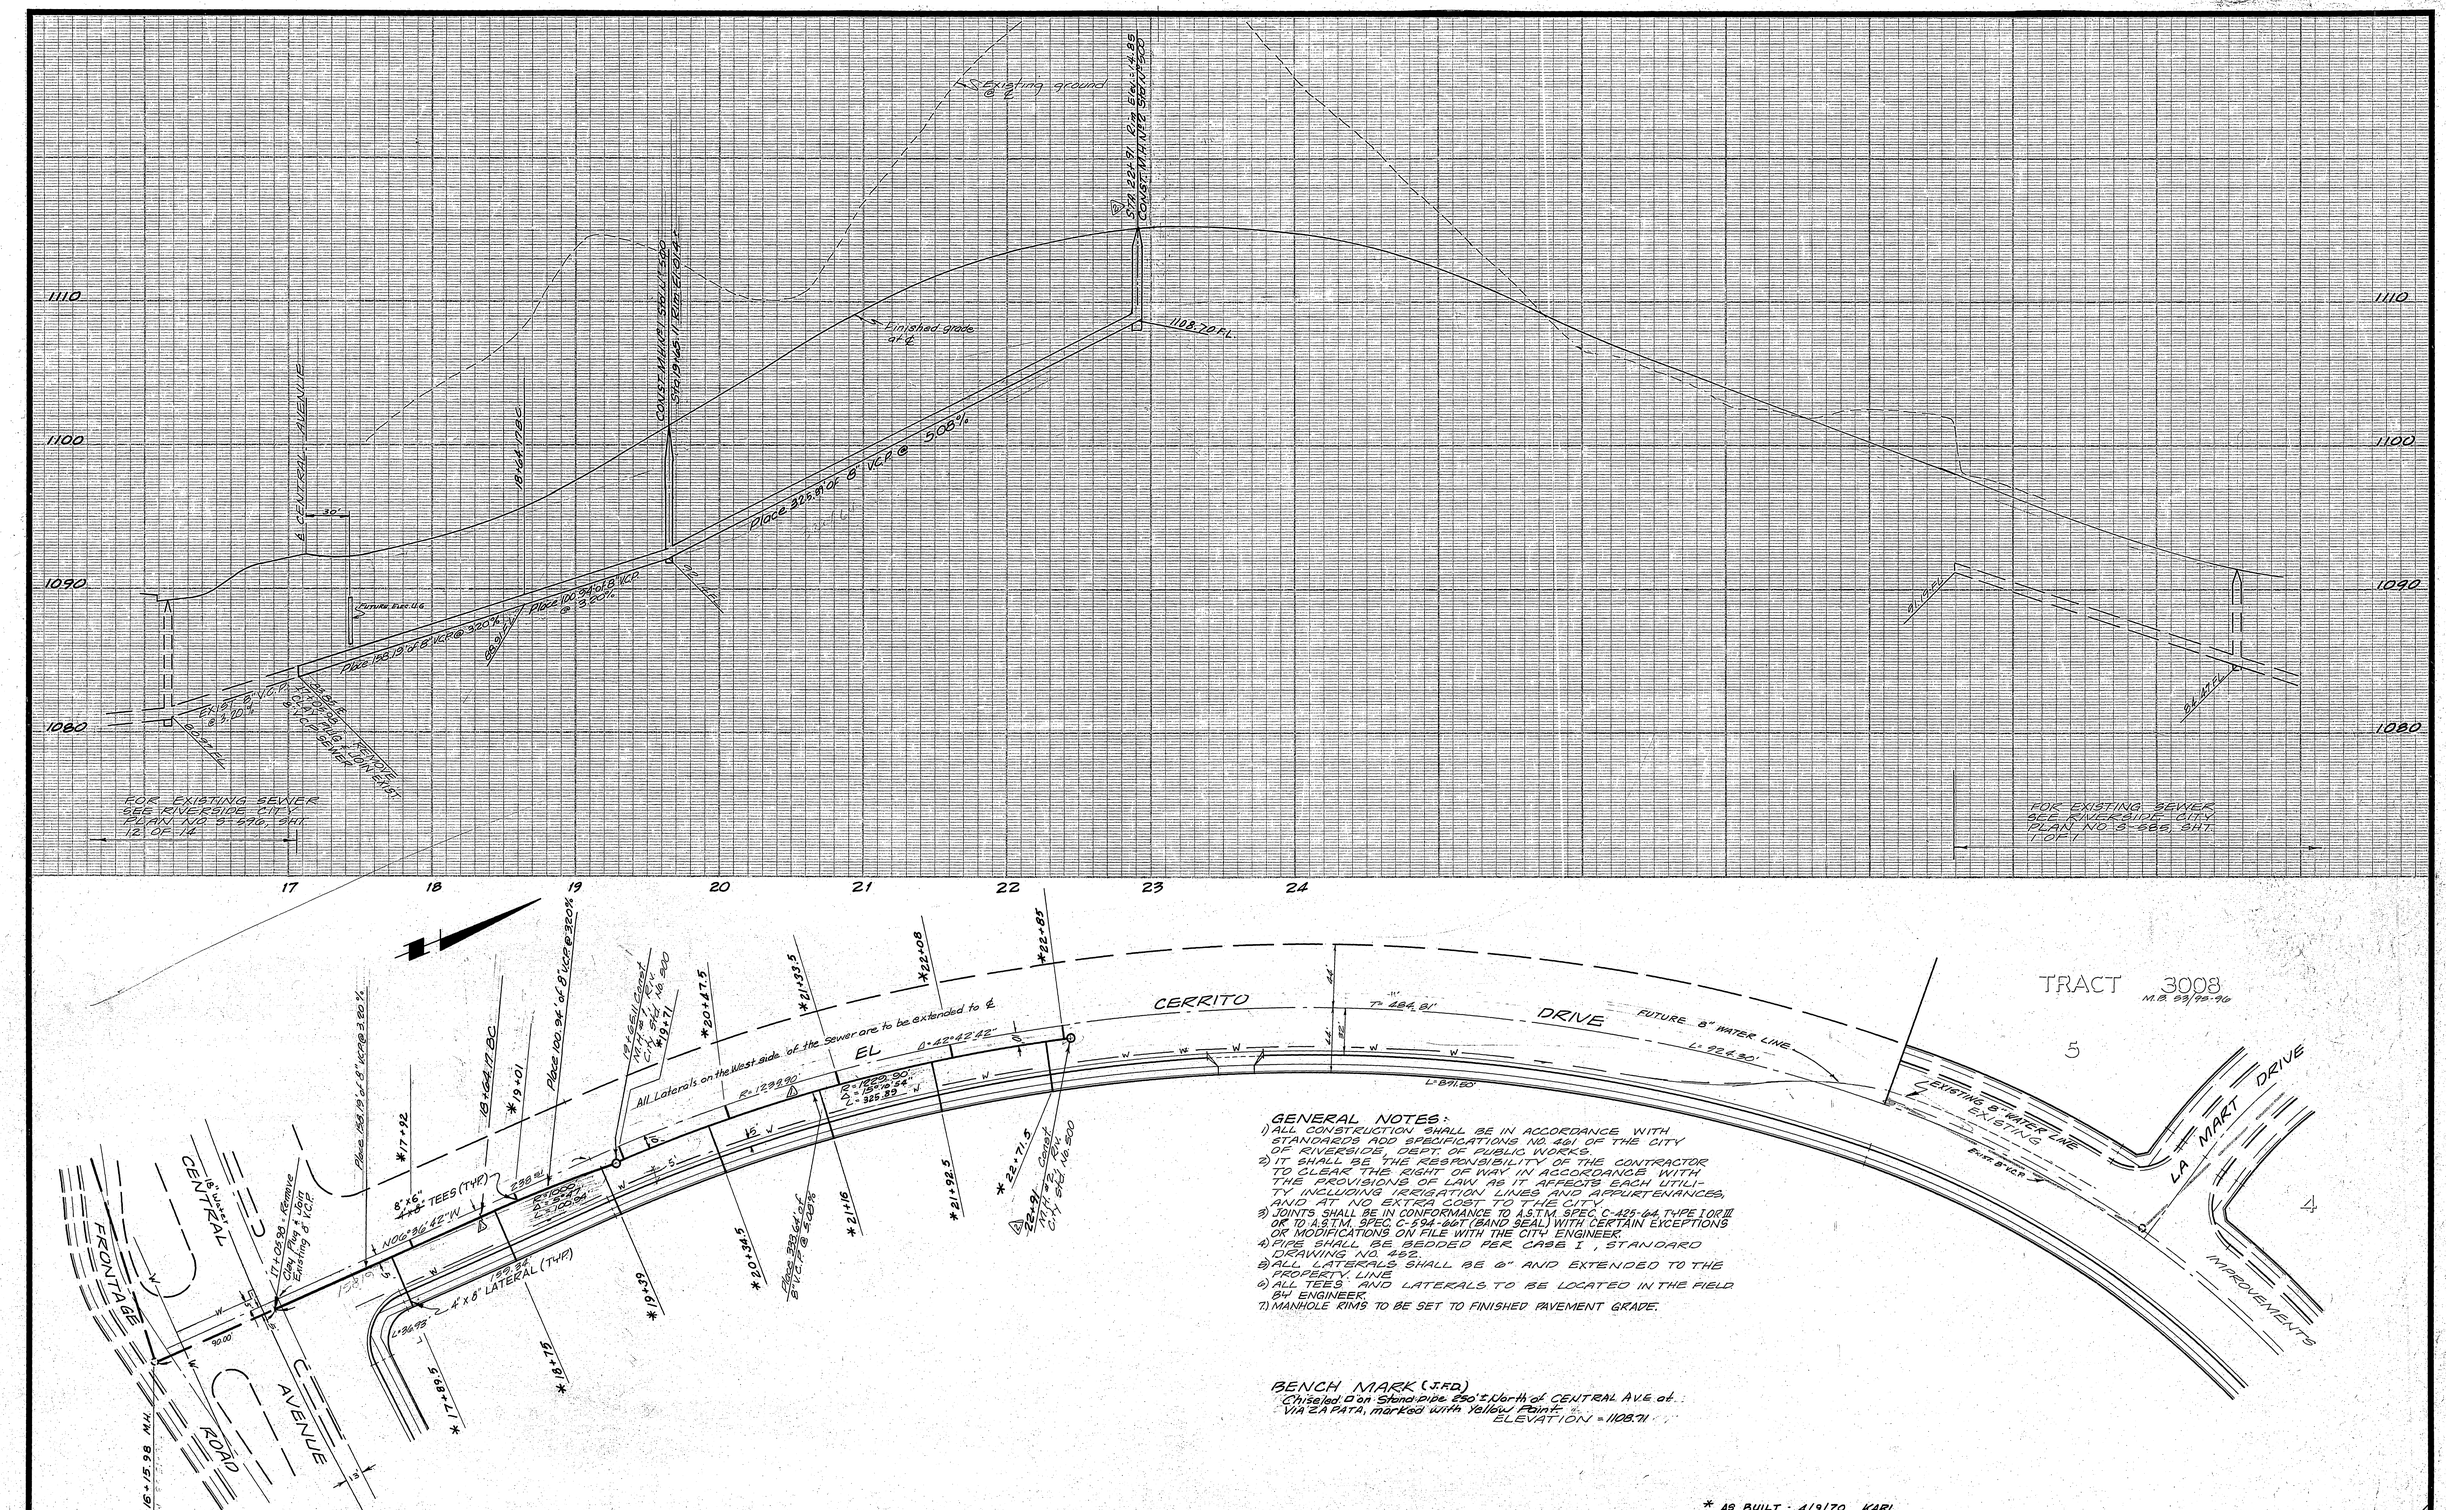

GENERAL NOTES:

1) ALL CONSTRUCTION SHALL BE IN ACCORDANCE WITH STANDARDS AND SPECIFICATIONS NO. 461 OF THE CITY OF RIVERSIDE, DEPT. OF PUBLIC WORKS.
2) IT SHALL BE THE RESPONSIBILITY OF THE CONTRACTOR TO CLEAR THE RIGHT OF WAY IN ACCORDANCE WITH THE REVISIONS OF LAW AS IT AFFECTS EACH UTILITY INCLUDING IRRIGATION LINES AND APPURTENANCES, AND AT NO EXTRA COST TO THE CITY.
3) JOINTS SHALL BE IN CONFORMANCE TO A.S.T.M. SPEC. C-425-64 TYPE I OR III OR TO A.S.T.M. SPEC. C-594-64T (BAND SEAL) WITH CERTAIN EXCEPTIONS OR MODIFICATIONS ON FILE WITH THE CITY ENGINEER.
4) PIPE SHALL BE BEDDED PER CASE I, STANDARD DRAWING NO. 452.
5) ALL LATERALS SHALL BE 6" AND EXTENDED TO THE PROPERTY LINE
6) ALL TEES AND LATERALS TO BE LOCATED IN THE FIELD BY ENGINEER.
7) MANHOLE RIMS TO BE SET TO FINISHED PAVEMENT GRADE.

BENCH MARK (J.R.D.)
Chiseled "D" on Standpipe 850'± North of CENTRAL AVE. at Via ZAPATA, marked with Yellow Paint.
ELEVATION = 1108.71

* AS BUILT - 4/9/70 KARL

APPROVED BY WATER DIVISION
Harold L. Cleaver 5-14-69
CHIEF UTILITIES ENGINEER DATE:

J. F. DAVIDSON ASSOCIATES
CIVIL ENGINEERS - SURVEYORS - PLANNERS
RIVERSIDE, CALIFORNIA
APPROVED BY [signature] DATE 5-1-69
R.E. NO. 13698

MARK	REVISIONS	BY	APPR.	DATE
2	Moved M.H. To Avoid Large Boulder. Added M.H. To provide additional ℄ Relocate Lateral Connection Point & Clear Pavement Improvements	WHIP	DJD	8-11-70
1	Change alignment from Sta 18+64.17 to Sta 22+97 Change water line	DJD	DJD	1-23-70

W.O. 1485 FOR: O. P. LADD F.B. 897
DESIGNED BY WHIP DRAWN BY WHIP CHECKED BY DJD

CITY OF RIVERSIDE, CALIFORNIA
DEPARTMENT OF PUBLIC WORKS

APPROVED BY	BY	DATE
OFFICE ENGINEER		
PARK DEPARTMENT		
TRAFFIC DIVISION		
ASSISTANT CITY ENG.		

APPROVED BY [signature]
DIRECTOR OF PUBLIC WORKS
DATE 10/29/69

SEWER PLAN & PROFILE
R.S. # 995
EL CERRITO DRIVE
CENTRAL AVENUE TO 500' NLY

HORIZ. SCALE: 1" = 50' VERT. SCALE: 1" = 5'

PROJECT NO. S-699
SHEET 1 OF 1
FILE NO. 2772