



- BENCH MARKS:**
- Elev. 835.399, Chiseled square cut in west curb Crowell at Indiana.
 - Elev. 829.809, Chiseled square cut in north curb Indiana 127' SW of Susan.
- GENERAL NOTES:**
- It shall be the responsibility of the Contractor to clear the right of way in accordance with the provisions of law as it affects each utility including irrigation lines and appurtenances and at no cost to the City.
 - Construction shall be in accordance with City of Riverside Dept. of Public Works, Specifications No. 461 and Standard Drawings.
 - Pipe shall be bedded per Std. Drawing No. 452.
 - Monolithic Concrete Pipe is an approved equal for RCP in sizes 24" & larger.

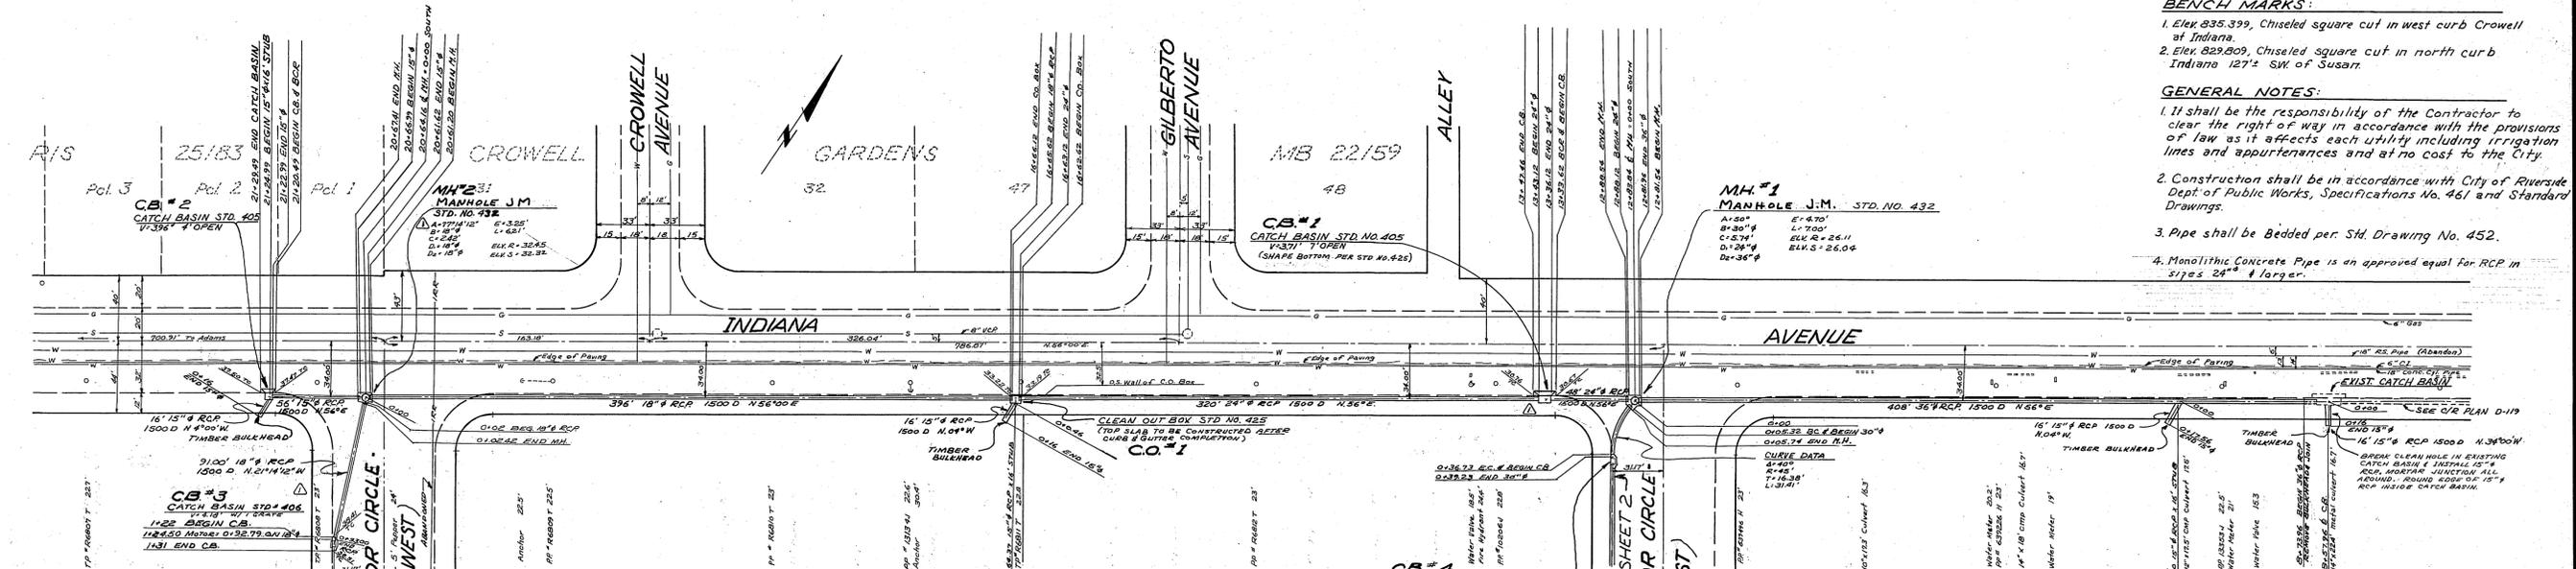

QUANTITY ESTIMATE

36" RCP 1500D	408	LF
30" RCP 1500D	34	LF
27" RCP 1500D	392	LF
24" RCP 1500D	472	LF
18" RCP 1500D	674	LF
15" RCP 1500D	176	LF
CATCH BASIN, STD. 405 W/7' OPEN	1	EA
CATCH BASIN, STD. 405 W/4' OPEN	2	EA
CATCH BASIN, STD. 406 W/1 GRATE	3	EA
CATCH BASIN, STD. 406 W/2 GRATE	5	EA
MANHOLE, J.M., STD 432	3	EA
CLEAN OUT BOX, STD 425	1	EA
CLEAN OUT BOX, STD 425 (MODIFIED)	1	EA


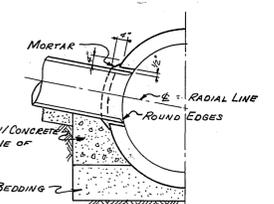


ALBERT A. WEBB ASSOCIATES
 CIVIL ENGINEERS
 RIVERSIDE, CALIFORNIA
 APPROVED BY: *Albert A. Webb* DATE 10/6/69
 R.E. No. 2976

ENUNCIATED
 RELOCATED
 DESIGNATED
 BY NUMBERS & REMOVE 15" RCP FROM CB#1




CITY OF RIVERSIDE, CALIFORNIA
 DEPARTMENT OF PUBLIC WORKS
 APPROVED BY: *[Signature]* DATE 10-15-69
 OFFICE ENGINEER
 PARK DEPARTMENT
 TRAFFIC DIVISION
 ASSISTANT CITY ENG.

STORM DRAIN PLAN & PROFILE
INDIANA AVENUE
TRACT NO. 2876
 PROJECT NO. **D-121**
 SHEET 1 OF 2
 FILE NO. 63-233-D
 HORIZ. SCALE: 1" = 50'
 VERT. SCALE: 1" = 5'

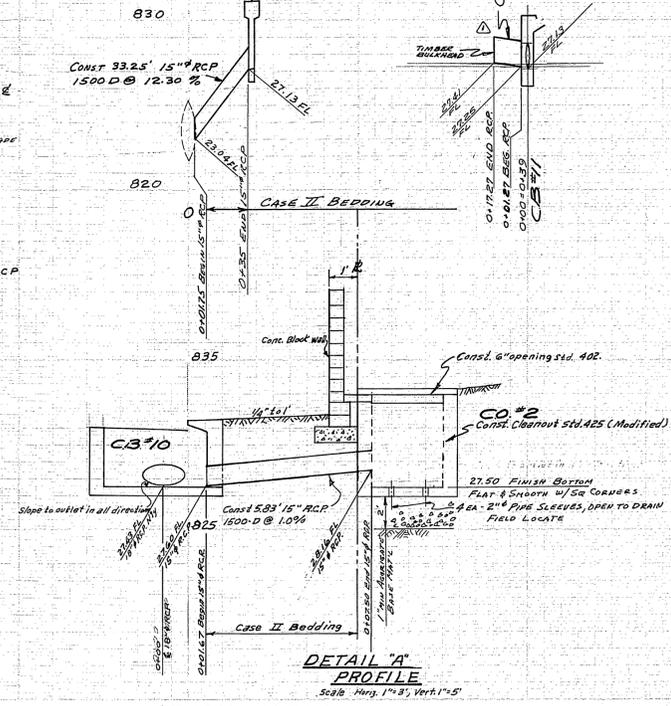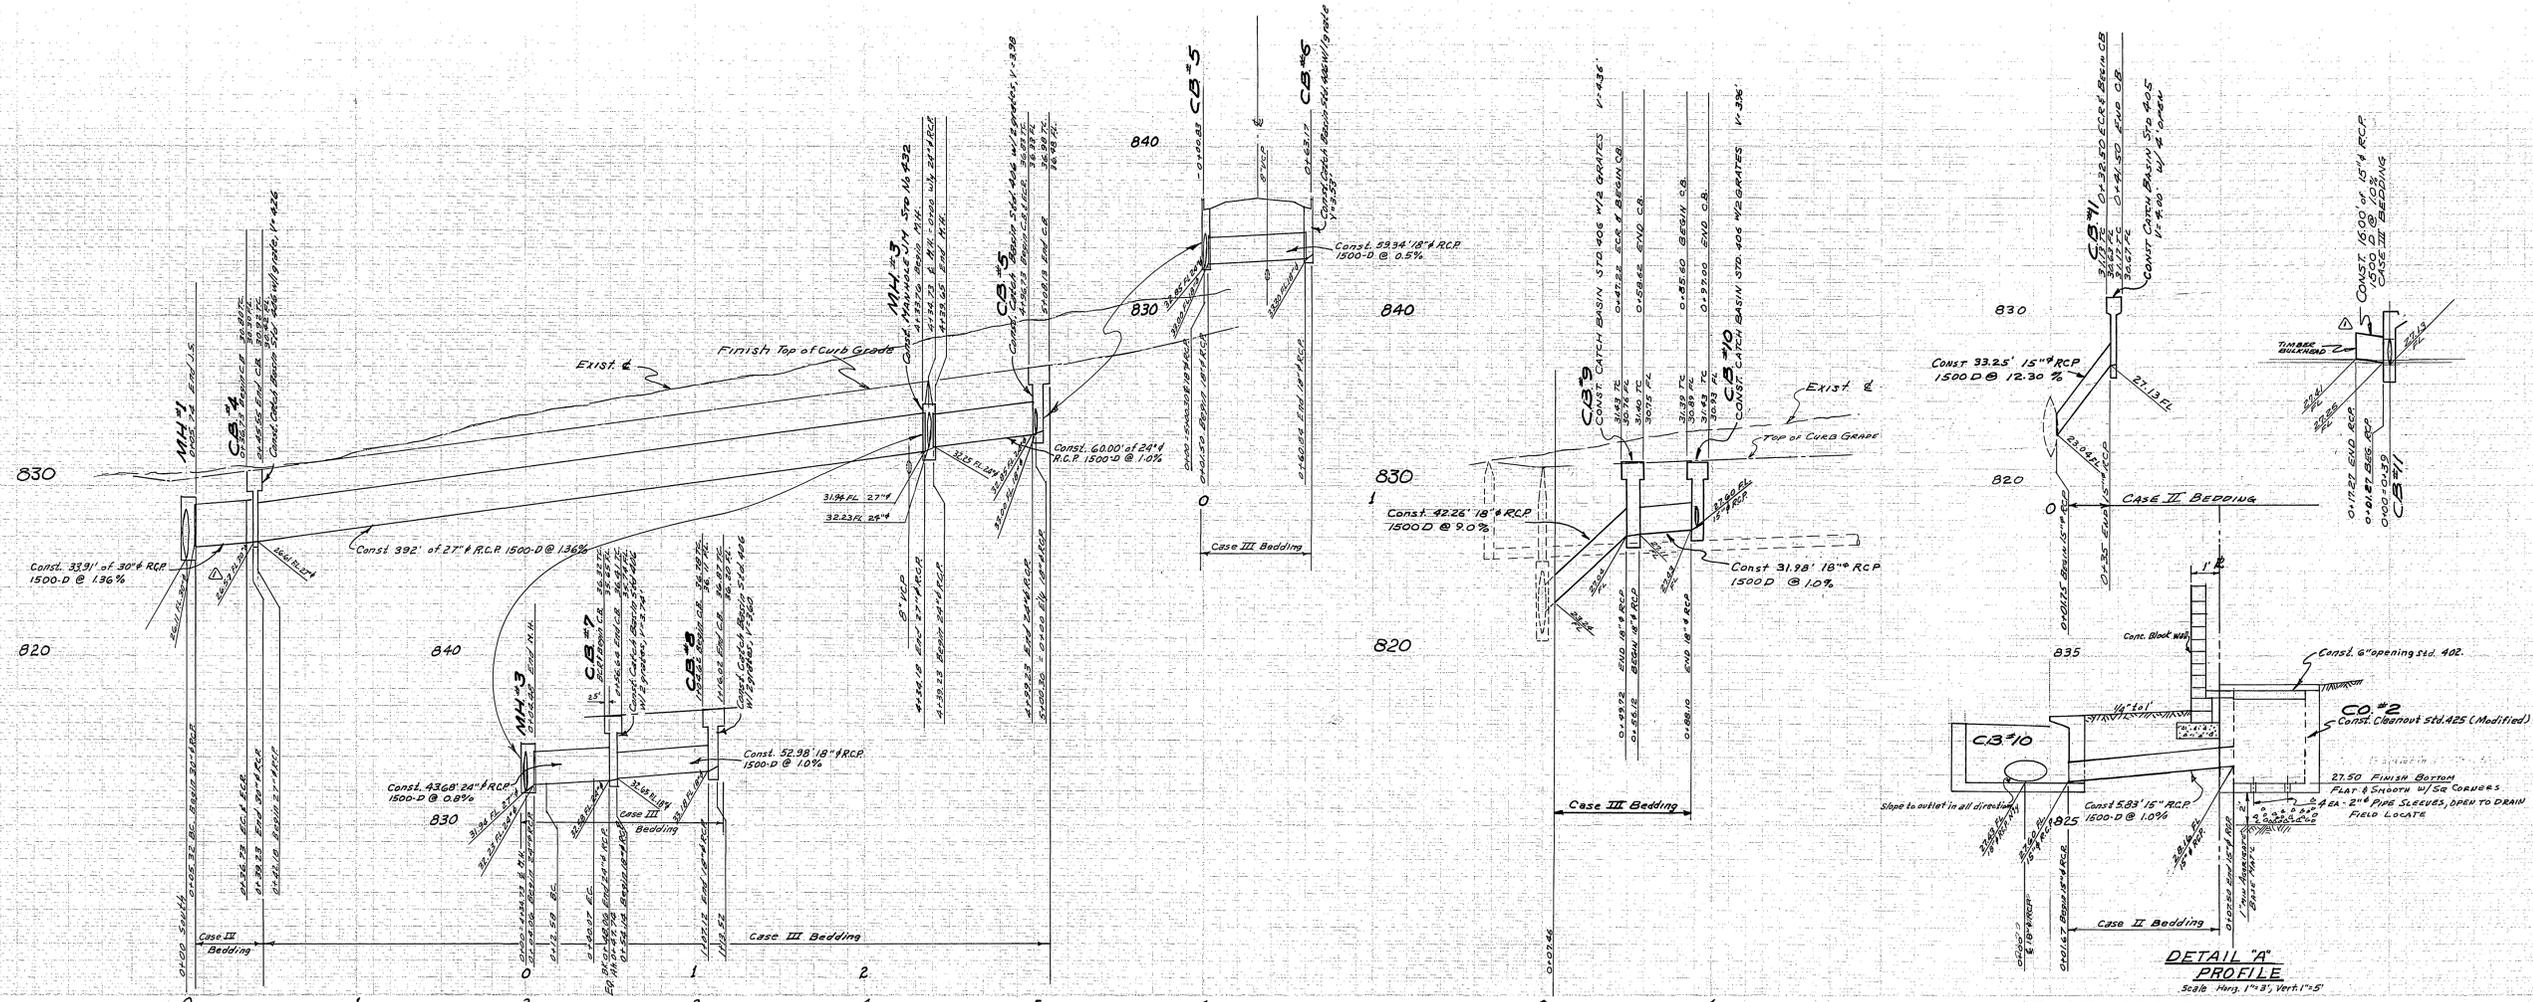

BENCH MARKS:


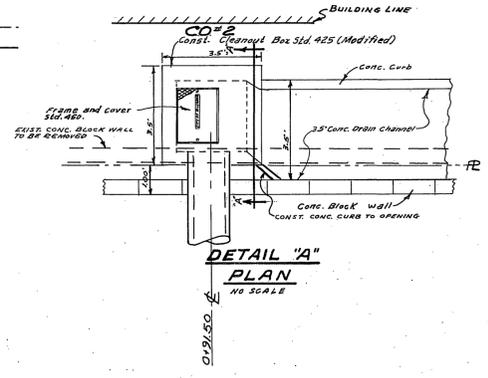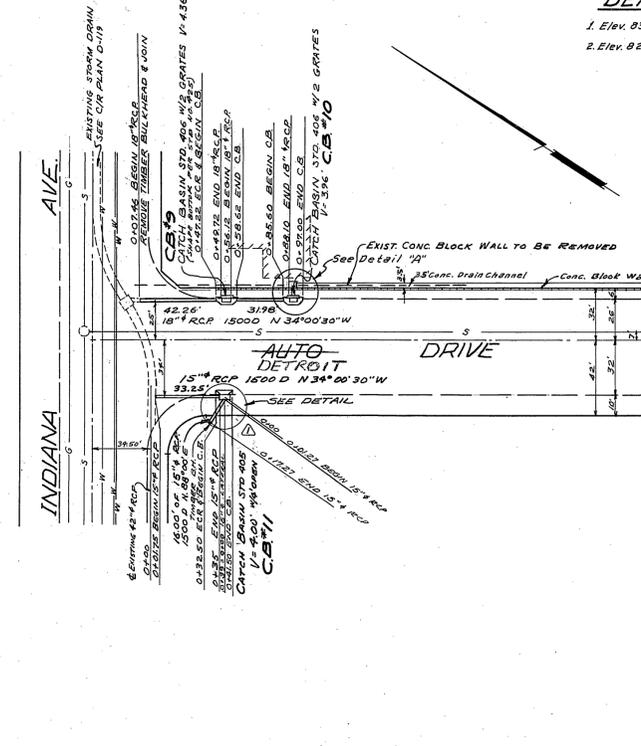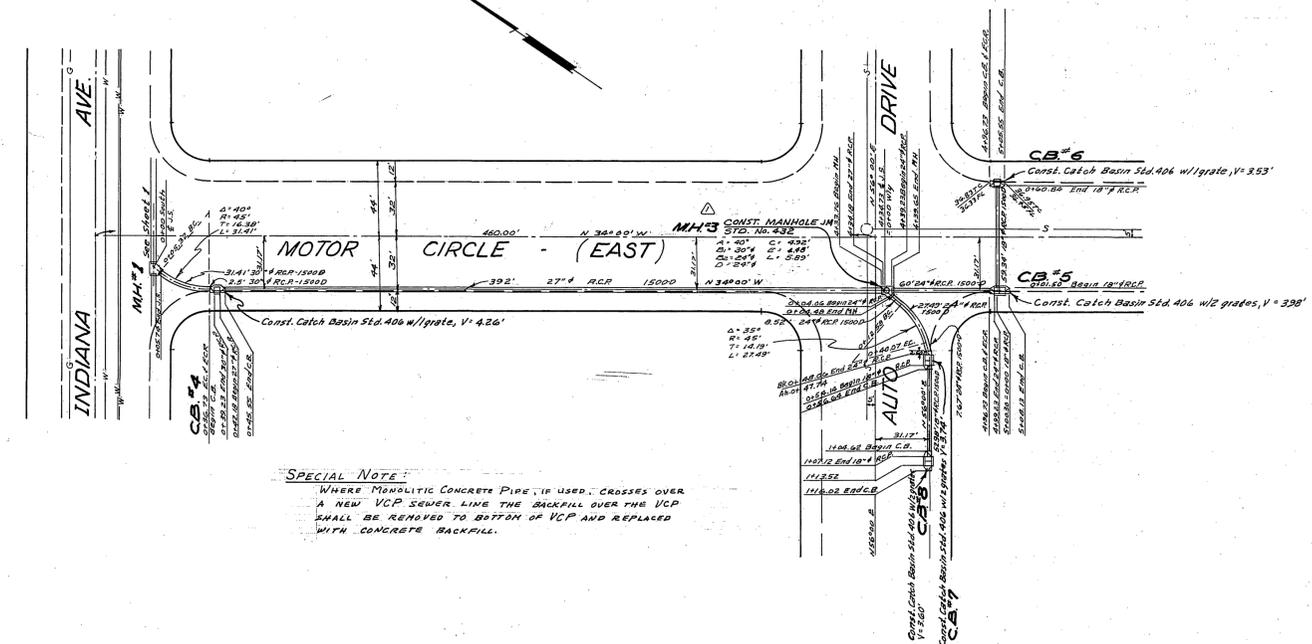

SPECIAL NOTE:

ALBERT A. WEBB ASSOCIATES CIVIL ENGINEERS RIVERSIDE, CALIFORNIA APPROVED BY: <i>[Signature]</i> DATE 10/6/64 R.E. No. 9876 W.O. 63-233 FOR RIVERSIDE AUTO CENTER F.B. 333	ENCL. 1, 2, 3, 1000.	CITY OF RIVERSIDE, CALIFORNIA DEPARTMENT OF PUBLIC WORKS APPROVED BY: <i>[Signature]</i> BY: DATE: 10-15-64 OFFICE ENGINEER PARK DEPARTMENT TRAFFIC DIVISION ASSISTANT CITY ENG.	STORM DRAIN PLAN & PROFILE MOTOR CIRCLE - EAST AND AUTO DRIVE TRACT No. 2876 HORIZ. SCALE: 1" = 50' VERT. SCALE: 1" = 5' SHEET 2 OF 2 FILE NO. 63-233-D	PROJECT NO. D-121
--	--	--	--	-----------------------------