
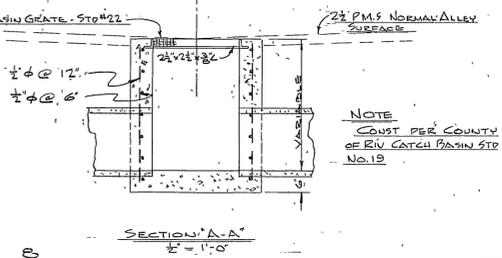
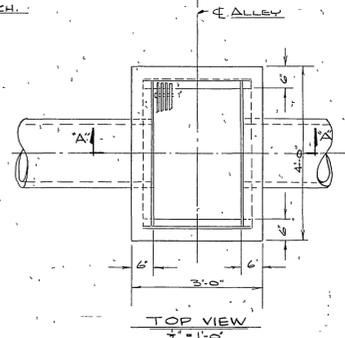


PLAN	SURVEYED	DATE
	PLOTTED	BY
	NOTE BOOK	
	RT. OF WAY CHECKED	
	NO.	

PROFILE	SURVEYED	DATE
	GRADES CHECKED	BY
	B.M. NOTED	
	STRUCTURE NOTATIONS CHD.	
	NO.	

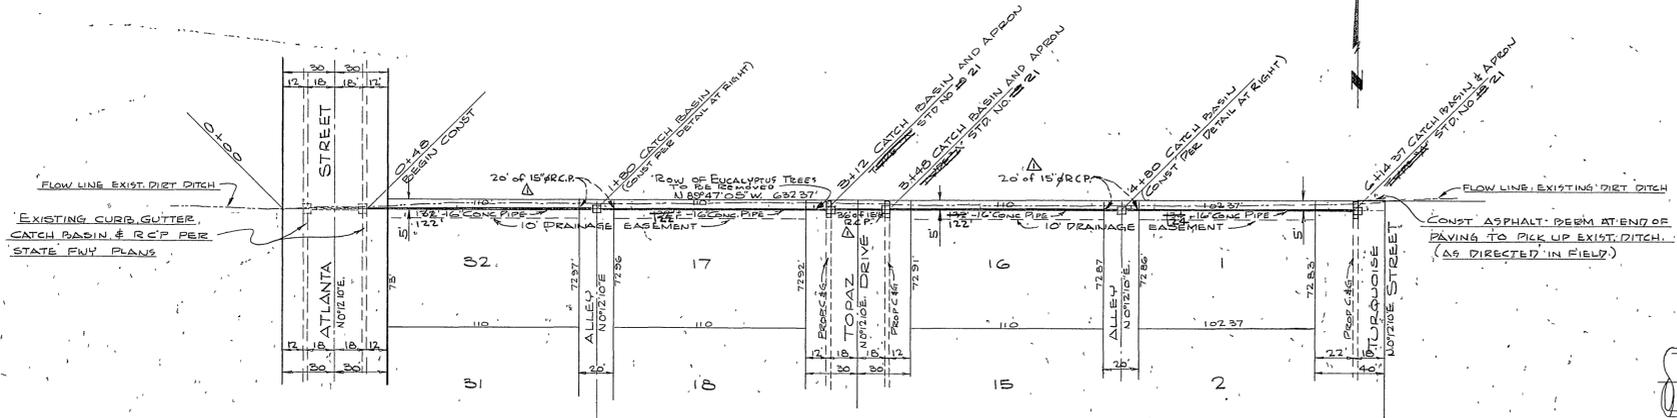

CHANGE CATCH BASINS TO STD. 21	8-7-60	dlr.
ADDED 15' R.C.P.	6-8-60	dlr.
REVISIONS	DATE	BY

TRACT No 2032

STORM DRAIN PLAN & PROFILE
IN EASEMENT BET ATLANTA ST & TURQUOISE ST

SCALE 1"=50'

DATE 4/21/60

DRAWN *dlr*

CHECKED *dlr*

L.R. 434

ALBERT A. WEBB ASSOCIATES
CIVIL ENGINEERS
Albert A. Webb
RIVERSIDE 10.E. 83% CALIFORNIA

W.O. 60-33
SHEET 5
OF 5 SHEETS
DWG. NO. 60-33D

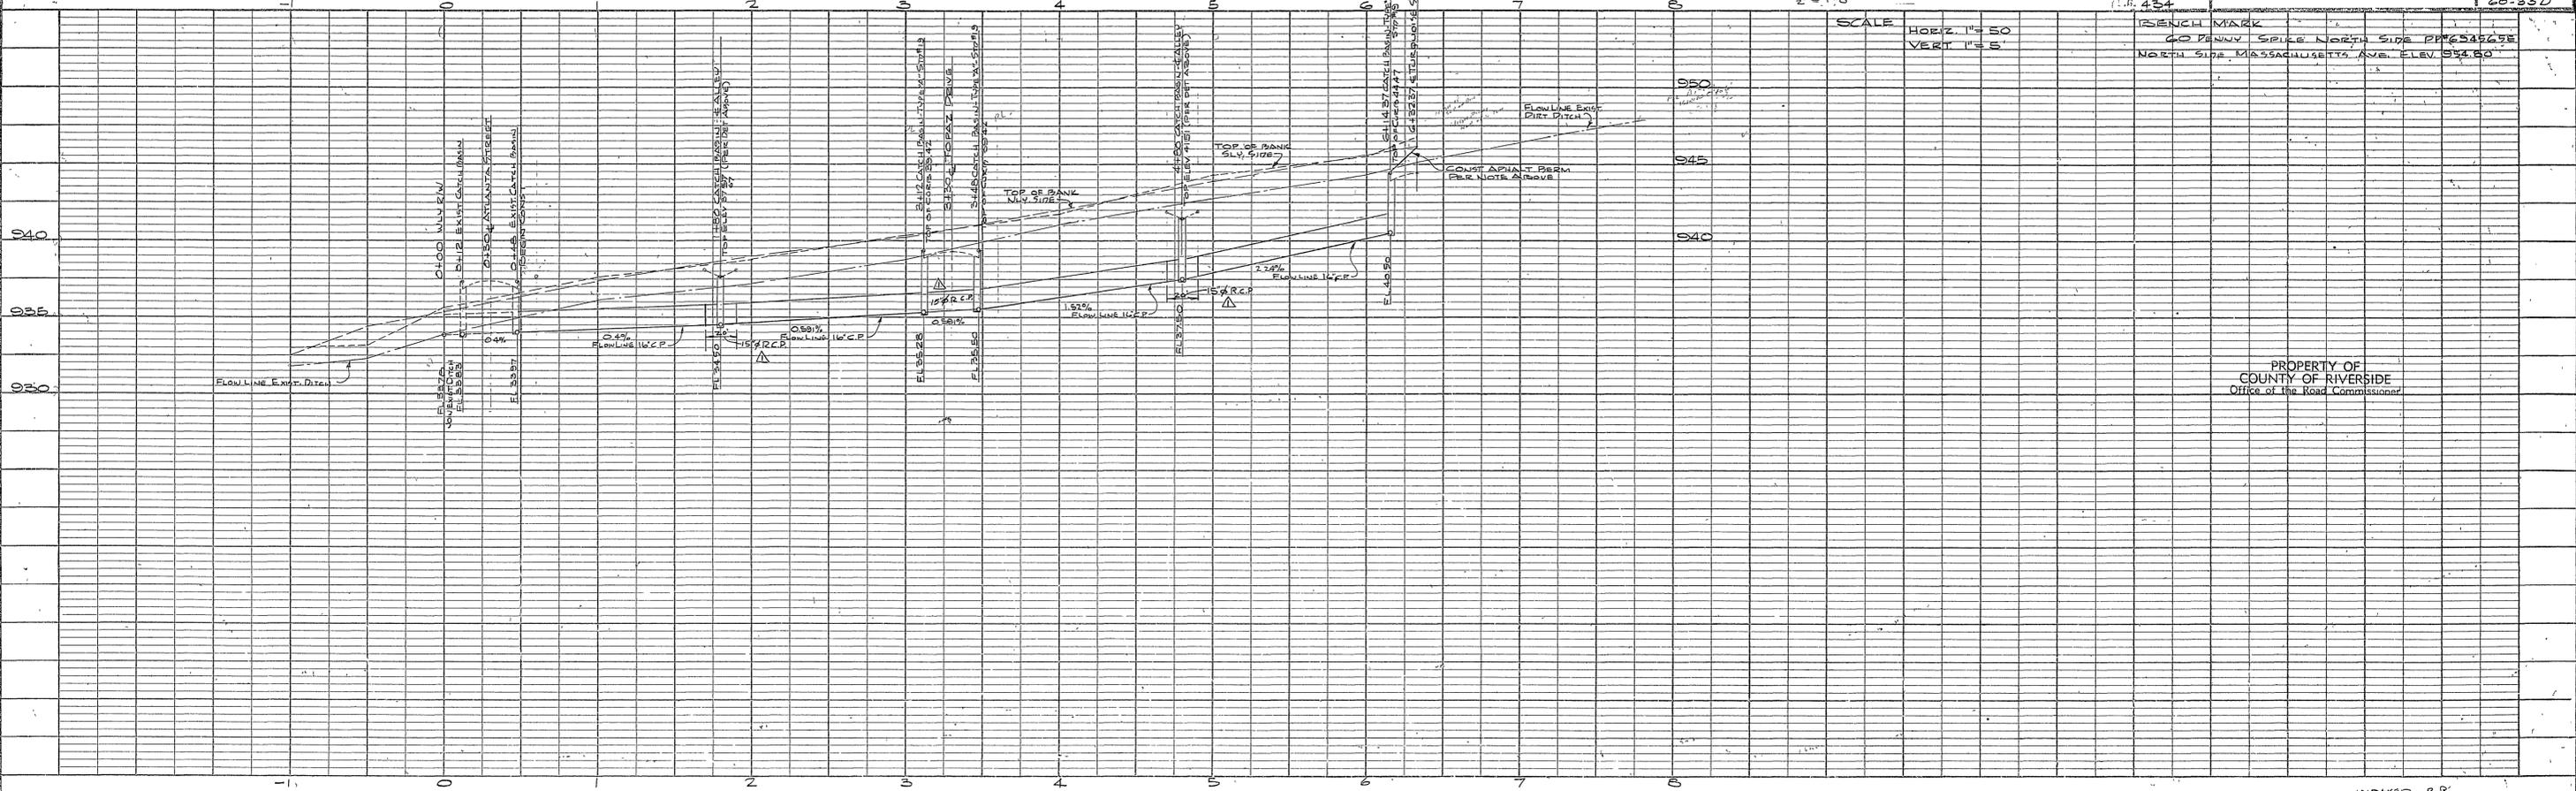


PLATE 1-PLAN-PROFILE, D.P.R. & C. STANDARD
KUFFEL & ESSER CO. NEW YORK

K & E Co No 347-1R IMPROVED 1961 MADE IN U.S.A. 22560