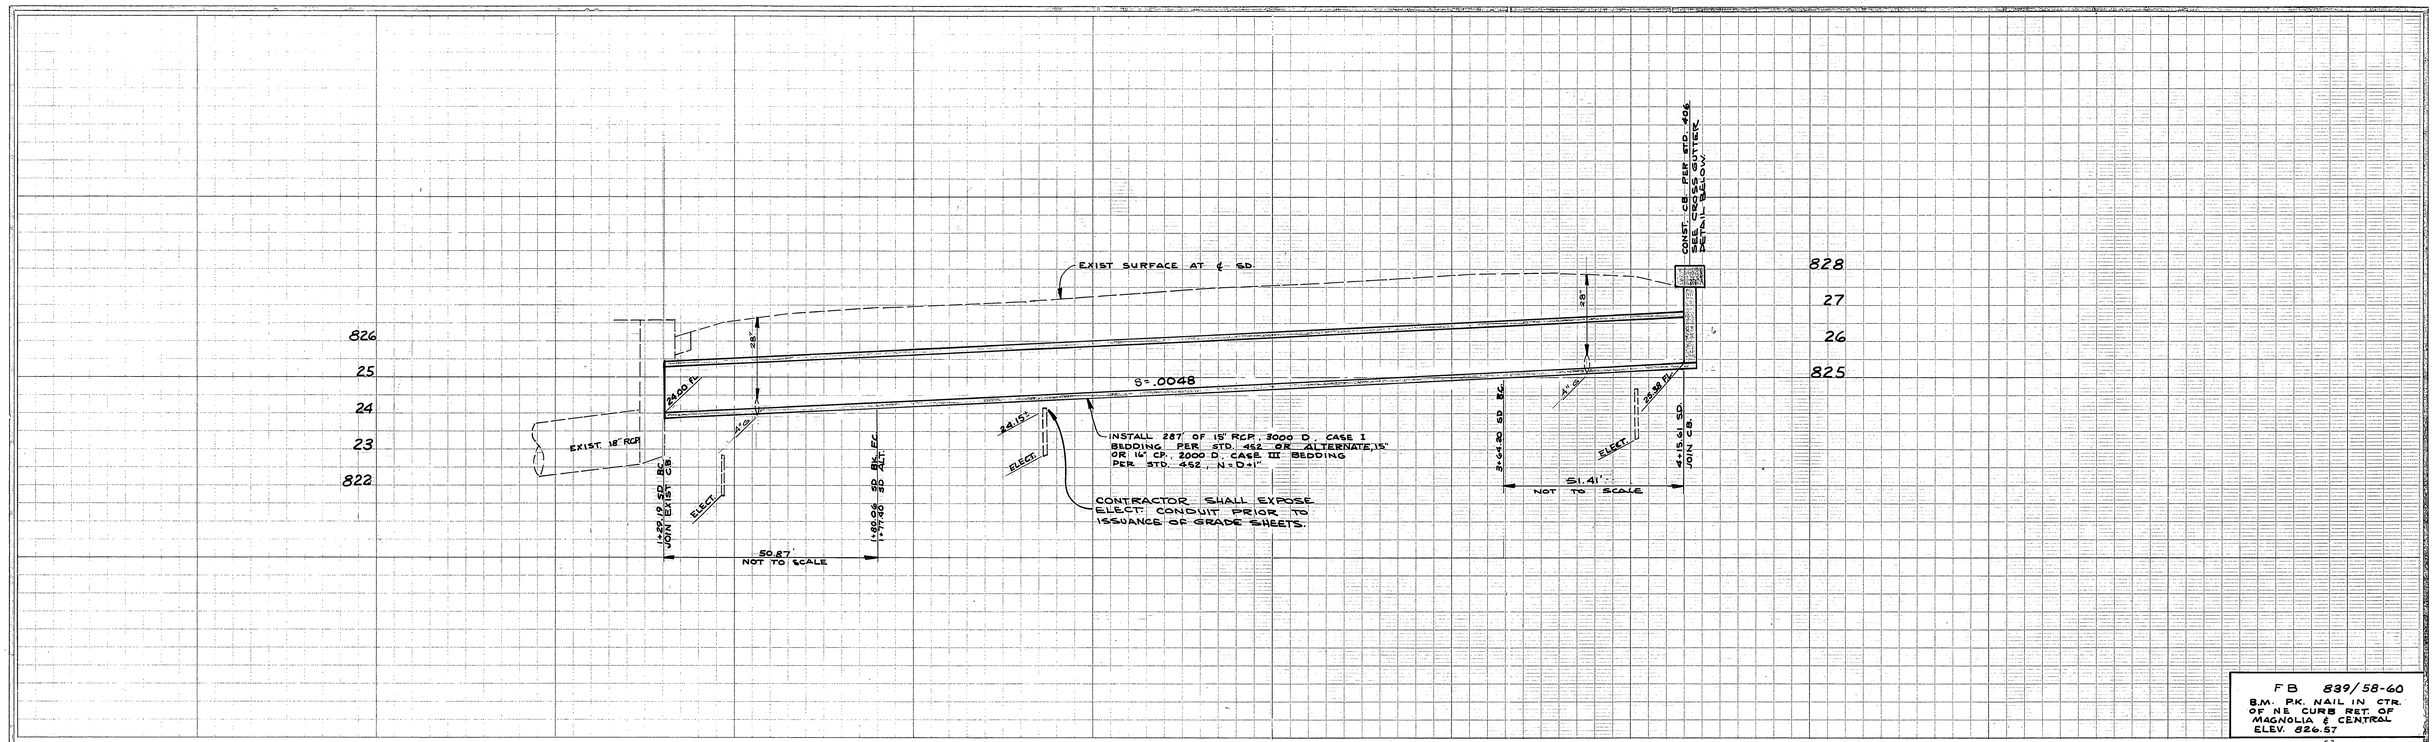

FB 839/58-60
B.M. PK. NAIL IN CTR. OF NE CURB RET. OF MAGNOLIA & CENTRAL
ELEV. 826.57

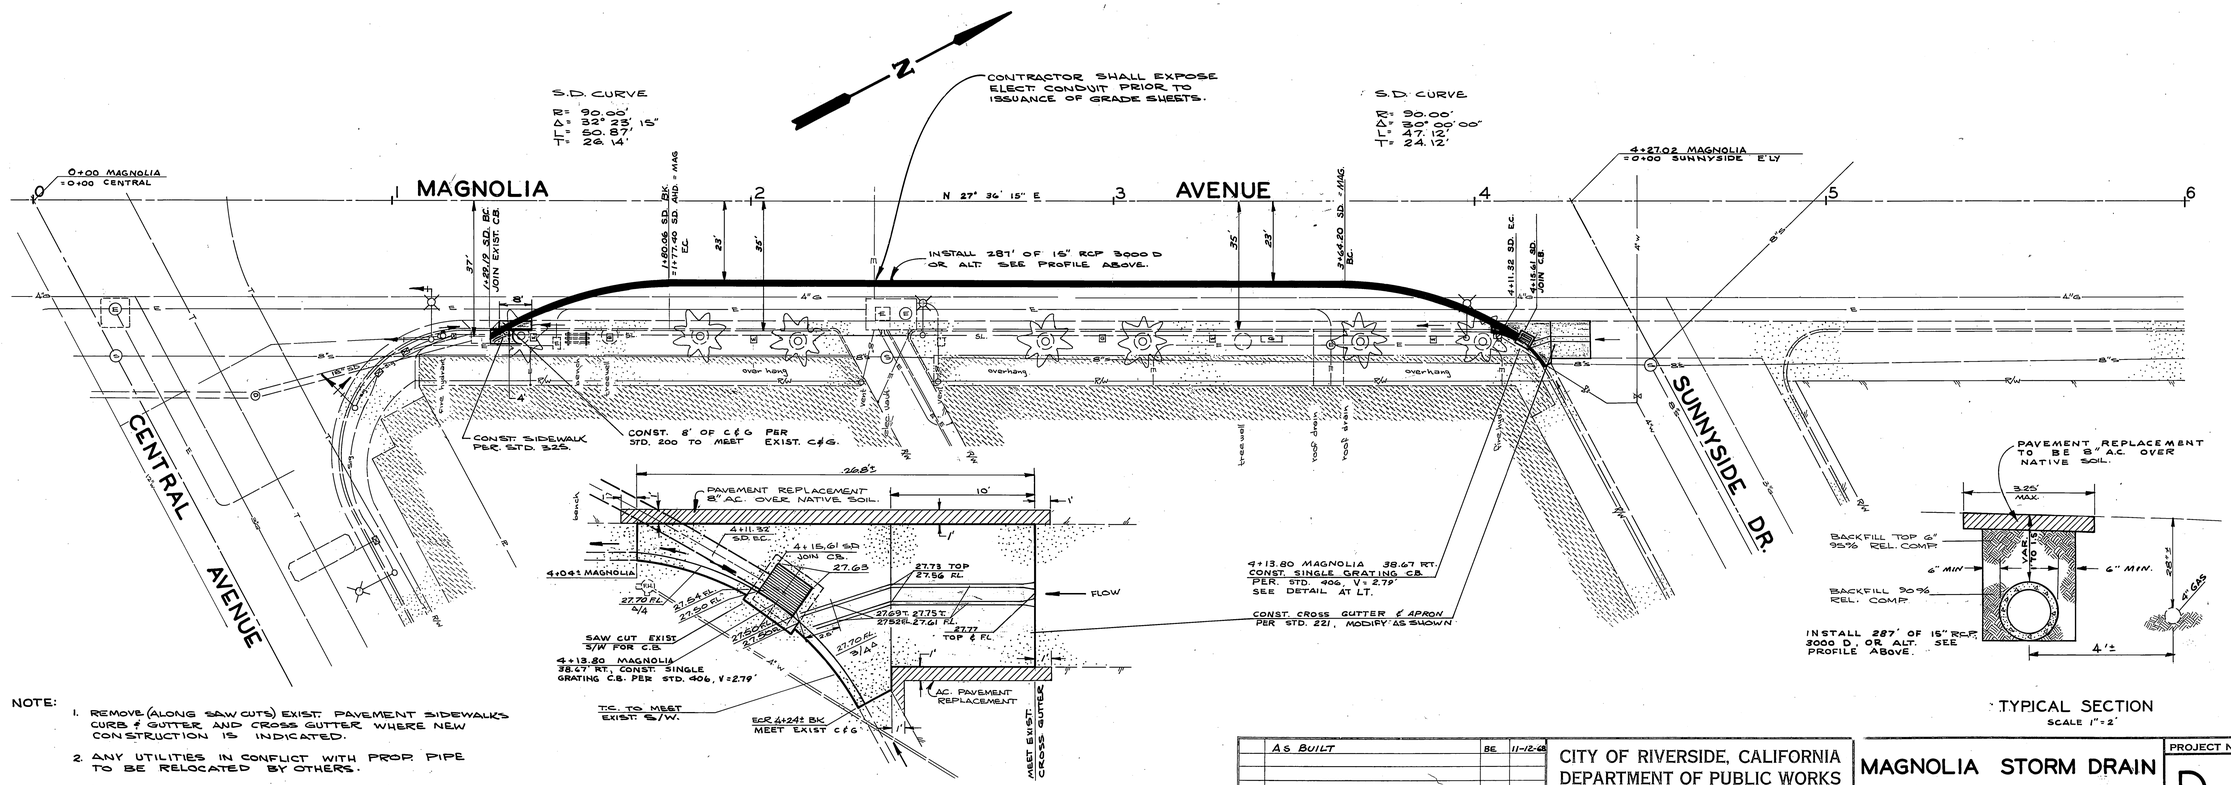

NOTE:

1. REMOVE (ALONG SAW CUTS) EXIST. PAVEMENT SIDEWALKS CURB & GUTTER AND CROSS GUTTER WHERE NEW CONSTRUCTION IS INDICATED.
2. ANY UTILITIES IN CONFLICT WITH PROP. PIPE TO BE RELOCATED BY OTHERS.

MARK	REVISIONS	APPR.	DATE
	AS BUILT	BE	11-12-68

DESIGNED BY BJG DRAWN BY LL CHECKED BY BE

CITY OF RIVERSIDE, CALIFORNIA
DEPARTMENT OF PUBLIC WORKS

APPROVED BY	BY	DATE
OFFICE ENGINEER		
~~PARK DEPARTMENT~~		
~~TRAFFIC DIVISION~~		
ASSISTANT CITY ENG.		

APPROVED BY
DIRECTOR OF PUBLIC WORKS
DATE 3-9-60

MAGNOLIA STORM DRAIN
CENTRAL TO SUNNYSIDE

PROJECT NO. 411
D-167
SHEET 1 OF 1
FILE NO.
HORIZ. SCALE: 1" = 20' VERT. SCALE: 1" = 2'