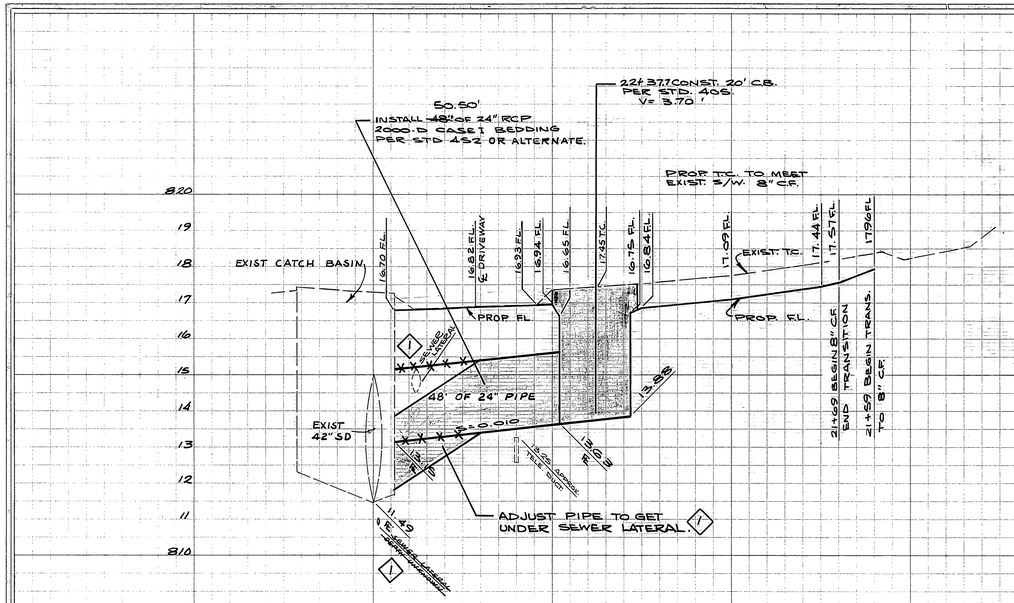

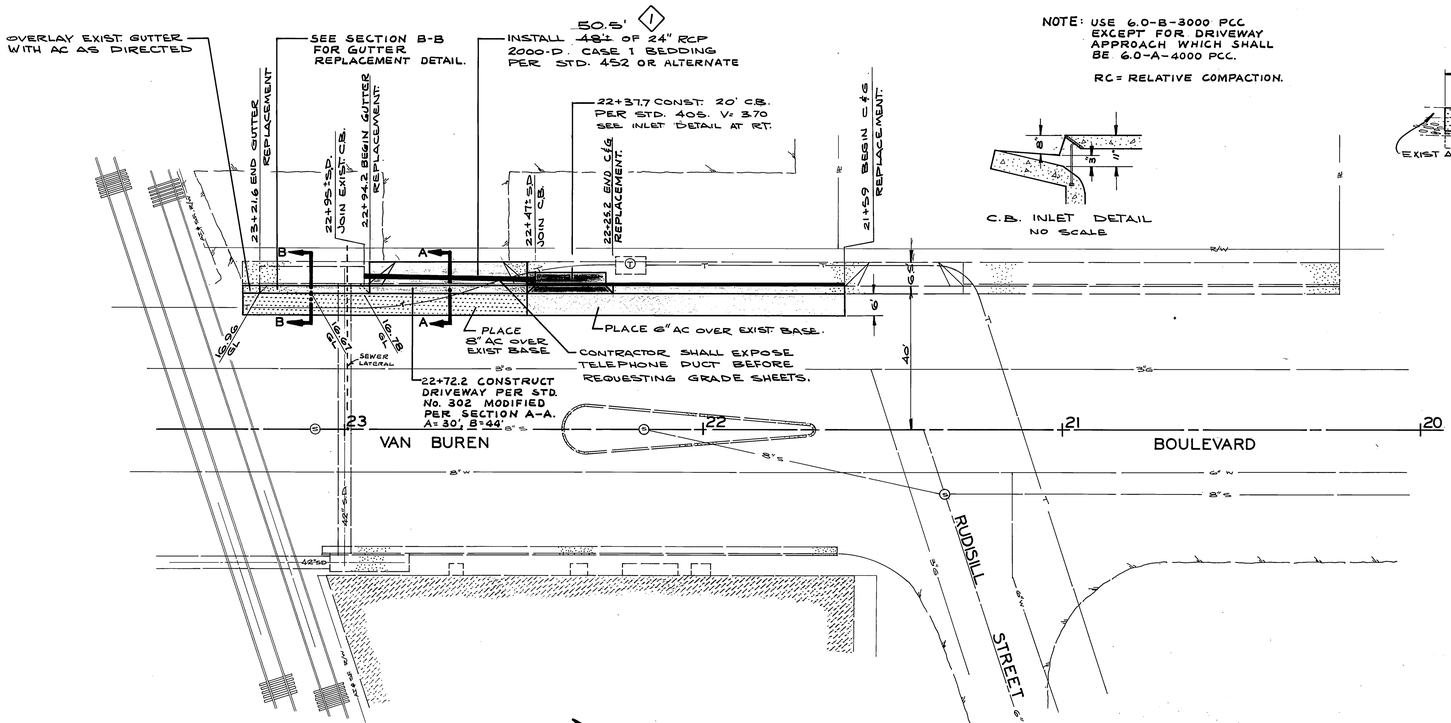

NOTE: USE 6.0-B-3000 PCC EXCEPT FOR DRIVEWAY APPROACH WHICH SHALL BE 6.0-A-4000 PCC.

RC = RELATIVE COMPACTION.

C.B. INLET DETAIL
NO SCALE

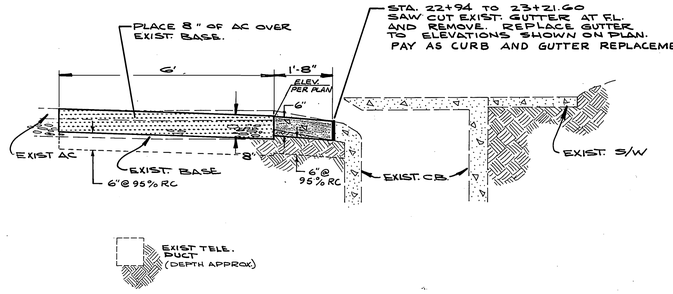

SECTION B-B

SCALE 1"= 2'

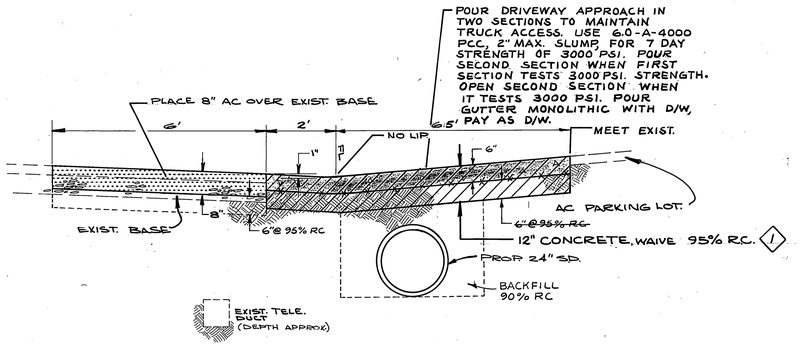

SECTION A-A

SCALE 1"= 2'

—CAUTION—
PACIFIC TELEPHONE
CABLES UNDERGROUND
BEFORE EXCAVATING
CALL COLLECT:
7:30 A.M. to 5 P.M. | After Hours & Holidays
Orange County 714-633-0811 | 714-547-6606
Riverside County 714-684-0071 | 714-547-6606
FOR FREE CABLE LOCATING SERVICE

MARK	REVISIONS	APPR.	DATE
1	AS BUILT - MC		12/9/68

DESIGNED BY BE DRAWN BY BE CHECKED BY

CITY OF RIVERSIDE, CALIFORNIA
DEPARTMENT OF PUBLIC WORKS

	BY	DATE
APPROVED BY OFFICE ENGINEER		
PARK DEPARTMENT		
TRAFFIC DIVISION		
ASSISTANT CITY ENG.		

APPROVED BY William D Gardner
DIRECTOR OF PUBLIC WORKS
DATE Sept. 3, 1968

VAN BUREN STORM DRAIN
AT A. T. & S.F. RAILROAD

INDEXED R.R.
PROJECT NO. 416

D-168

SHEET 1 OF 1

HORIZ. SCALE: 1" = 20' VERT. SCALE: 1" = 2'

FILE NO.