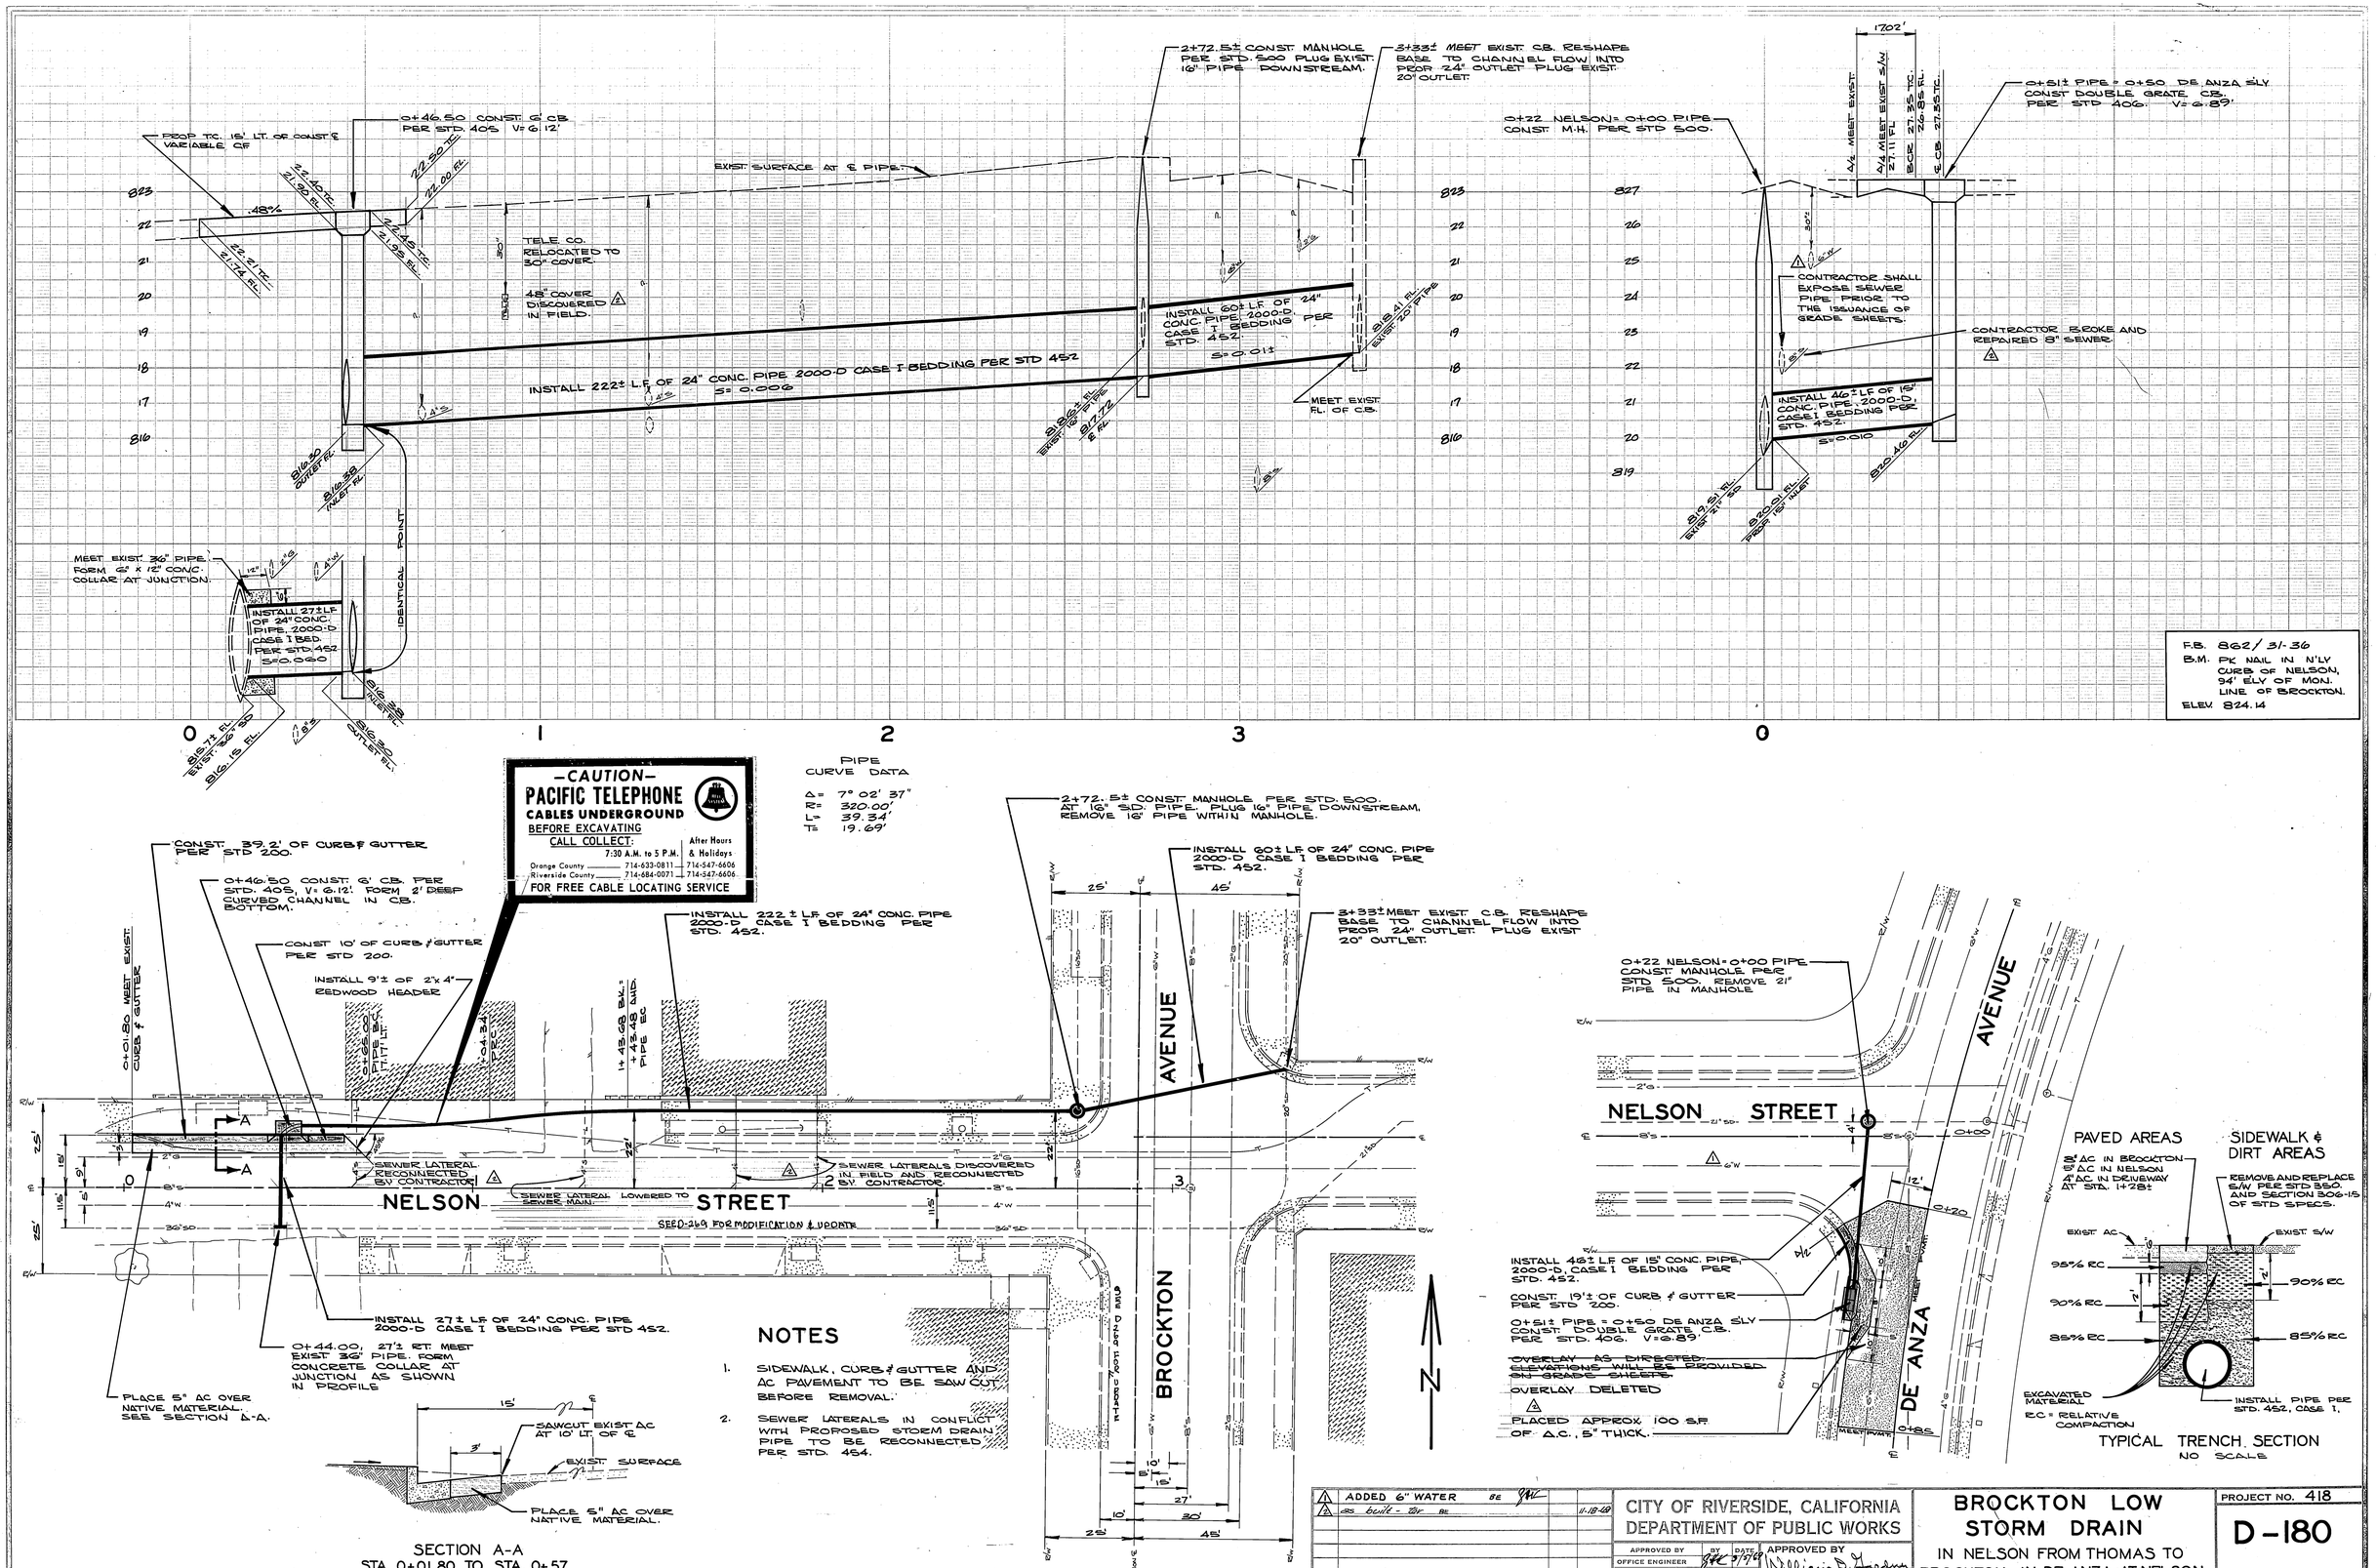

F.B. 862/31-36
B.M. PK NAIL IN N'LY CURB OF NELSON, 94' E'LY OF MON. LINE OF BROCKTON.
ELEV. 824.14

1	ADDED 6" WATER	BE	11-18-68
2	as built - TOP	BE	

DESIGNED BY BE DRAWN BY MM CHECKED BY

CITY OF RIVERSIDE, CALIFORNIA
DEPARTMENT OF PUBLIC WORKS

APPROVED BY	BY	DATE
OFFICE ENGINEER		2/7/69
TRAFFIC DEPARTMENT		
MAPPING DIVISION		
ASSISTANT CITY ENG.		3-12

APPROVED BY William D. Gordon
DIRECTOR OF PUBLIC WORKS
DATE 3/12/69

BROCKTON LOW STORM DRAIN

IN NELSON FROM THOMAS TO BROCKTON. IN DE ANZA AT NELSON

HORIZ. SCALE: 1" = 20' VERT. SCALE: 1" = 2'

PROJECT NO. 418

D-180

SHEET 1 OF 1

FILE NO.