DEPT. OF PUBLIC WORKS
ENGINEERING DIVISION

PROPERTY OF
CITY OF RIVERSIDE
DEPT. OF PUBLIC WORKS
ENGINEERING DIVISION

PLATE 1-PLAN-PROFILE-F.A.S.
CLEARPRINT PAPER CO. S. F. CAL.
No. 1000H-1

PROFILE

Vert. scale 1" = 5'

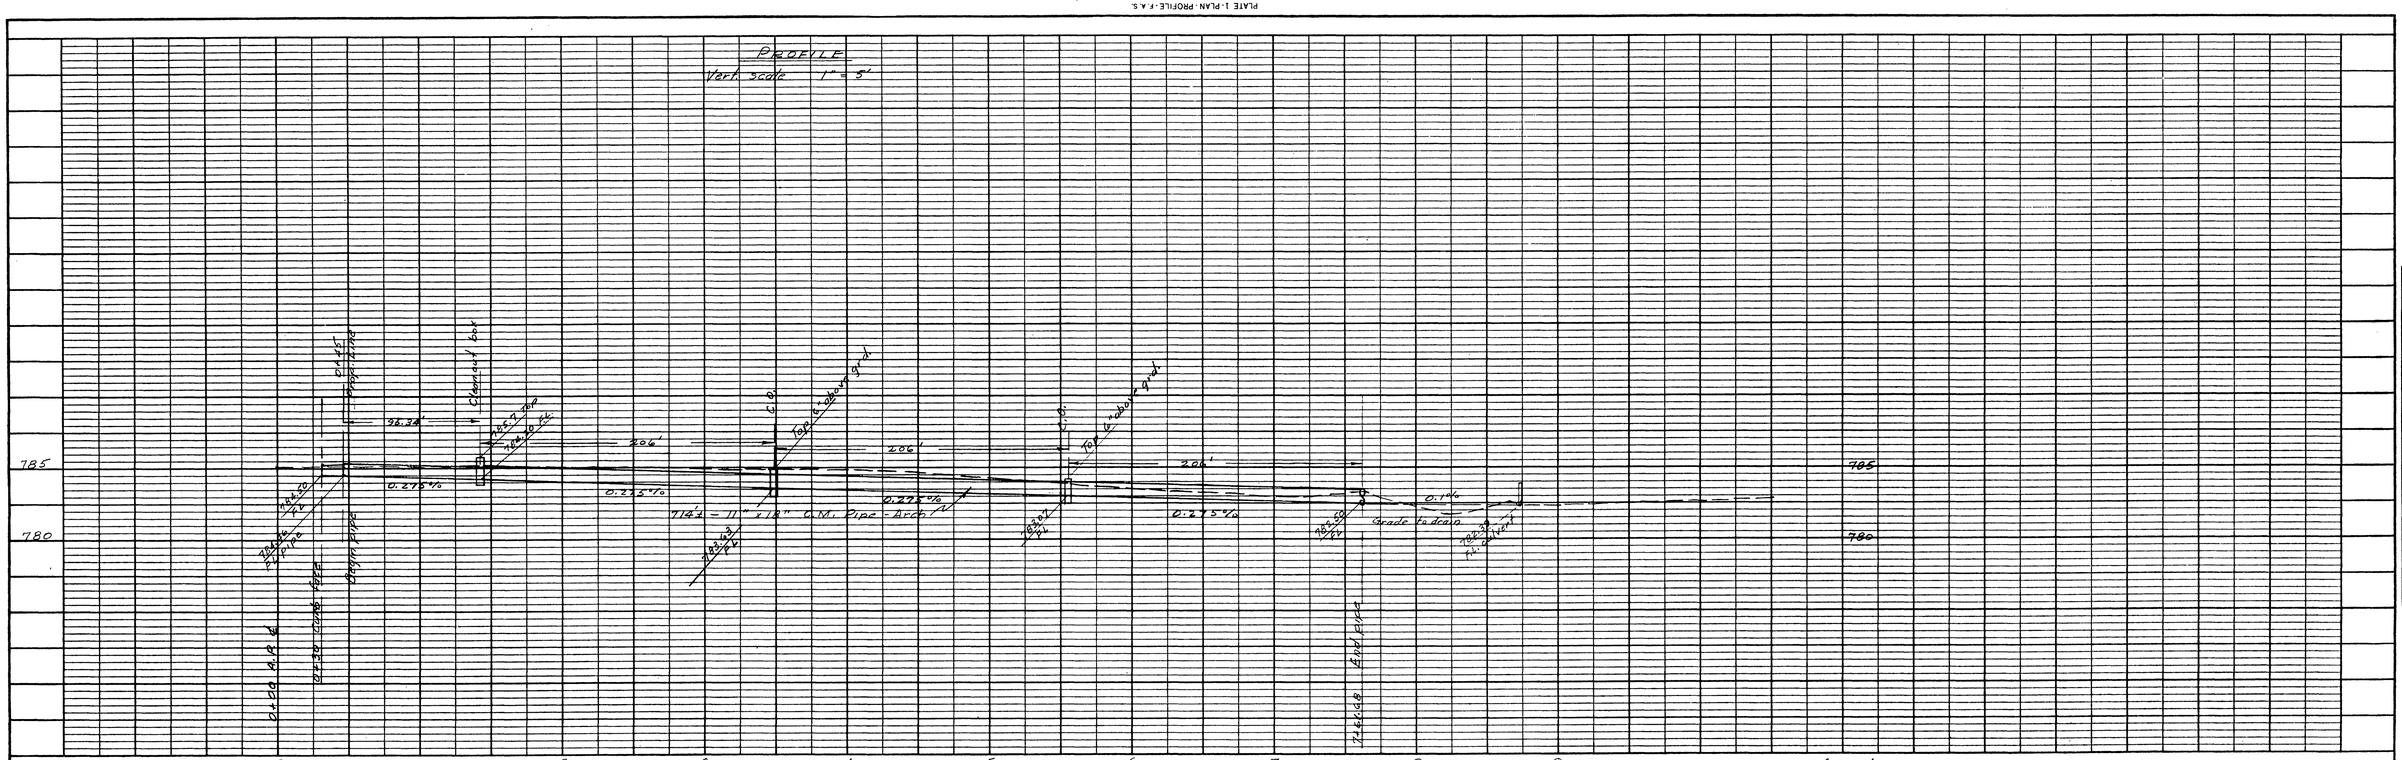

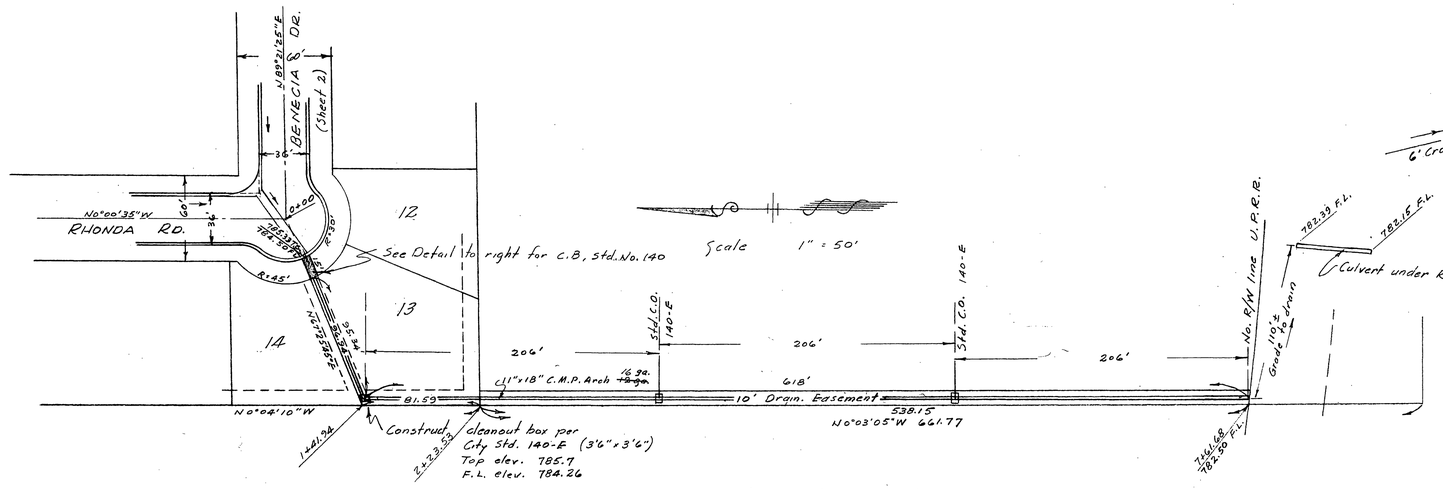

Cleanout boxes to be City Std. 140-E or equivalent, at discretion of City Engineer.

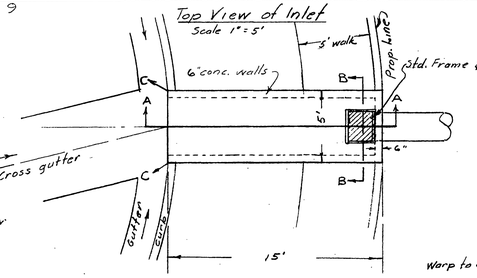

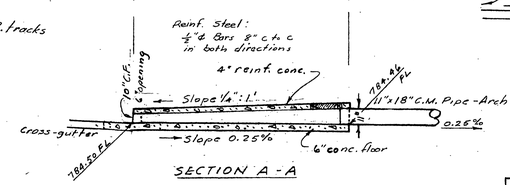

SECTION A-A

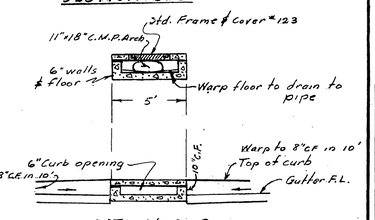

SECTION C-C

SECTION B-B

Detail of Catch Basin Std. No. 140
with Std. Frame & Cover No. 123

Hydraulic data
11"x18" C.M. Pipe arch = 15" diam. circ. pipe = 176 □"
n=.021 S=.00275 V= 1.75 Ft./sec. Q= 2.15 C.f.s.
Area of curb opening = 288 □"

REVISED 10-30-57
1-29-58 Change Gage of 11"x18" C.M. Arch 9#8

W.O. 56-9
Dwg. No. 56-211

PROPERTY OF
CITY OF RIVERSIDE
DEPT. OF PUBLIC WORKS
ENGINEERING DIVISION

PROPERTY OF
CITY OF RIVERSIDE
DEPT. OF PUBLIC WORKS
ENGINEERING DIVISION

ALBERT A. WEBB ASSOCIATES
CIVIL ENGINEERS
RIVERSIDE, CALIFORNIA
Approved by E. H. Webb Date 4/25/57
R.E. 9876

CITY OF RIVERSIDE, CALIFORNIA
DEPARTMENT OF PUBLIC WORKS

DRAIN PLAN & PROFILE from BENECIA DRIVE TO U.P.R.R.

MAXWELL GARDENS TRACT

Horiz. Scale - 1"=50' Vert. Scale - 1"=5'

Approved by _____
Director of Public Works
Date 6-14-57

No D-22

Sheet 1 of 1

PLAN / PROFILE
NOTE BOOK NO. ____
SURVEYED
PLOTTED
GRADES CHECKED
R/W & NOTED
STRUCTURE NOTATNS CHK'D
BY
DATE

INDEXED