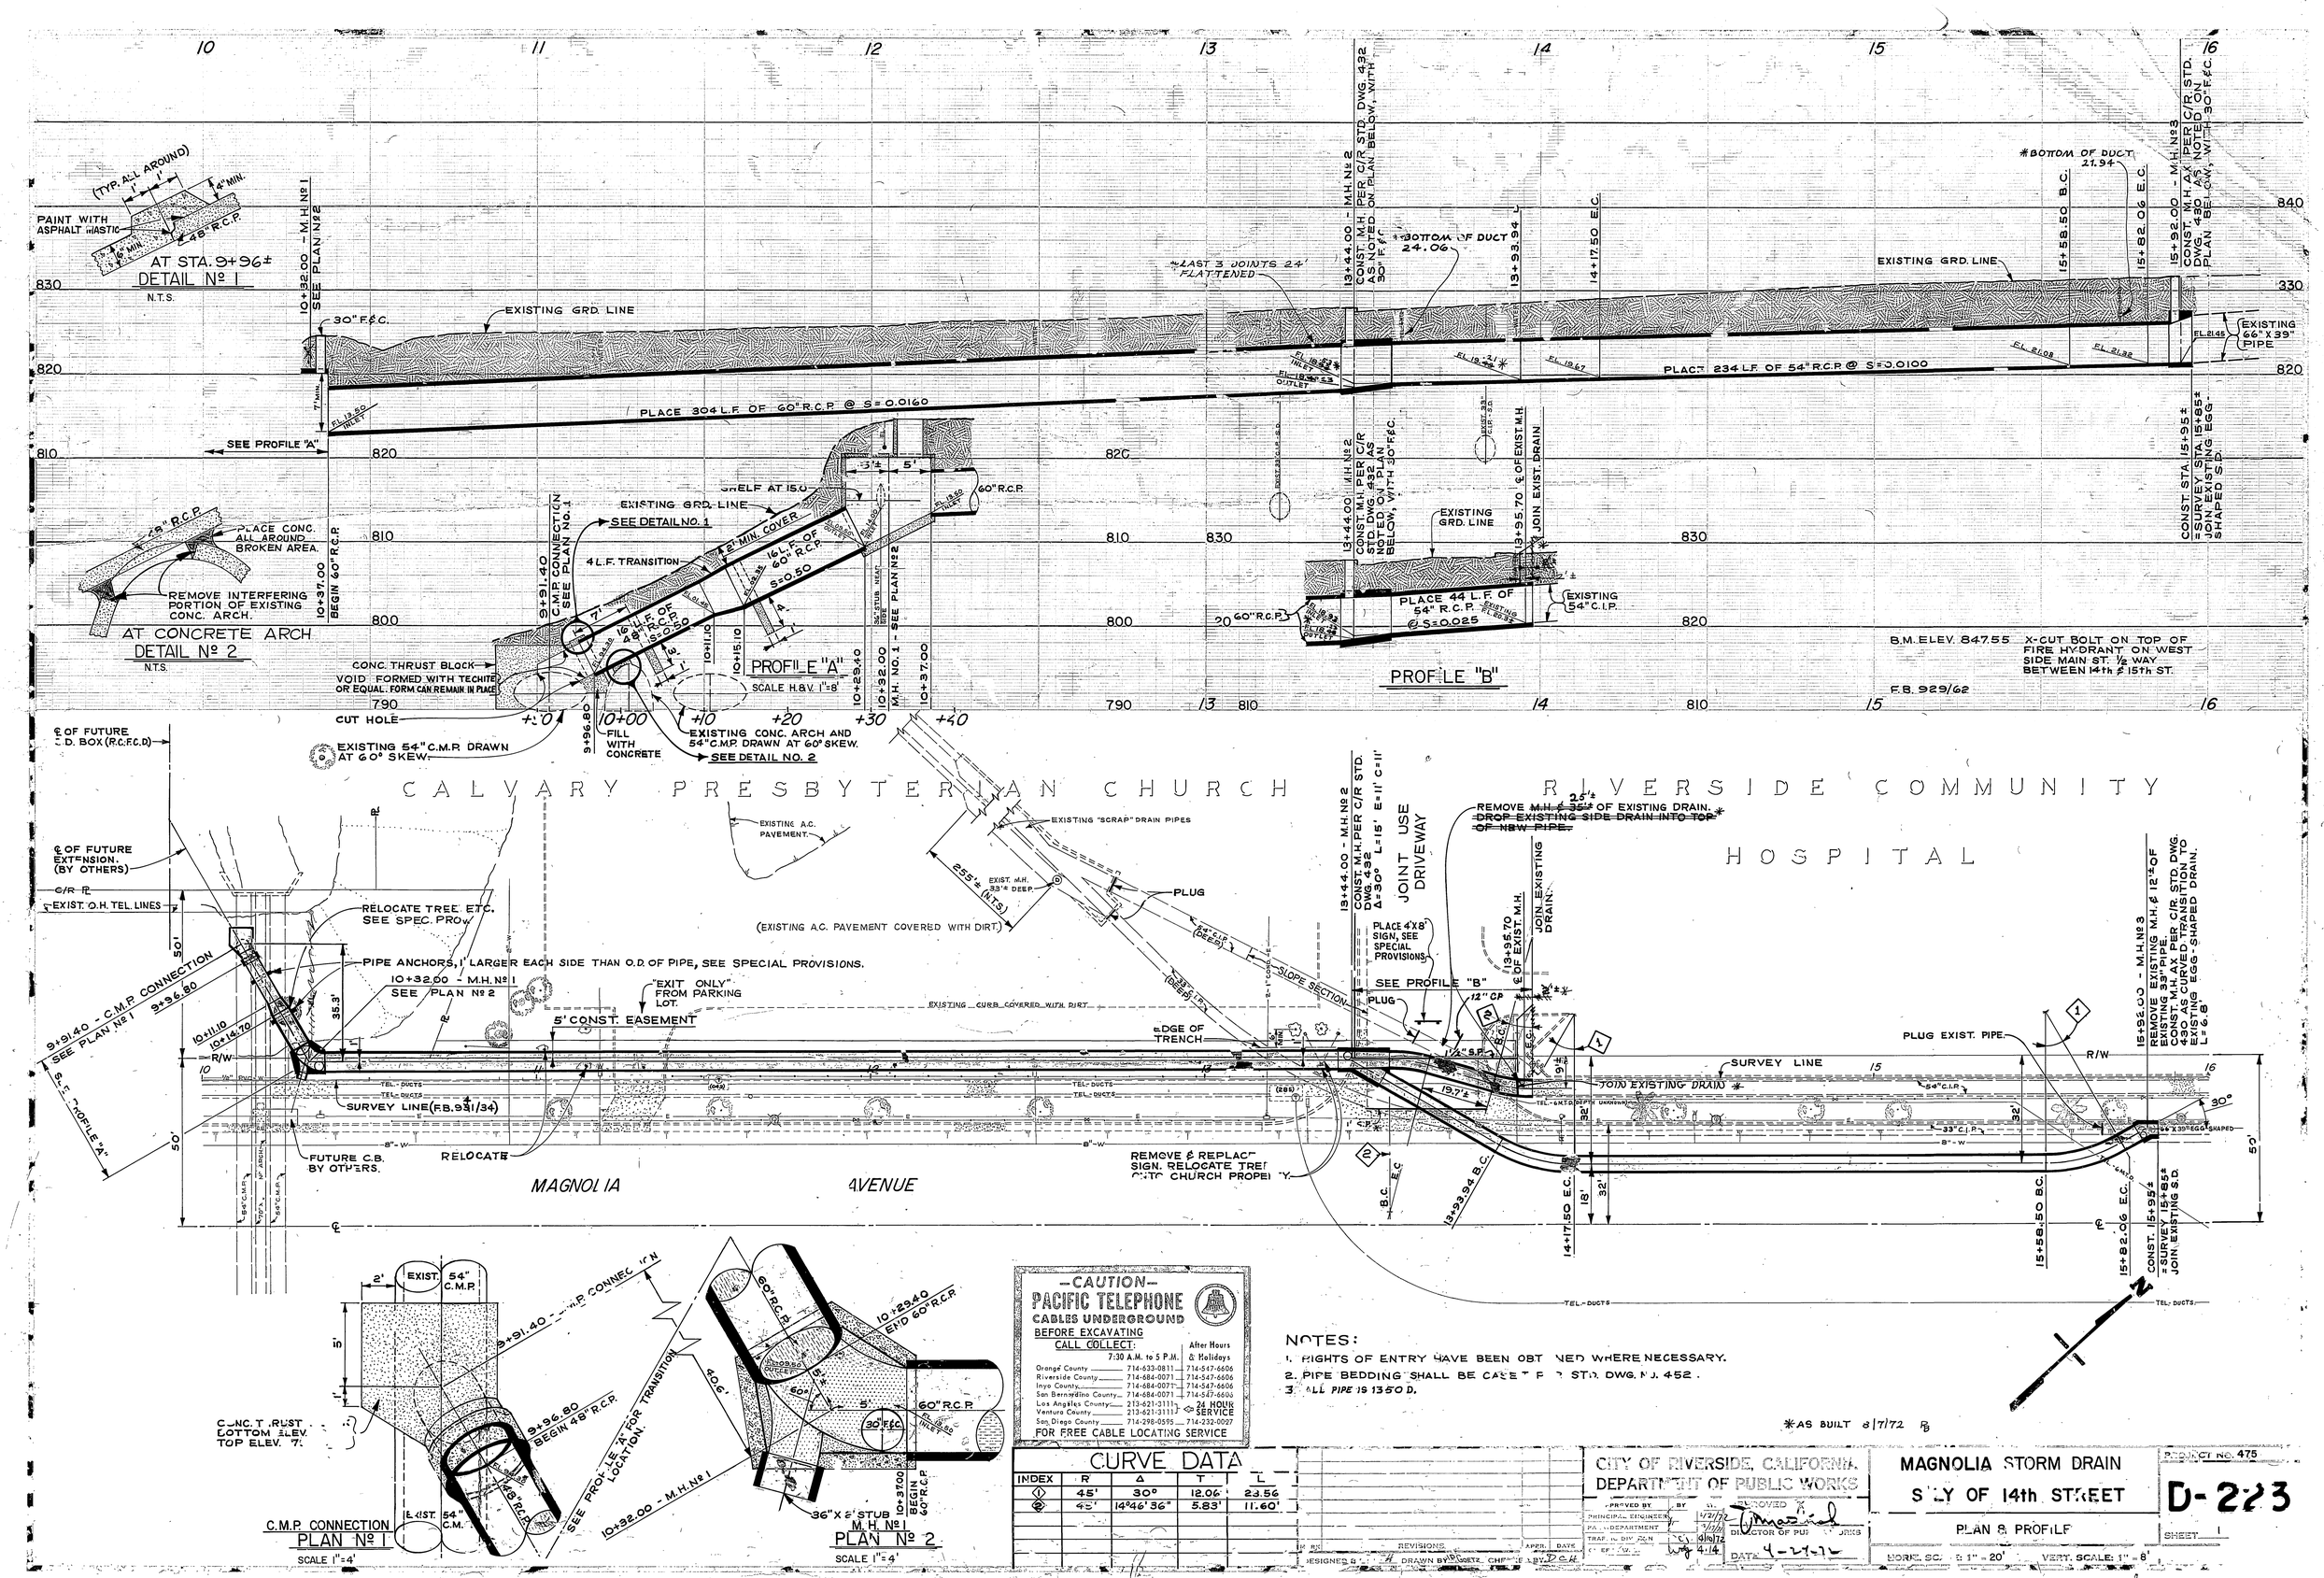

—CAUTION—
PACIFIC TELEPHONE
CABLES UNDERGROUND
BEFORE EXCAVATING
CALL COLLECT:

	7:30 A.M. to 5 P.M.	After Hours & Holidays
Orange County	714-633-0811	714-547-6606
Riverside County	714-684-0071	714-547-6606
Inyo County	714-684-0071	714-547-6606
San Bernardino County	714-684-0071	714-547-6606
Los Angeles County	213-621-3111	24 HOUR SERVICE
Ventura County	213-621-3111	
San Diego County	714-298-8595	714-232-0027

FOR FREE CABLE LOCATING SERVICE

NOTES:

1. RIGHTS OF ENTRY HAVE BEEN OBTAINED WHERE NECESSARY.
2. PIPE BEDDING SHALL BE CASE T PER STD. DWG. NO. 452.
3. ALL PIPE IS 1350 D.

CURVE DATA

INDEX	R	Δ	T	L
1	45'	30°	12.06	23.56
2	45'	14°46'36"	5.83'	11.60'

REVISIONS		APPR.	DATE

DESIGNED BY H DRAWN BY D. GOETZ CHECKED BY DCH

CITY OF RIVERSIDE, CALIFORNIA
DEPARTMENT OF PUBLIC WORKS

	BY		
APPROVED BY		APPROVED BY	
PRINCIPAL ENGINEER		DIRECTOR OF PUBLIC WORKS	
PARKS DEPARTMENT			
TRAFFIC DIV. ENG.		DATE 4-27-72	
CITY ENGINEER			

MAGNOLIA STORM DRAIN
S'LY OF 14th STREET
PLAN & PROFILE

PROJECT NO. 475
D-223
SHEET 1

HORIZ. SCALE: 1" = 20' VERT. SCALE: 1" = 8'