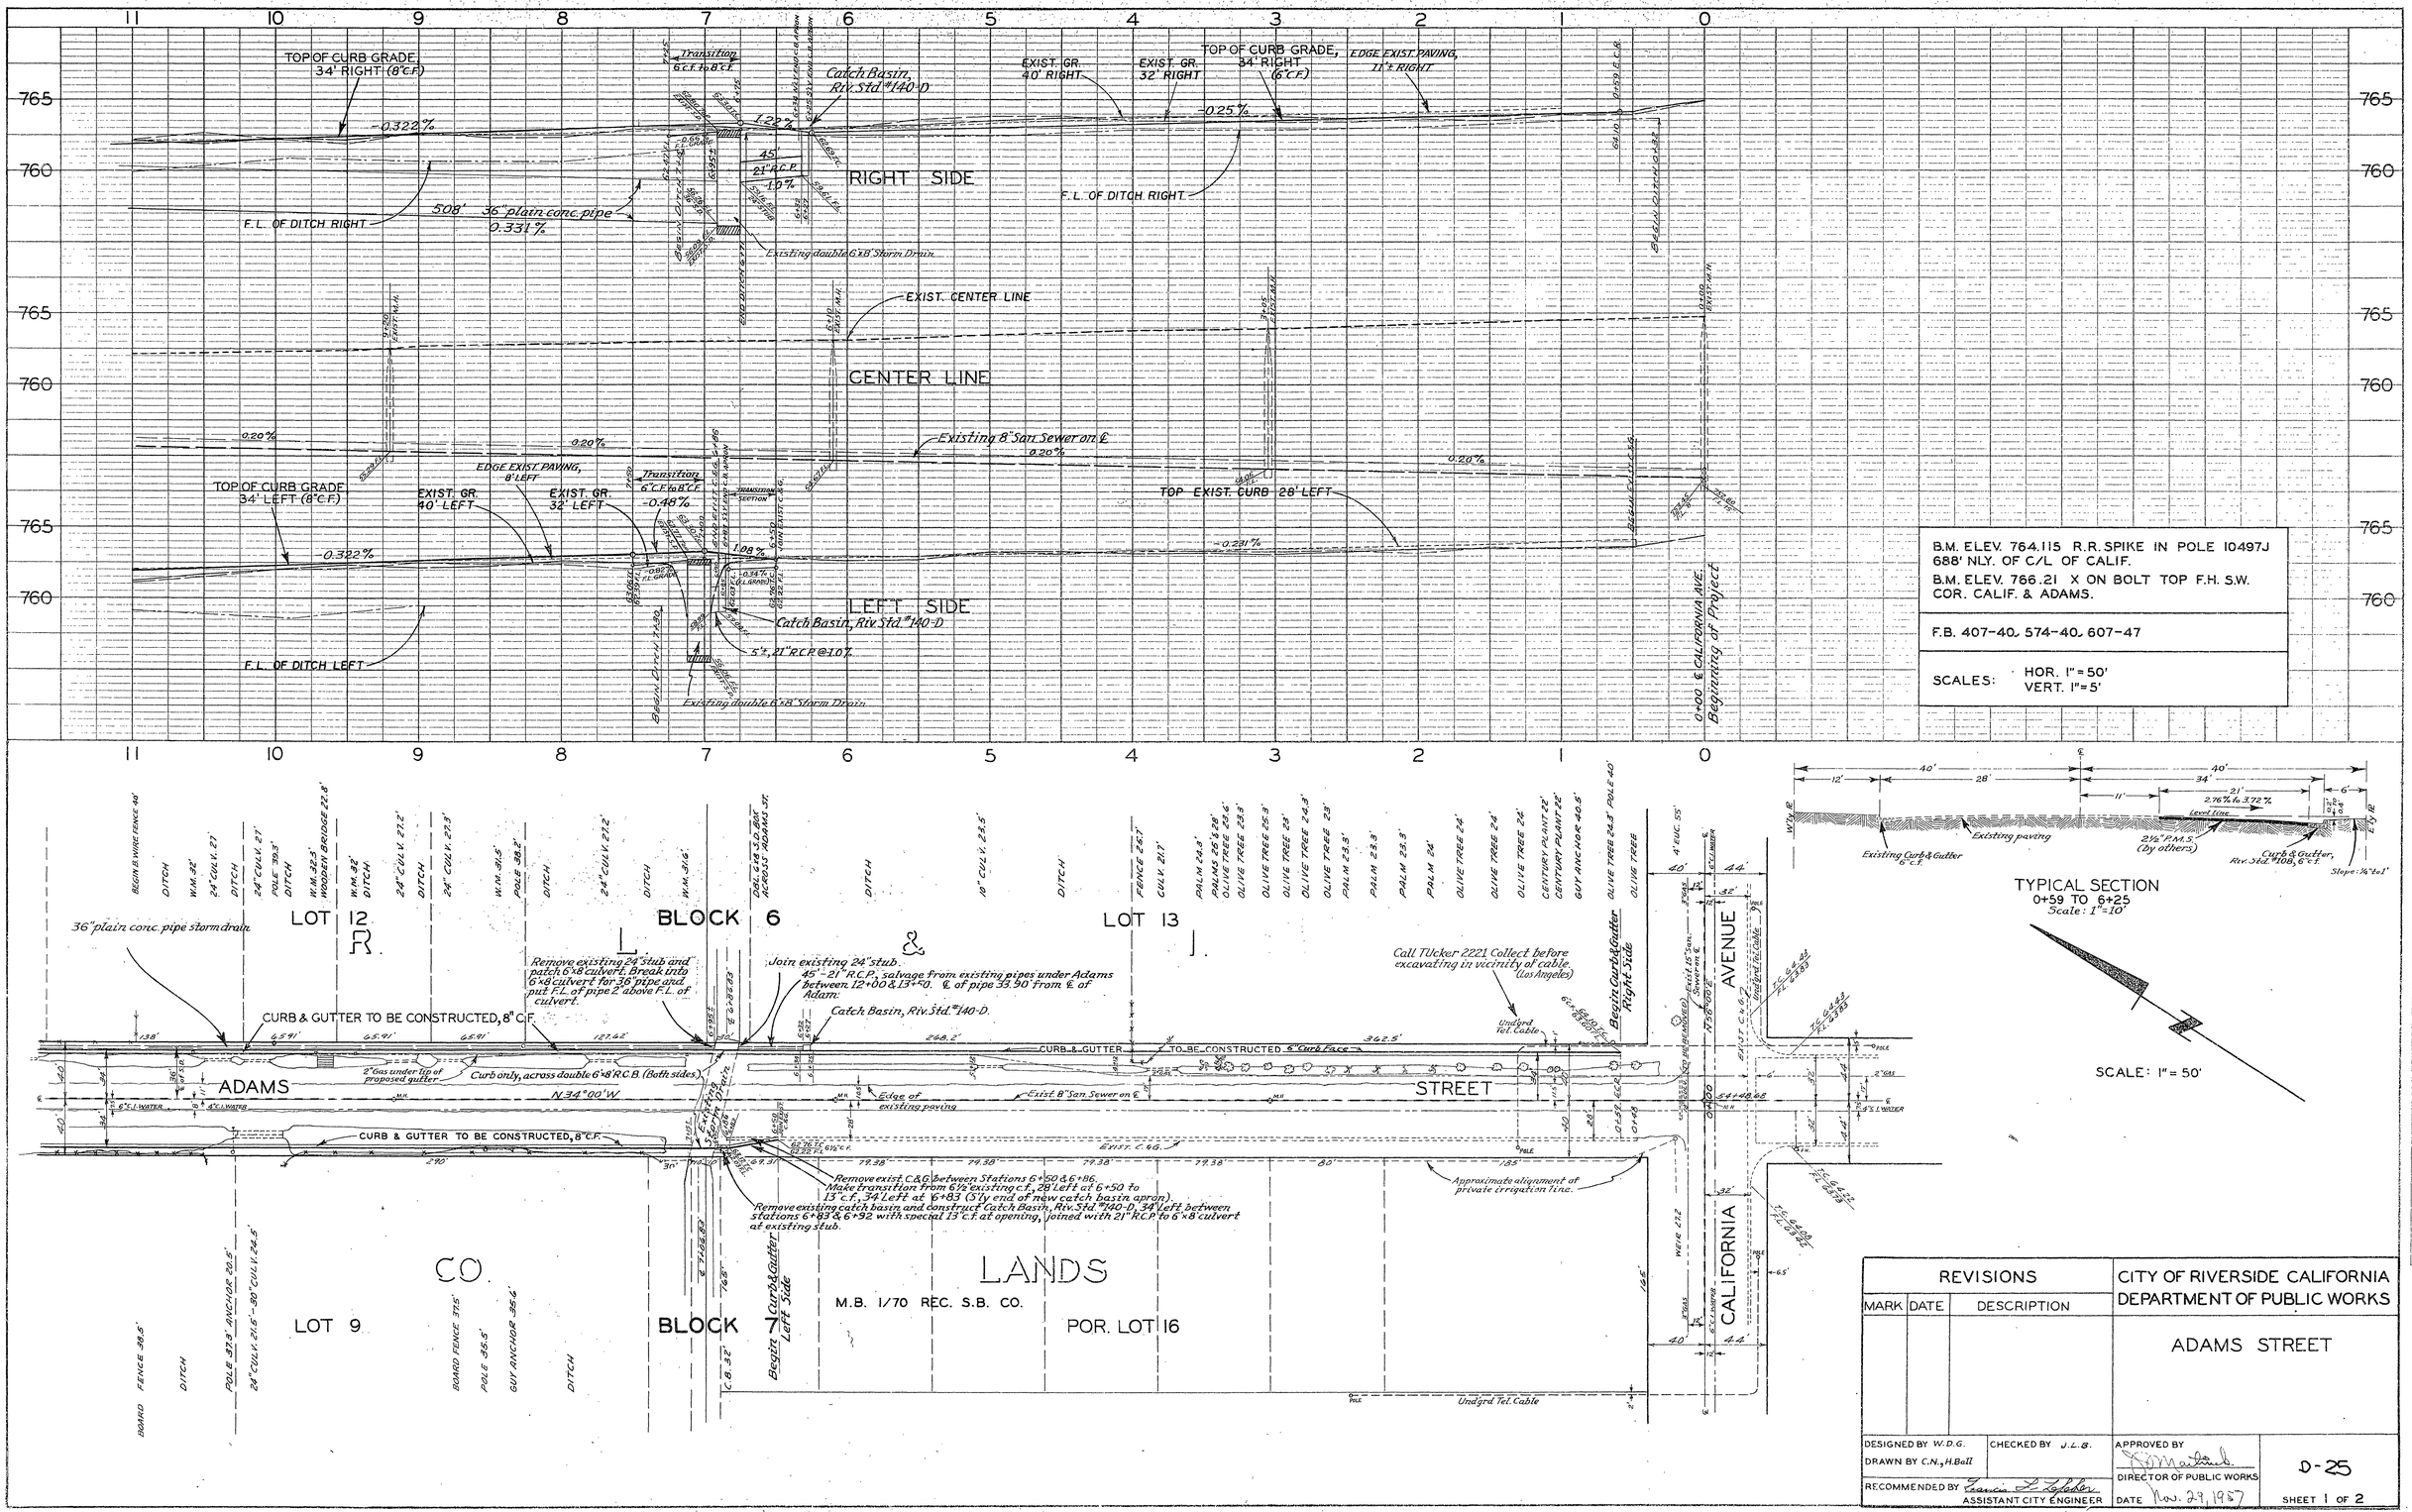

REVISIONS			CITY OF RIVERSIDE CALIFORNIA DEPARTMENT OF PUBLIC WORKS
MARK	DATE	DESCRIPTION	ADAMS STREET

DESIGNED BY W.D.G. CHECKED BY J.L.B.
DRAWN BY C.N., H.Ball
RECOMMENDED BY Francis L. Lightner, ASSISTANT CITY ENGINEER
APPROVED BY [signature], DIRECTOR OF PUBLIC WORKS

D-25

SHEET 1 OF 2

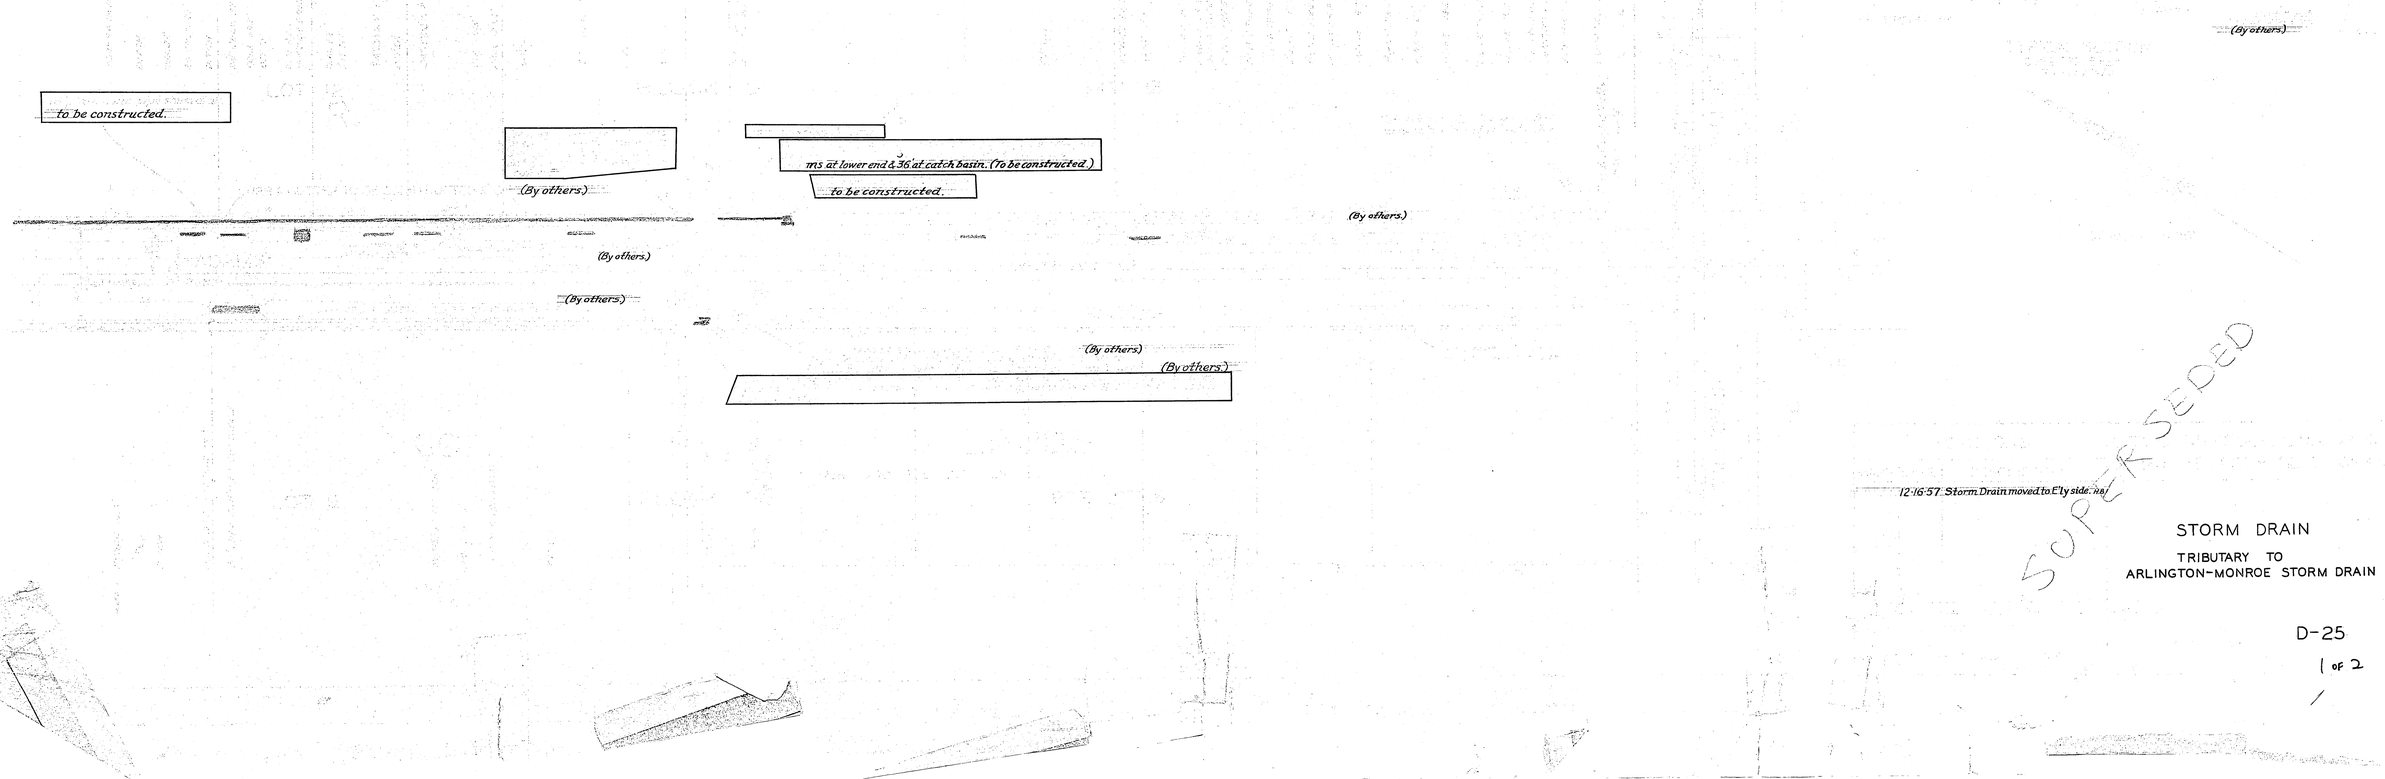

STORM DRAIN

TRIBUTARY TO
ARLINGTON-MONROE STORM DRAIN

D-25

1 of 2

PLATE 1 - PLAN-PROFILE - O. R. R. R. E. STANDARD
KEUFFEL & ESSER CO., NEW YORK.
K & E CO. No. 348-IC
(Reproducible Tracing Cloth)
(1000)

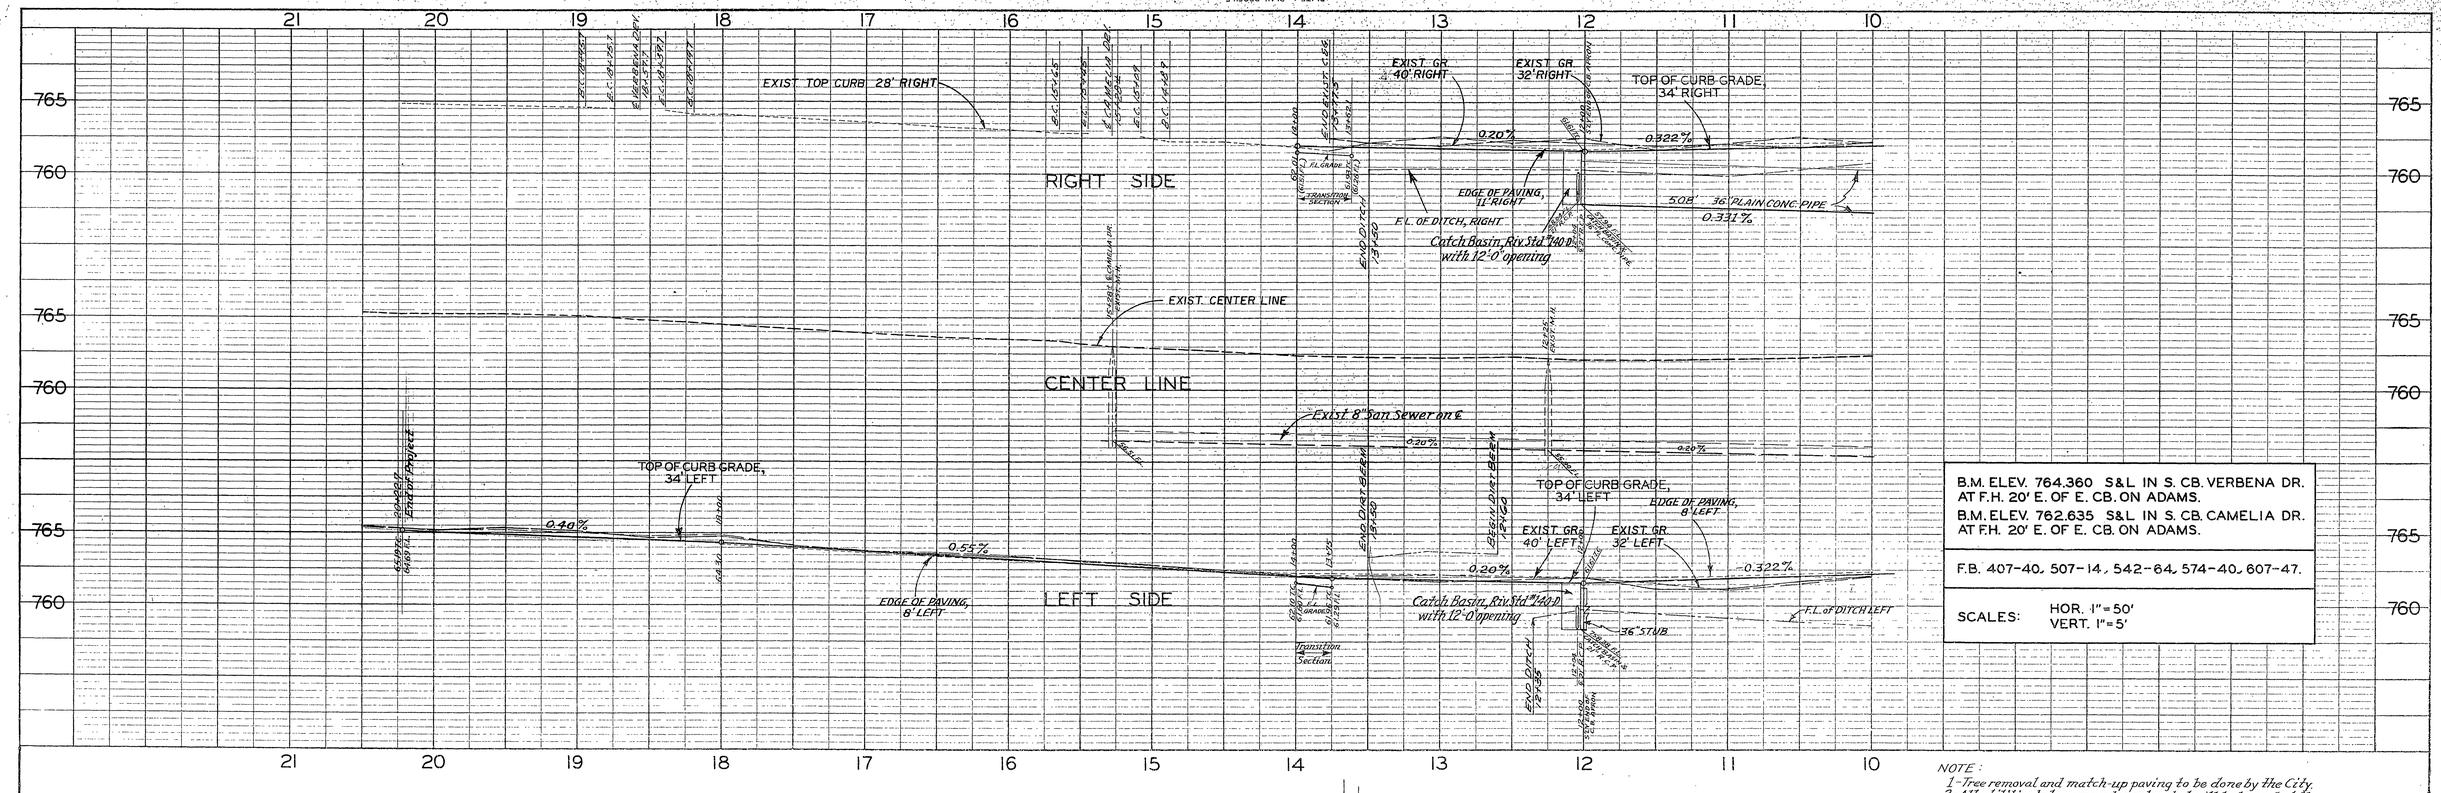

B.M. ELEV. 764.360 S&L IN S. CB. VERBENA DR. AT F.H. 20' E. OF E. CB. ON ADAMS.

B.M. ELEV. 762.635 S&L IN S. CB. CAMELIA DR. AT F.H. 20' E. OF E. CB. ON ADAMS.

F.B. 407-40, 507-14, 542-64, 574-40, 607-47.

SCALES: HOR. 1" = 50'
VERT. 1" = 5'

NOTE:
1-Tree removal and match-up paving to be done by the City.
2-All utilities to be removed or relocated will be by and at the expense of the utility company concerned. (Except irrigation, to be relocated by contractor.)
3-Fences are to be removed and relocated by and at the expense of the property owners concerned.
4-Storm drain, & catch basin construction, pipe & tree removal, utility relocations, and ditch backfilling to be done by others prior to construction of curb & gutter under this contract.

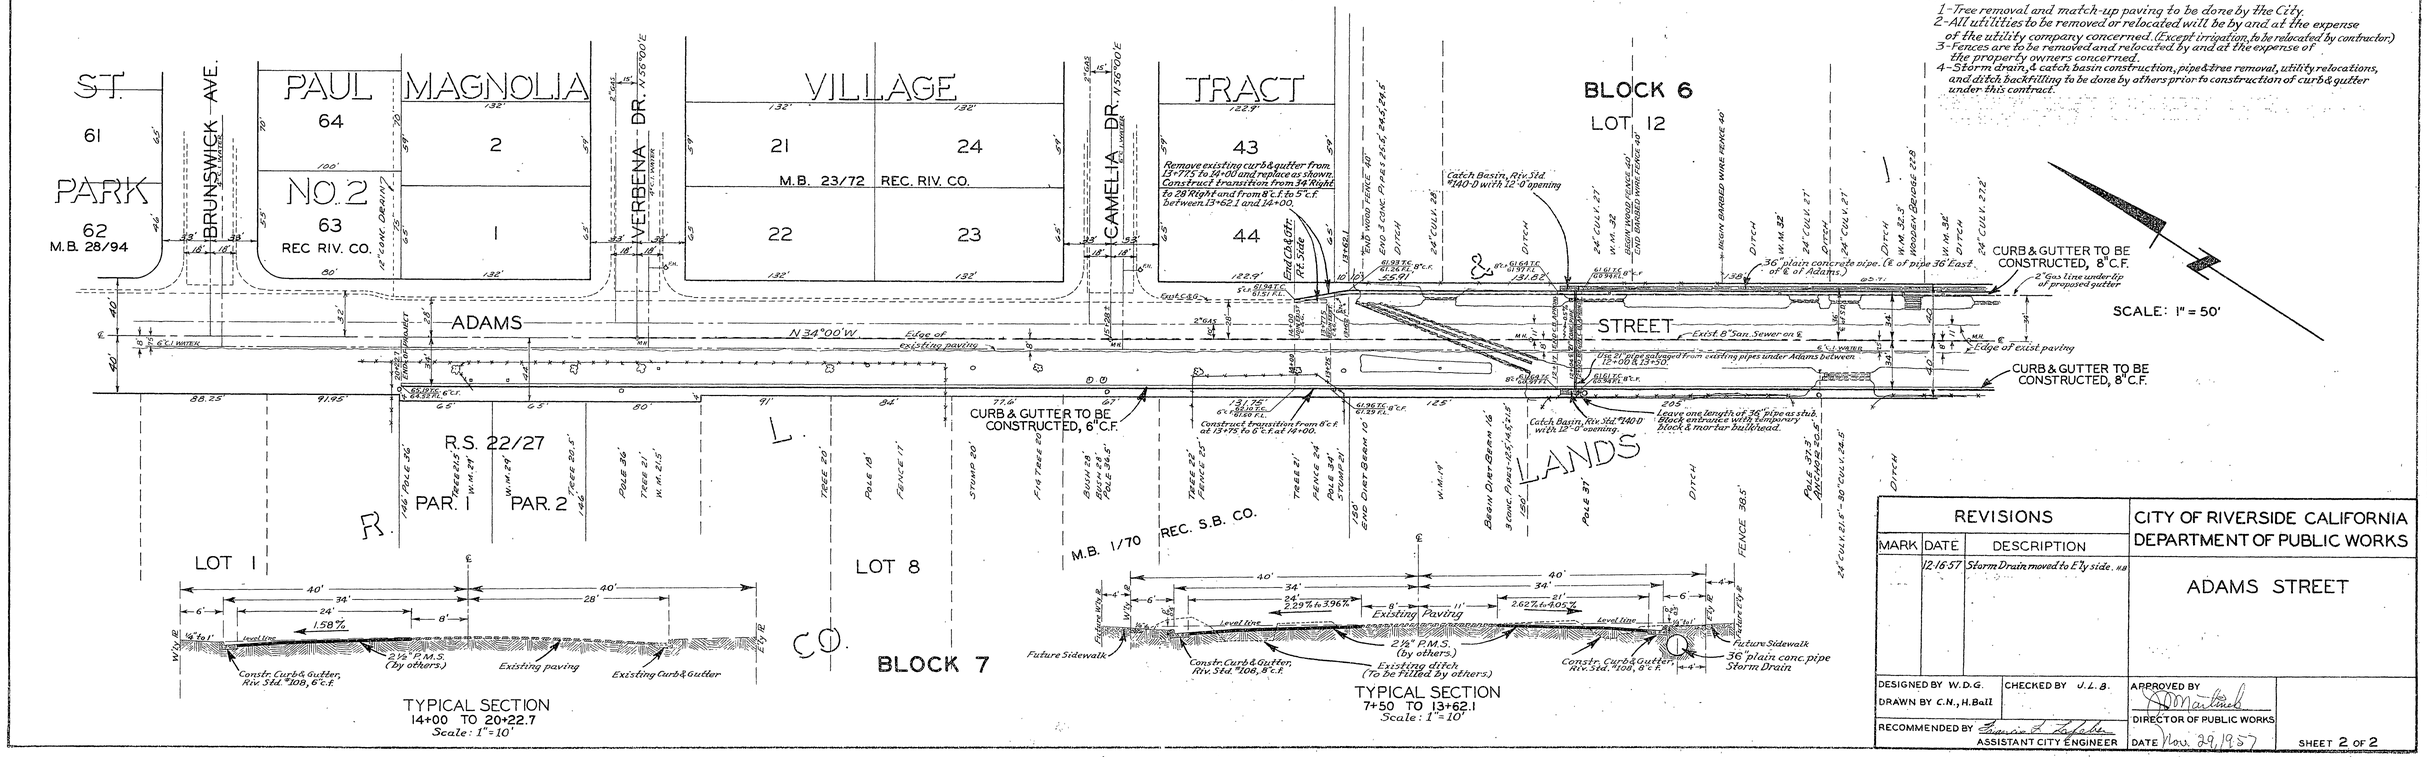

REVISIONS		
MARK	DATE	DESCRIPTION
	12-16-57	Storm Drain moved to E'ly side.

CITY OF RIVERSIDE CALIFORNIA
DEPARTMENT OF PUBLIC WORKS

ADAMS STREET

DESIGNED BY W.D.G.
DRAWN BY C.N., H.Ball
CHECKED BY J.L.B.
RECOMMENDED BY Lewis B. Lafabre
ASSISTANT CITY ENGINEER
APPROVED BY A. D. Martinez
DIRECTOR OF PUBLIC WORKS
DATE Nov. 29, 1957
SHEET 2 OF 2

PROFILE
SURVEYED
PLOTTED
GRADES CHECKED
B.M. & NOTED
STRUCTURE NOTATIONS CH'KD.
NOTE BOOK
NO.
BY
DATE

PLAN
SURVEYED
PLOTTED
PLAN CHECKED
BY OR W.U. CHECKED
NOTE BOOK
NO.
BY
DATE

5-Ditch backfill to be compacted to 90% of maximum density.
6-Paving replacement over new 21" pipe (at 12+04) and over area of removal of existing pipes (12+00 to 13+50) to be done by others.

Construct

(By others.)

(To be constructed.)

(By others.)

ed from exist
(To be constructed)

(By others.)

Construct

(By others.)

(By others.)

These plans can be used if the second 36" pipe is installed.

SUPERSEDED

11-30-57 Note 6 and shading. J.B.

STORM DRAIN

TRIBUTARY TO
ARLINGTON-MONROE STORM DRAIN

(By others.)

(By others.)

Existing ditch to be filled.

to be constructed.

(By others.)

D-25