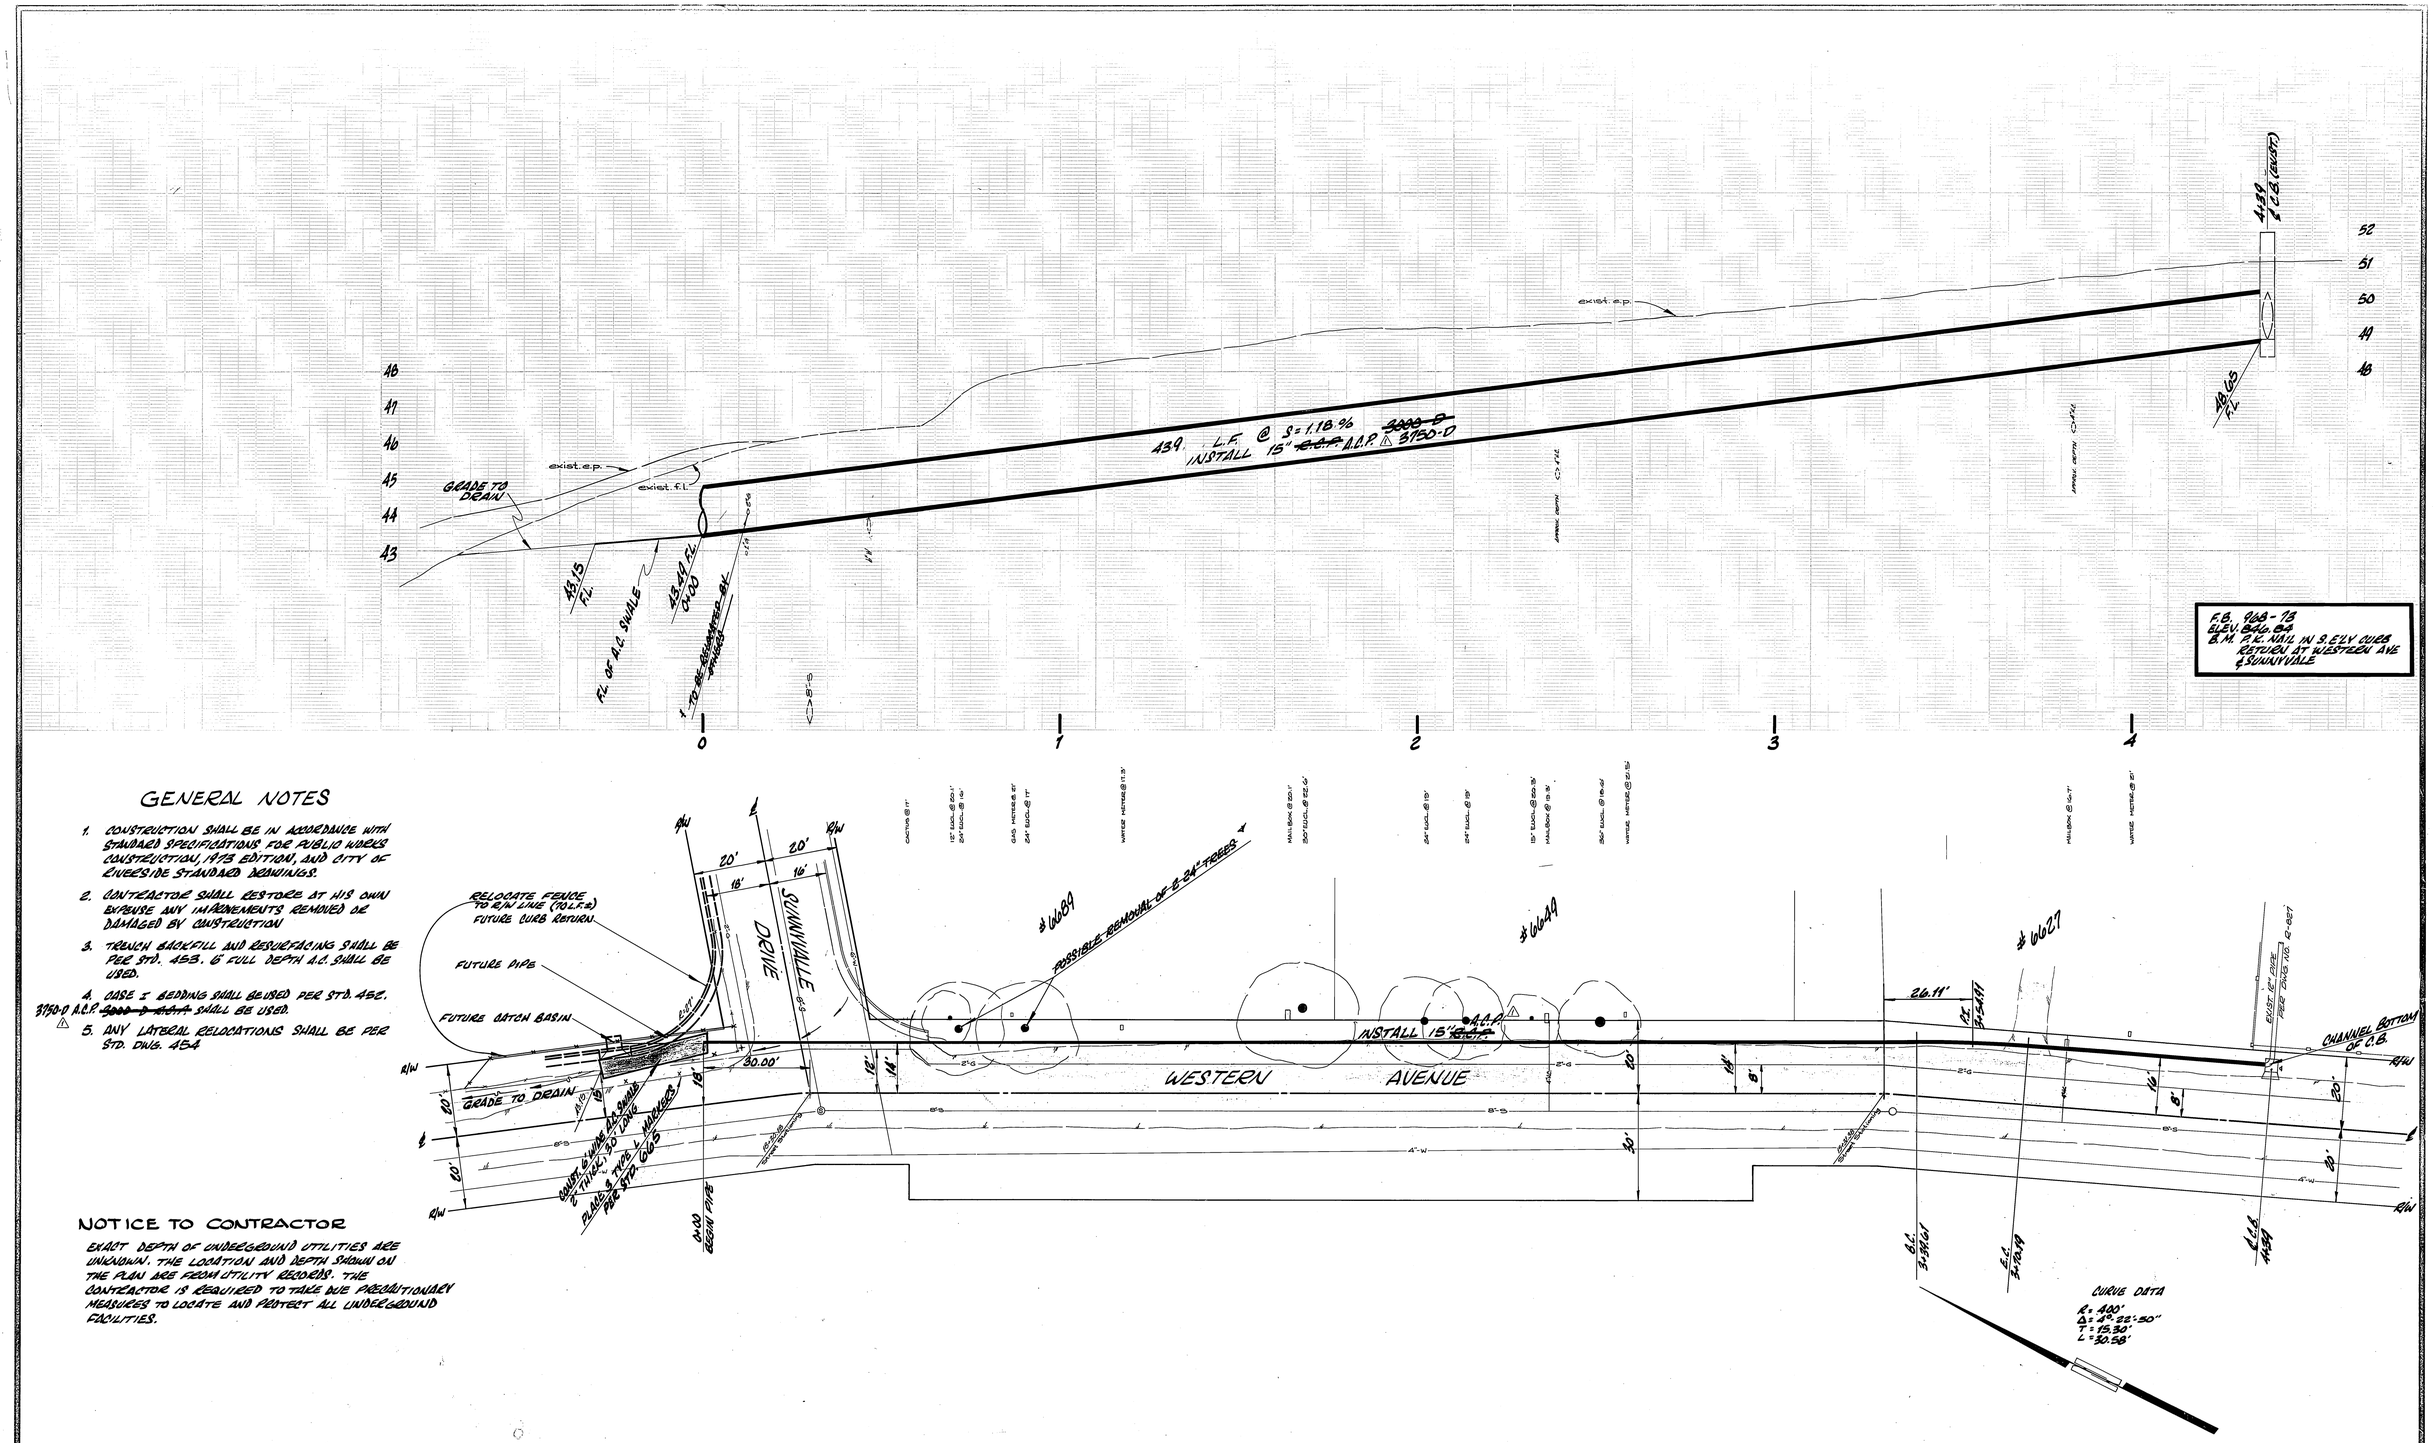

GENERAL NOTES

1. CONSTRUCTION SHALL BE IN ACCORDANCE WITH STANDARD SPECIFICATIONS FOR PUBLIC WORKS CONSTRUCTION, 1973 EDITION, AND CITY OF RIVERSIDE STANDARD DRAWINGS.
2. CONTRACTOR SHALL RESTORE AT HIS OWN EXPENSE ANY IMPROVEMENTS REMOVED OR DAMAGED BY CONSTRUCTION
3. TRENCH BACKFILL AND RESURFACING SHALL BE PER STD. 453. 6" FULL DEPTH A.C. SHALL BE USED.
4. CASE I BEDDING SHALL BE USED PER STD. 452. 3750-D A.C.P. ~~3000-D A.C.P.~~ SHALL BE USED.
5. ANY LATERAL RELOCATIONS SHALL BE PER STD. DWG. 454

NOTICE TO CONTRACTOR

EXACT DEPTH OF UNDERGROUND UTILITIES ARE UNKNOWN. THE LOCATION AND DEPTH SHOWN ON THE PLAN ARE FROM UTILITY RECORDS. THE CONTRACTOR IS REQUIRED TO TAKE DUE PRECAUTIONARY MEASURES TO LOCATE AND PROTECT ALL UNDERGROUND FACILITIES.

"AS BUILT" E.K. 11/74

MARK	REVISIONS	APPR.	DATE
1	CHANGE FROM R.C.P. 3000-D TO A.C.P. 3750-D	RAB	8/4/74

DESIGNED BY S.J.B. DRAWN BY RAB CHECKED BY

CITY OF RIVERSIDE
PUBLIC WORKS DEPARTMENT

APPROVED BY		
PRINCIPAL ENGINEER		7/22
PARK DEPARTMENT		7-18
TRAFFIC DIVISION		
CHIEF P. W. ENGINEER		

APPROVED BY William D. Gardner
PUBLIC WORKS DIRECTOR
DATE 7/25/74

WESTERN AVENUE STORM DRAIN BLEEDER PIPE

EAST SIDE OF WESTERN – FROM SUNNYVALLE TO 400' SOUTHERLY

HORIZ. SCALE: 1" - 20' VERT. SCALE: 1" - 2'

ACCOUNT NO. 09-573-492

D-268

SHEET 1 OF 1

FILE NO.