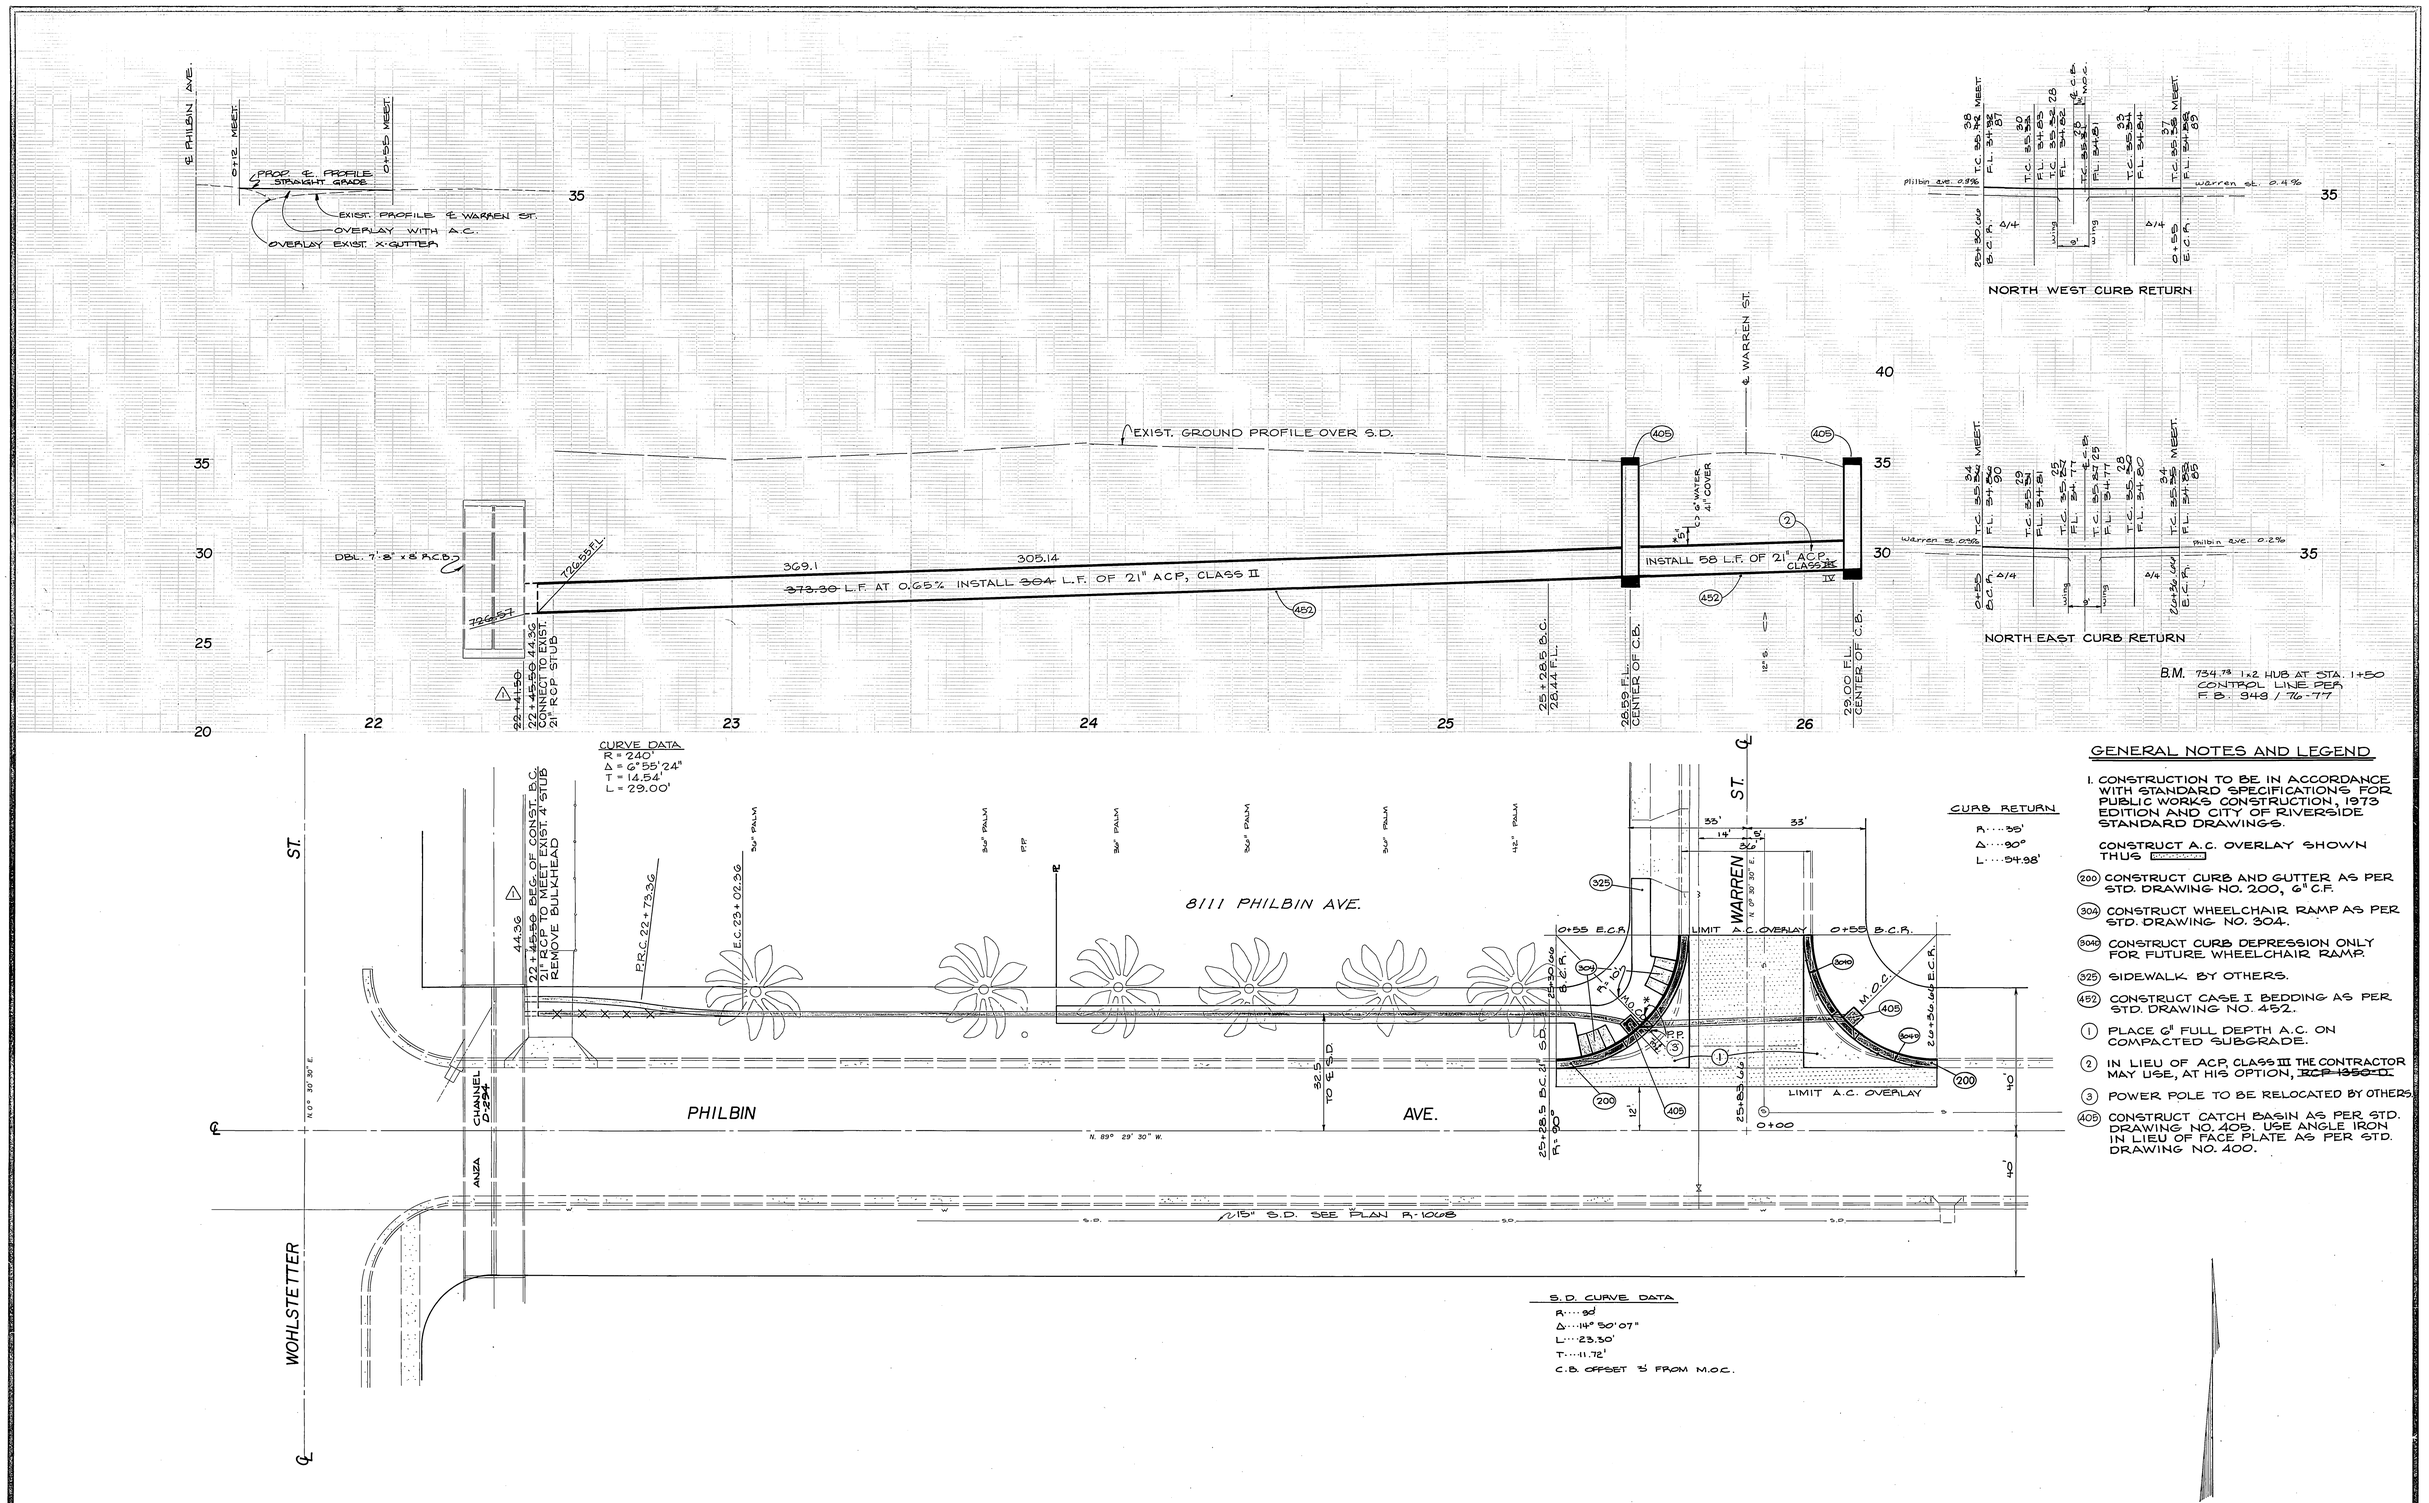


## GENERAL NOTES AND LEGEND

1. CONSTRUCTION TO BE IN ACCORDANCE WITH STANDARD SPECIFICATIONS FOR PUBLIC WORKS CONSTRUCTION, 1973 EDITION AND CITY OF RIVERSIDE STANDARD DRAWINGS.

CONSTRUCT A.C. OVERLAY SHOWN THUS

(200) CONSTRUCT CURB AND GUTTER AS PER STD. DRAWING NO. 200, 6" C.F.

(304) CONSTRUCT WHEELCHAIR RAMP AS PER STD. DRAWING NO. 304.

(304D) CONSTRUCT CURB DEPRESSION ONLY FOR FUTURE WHEELCHAIR RAMP.

(325) SIDEWALK BY OTHERS.

(452) CONSTRUCT CASE I BEDDING AS PER STD. DRAWING NO. 452.

(1) PLACE 6" FULL DEPTH A.C. ON COMPACTED SUBGRADE.

(2) IN LIEU OF ACP, CLASS III THE CONTRACTOR MAY USE, AT HIS OPTION, ~~RCP 1350-D~~.

(3) POWER POLE TO BE RELOCATED BY OTHERS.

(405) CONSTRUCT CATCH BASIN AS PER STD. DRAWING NO. 405. USE ANGLE IRON IN LIEU OF FACE PLATE AS PER STD. DRAWING NO. 400.

AS BUILT 4-76 KBT

| MARK | REVISIONS | APPR. | DATE |
|---|---|---|---|
| 1 | CHANGED ALIGNMENT TO MATCH LOCATION OF EXIST. STUB KBT | | 7/13/76 |

DESIGNED BY [signature] DRAWN BY [signature] CHECKED BY

CITY OF RIVERSIDE
PUBLIC WORKS DEPARTMENT

| APPROVED BY | | |
|---|---|---|
| PRINCIPAL ENGINEER | | 9/17 |
| PARK DEPARTMENT | RB | 9-10 |
| TRAFFIC DIVISION | | |
| CHIEF P. W. ENGINEER | | 9-23 |

APPROVED BY [signature]
PUBLIC WORKS DIRECTOR
DATE 9-23-75

# PHILBIN AVE. STORM DRAIN

WOHLSETTER to WARREN

HORIZ. SCALE: 1" - 20' VERT. SCALE: 1" - 4'

ACCOUNT NO. 09-573-401

D-279

SHEET 1 OF 1

FILE NO.