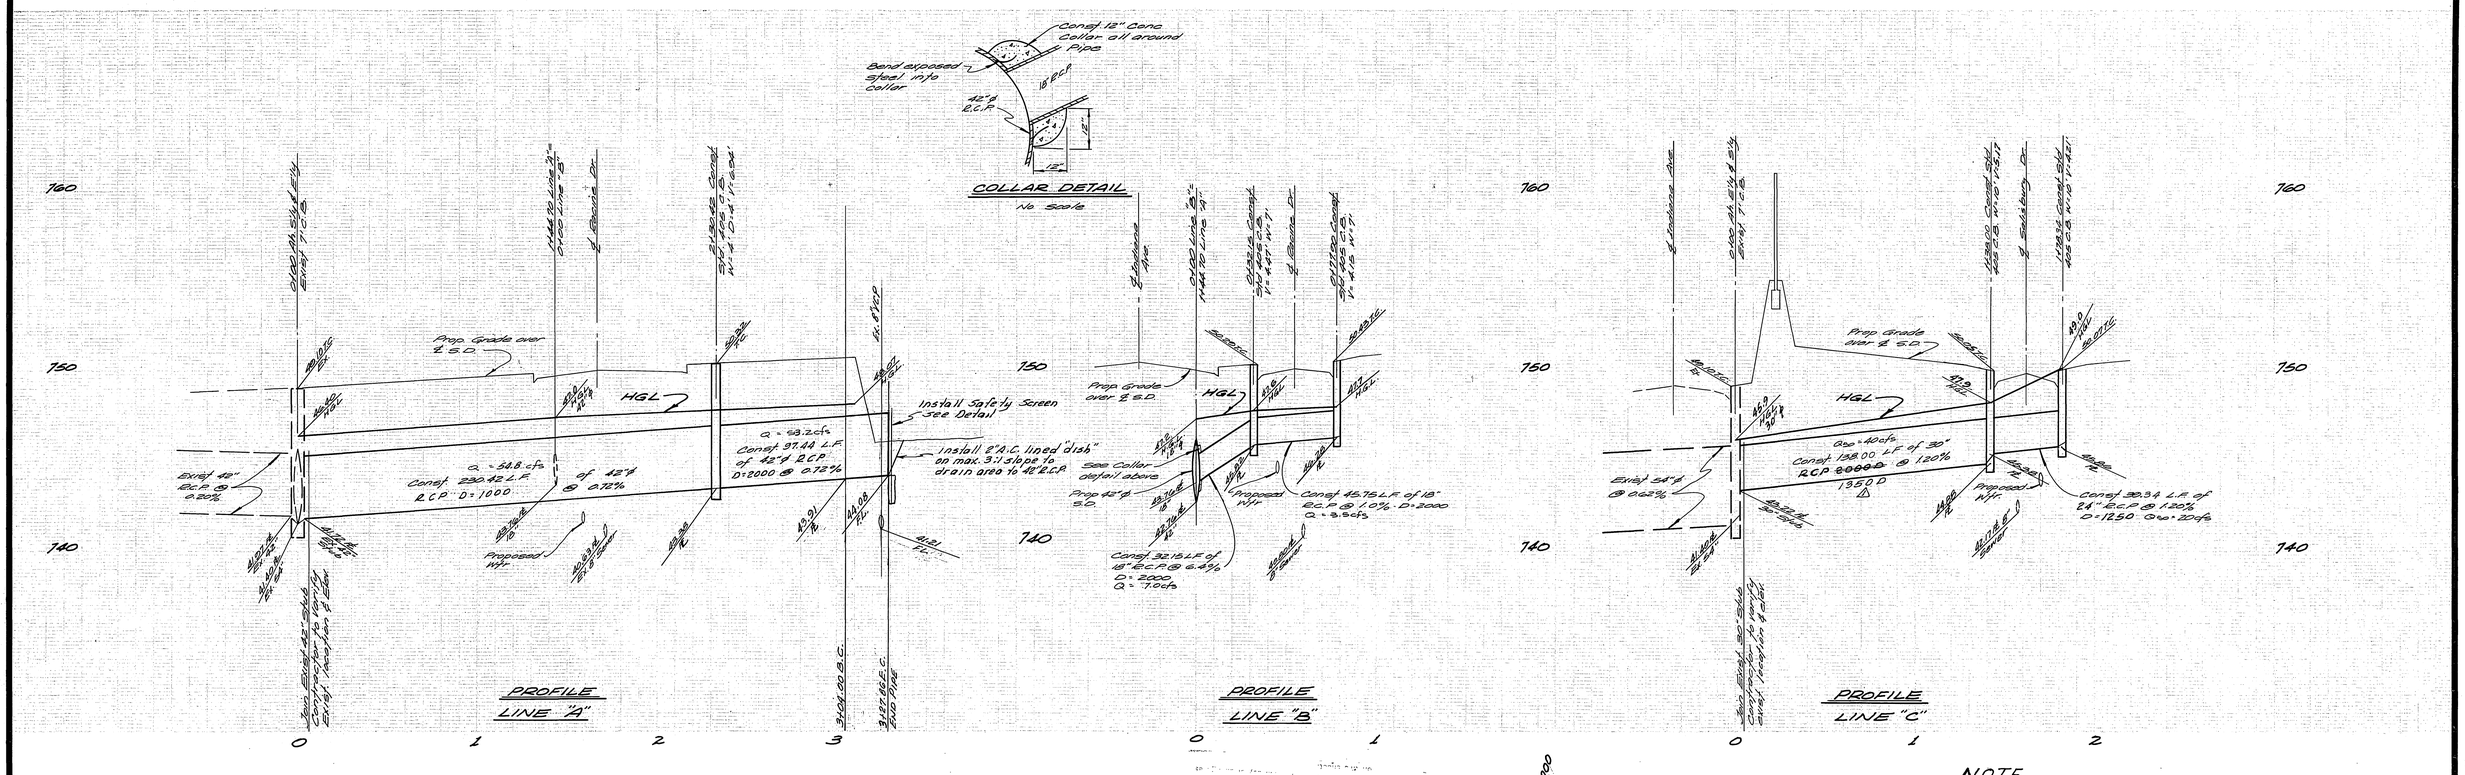

NOTE

Lines "A" & "B" are to be constructed by the City with the costs shared by the City and the Developer as agreed upon.
Line "C" is to be constructed and paid for by the Developer.
42" Cast in Place may be an alternate for the 42" R.C.P. shown as Line "A".

GENERAL NOTES

1. It shall be the responsibility of the contractor to clear the right of way in accordance with the provisions of law as it affects each utility including irrigation lines and appurtenances and of no cost to the city.
2. Construction shall be in accordance with the City of Riverside, Department of Public Works, Standard Drawings and the Standard Specifications for Public Works Construction, 1973 Edition.
3. Bedding shall be per City of Riverside Standard Drawing No. 452, Case I.

NOTE:
Frame shall be placed in such a way that the bars clear the end of the R.C.P. by a maximum of 2".
Paint frame and bars as follows:
Prime - 1 Coat Red Lead State 691-80-53
Finish - 2 Coats Green State 701-80-82

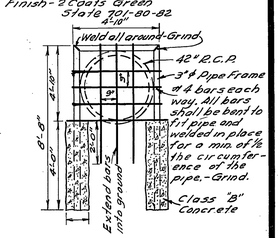

SAFETY SCREEN DETAIL

NO SCALE

FOR APPROVAL OF 30" R.C.P. LINE "C" ONLY
APPROVED BY [signature] DATE 3-22-76
DIRECTOR OF PUBLIC WORKS

*AS BUILT 8-76 KPT

BENCH MARK

Brass disc set in conc. stamped 601-25-68 on West side of Tyler St. 250'± North of Indiana Ave & 1'± Northeast of bridge No. 56-419. Elevation ~ 756.665

ALBERT A. WEBB ASSOCIATES CIVIL ENGINEERS RIVERSIDE, CALIFORNIA APPROVED BY [signature] DATE 2/20/76 R.E. No. 9876 W.O. 75-99 FOR: Pace Setter Homes Inc. F.B. 1037	MARK / REVISIONS / APPR. / DATE Δ 30" RCP D revised to 1350D-as constructed 4/20/76 DESIGNED BY LAW DRAWN BY RLT CHECKED BY [signature]	CITY OF RIVERSIDE, CALIFORNIA PUBLIC WORKS DEPARTMENT APPROVED BY / BY / DATE PRINCIPAL ENGINEER 4/16 PARK DEPARTMENT TRAFFIC DIVISION CHIEF PUB. WKS. ENGR. 4-21 APPROVED BY [signature] DIRECTOR OF PUBLIC WORKS DATE 4-21-76	STORM DRAIN PLAN & PROFILE TRACT NO 6070-2 INDIANA AVENUE RACINE DRIVE EASEMENT SCALE: Horiz: 1"=40' Vert: 1"=4'

ACCOUNT No.
DRAWING NUMBER D-288
SHEET 1 OF 1
75-99-D