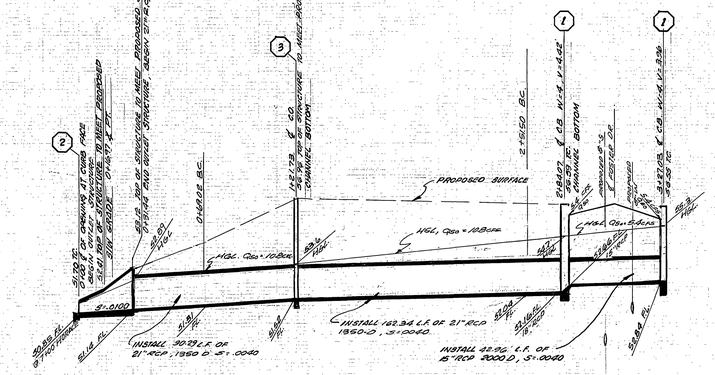

PROFILE "A"

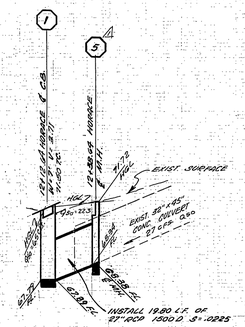

PROFILE "B"

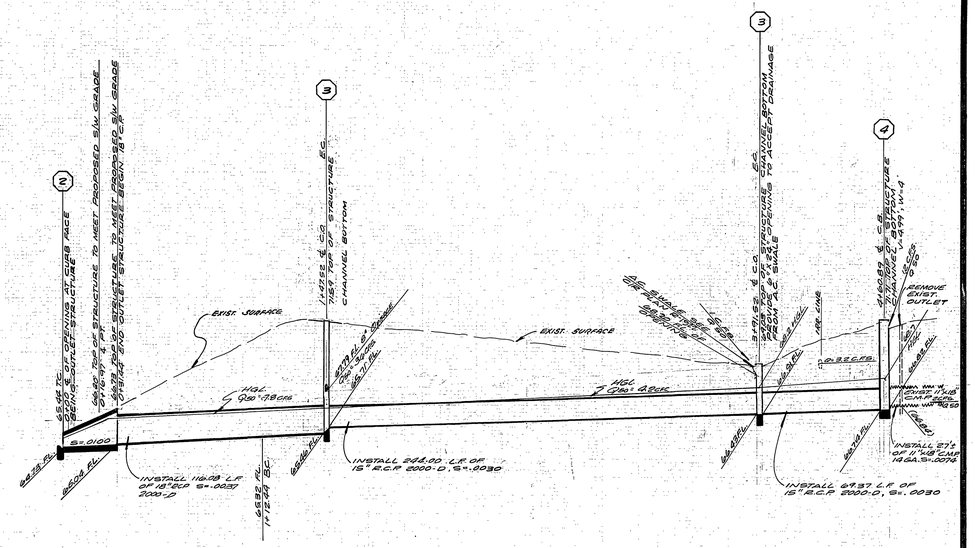

PROFILE "C"

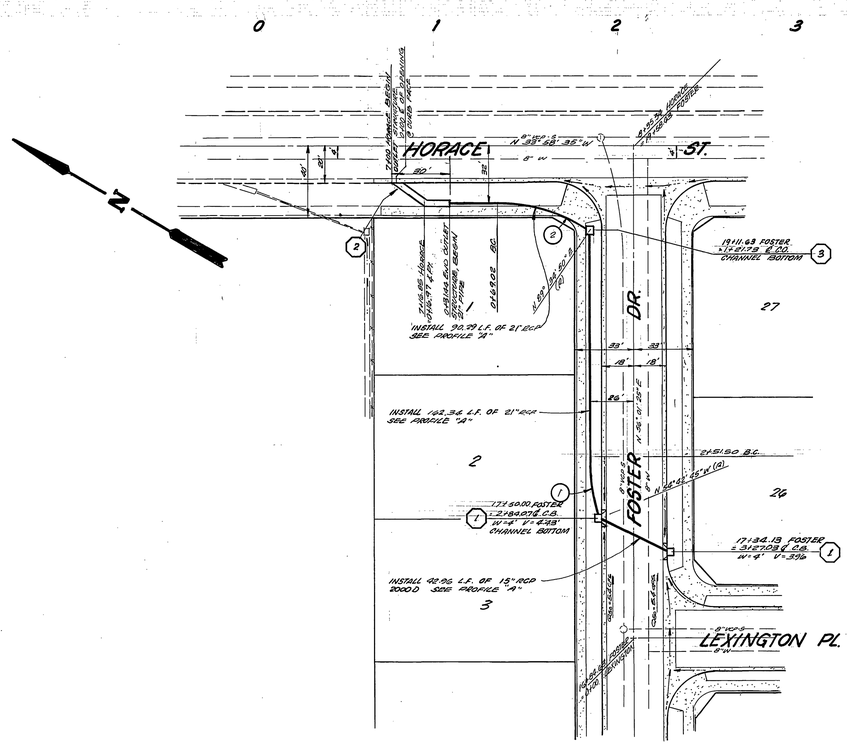

GENERAL NOTES

1. IT SHALL BE THE RESPONSIBILITY OF THE CONTRACTOR TO CLEAR THE RIGHT OF WAY IN ACCORDANCE WITH THE PROVISIONS OF LAW AS IT AFFECTS EACH UTILITY INCLUDING IRRIGATION LINES AND APPURTENANCES AND AT NO COST TO THE CITY.
2. CONSTRUCTION SHALL BE IN ACCORDANCE WITH THE CITY OF RIVERSIDE DEPARTMENT OF PUBLIC WORKS STANDARD DRAWINGS, AND THE STANDARD SPECIFICATIONS FOR PUBLIC WORKS CONSTRUCTION, 1976 EDITION.
3. PIPE BEDDING SHALL BE PER CITY OF RIVERSIDE STANDARD DRAWING NO. 422, CASE I.
4. SEE C/R PLAN R-1922 FOR STREET CONSTRUCTION.

CONSTRUCTION NOTES

1. CONSTRUCT C/R STANDARD DRAWING NO. 405 CATCH BASIN, CHANNEL BOTTOM
2. CONSTRUCT C/R STANDARD DRAWING NO. 410 OUTLET STRUCTURE, W.S.
3. CONSTRUCT C/R STANDARD DRAWING NO. 425 CLEANOUT
4. CONSTRUCT C/R STANDARD DRAWING NO. 405 CATCH BASIN (DELETE CATCH BASIN WINGS AND GUTTER, PROVIDE 3'SMOOTH AC APRON INTO OPENING)
5. CONSTRUCT C/R STANDARD DRAWING NO. 320 MANHOLE (MODIFIED 8'-0 I.D.)

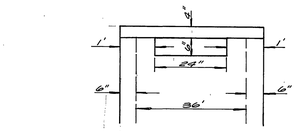

CURVE DATA				
No.	Δ	R	L	T
1.	20°48'10"	90.00'	32.67'	16.47'
2.	33°33'25"	90.00'	52.71'	27.14'
3.	22°20'00"	90.00'	35.08'	17.77'

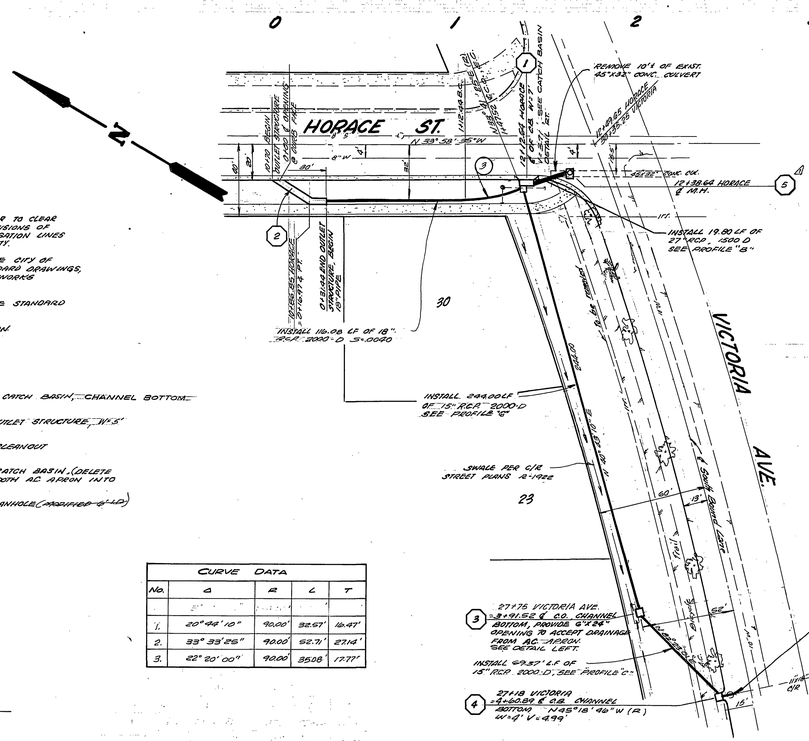

BENCH MARK:
(65-G) PK NAIL & TAG IN CULVERT HEADWALL @ W'LY CORNER OF VICTORIA AVE. & ANNA ST. ELEV. 980.685

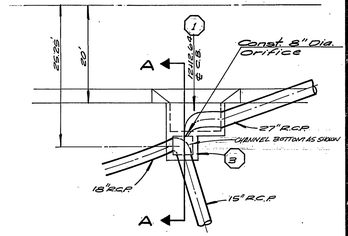

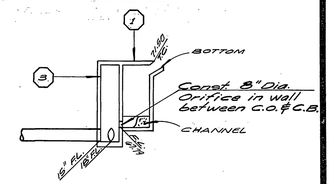

* AS BUILT 1-22-80 BLP

INDEXED E.T.

ALBERT A. WEBB ASSOCIATES CIVIL ENGINEERS RIVERSIDE, CALIFORNIA APPROVED BY Brian J. Forsyth DATE 8-26-75 R.E. No. 21884		CITY OF RIVERSIDE, CALIFORNIA PUBLIC WORKS DEPARTMENT	STORM DRAIN PLAN & PROFILE
W.O. 75-101 FOR: DR. M.H. MAC ARTHUR F.B. 1037	MARK: REVISIONS — APPR. — DATE DESIGNED BY EDL DRAWN BY EDL CHECKED BY	APPROVED BY — BY — DATE PRINCIPAL ENGINEER — [illegible] — 1/25 PARK DEPARTMENT TRAFFIC DIVISION — [illegible] — 1/25 CHIEF PUB. WKS. ENGR. — [illegible] — 1/26 APPROVED BY [signature] DIRECTOR OF PUBLIC WORKS DATE 1-26-77	TRACT 6466-1 HORACE ST.REET VICTORIA AVENUE FOSTER DRIVE SCALE: HORIZ. 1"=40' VERT. 1"=4'

ACCOUNT No. 75-101	
DRAWING NUMBER	D-303
SHEET 1 OF 1	
	75-101-D